


PLAN SURVEYED BY L.A. CAMPBELL 9/2/28
 PLOTTED BY L.A. CAMPBELL
 ALIGNMENT CHECKED BY L.A. CAMPBELL
 RT. OF WAY CHECKED BY L.A. CAMPBELL

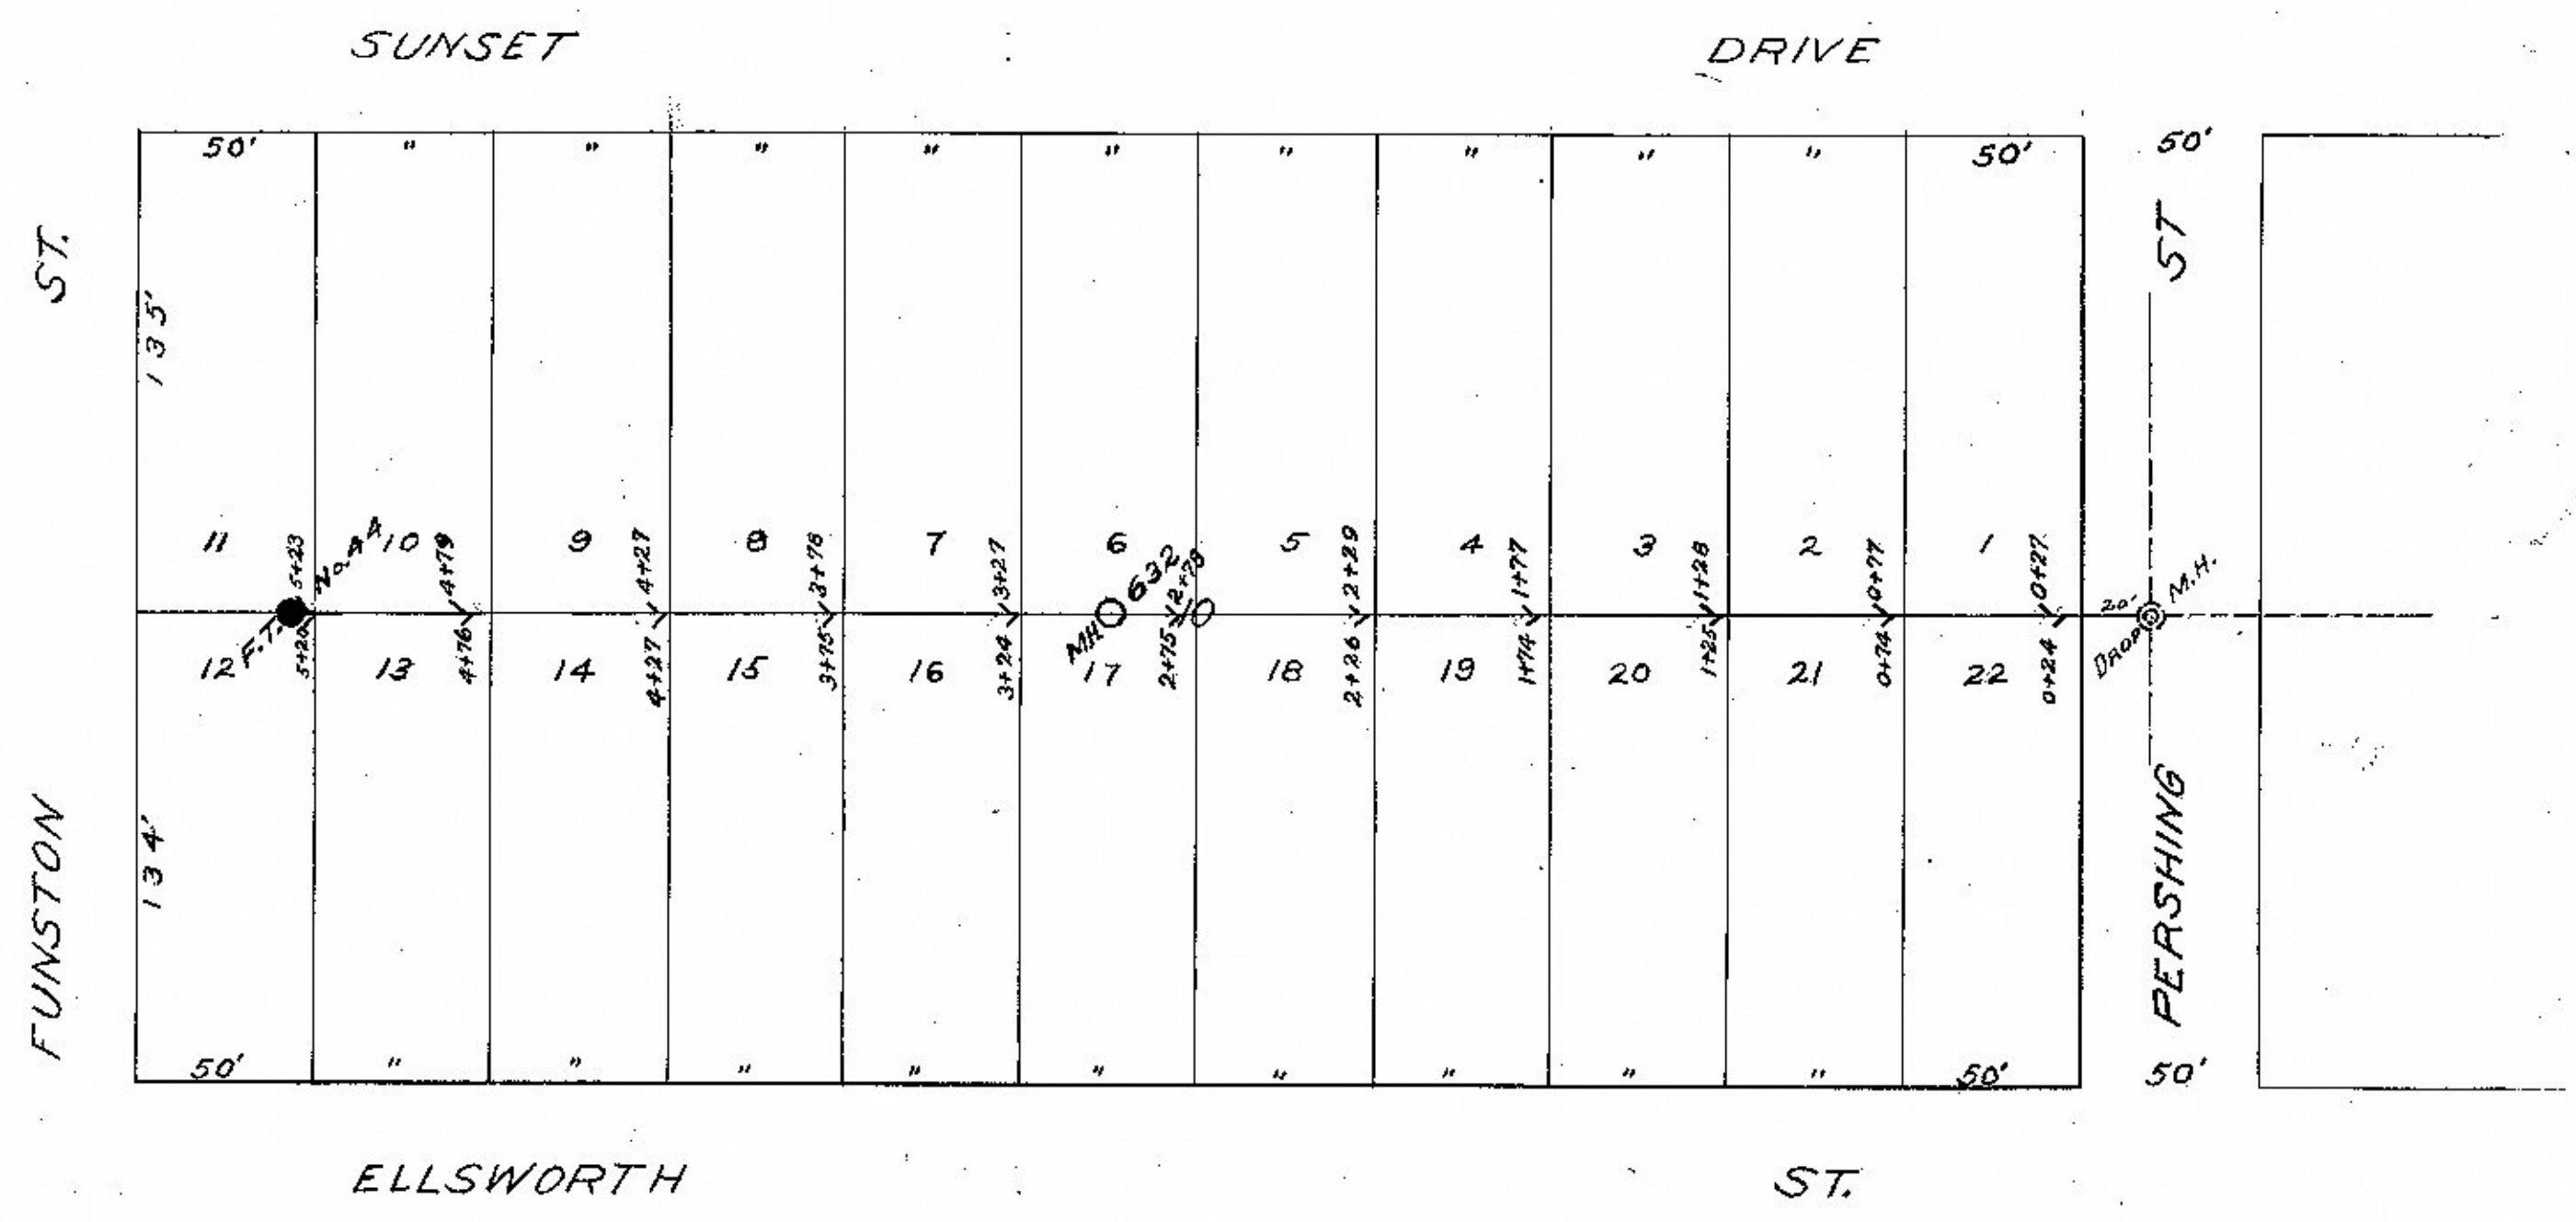

PROFILE SURVEYED BY L.A. CAMPBELL 9/2/28
 PLOTTED BY L.A. CAMPBELL
 R.M.S. ADJUSTED BY L.A. CAMPBELL
 STRUCTURE NOT TO SCALE

