

PLAN
NOTE BOOK
NO. _____

BY _____ DATE _____



FILED
SEP 29 1930
CHAS. E. BARKER
CITY ENGINEER

FILED
SEP 29 1930
CHAS. E. BARKER
CITY ENGINEER

PROFILE
NOTE BOOK
NO. _____

BY _____ DATE _____

FILED
SEP 29 1930
CHAS. E. BARKER
CITY ENGINEER

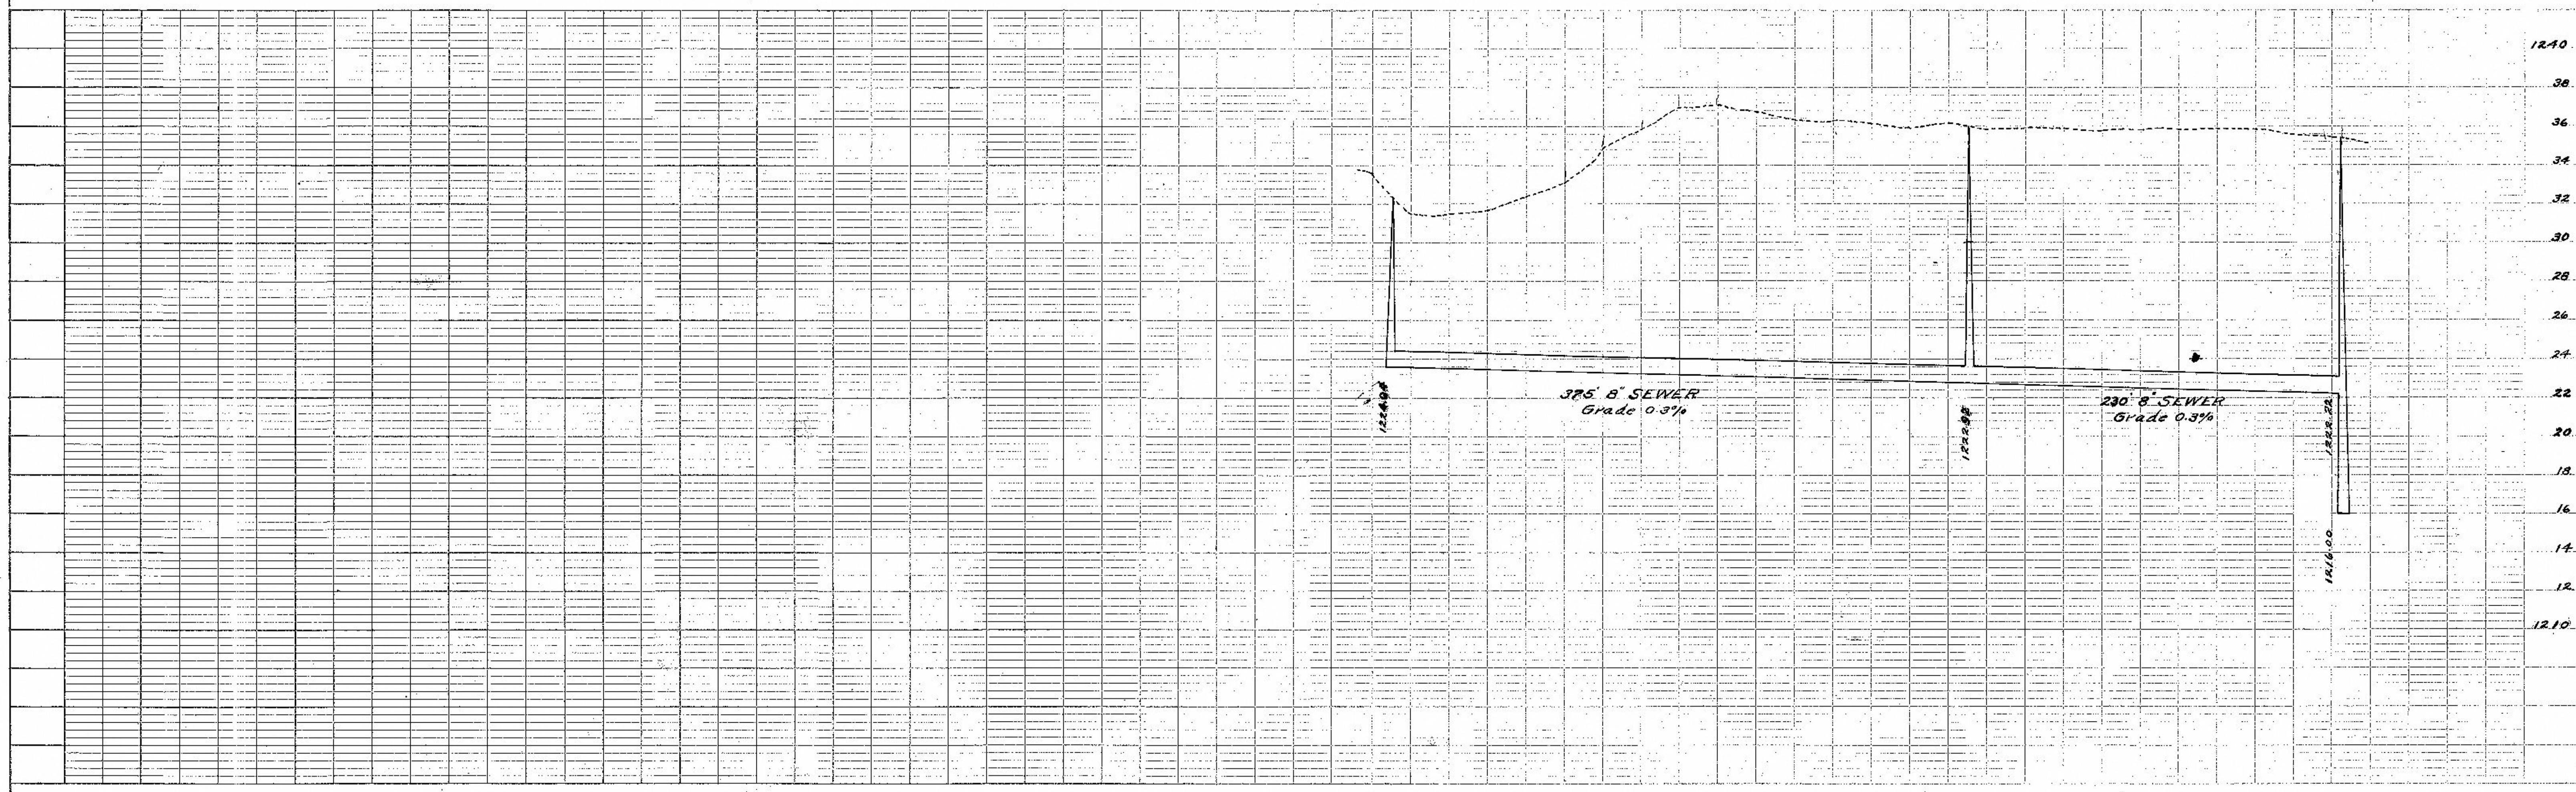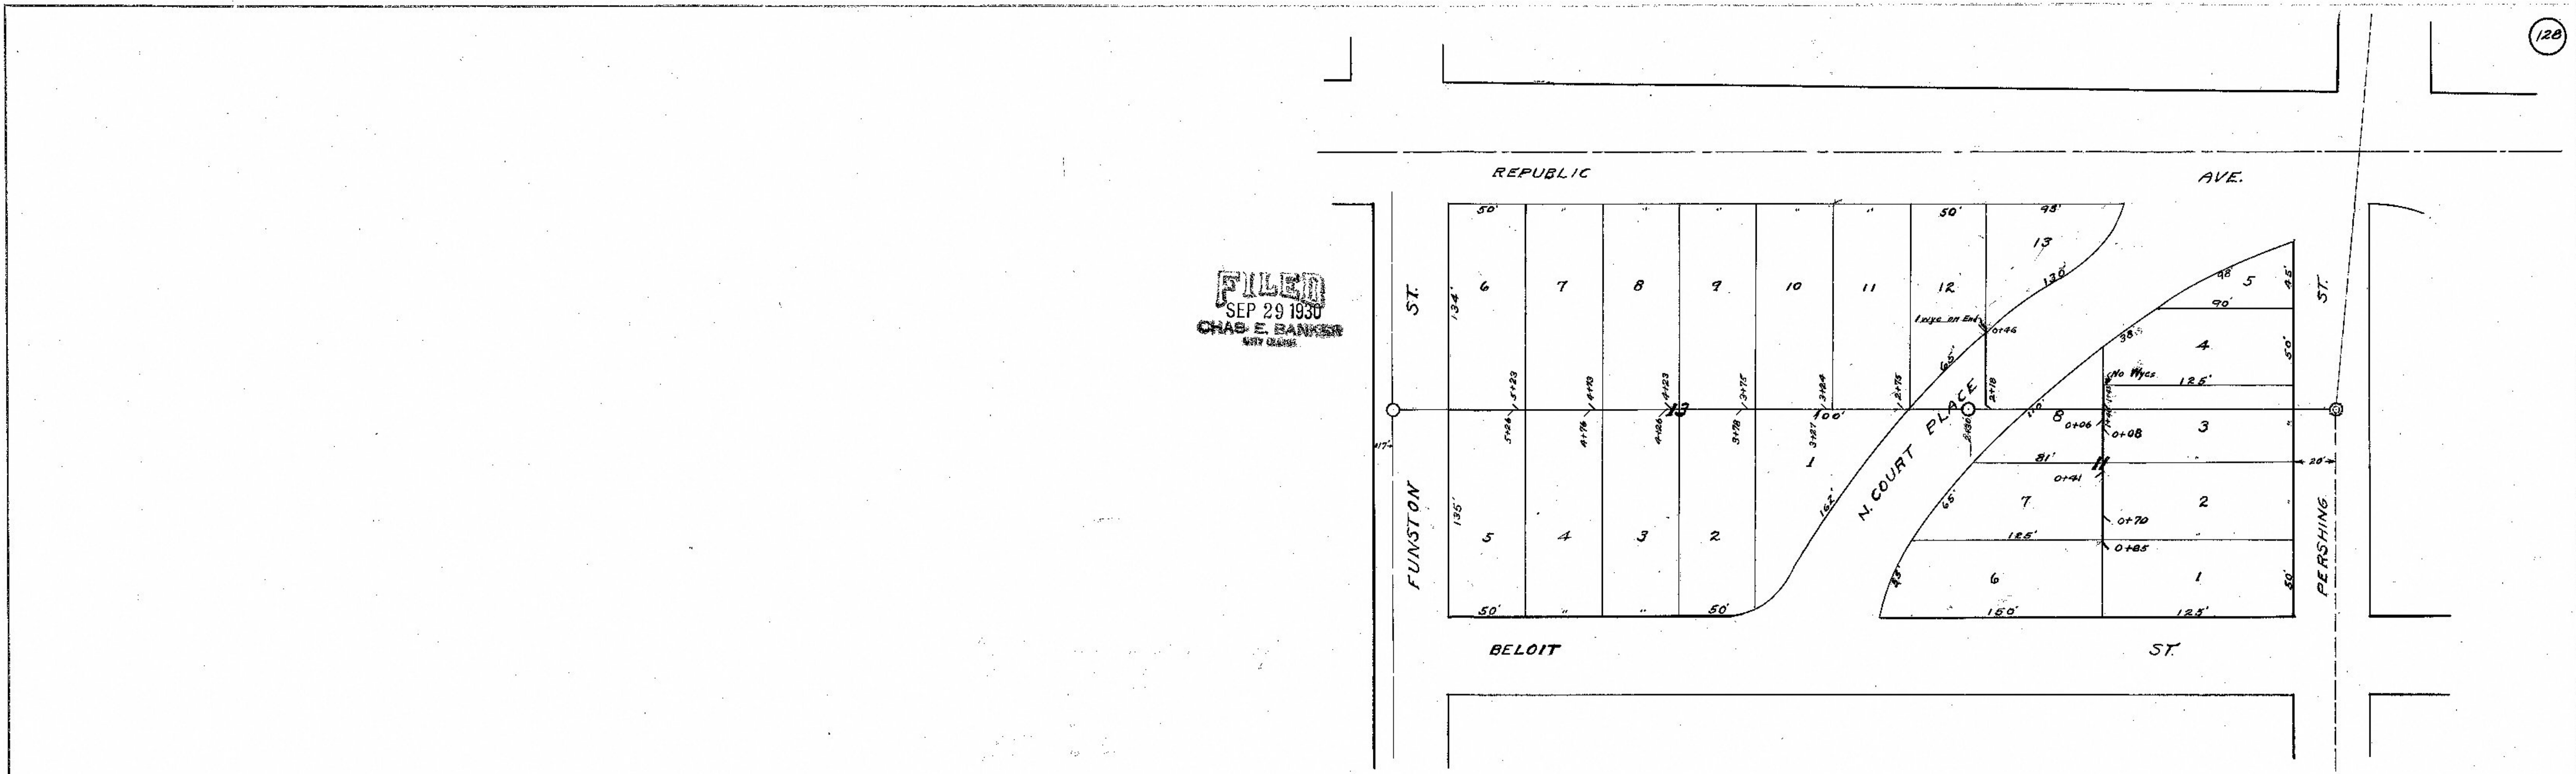

LATERAL SANITARY SEWER NO. 144