


PLAN  
 SURVEYED BY \_\_\_\_\_ DATE \_\_\_\_\_  
 NOTE BOOK NO. \_\_\_\_\_  
 GRADES CHECKED BY \_\_\_\_\_  
 ALIGNMENT CHECKED BY \_\_\_\_\_  
 RT. OF WAY CHECKED BY \_\_\_\_\_

**FILED**  
 SEP 29 1930  
 CHAS. E. BANNER  
 CITY ENGINEER



PROFILE  
 SURVEYED BY \_\_\_\_\_ DATE \_\_\_\_\_  
 PLOTTED BY \_\_\_\_\_  
 GRADES CHECKED BY \_\_\_\_\_  
 NOTE BOOK NO. \_\_\_\_\_  
 STRUCTURE NOTATIONS BY \_\_\_\_\_

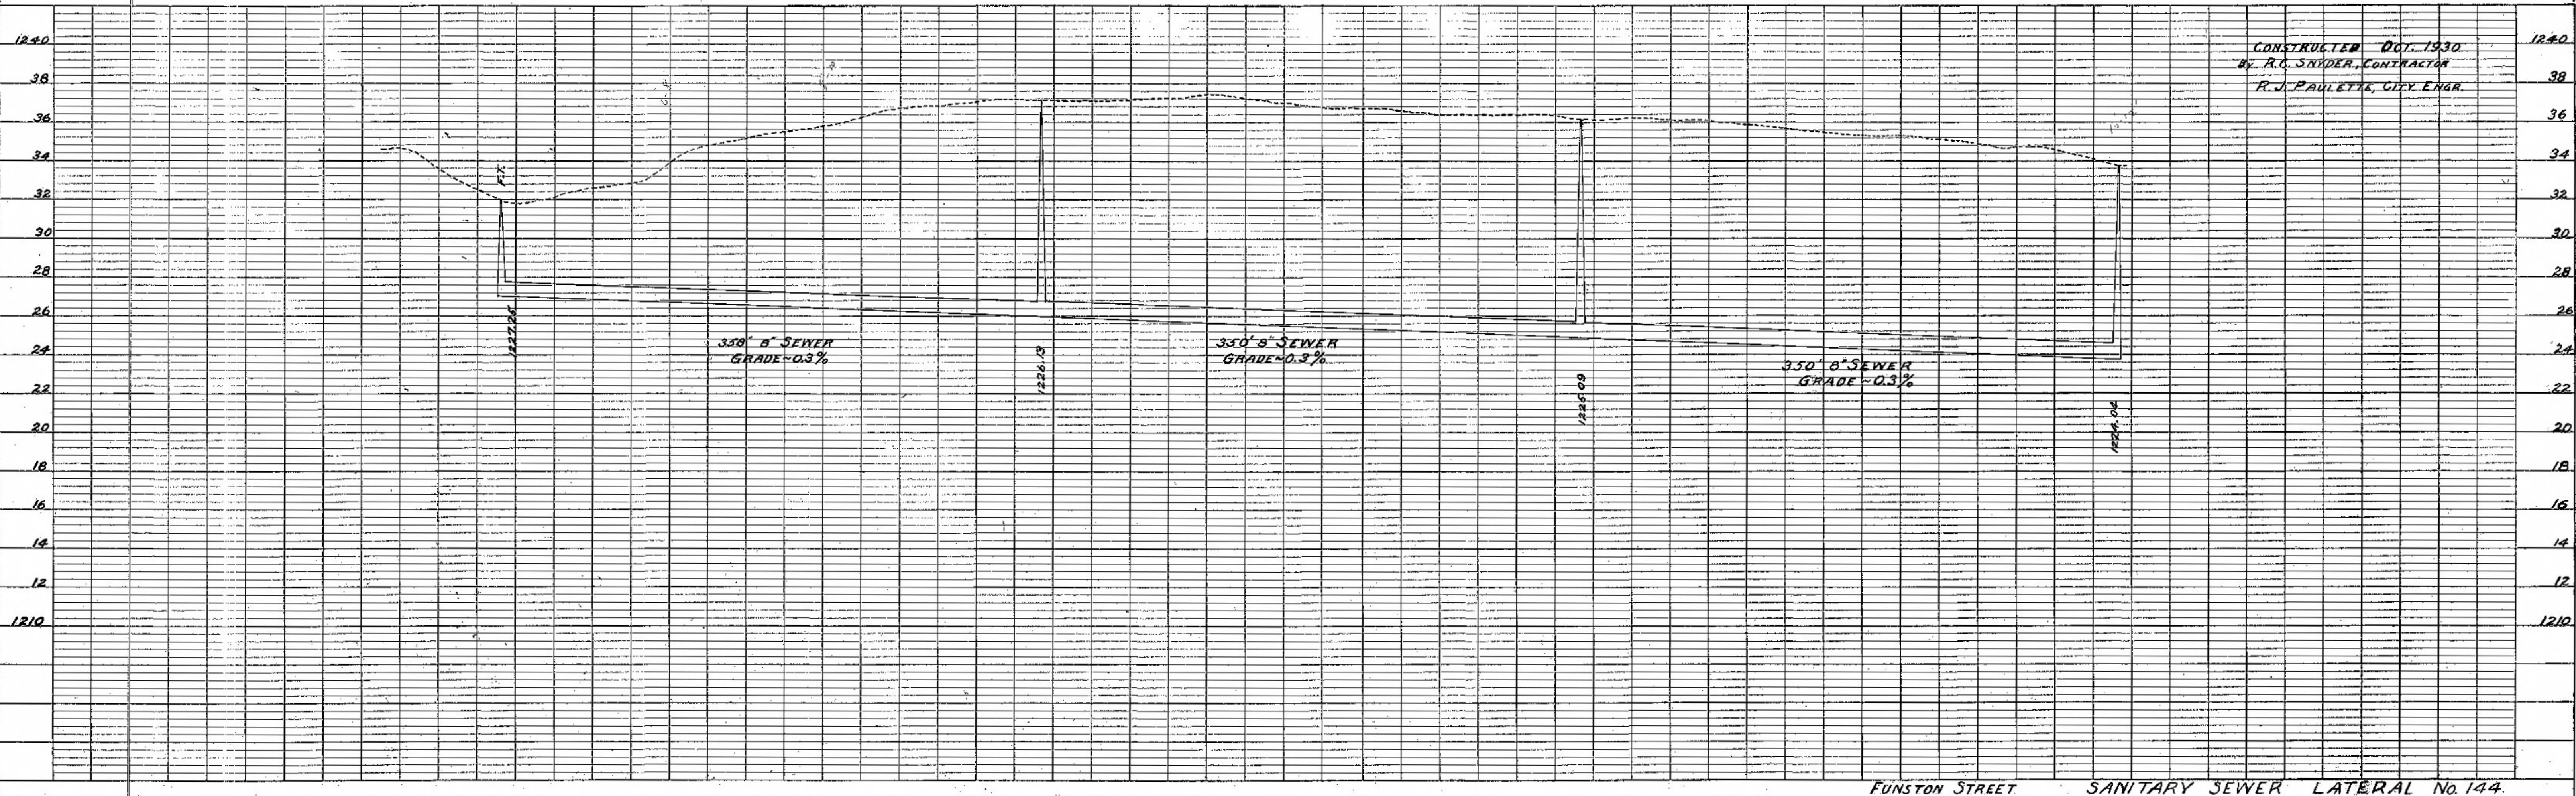

CONSTRUCTED DEC. 1930  
 BY R.C. SNIDER, CONTRACTOR  
 R.J. PAULETTE, CITY ENGR.

FUNSTON STREET SANITARY SEWER LATERAL No. 144.