



PLAN
 NOTE BOOK NO. _____
 SURVEYED BY L. A. CAMPBELL
 PLOTTED BY _____
 ALIGNED CHECKED BY _____
 REVISIONS CHECKED BY _____

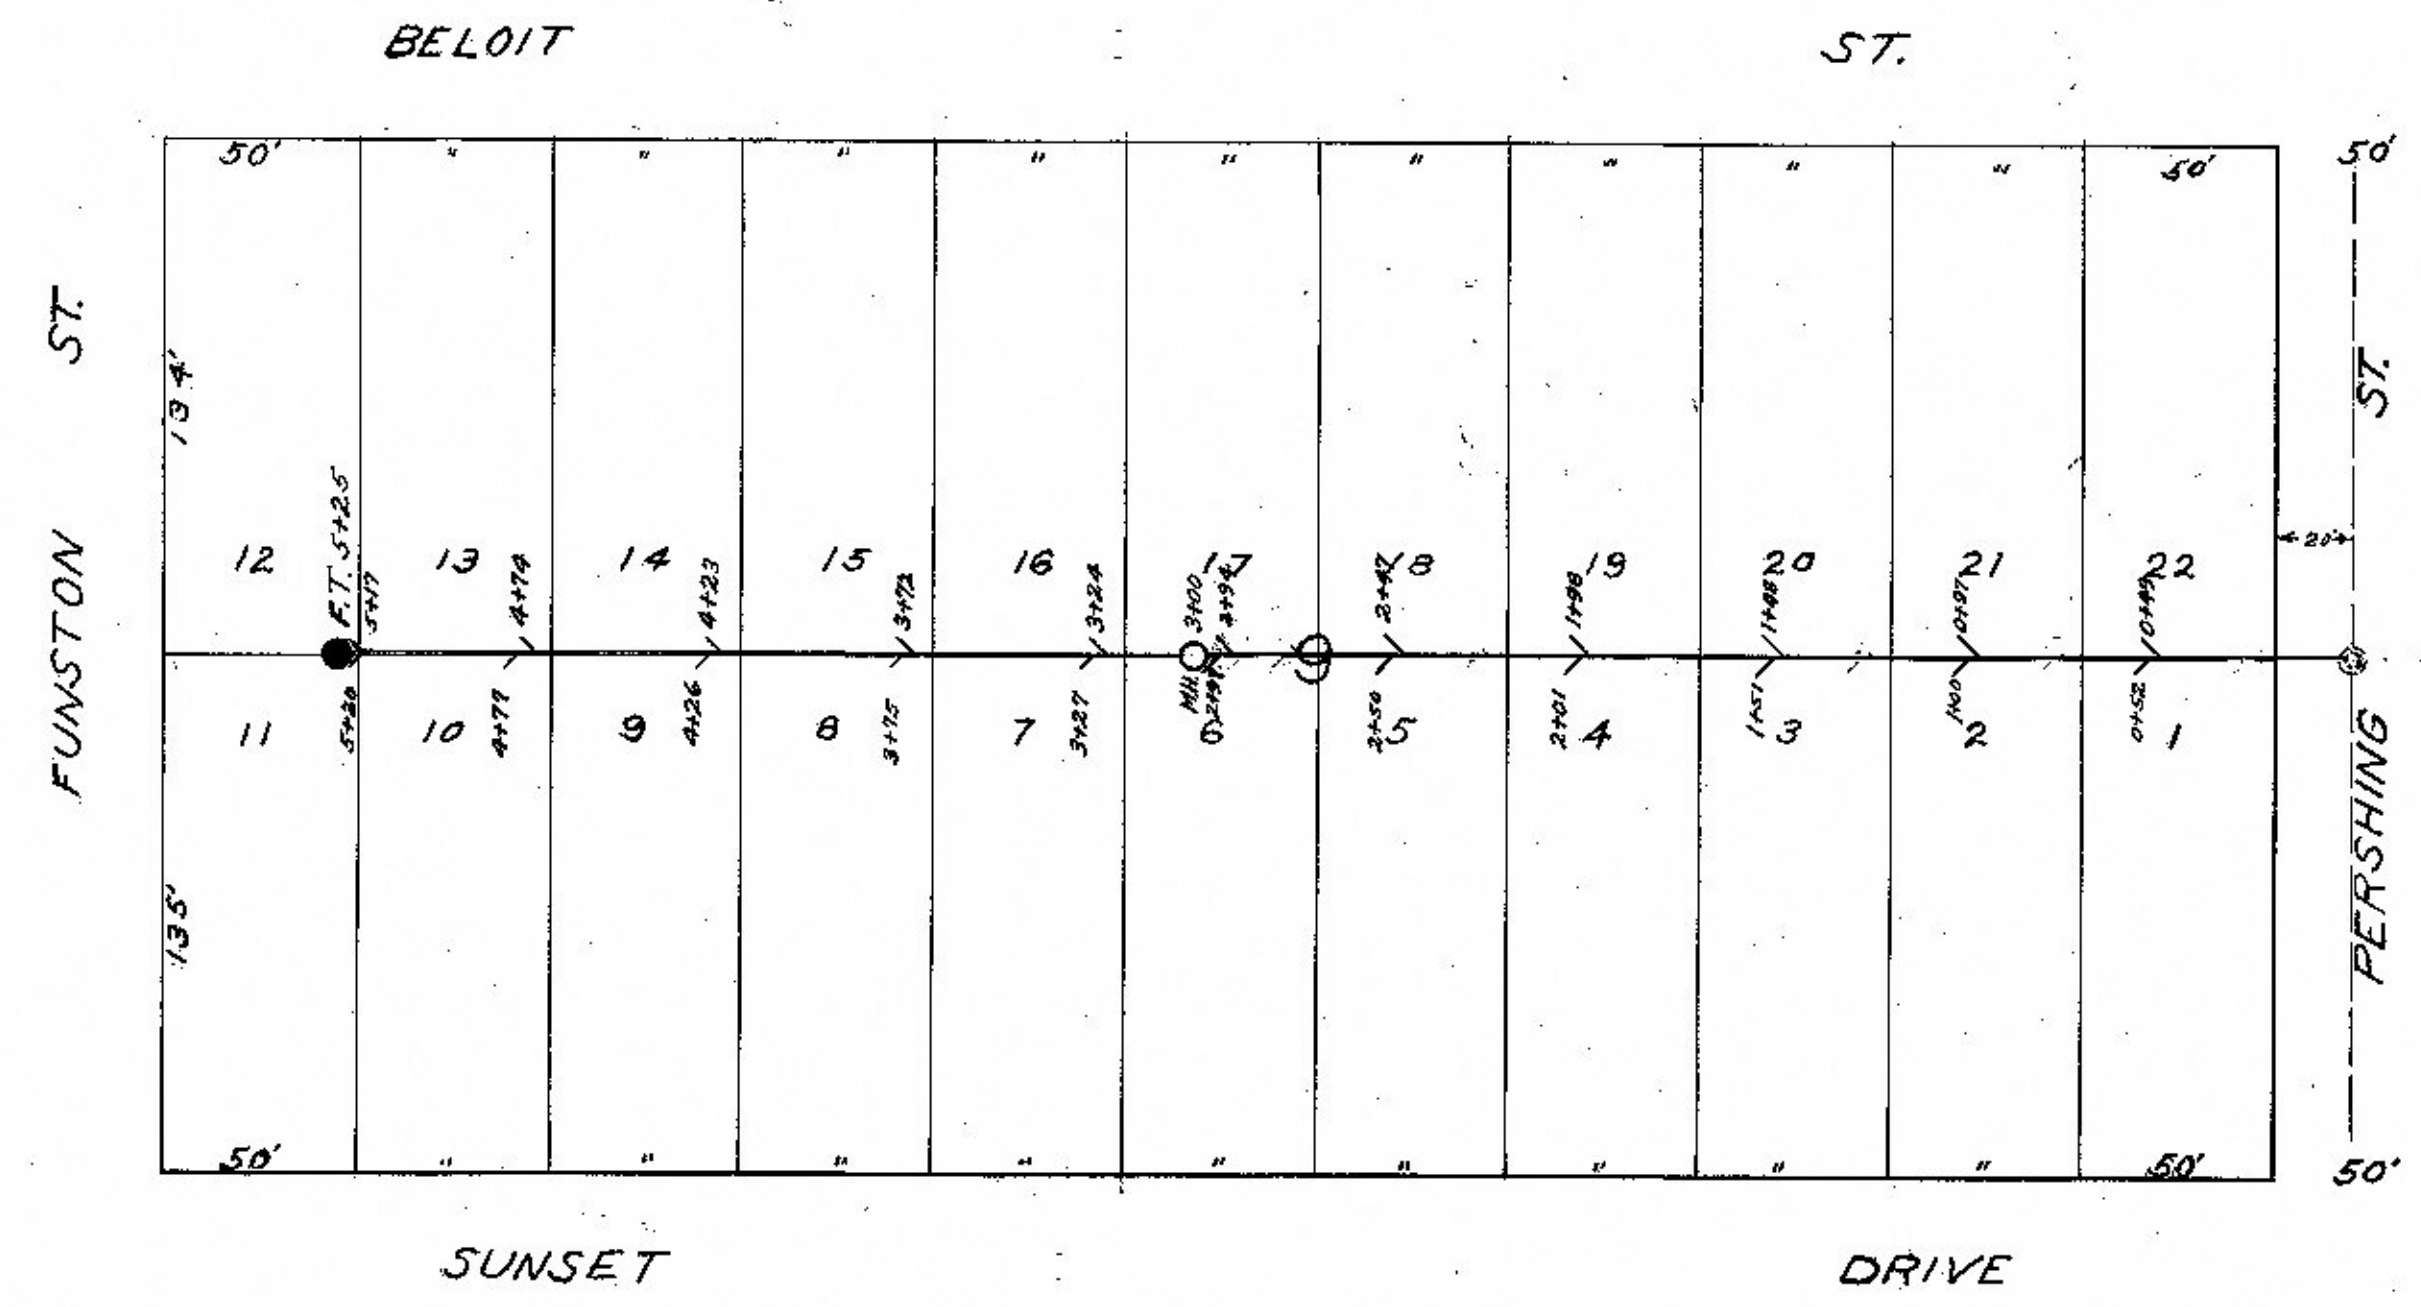

FILED
 SEP 29 1930
 CHAS. E. BARKER
 CITY ENGINEER

PROFILE
 NOTE BOOK NO. _____
 SURVEYED BY L. A. Campbell
 PLOTTED BY _____
 B.M. 101.00
 B.M. 102.00
 B.M. 103.00
 B.M. 200.00

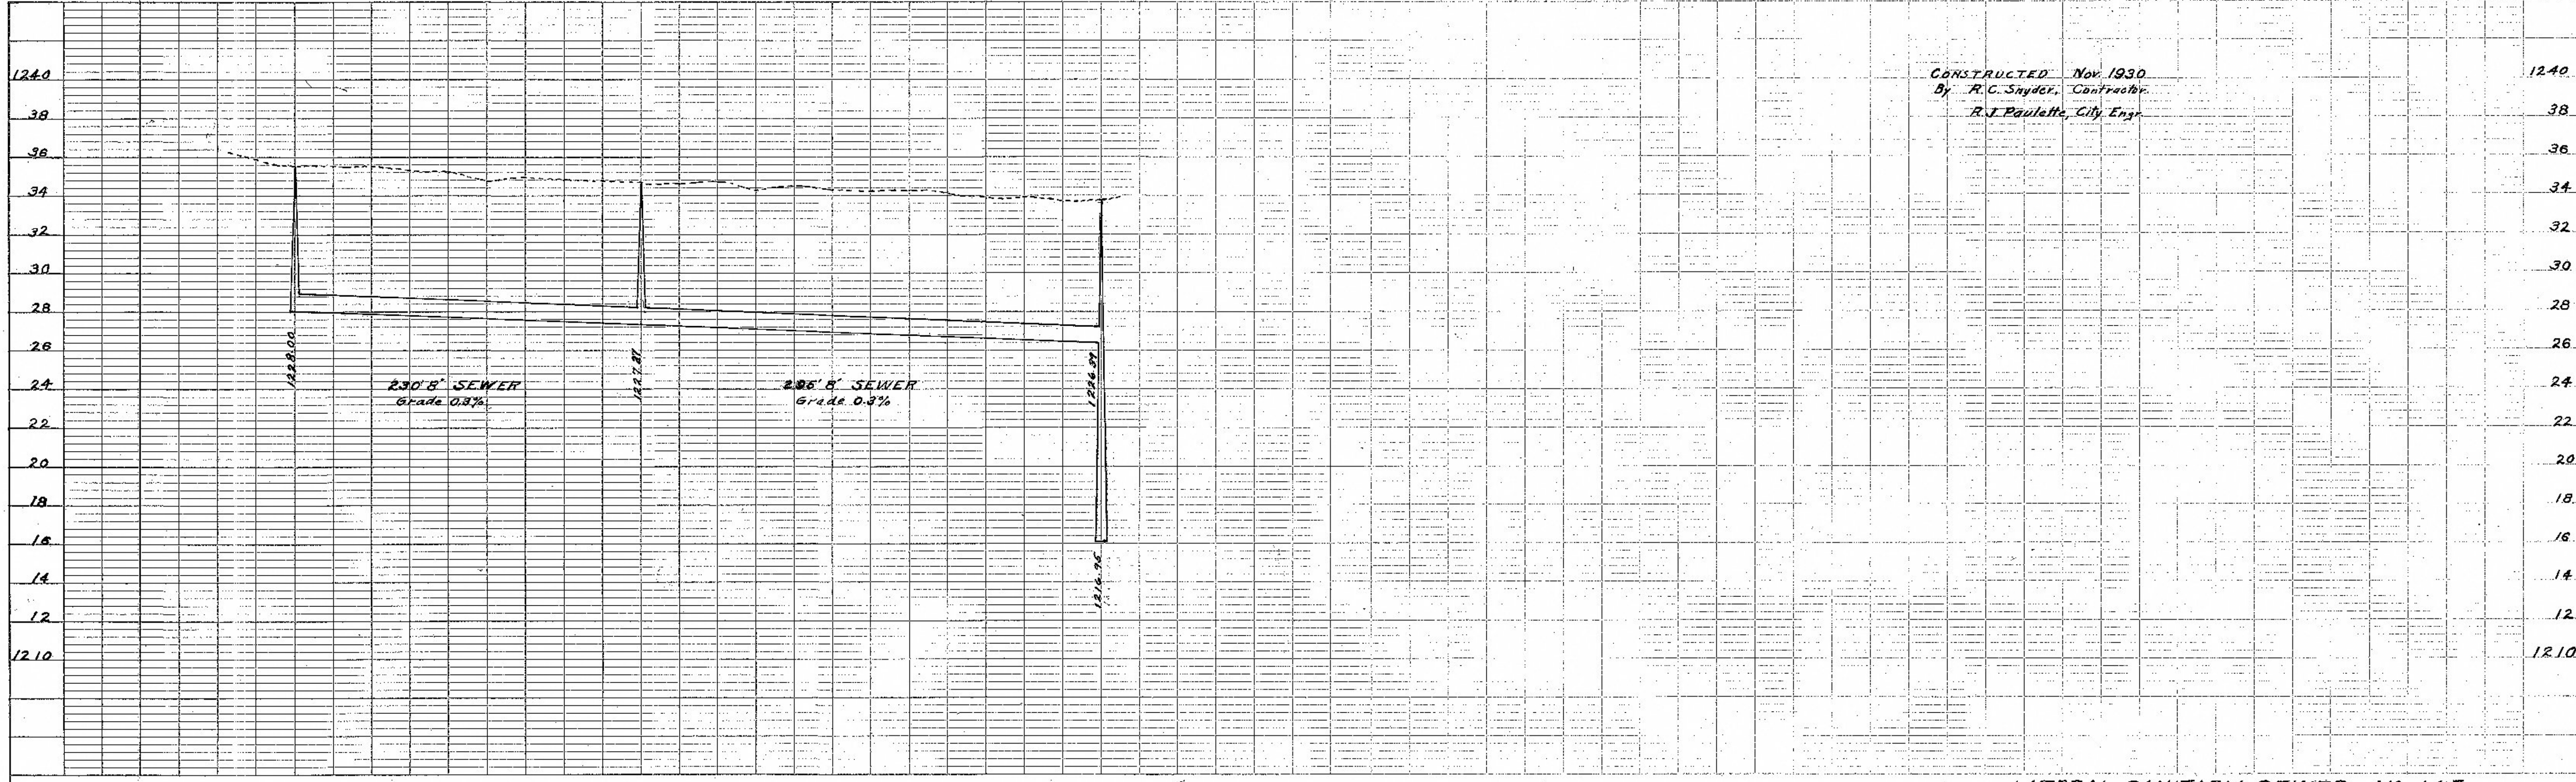

CONSTRUCTED Nov. 1930
 By R. C. Snyder, Contractor
 R. J. Paulette, City Engr.

LATERAL SANITARY SEWER NO. 145