


PLAN
 SURVEYED BY
 NOTE BOOK NO.
 PLOTTED BY
 CHECKED BY
 RT. OF WAY CHECKED BY

PROFILE
 SURVEYED BY
 NOTE BOOK NO.
 GRADES CHECKED BY
 B. M. S. NOTED BY
 PLOTTED BY
 CHECKED BY
 RT. OF WAY CHECKED BY

FILED
 SEP 29 1930
 CHAS. E. BANKER
 CITY ENGINEER

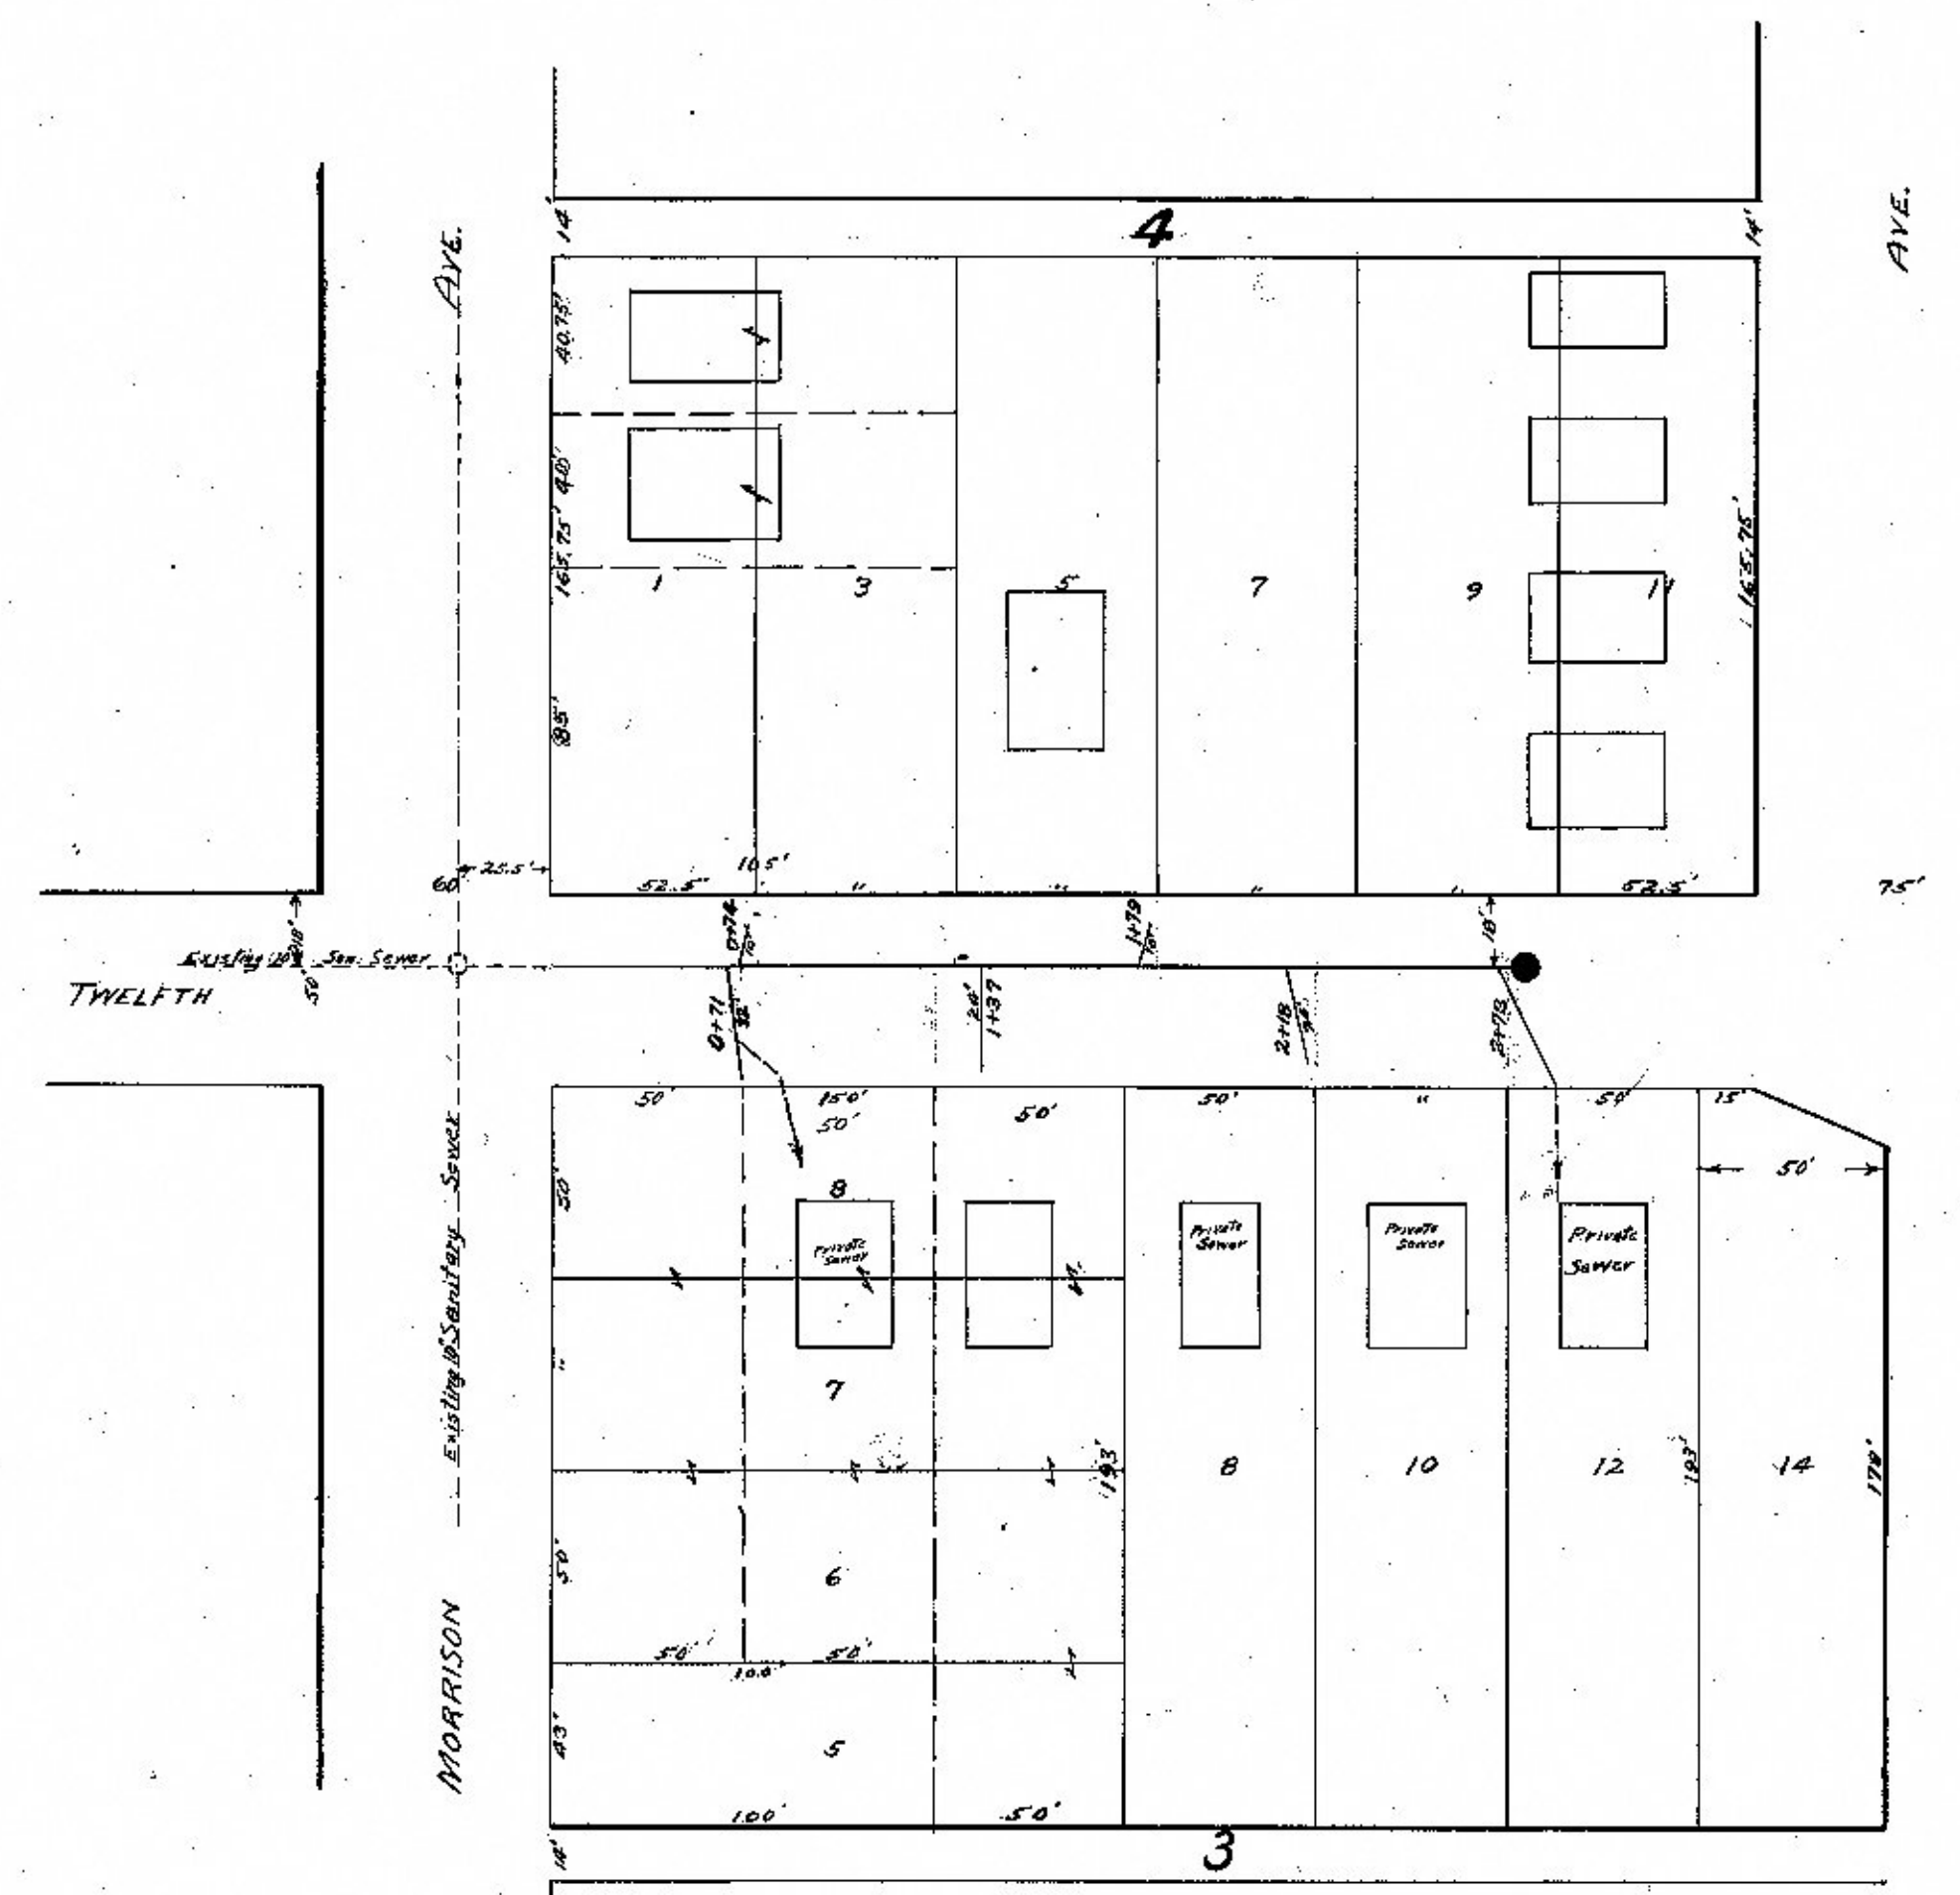

Note: All 6" Services Are 6' deep at sidewalk and approx. 8' deep at Wye. No risers.
 Constructed Nov. 1930
 Constructed By R.C. Snyder
 Engineer R.J. Paulath City Engr.

