

PLAN	SURVEYER	DATE
	NOTE BOOK NO.	BY
FLOTTED		DATE
ALIGNMENT CHECKED		
BY		

PROFILE	SURVEYED	DATE
	NOTE BOOK NO.	BY
FLOTTED		DATE
ALIGNMENT CHECKED		
BY		

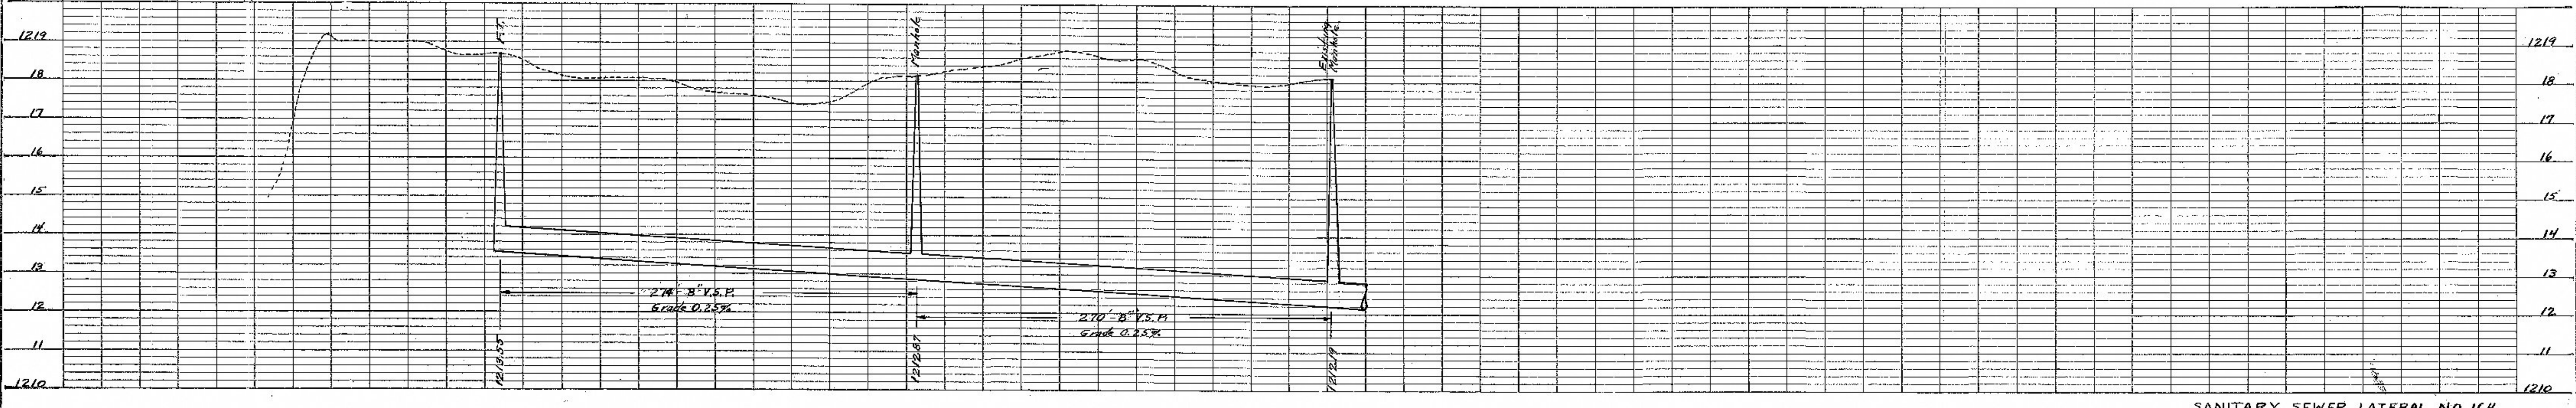
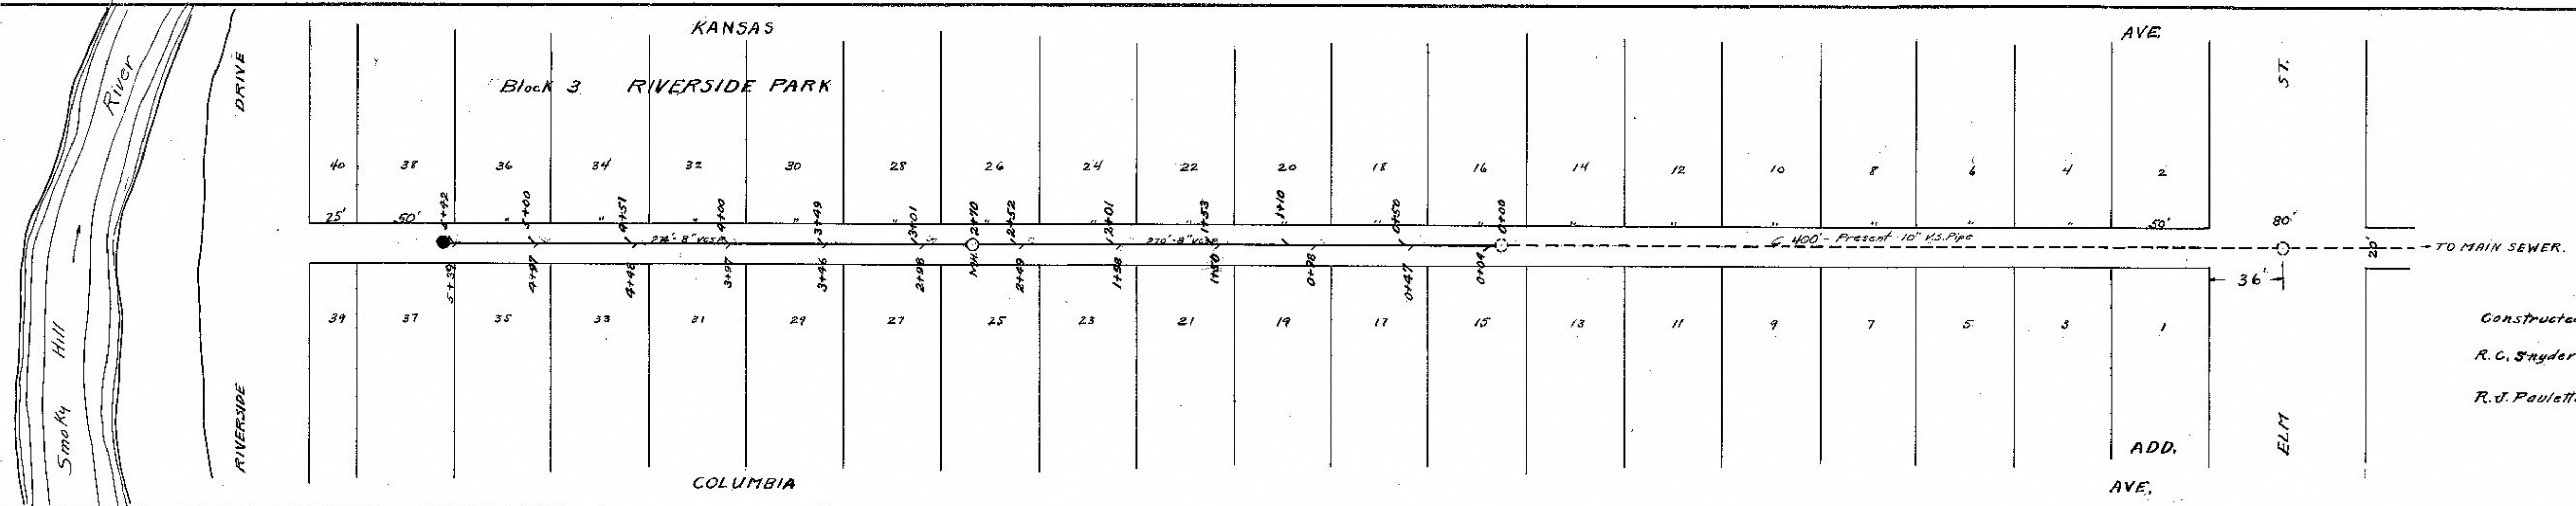
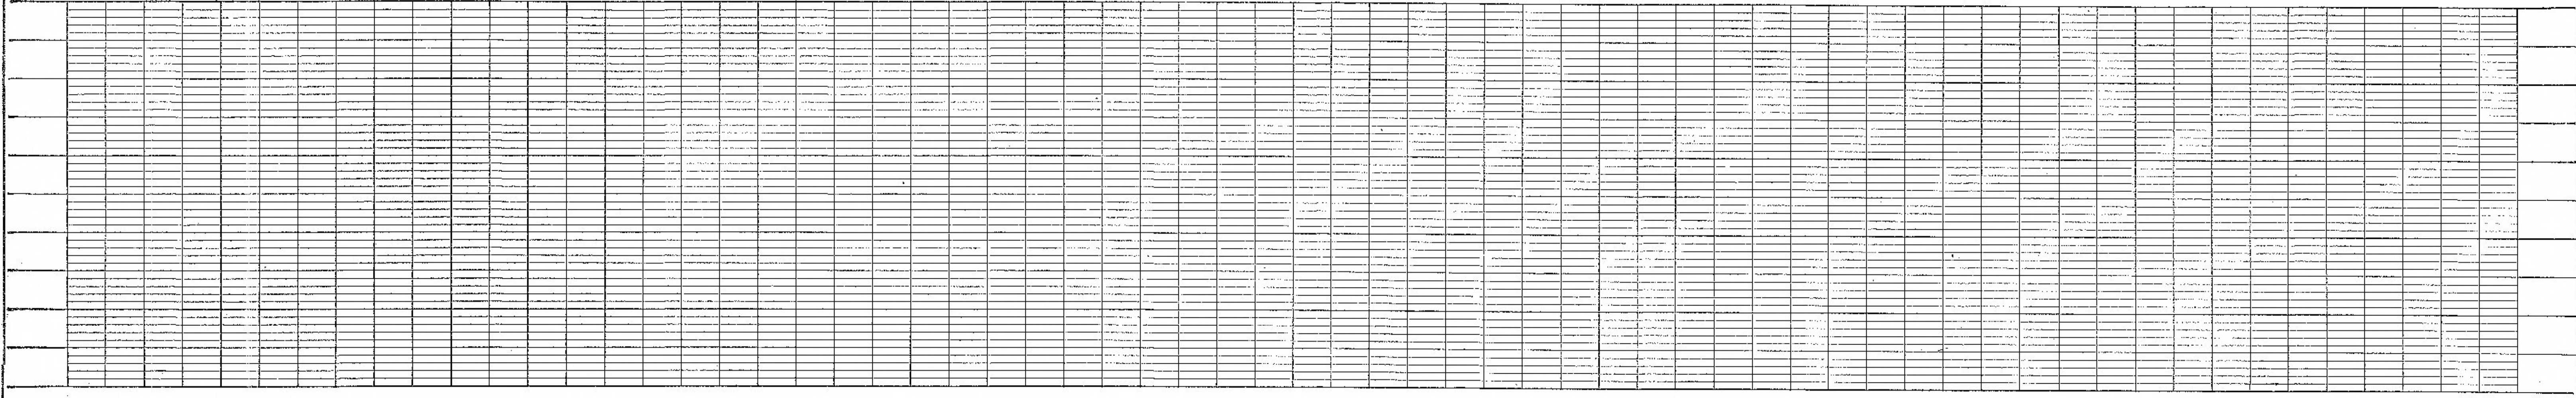


PLATE 2-PLAN-PROFILE B. P. R. STANDARD

SANITARY SEWER LATERAL NO. 164