



PLAN	SURVEYED	DATE
NOTE BOOK	PLOTTED	
	CHECKED	
	BY CITY ENGINEER	
	NO. OF WAY CHECKED	

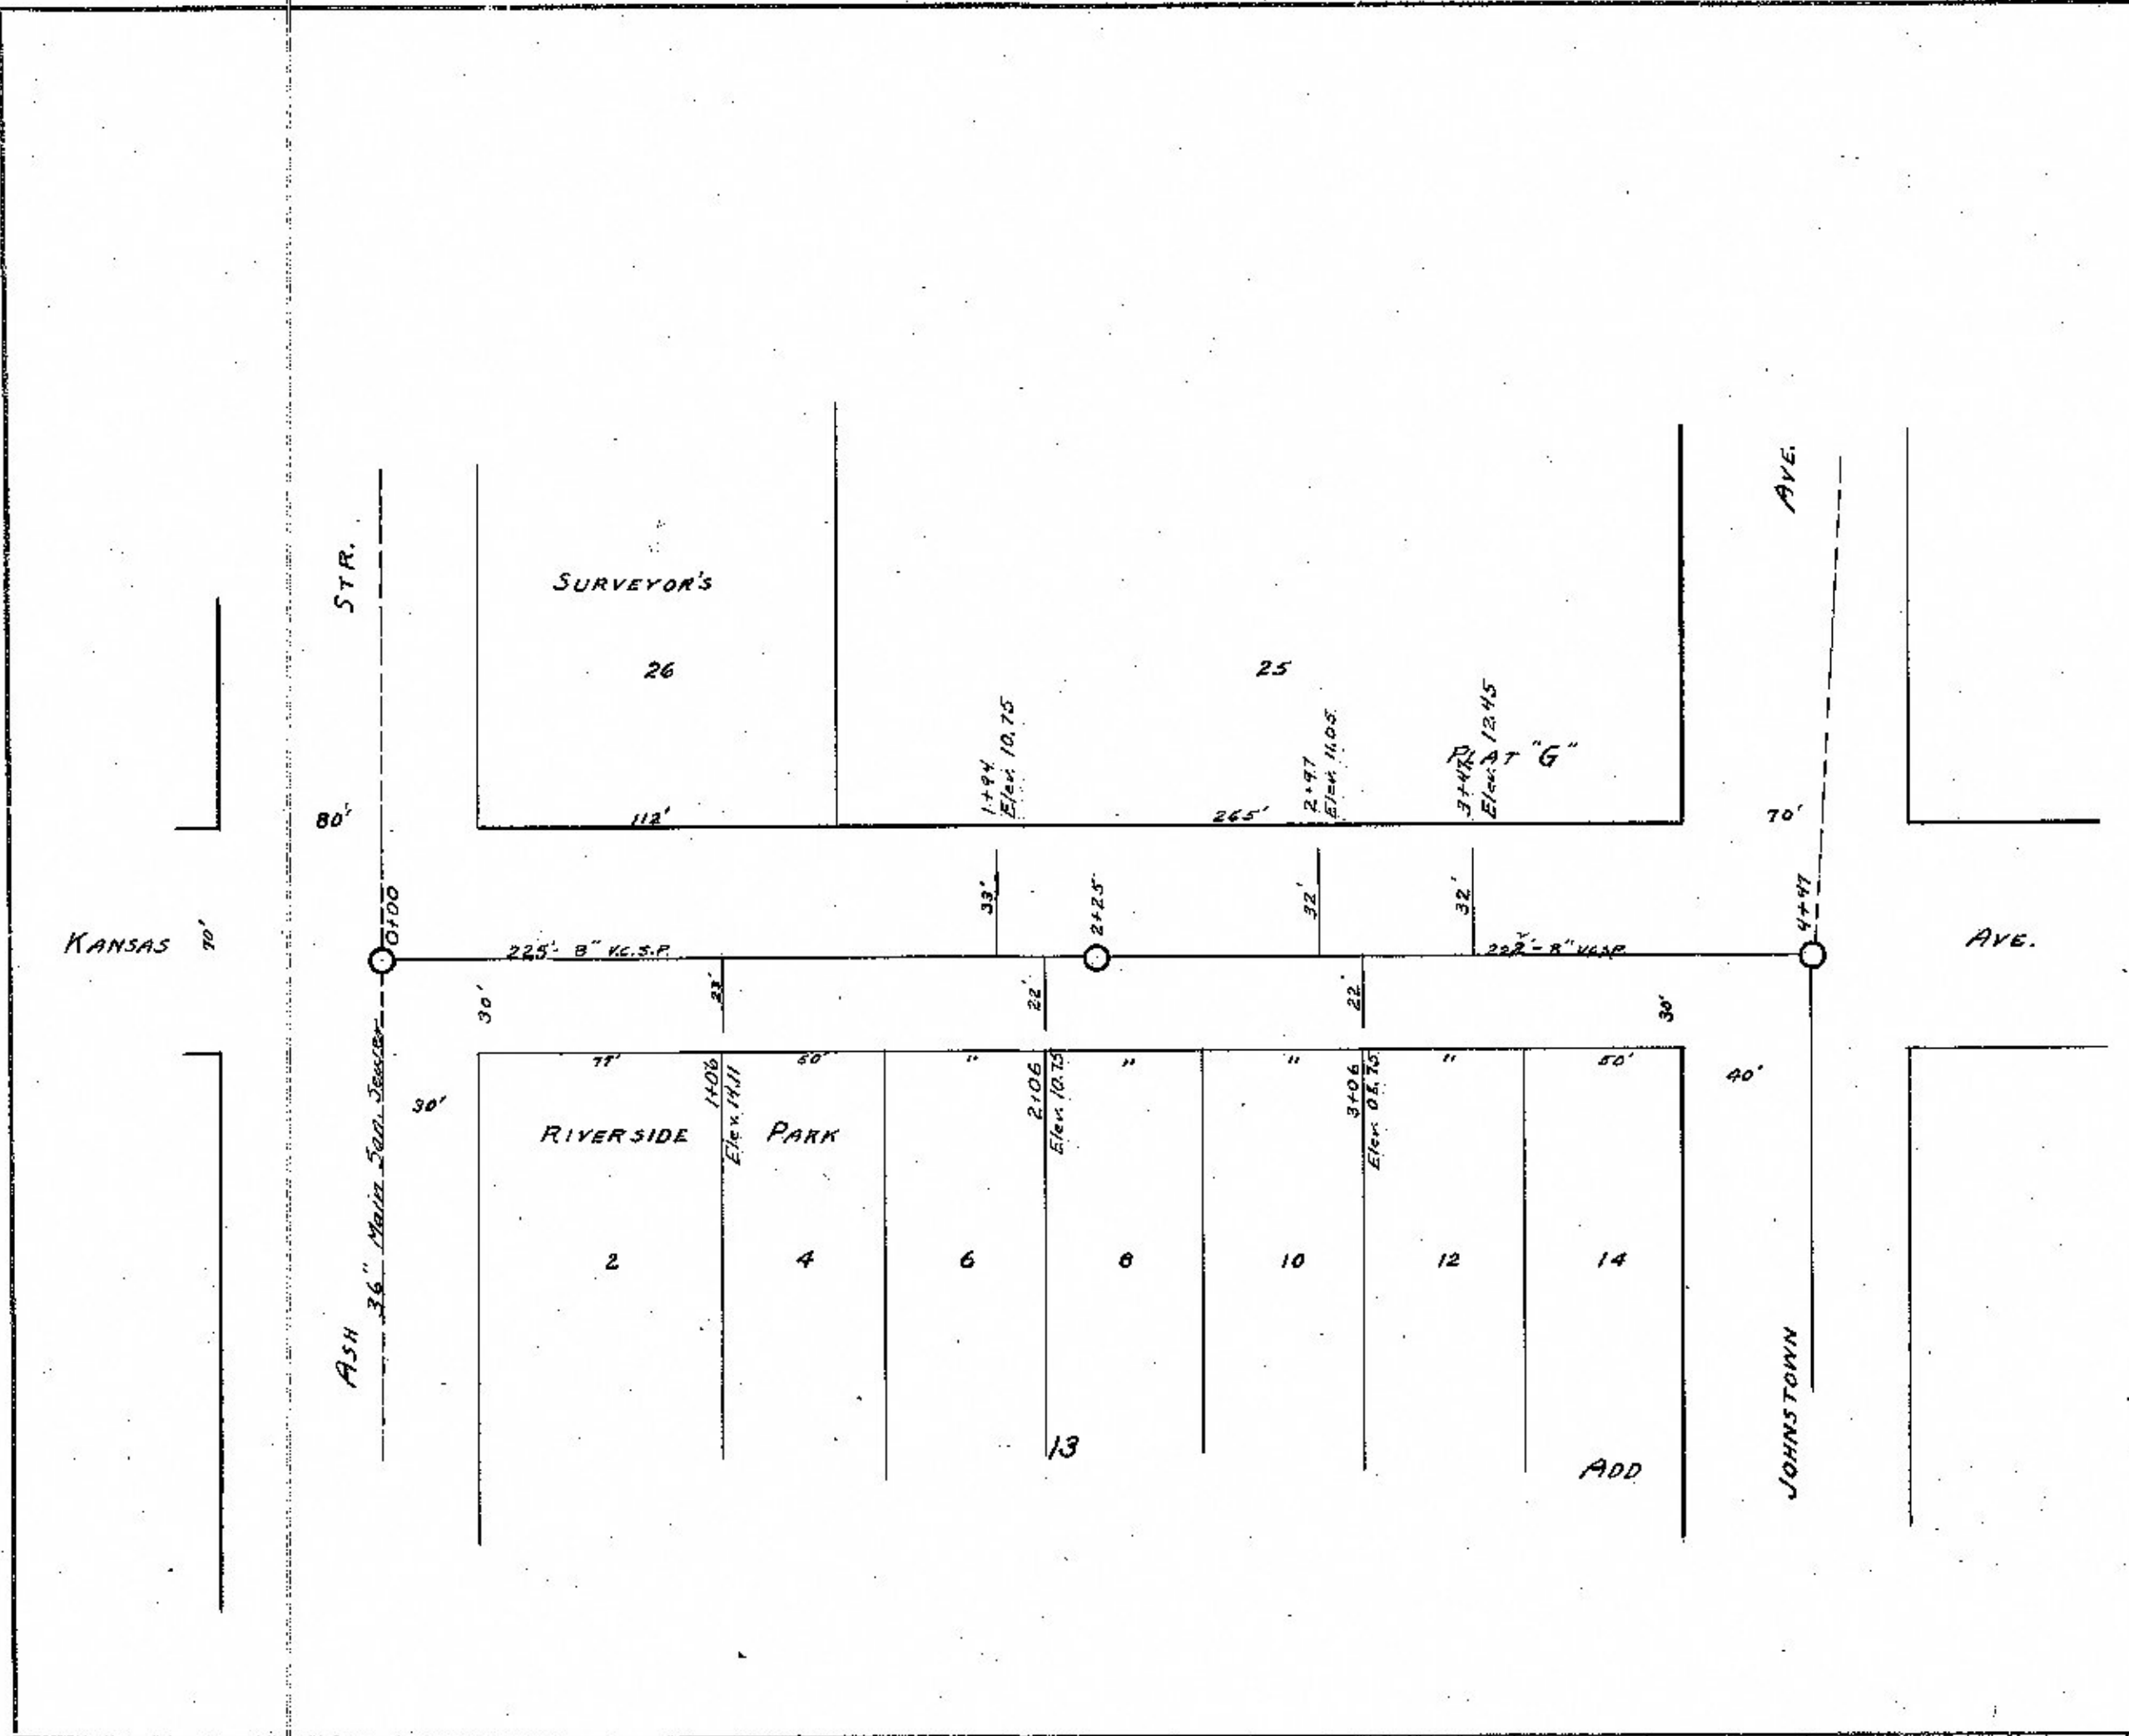

PROFILE	SURVEYED	DATE
NOTE BOOK	PLOTTED	
	CHECKED	
	BY CITY ENGINEER	
	NO. OF WAY CHECKED	

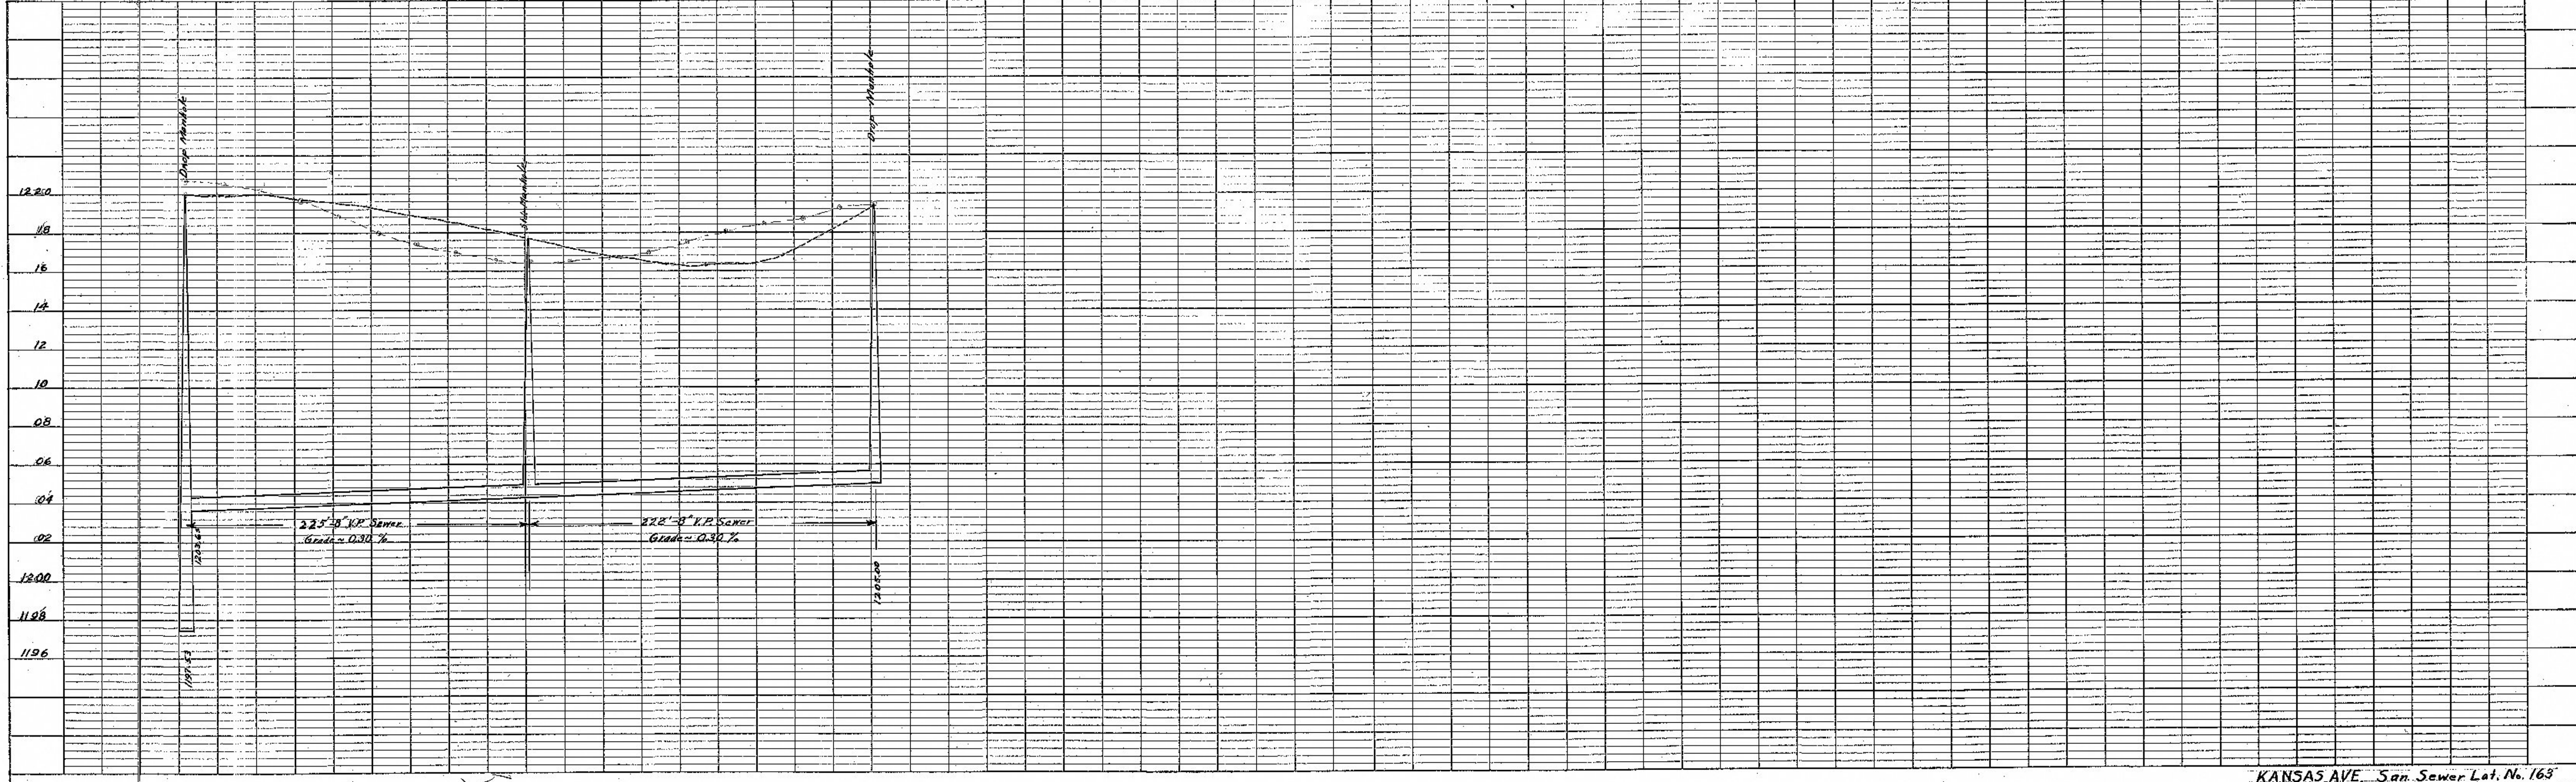

KANSAS AVE. San. Sewer Lat. No. 163