
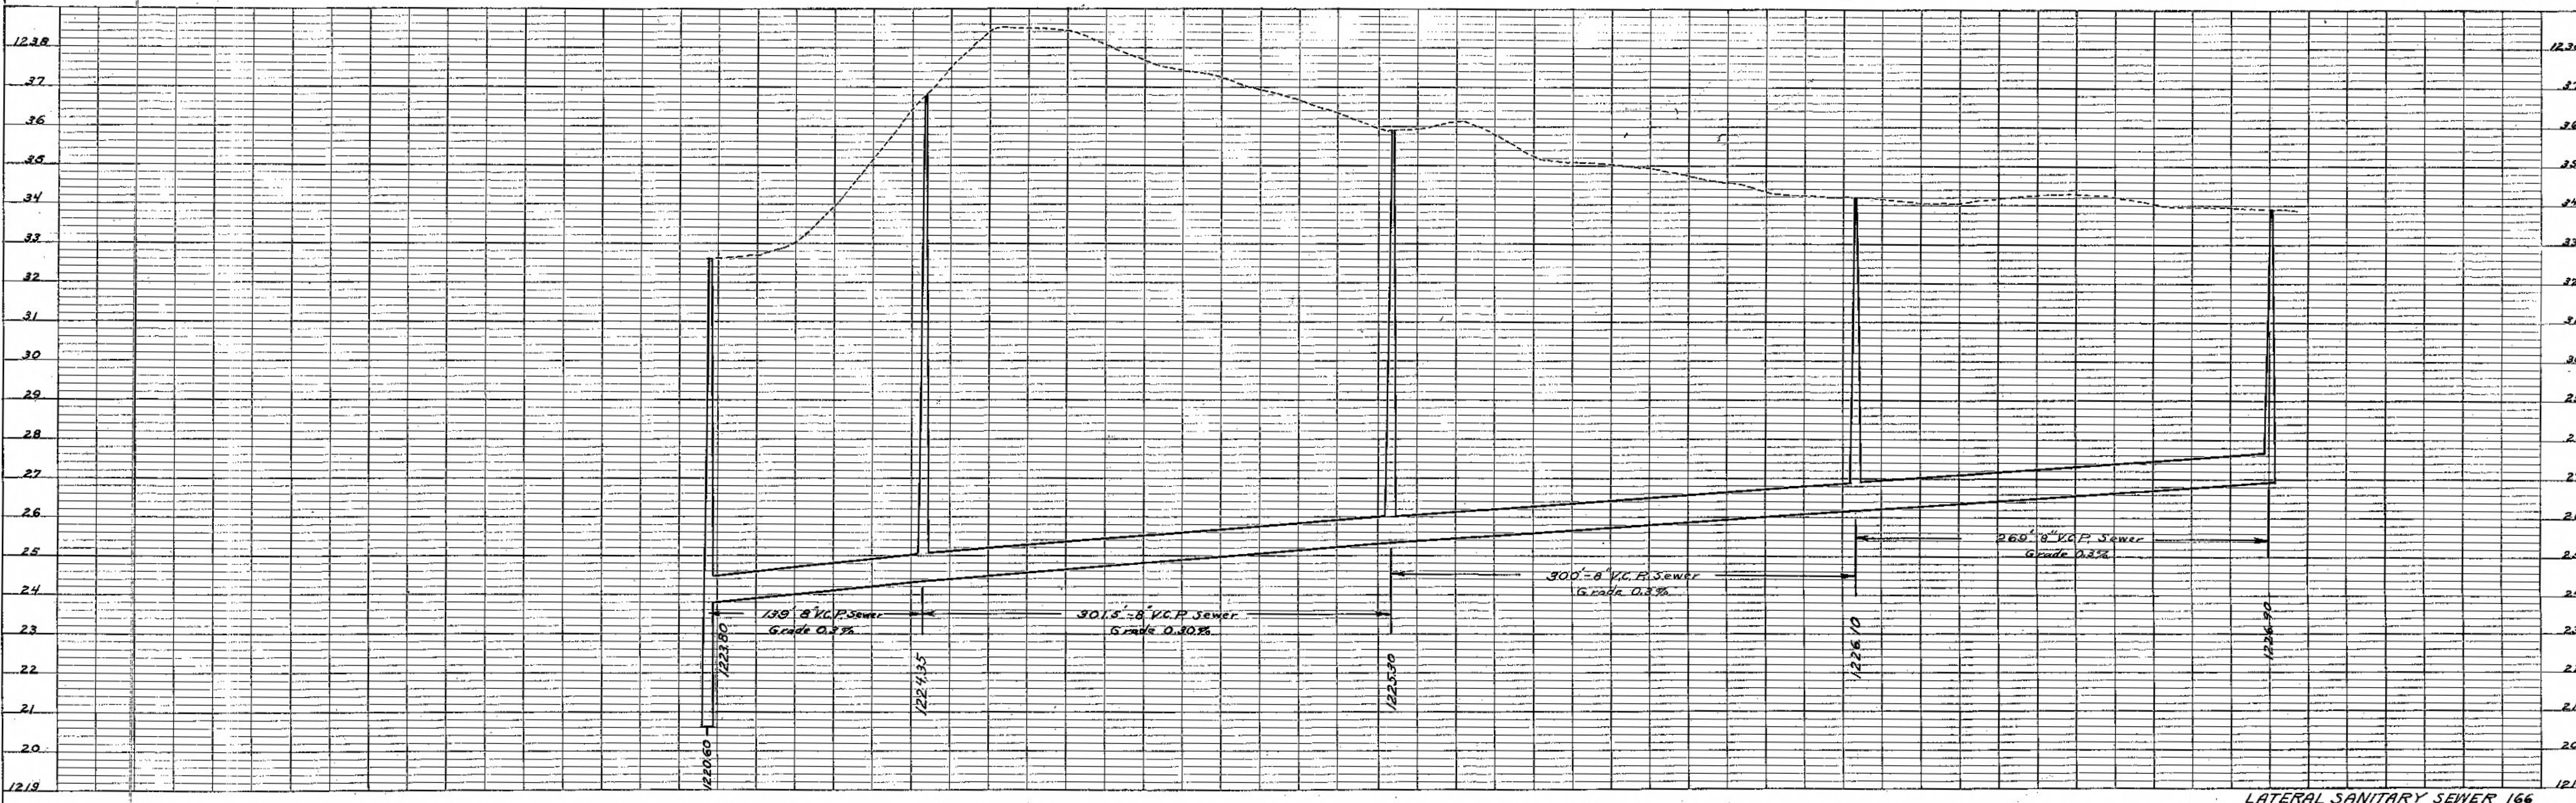


PLAN  
DATE  
BY  
SURVEYED  
NOTE BOOK  
PLOTTED  
ALIGNED  
CHECKED  
BY  
NO.

PROFILE  
DATE  
BY  
SURVEYED  
NOTE BOOK  
PLOTTED  
ALIGNED  
CHECKED  
BY  
NO.

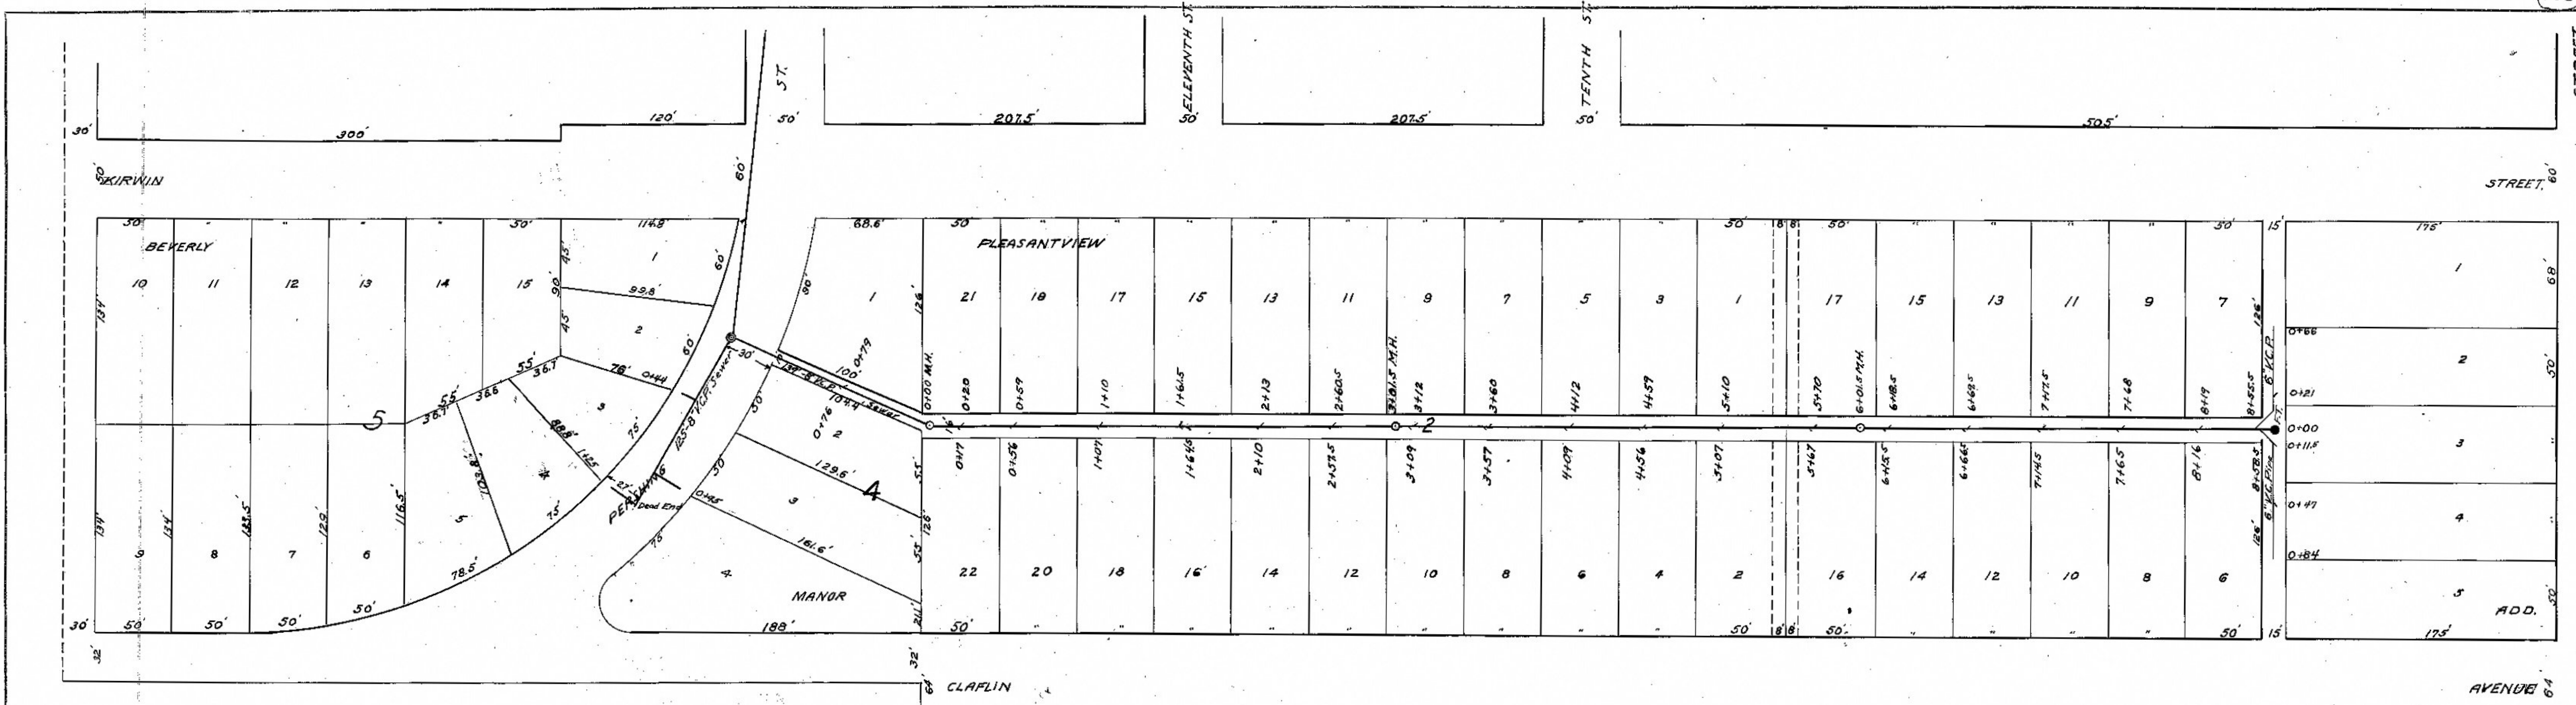

LATERAL SANITARY SEWER 166