


PLAN
 SHEET NO. 140
 DATE 1932



Constructed Nov. 1932
 By H.J. Taylor Const. Co. - Contractor
 H.N. Lamme City Engineer

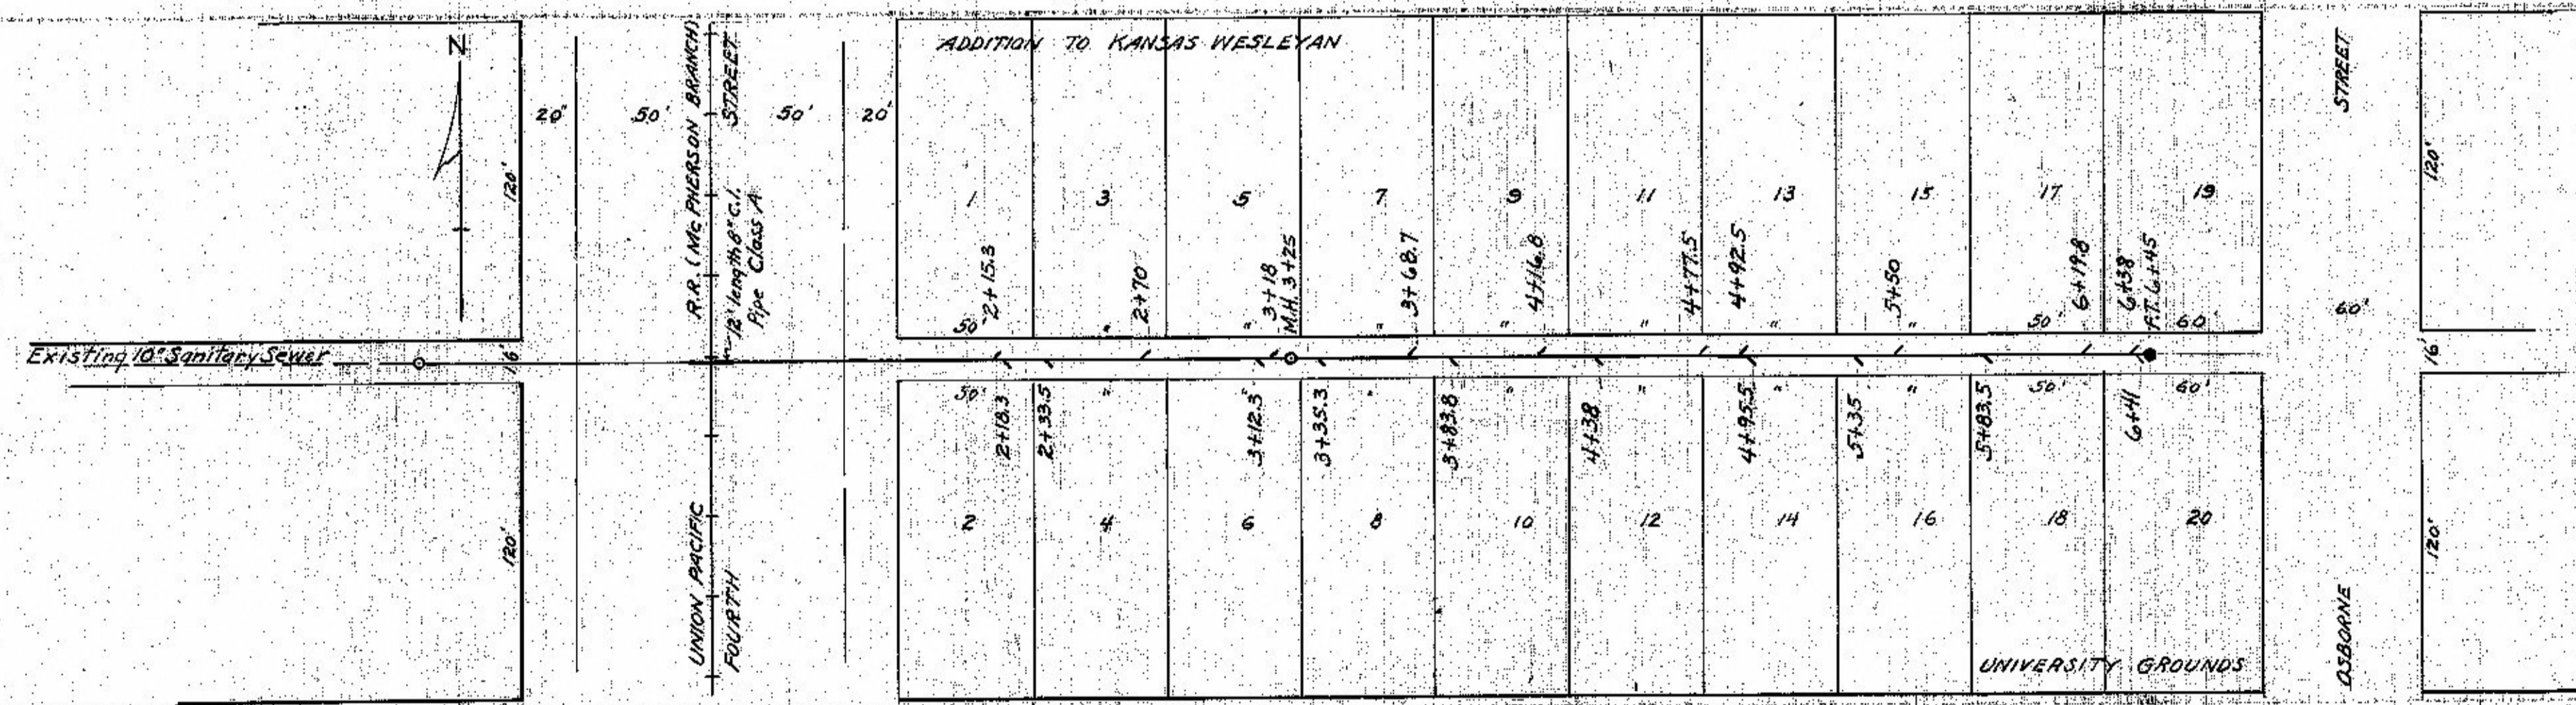