

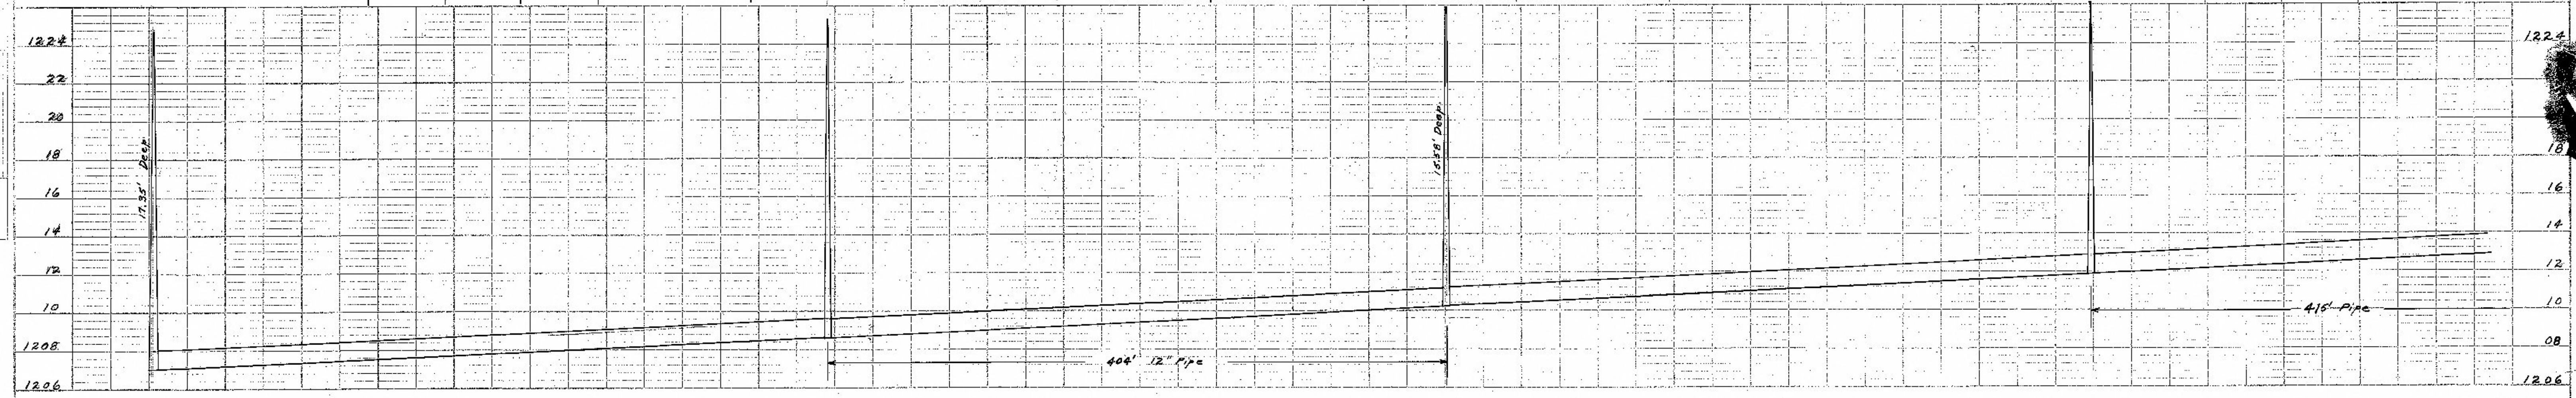
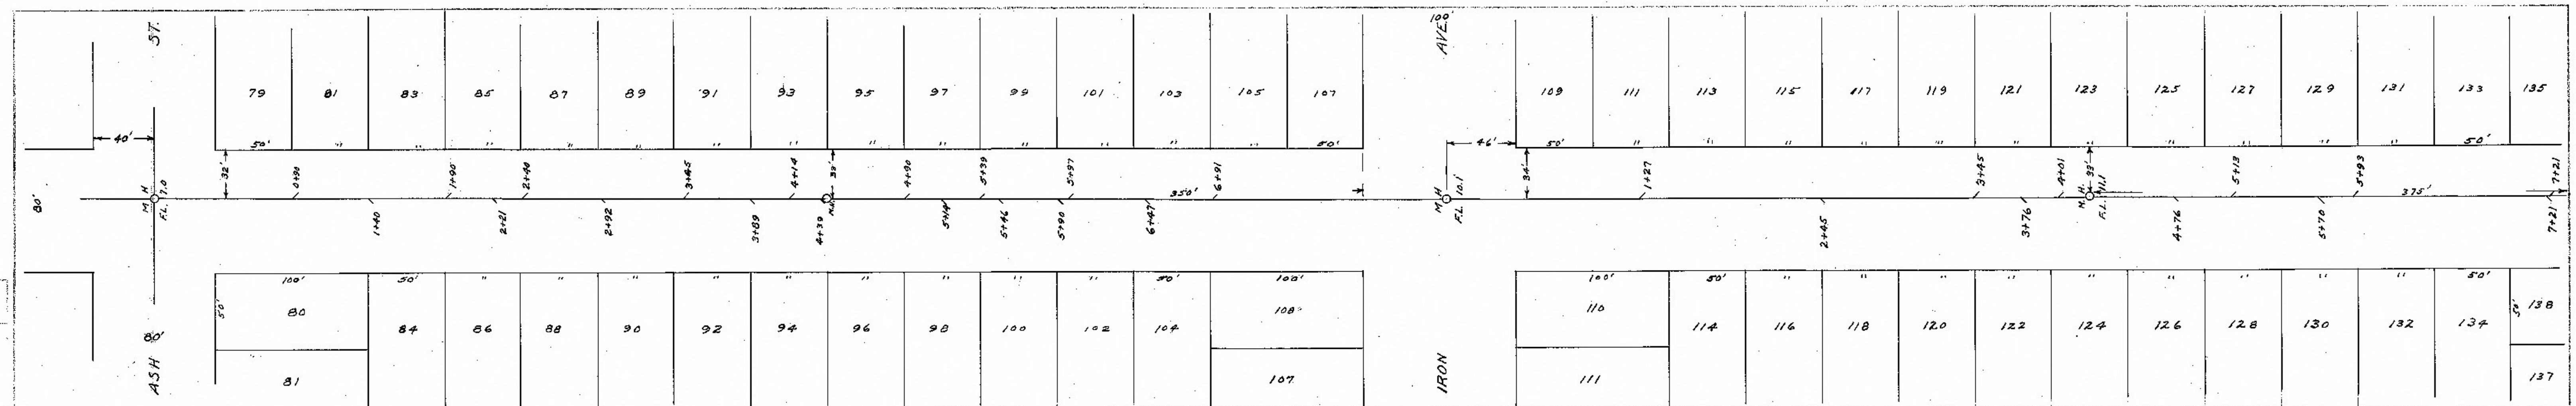


PLAN
 ELEVATED
 NOTES:
 1. SEE PLAN FOR ALL DIMENSIONS
 2. SEE PLAN FOR ALL DIMENSIONS

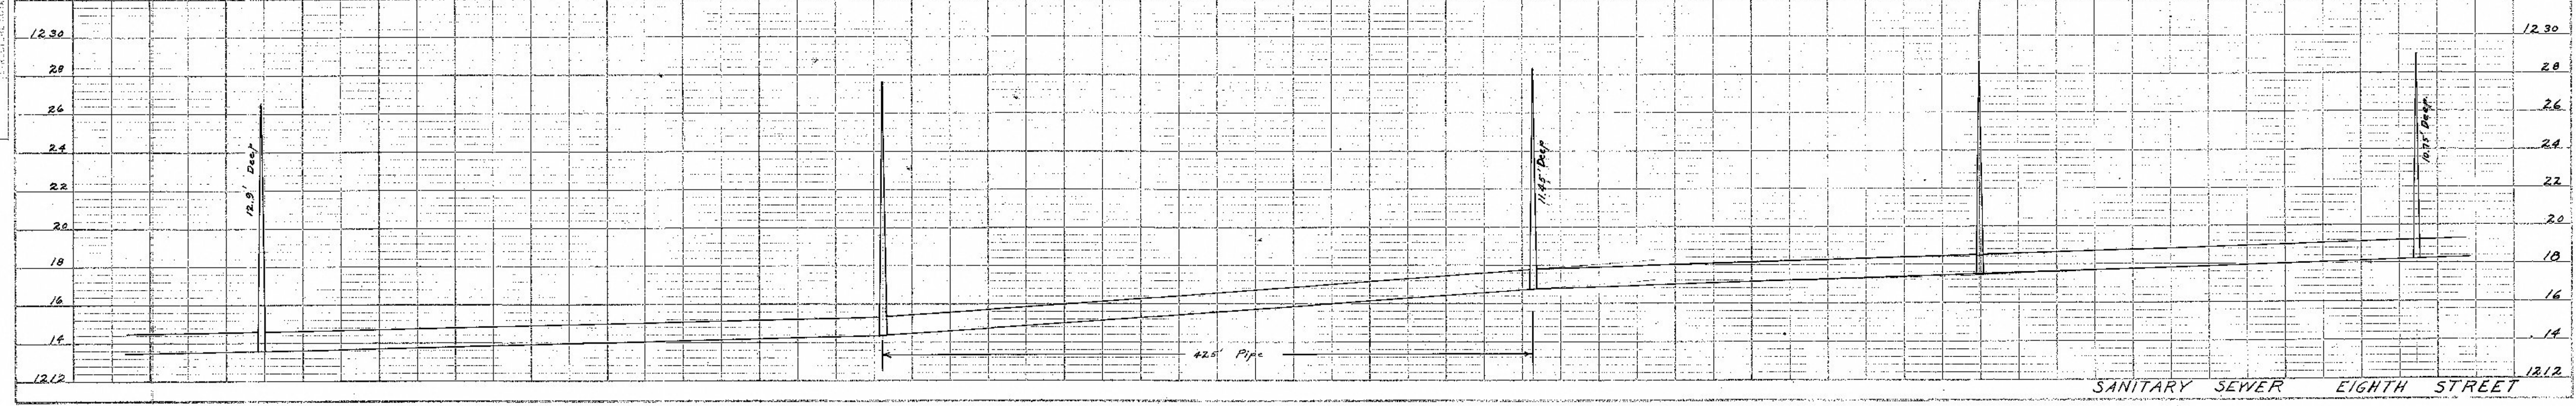

PROFILE
 ELEVATED
 NOTES:
 1. SEE PLAN FOR ALL DIMENSIONS
 2. SEE PLAN FOR ALL DIMENSIONS

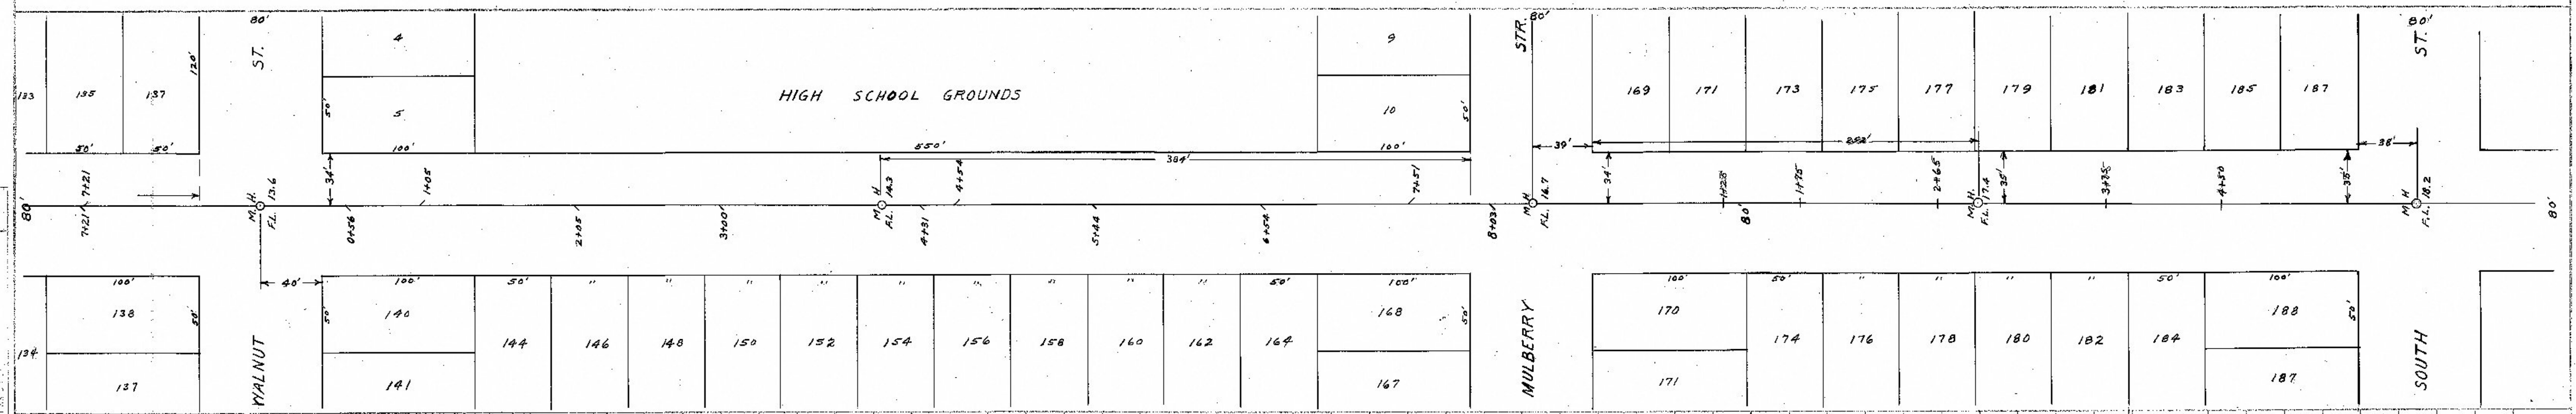

SANITARY SEWER EIGHTH STREET