



FILED (Prelim. Plans)
June 10, 1936
Charles E. Bonker
City Clerk

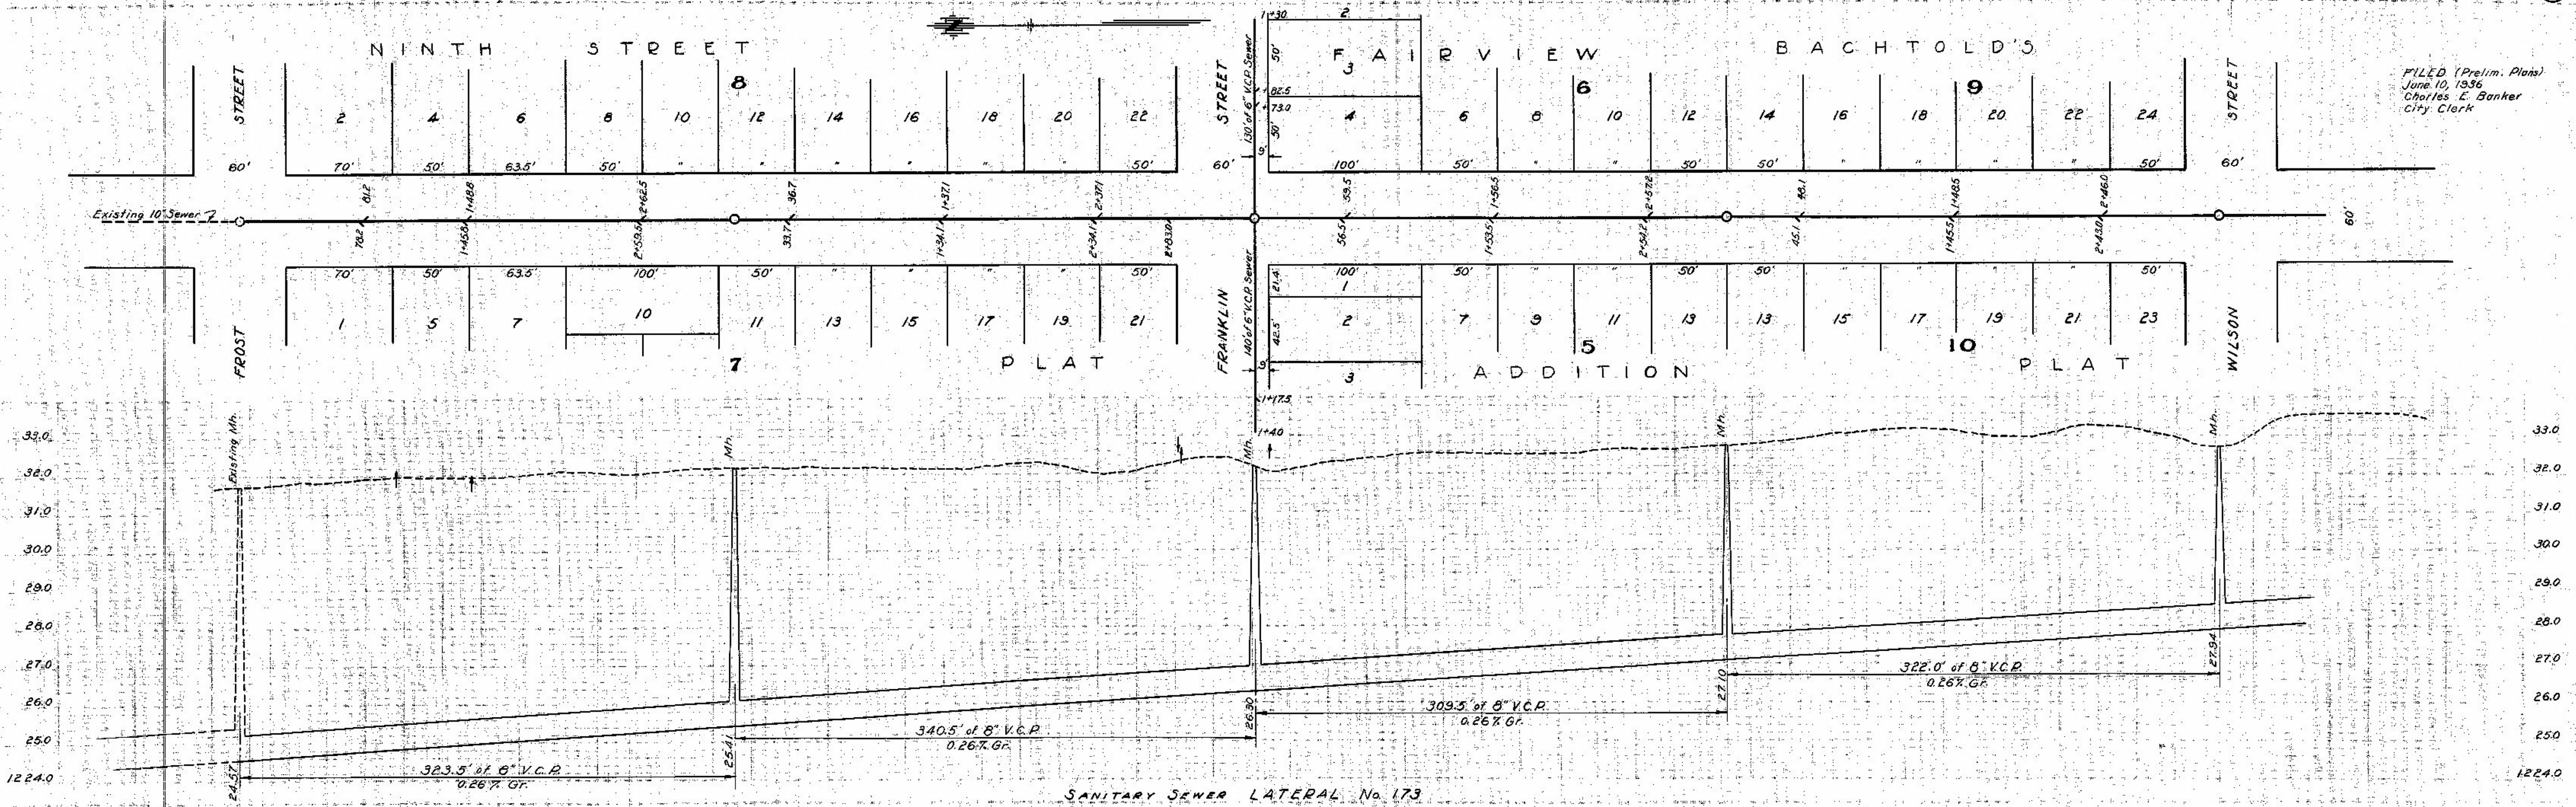

SANITARY SEWER LATERAL No. 173

J. T. Hoyle
Jun 30
Wm P. Simpson
5-10-36

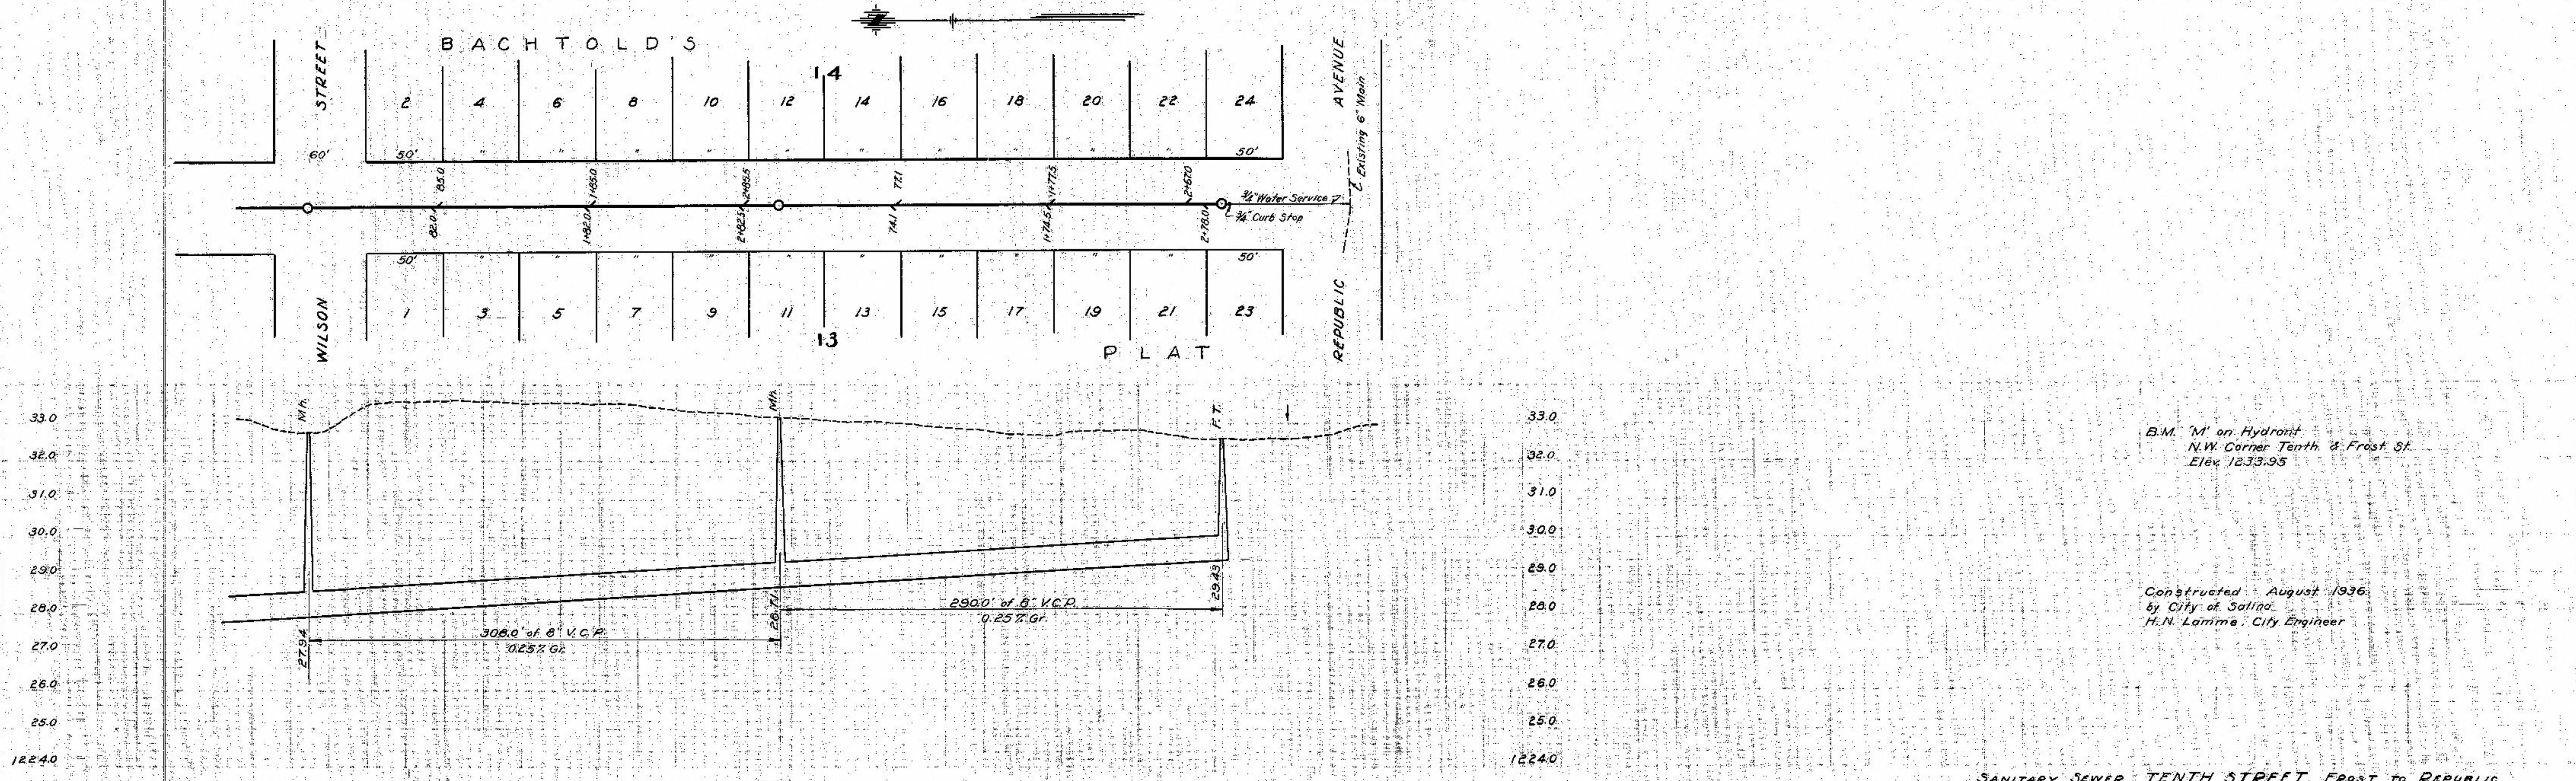

SANITARY SEWER LATERAL No. 173

SANITARY SEWER TENTH STREET FROST TO REPUBLIC

B.M. 'M' on Hydrant
N.W. Corner Tenth & Frost St.
Elev. 1233.95

Constructed August 1936
by City of Salina
H. N. Lammie, City Engineer