



PLAN
 DATE: _____
 DRAWN BY: _____
 CHECKED BY: _____
 TITLE: _____
 NO. _____

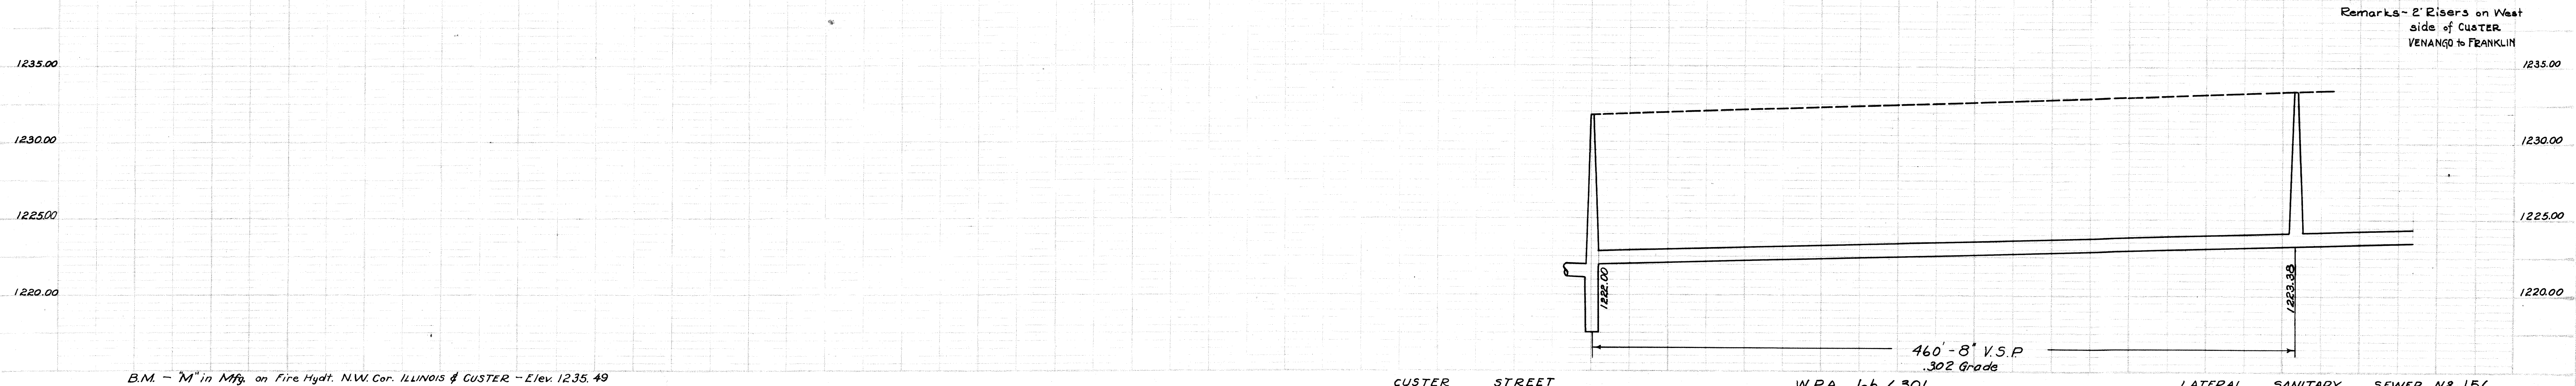

PROFILE
 DATE: _____
 DRAWN BY: _____
 CHECKED BY: _____
 TITLE: _____
 NO. _____

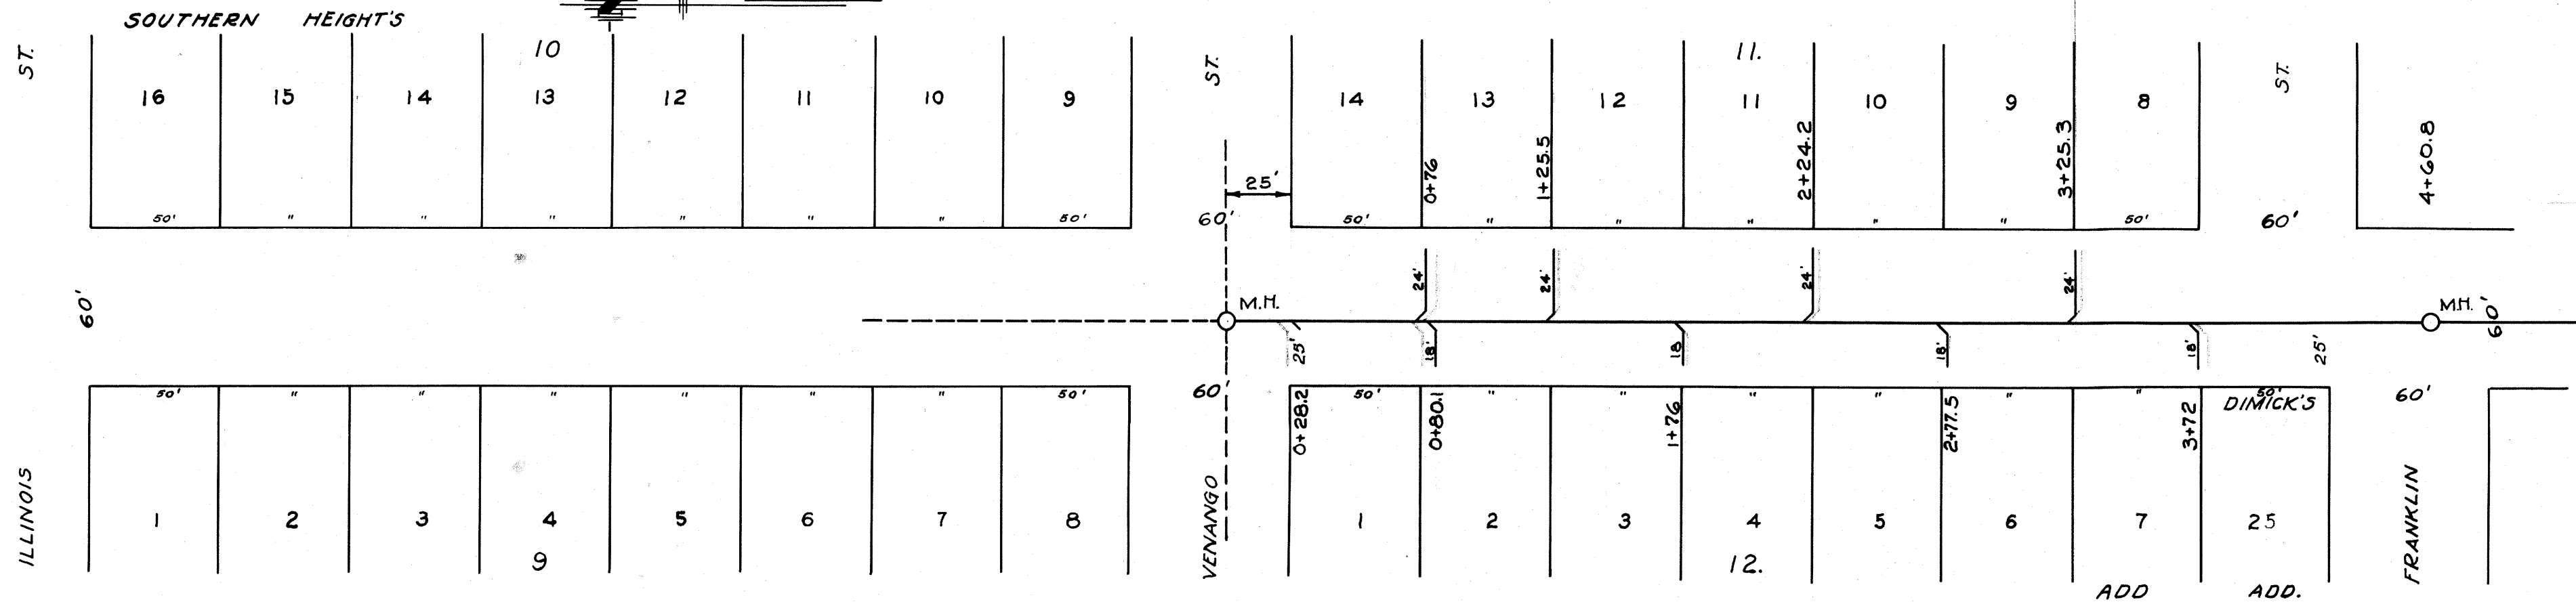