


Preliminary Design

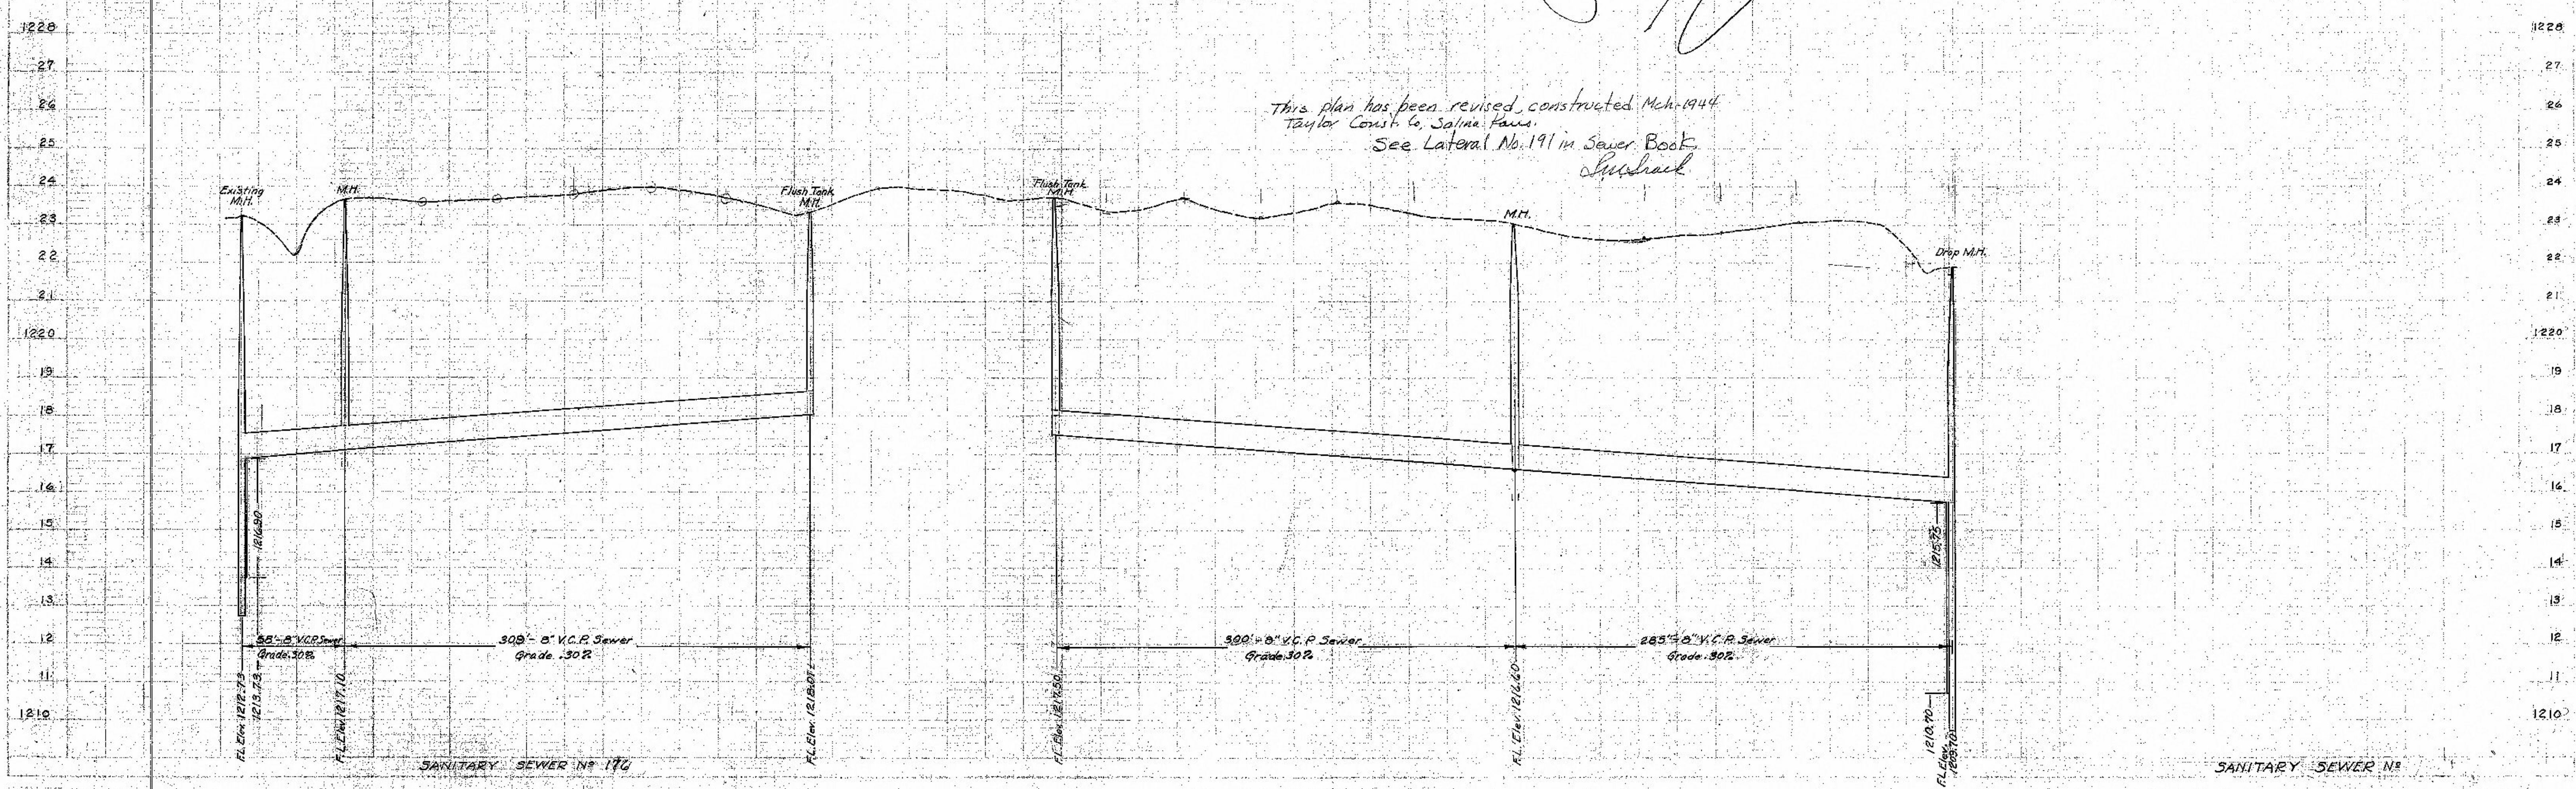

This plan has been revised, constructed, Mch. 1944
Taylor Const. Co., Salina, Kans.
See Lateral No. 191 in Sewer Book
Ludwick

SANITARY SEWER NO. 176

SANITARY SEWER NO. 1091