



1224  
1222  
1220  
1218  
1216  
1214  
1212  
1210

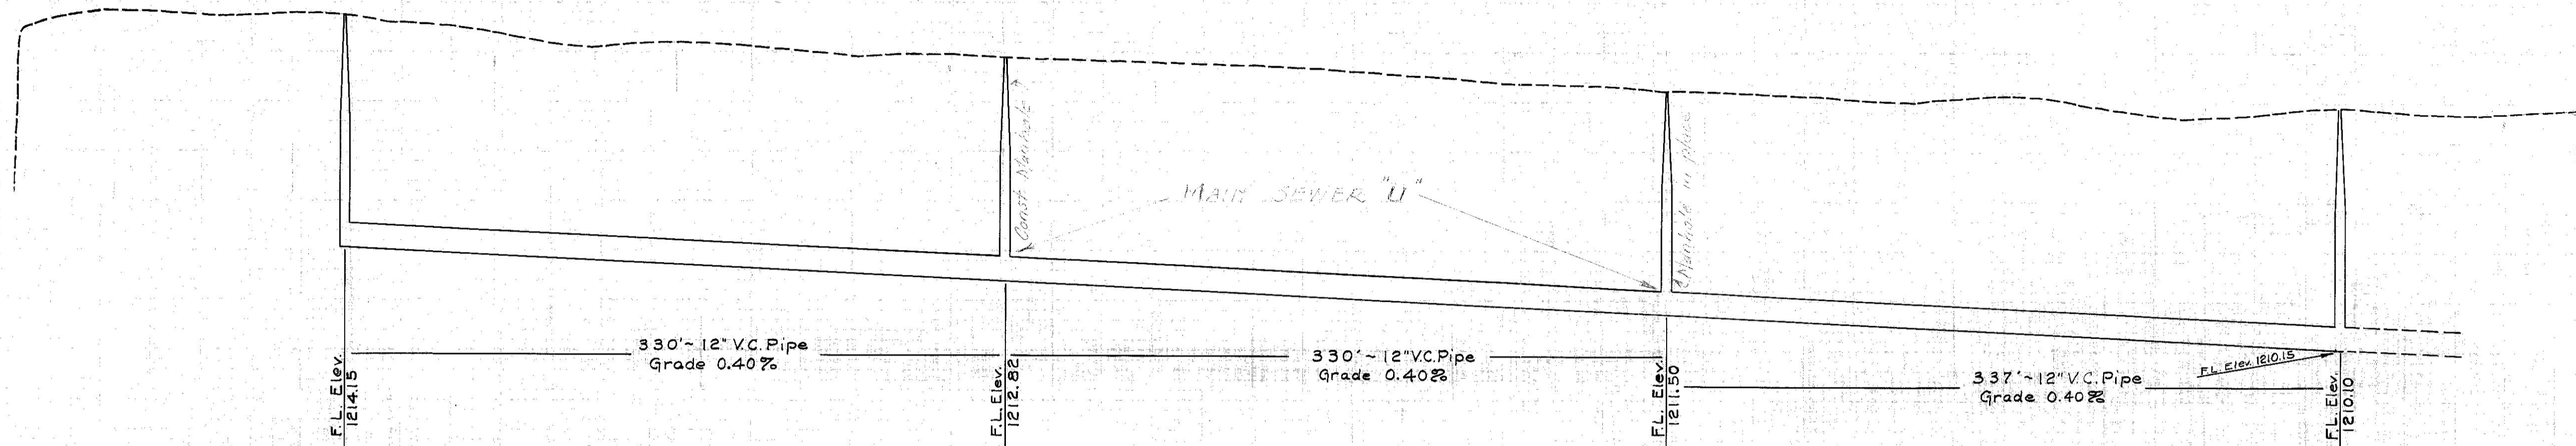


1224  
1222  
1220  
1218  
1216  
1214  
1212  
1210

B.M. - Arrow on Fire Hydr. N.E. Cor. 10th & Pacific Elev. 1222.02

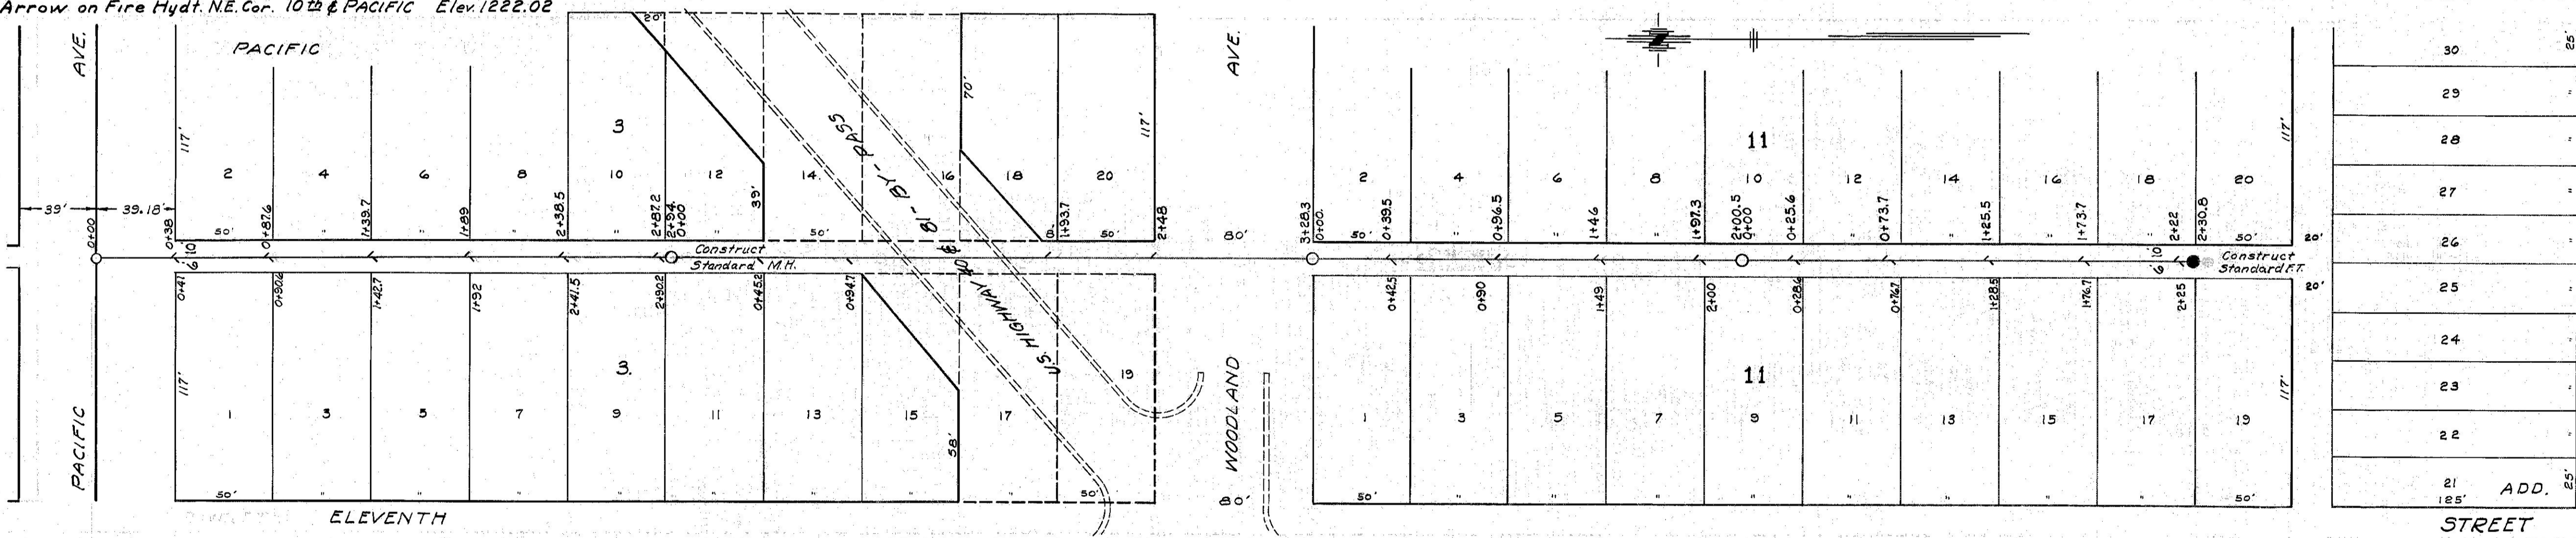

1222  
1220  
1218  
1216  
1214  
1212  
1210

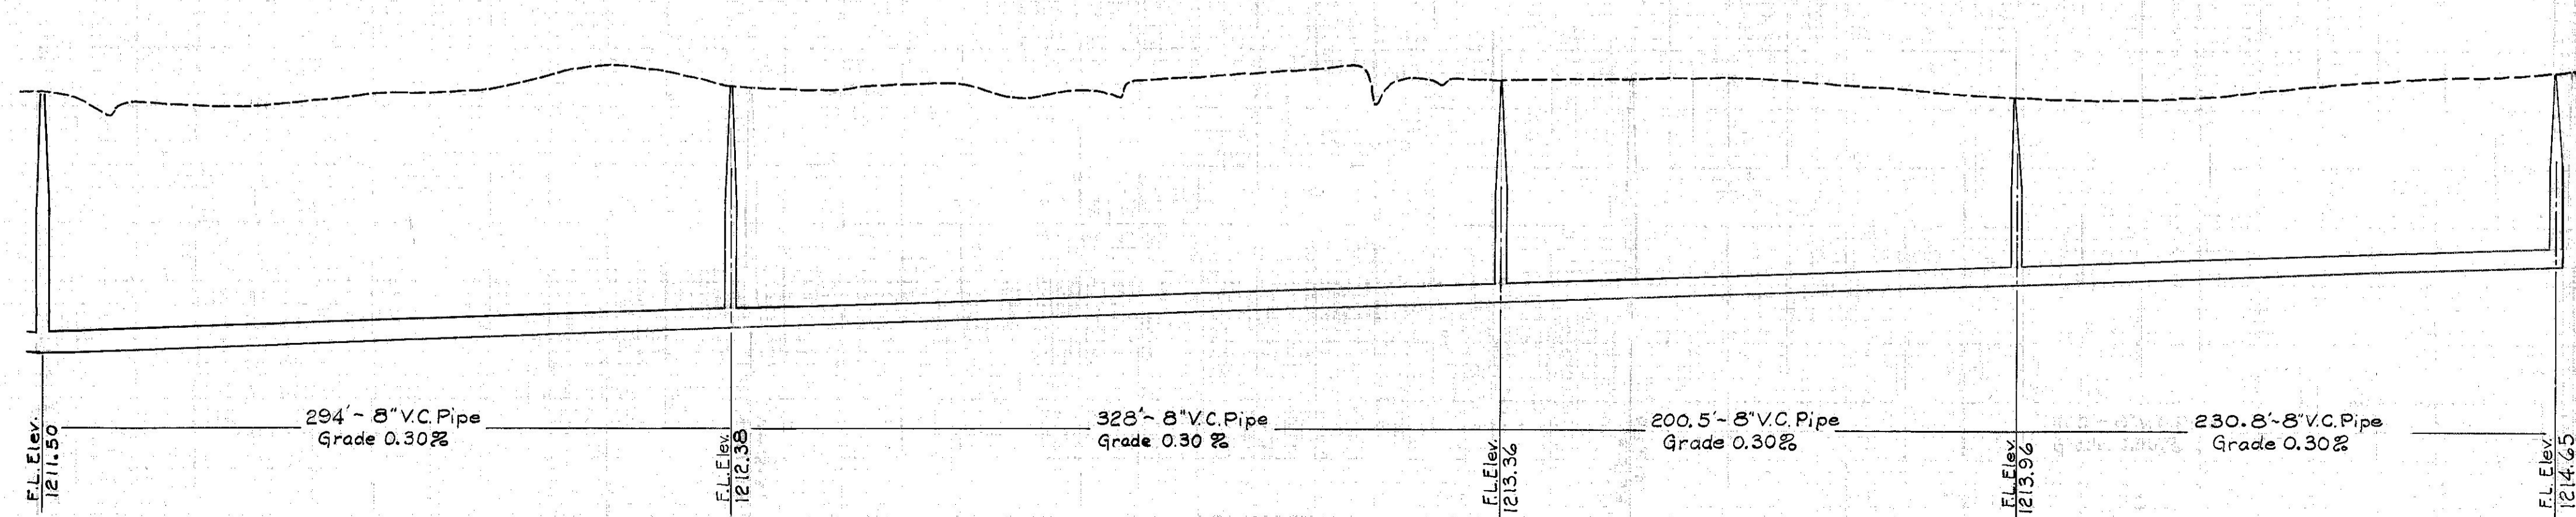

1222  
1220  
1218  
1216  
1214  
1212  
1210