



PLAN	SURVEYED	DATE
NOTEBOOK	PLOTTED	BY
NO.	CHECKED	J.H.H.
	AT. OF WORK CHECKED	J.H.H.

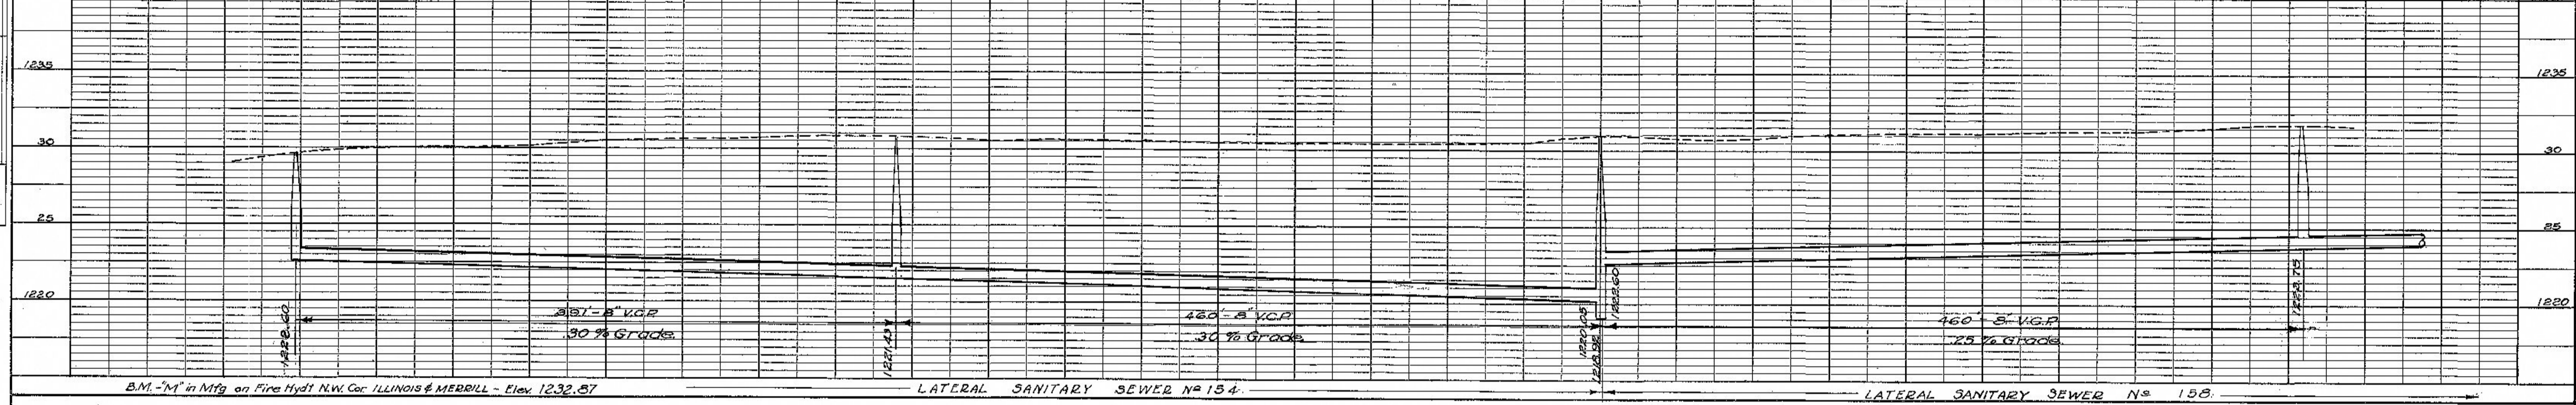

PROFILE	SURVEYED	DATE
NOTEBOOK	GRABS CHECKED	BY
NO.	B.M. & NOTES	J.H.H.
	STRUCTURE NOTATION CHECKED	J.H.H.

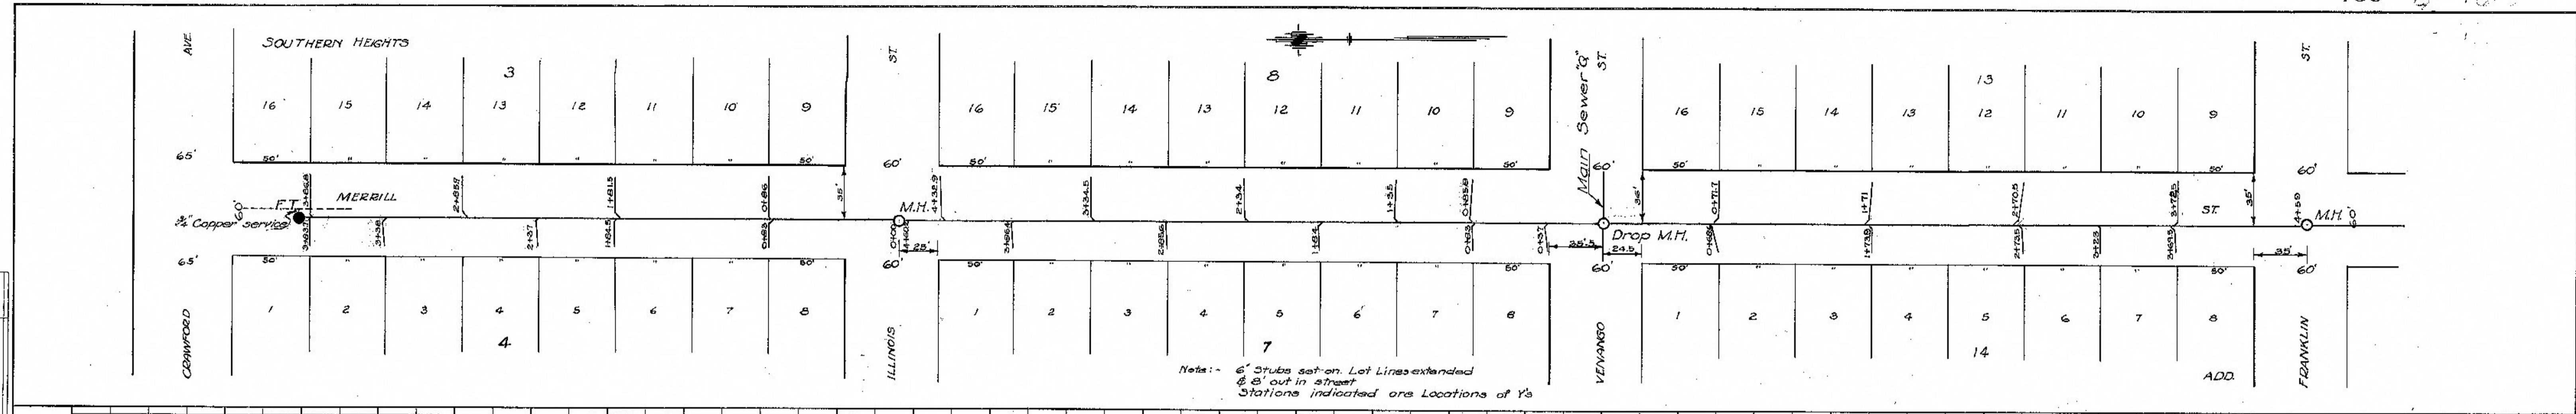