

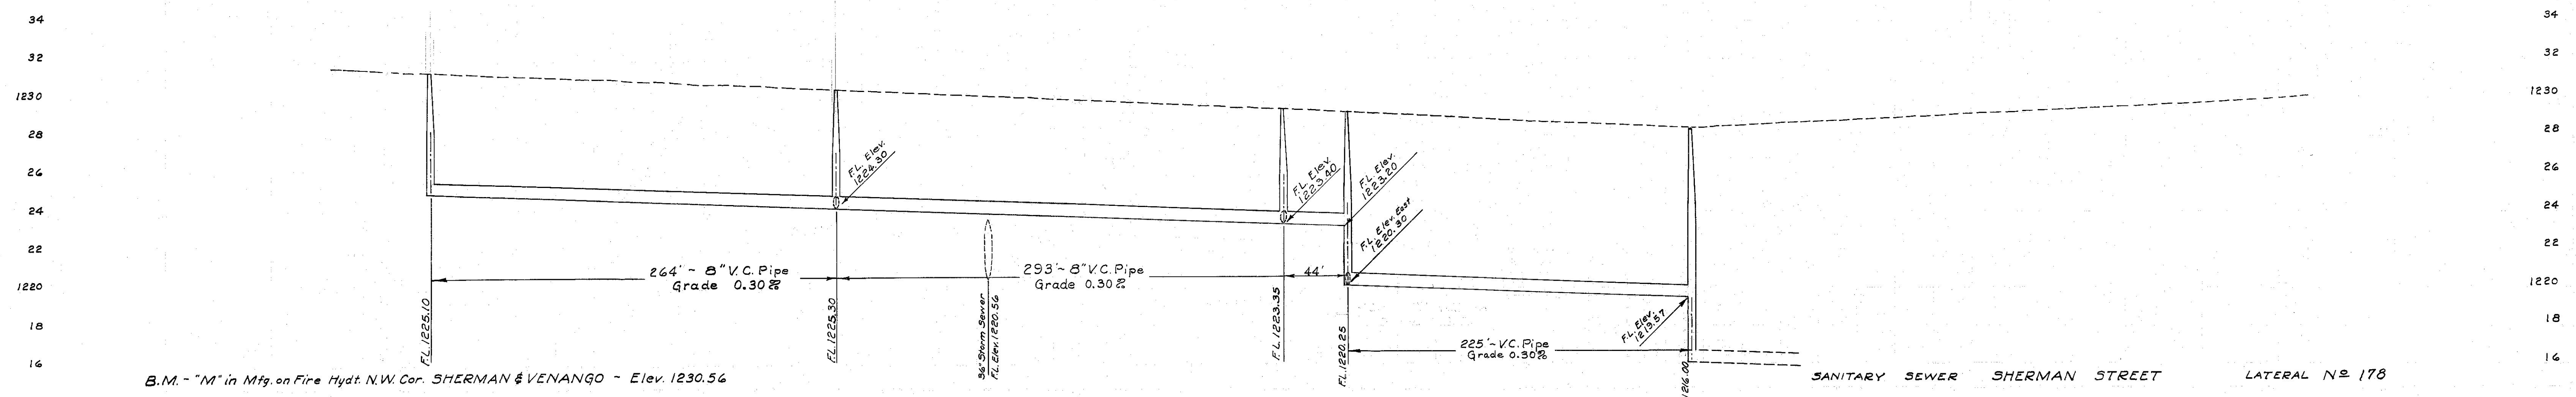
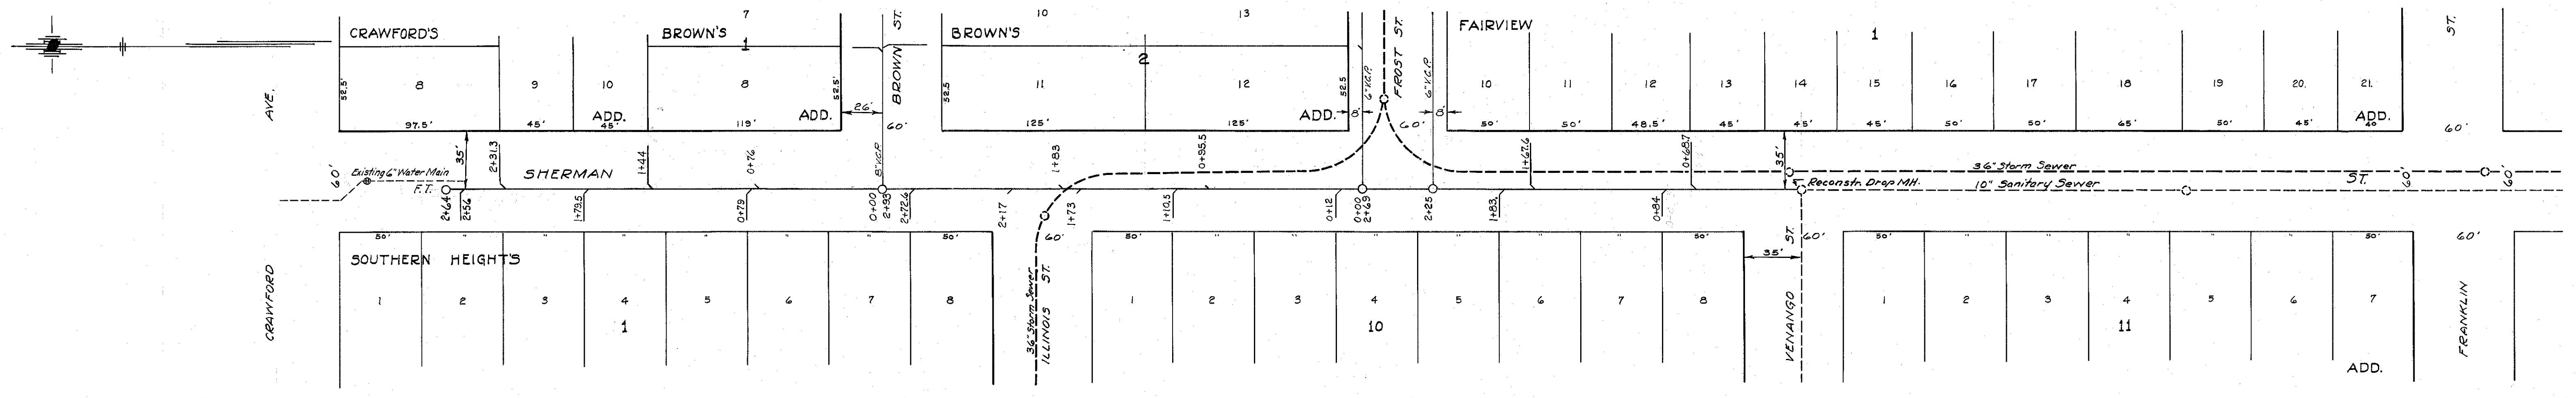
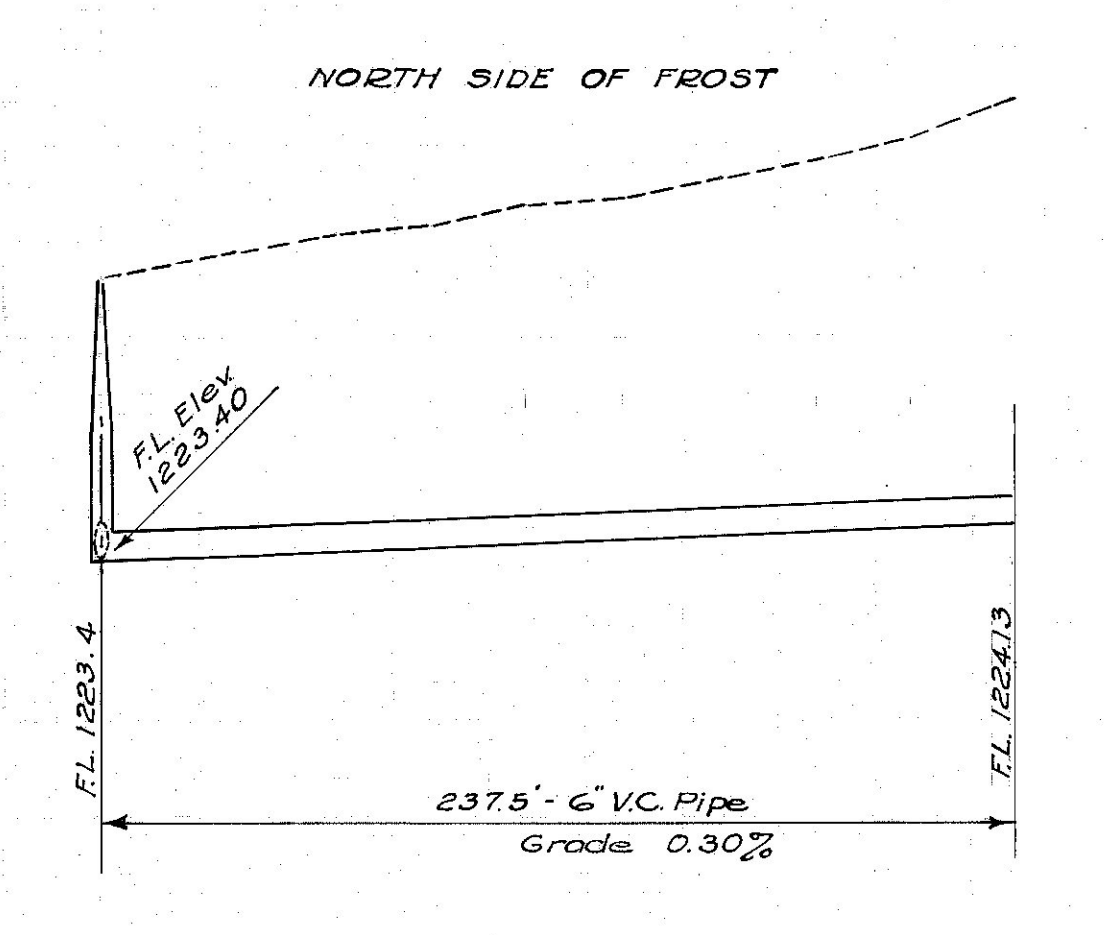
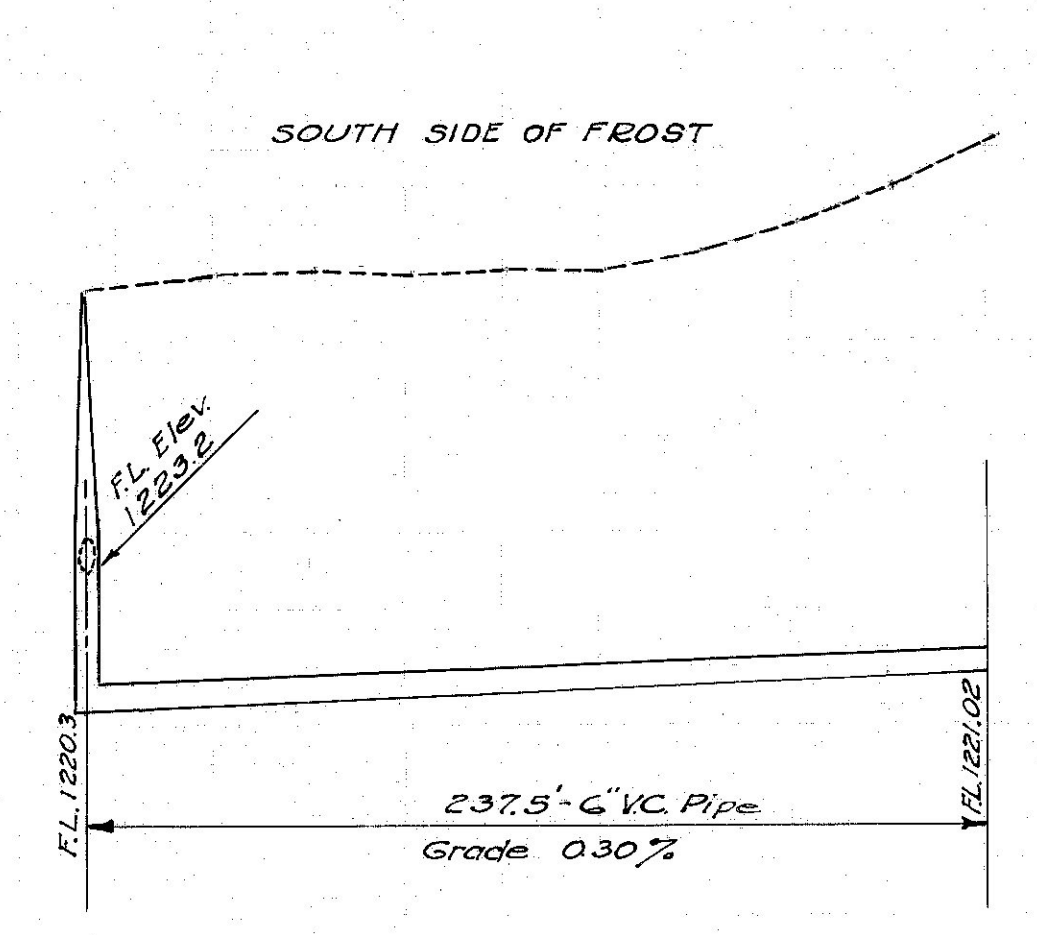
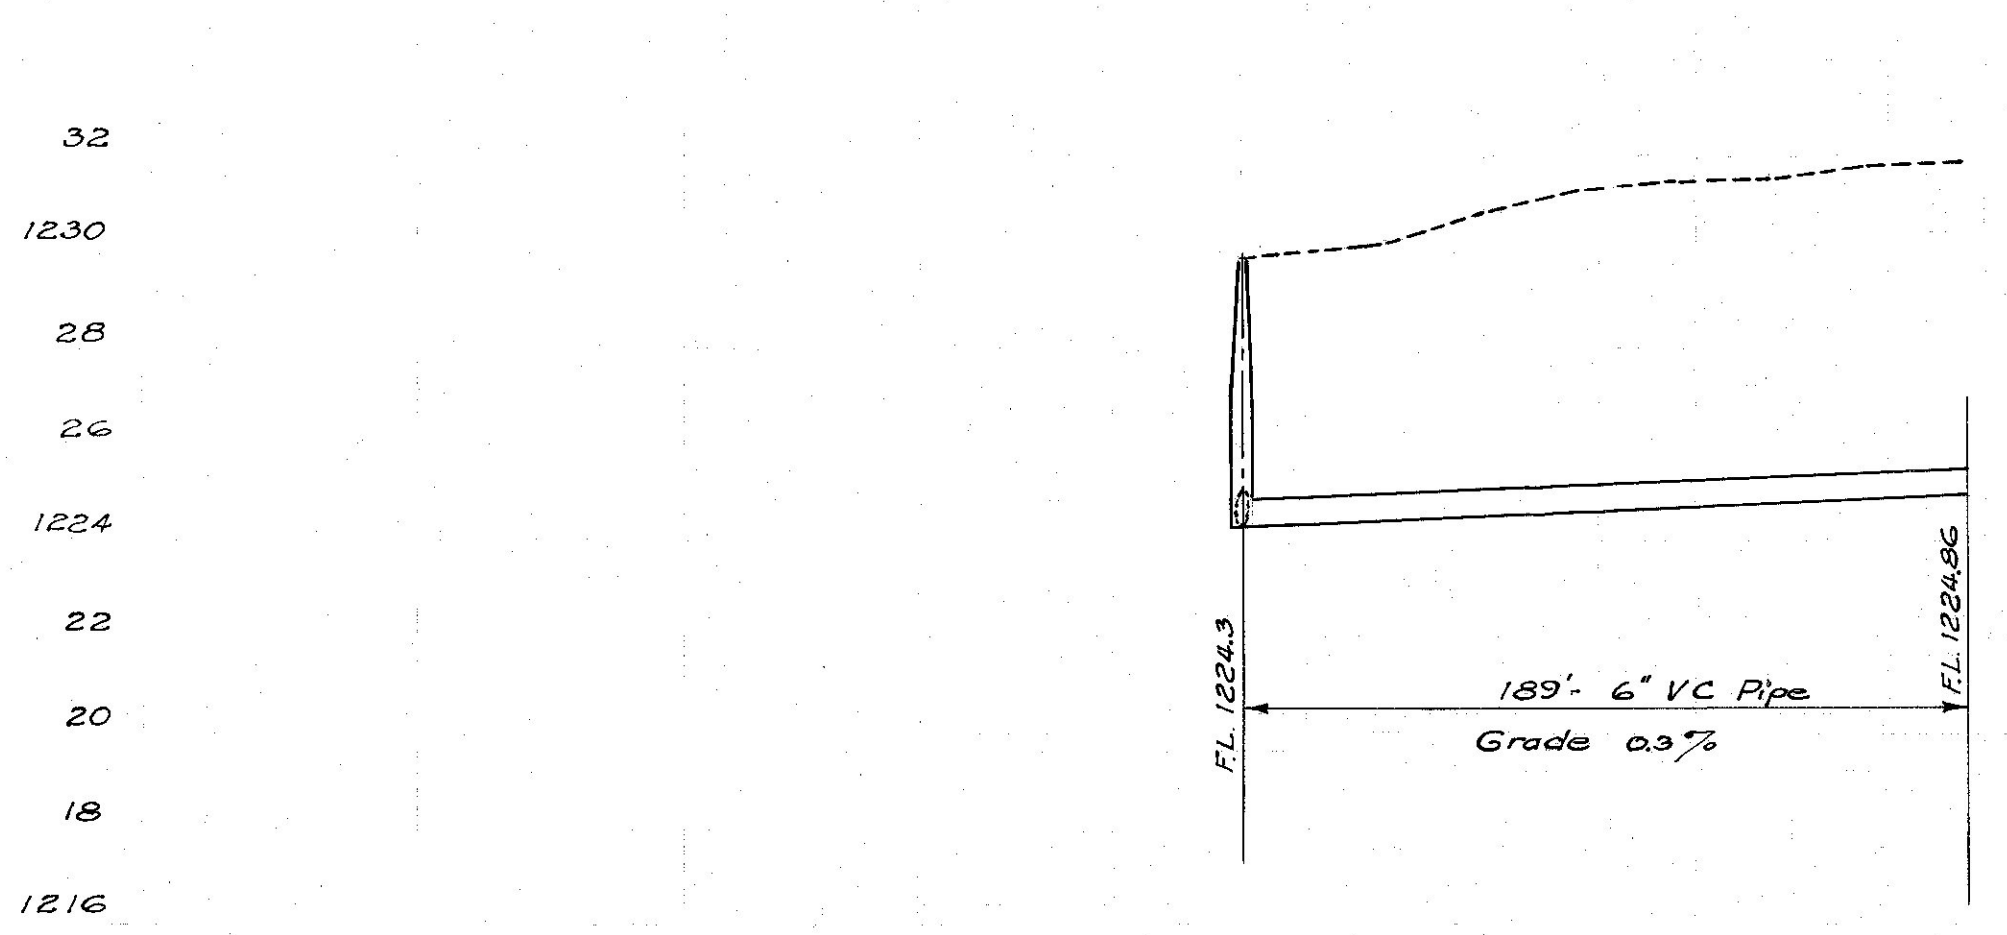


J.T.H. 2/14/38

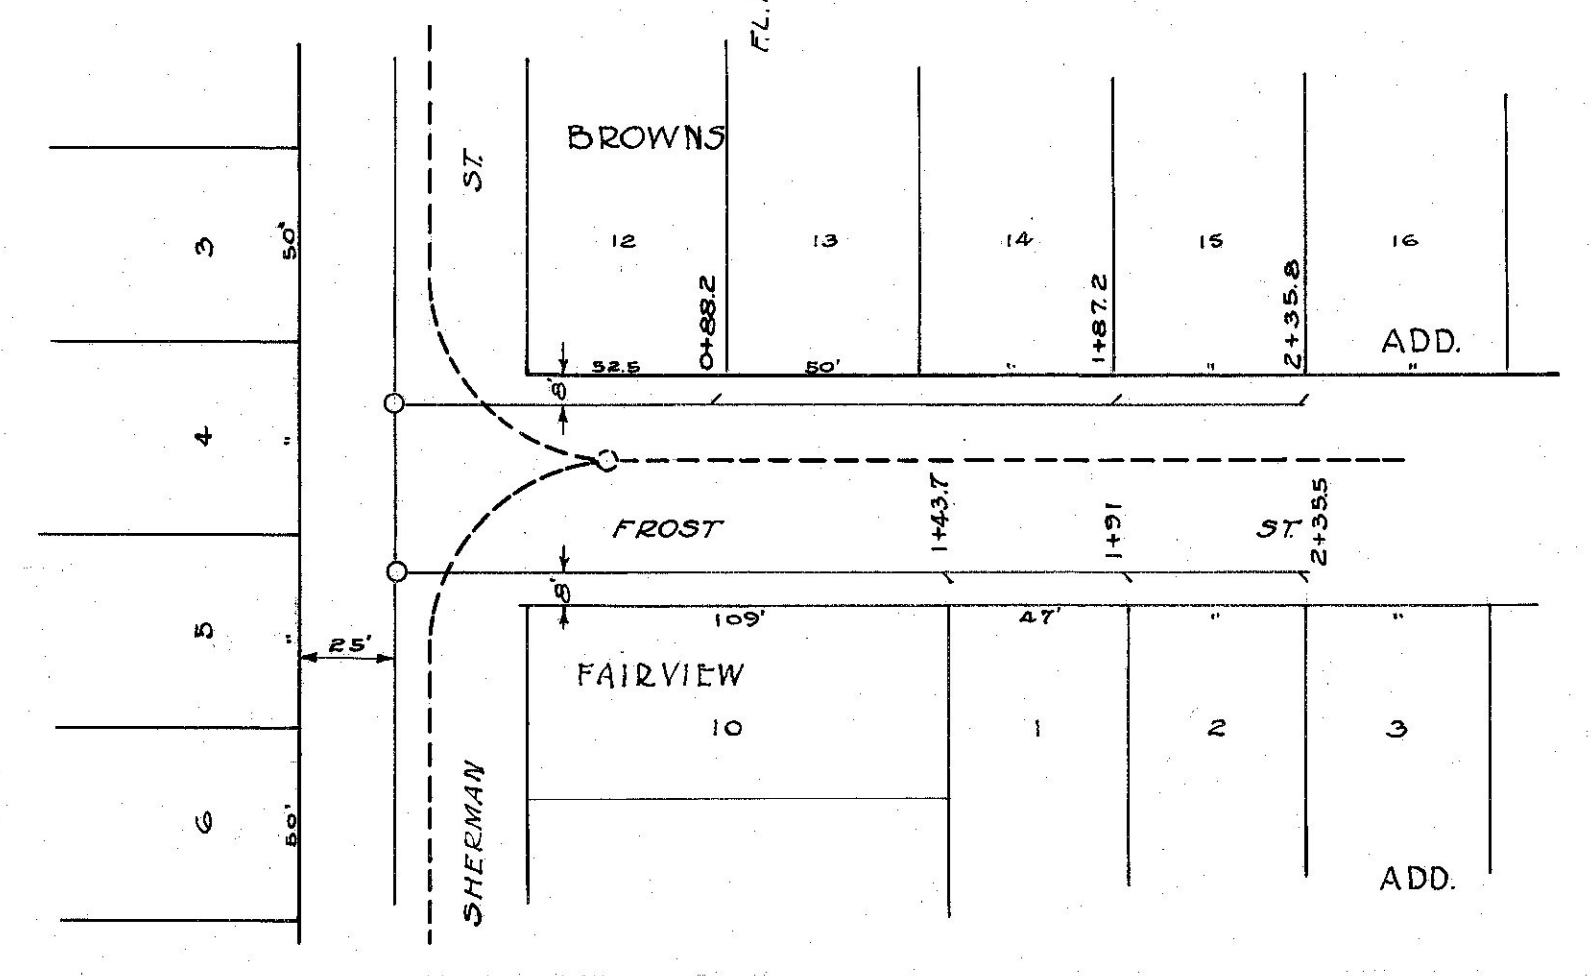

B.M. - "M" in Mtg. on Fire Hydt. N.W. Cor. SHERMAN & VENANGO - Elev. 1230.56
 SANITARY SEWER SHERMAN STREET LATERAL NO 178

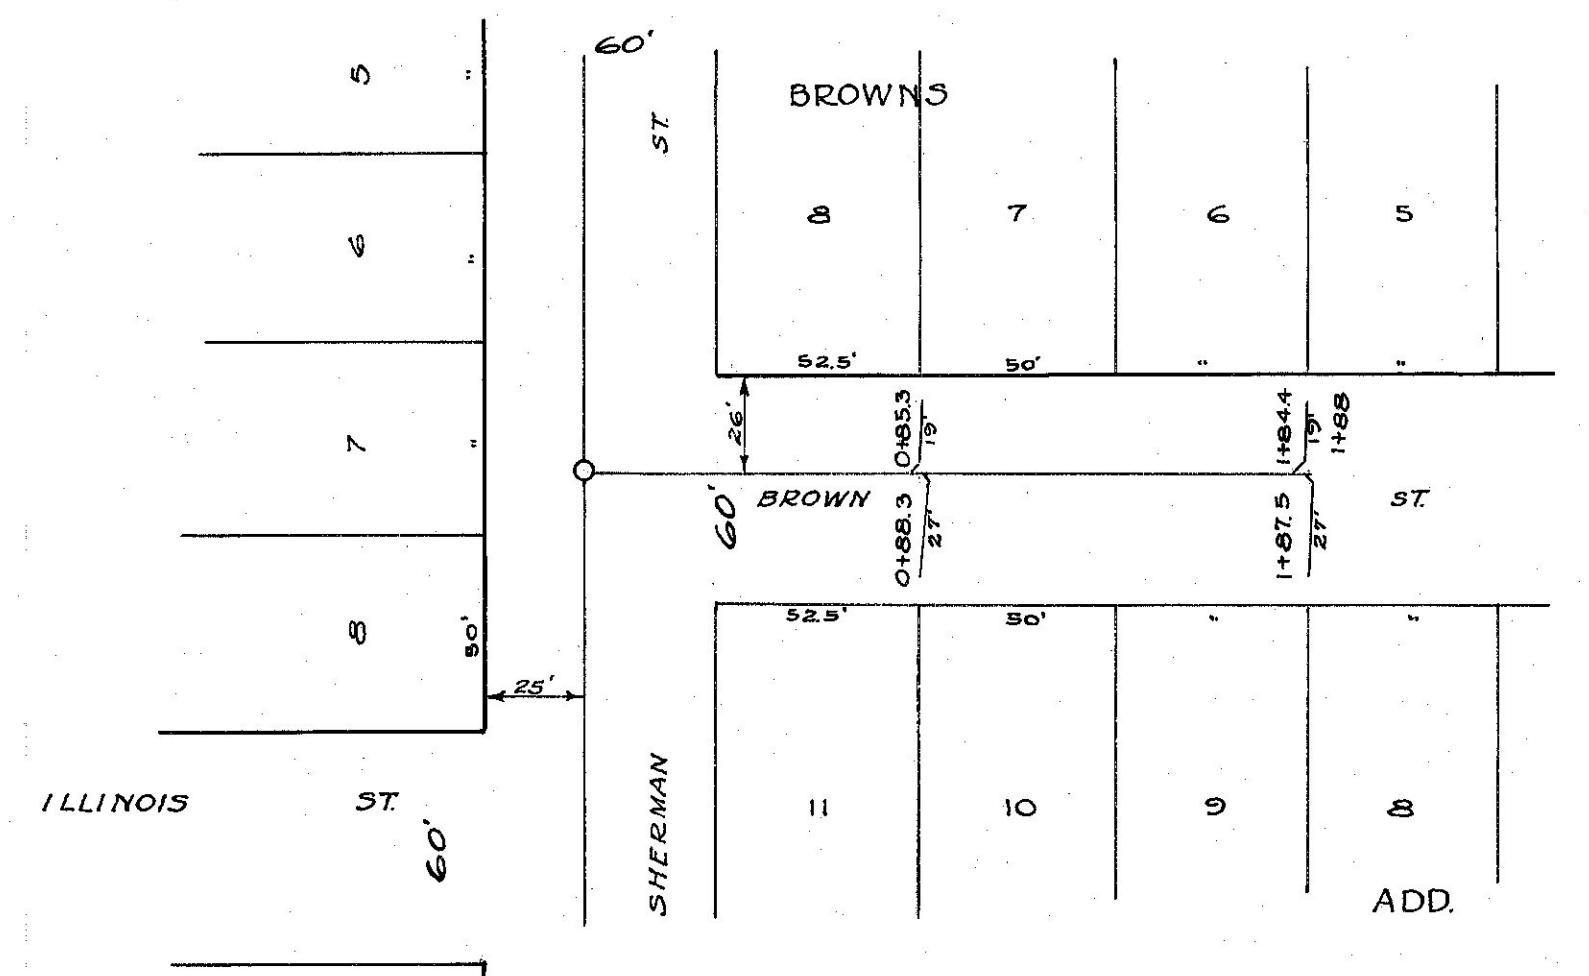

B.M. - "M" in Mtg. on Fire Hydt. N.W. Cor. SHERMAN & VENANGO - Elev. 1230.56

1216 18 20 22 24 26 28 32 34