


N side 29 to Lot 35 & E side Lot 19 SEWER LATERAL "B" 182

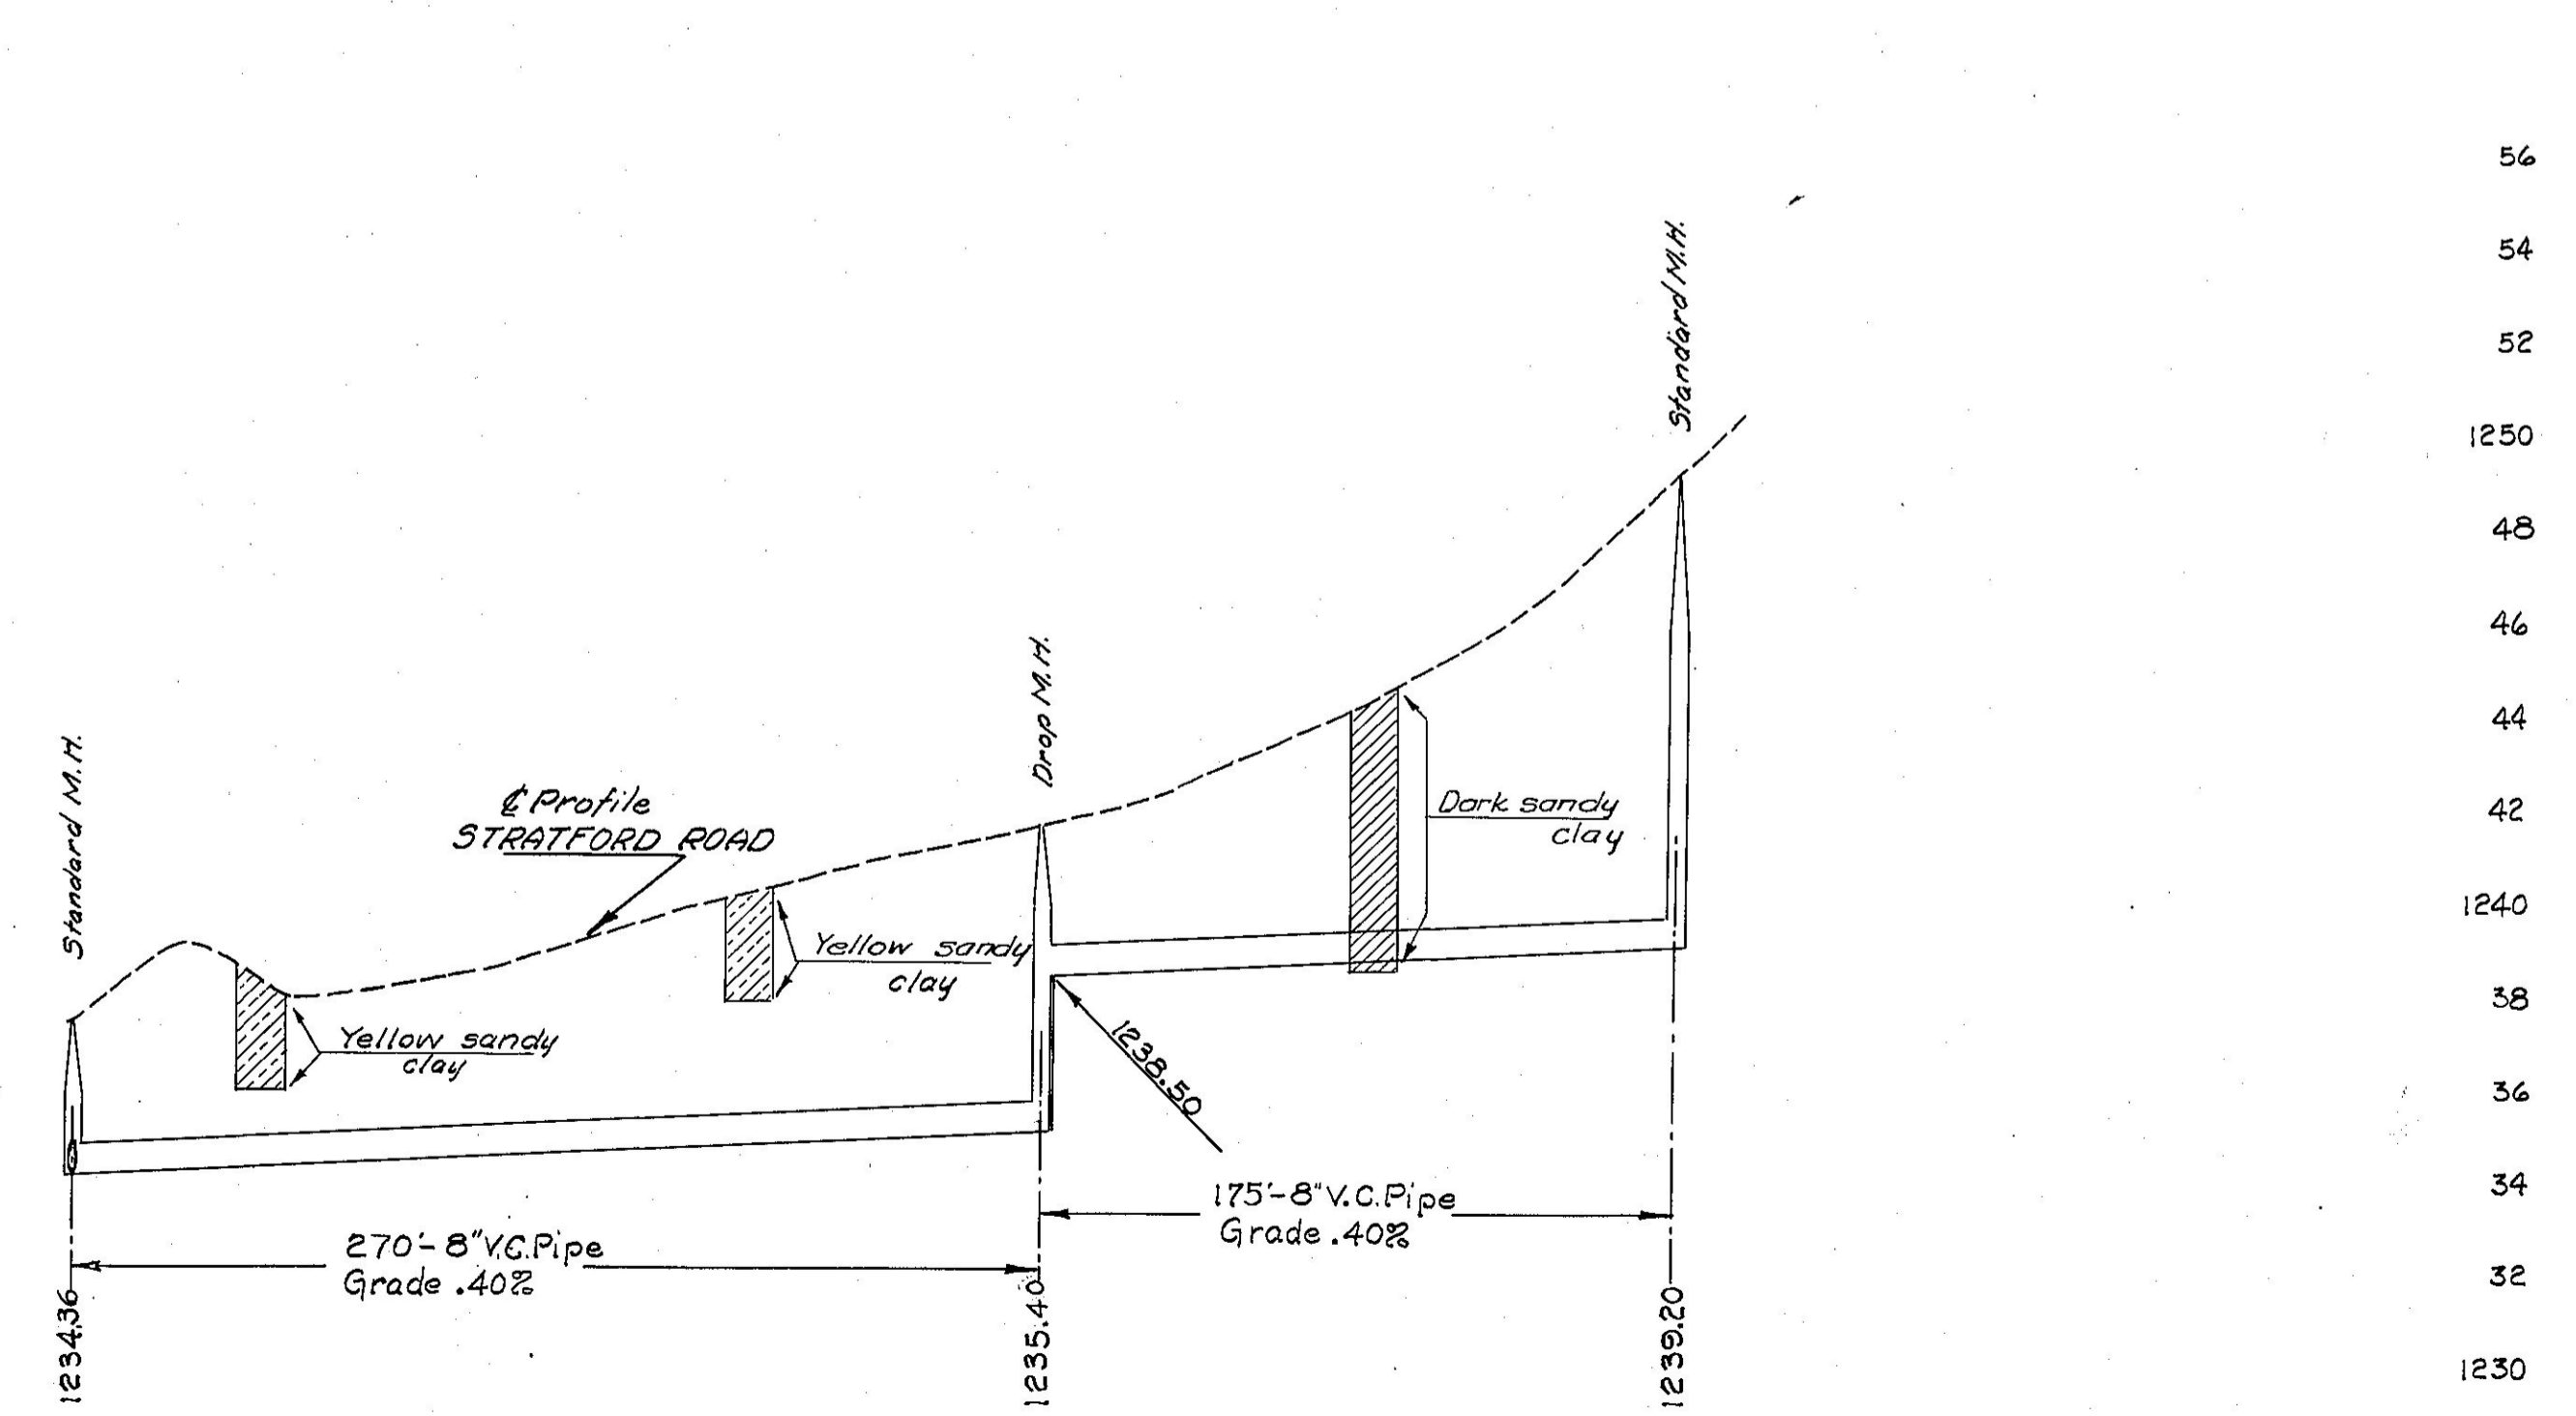

WEST LAKE DRIVE SEWER LATERAL "C" 183