



771

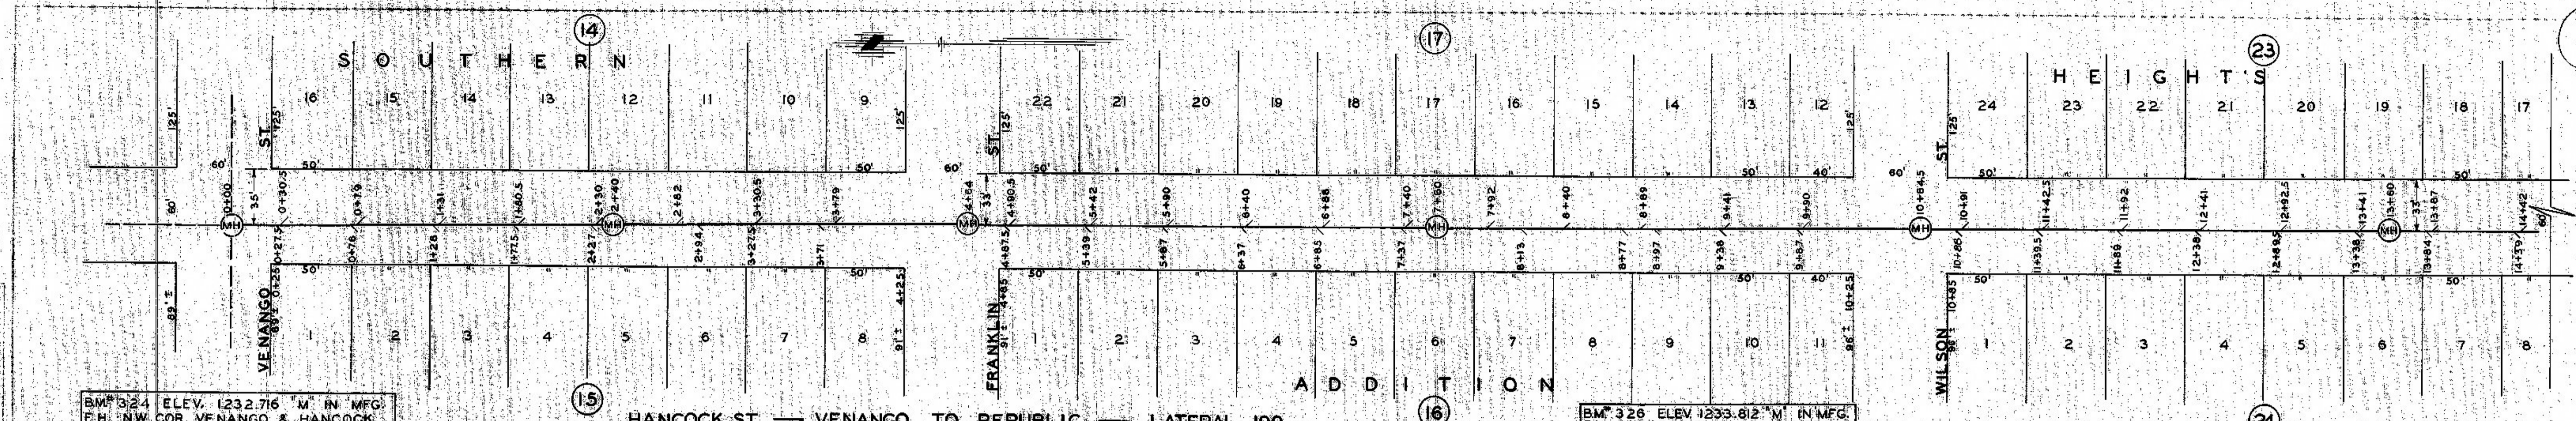


BM 324 ELEV. 1232.716 'M' IN MFG.
F.H. NW. COR. VENANGO & HANCOCK

BM 326 ELEV. 1233.812 'M' IN MFG.
F.H. NW. COR. WILSON & HANCOCK


HANCOCK ST. — VENANGO TO REPUBLIC — LATERAL 199

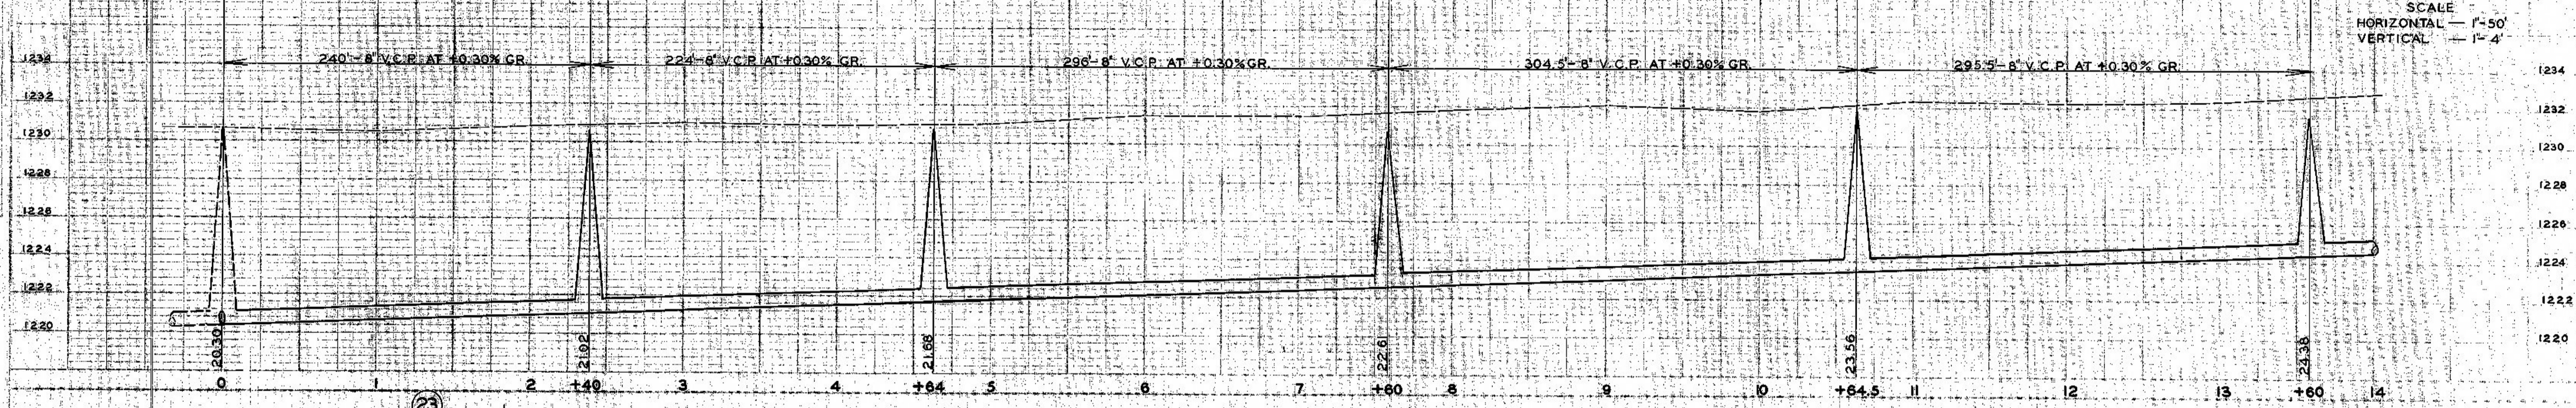

SCALE
HORIZONTAL — 1"=50'
VERTICAL — 1"=4'

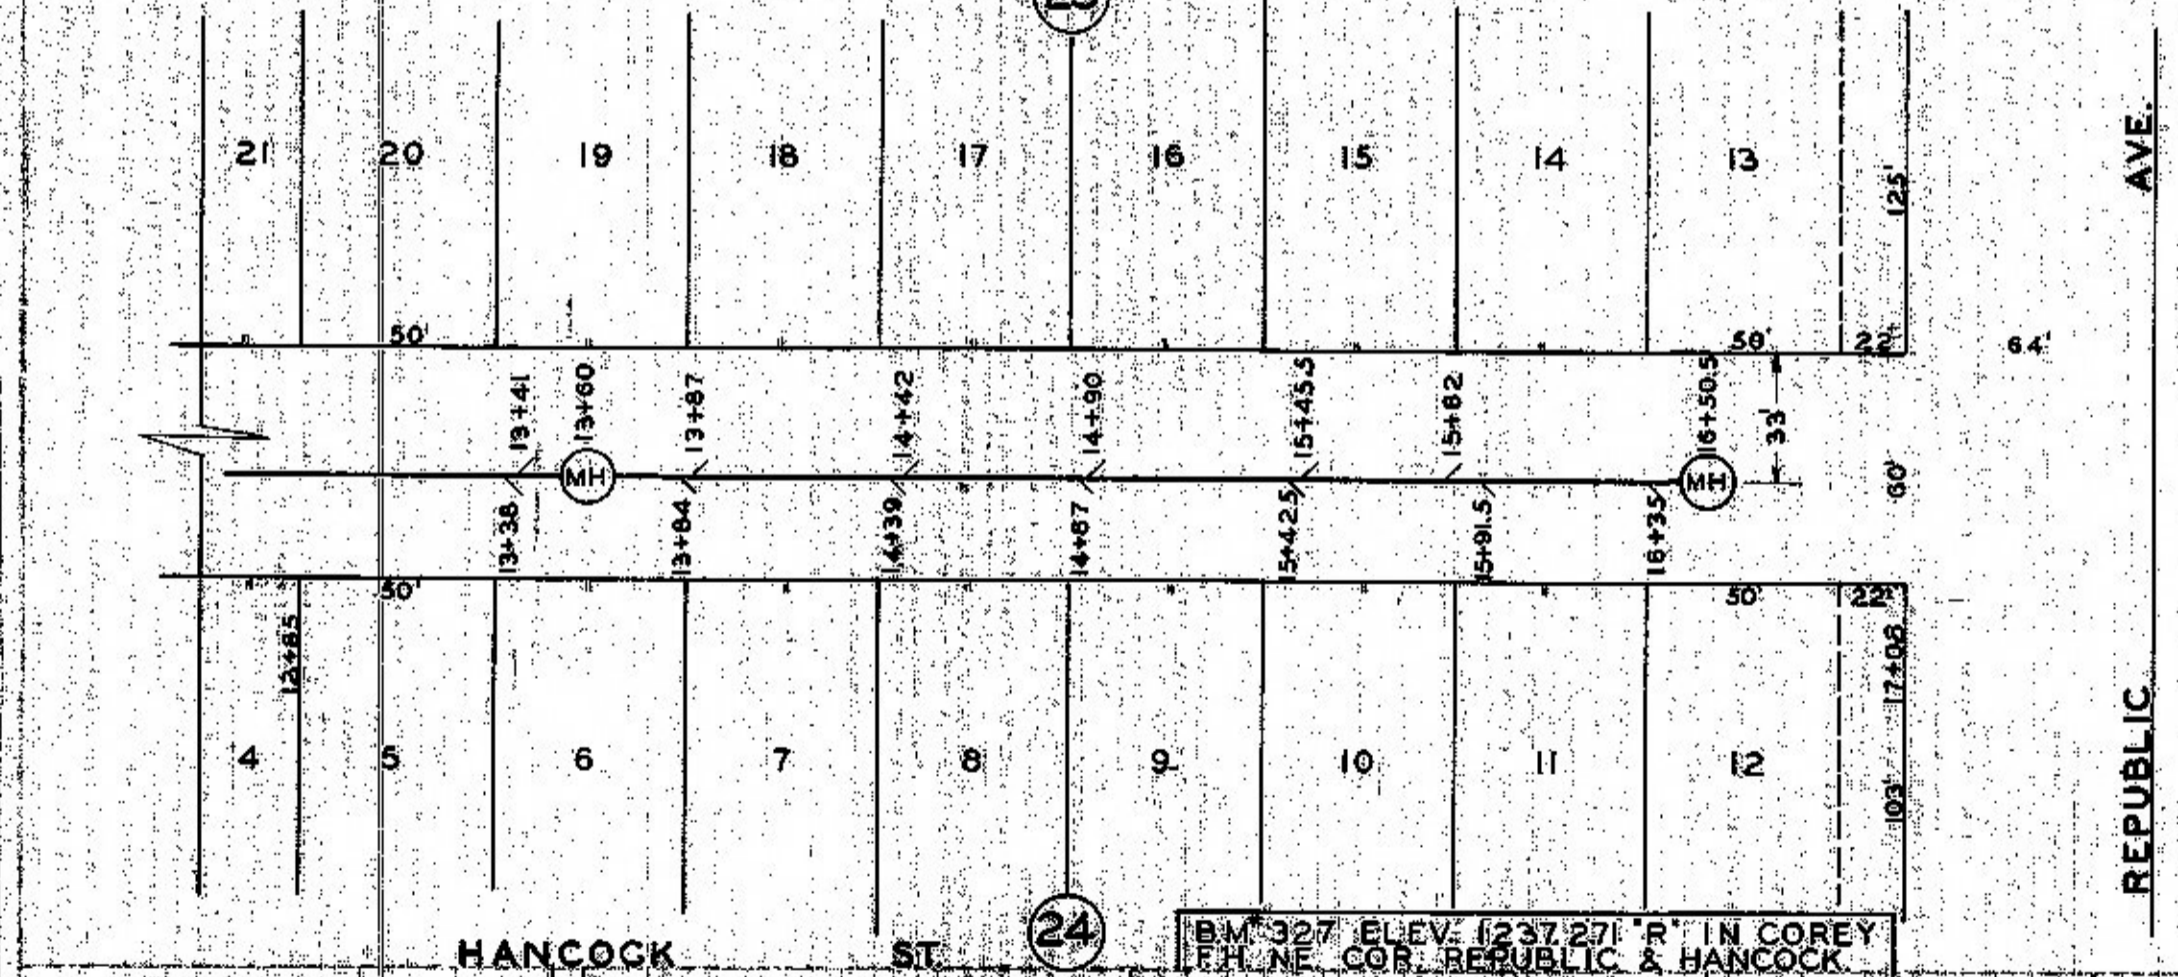

BM 327 ELEV. 1237.271 'R' IN COREY
F.H. NE. COR. REPUBLIC & HANCOCK

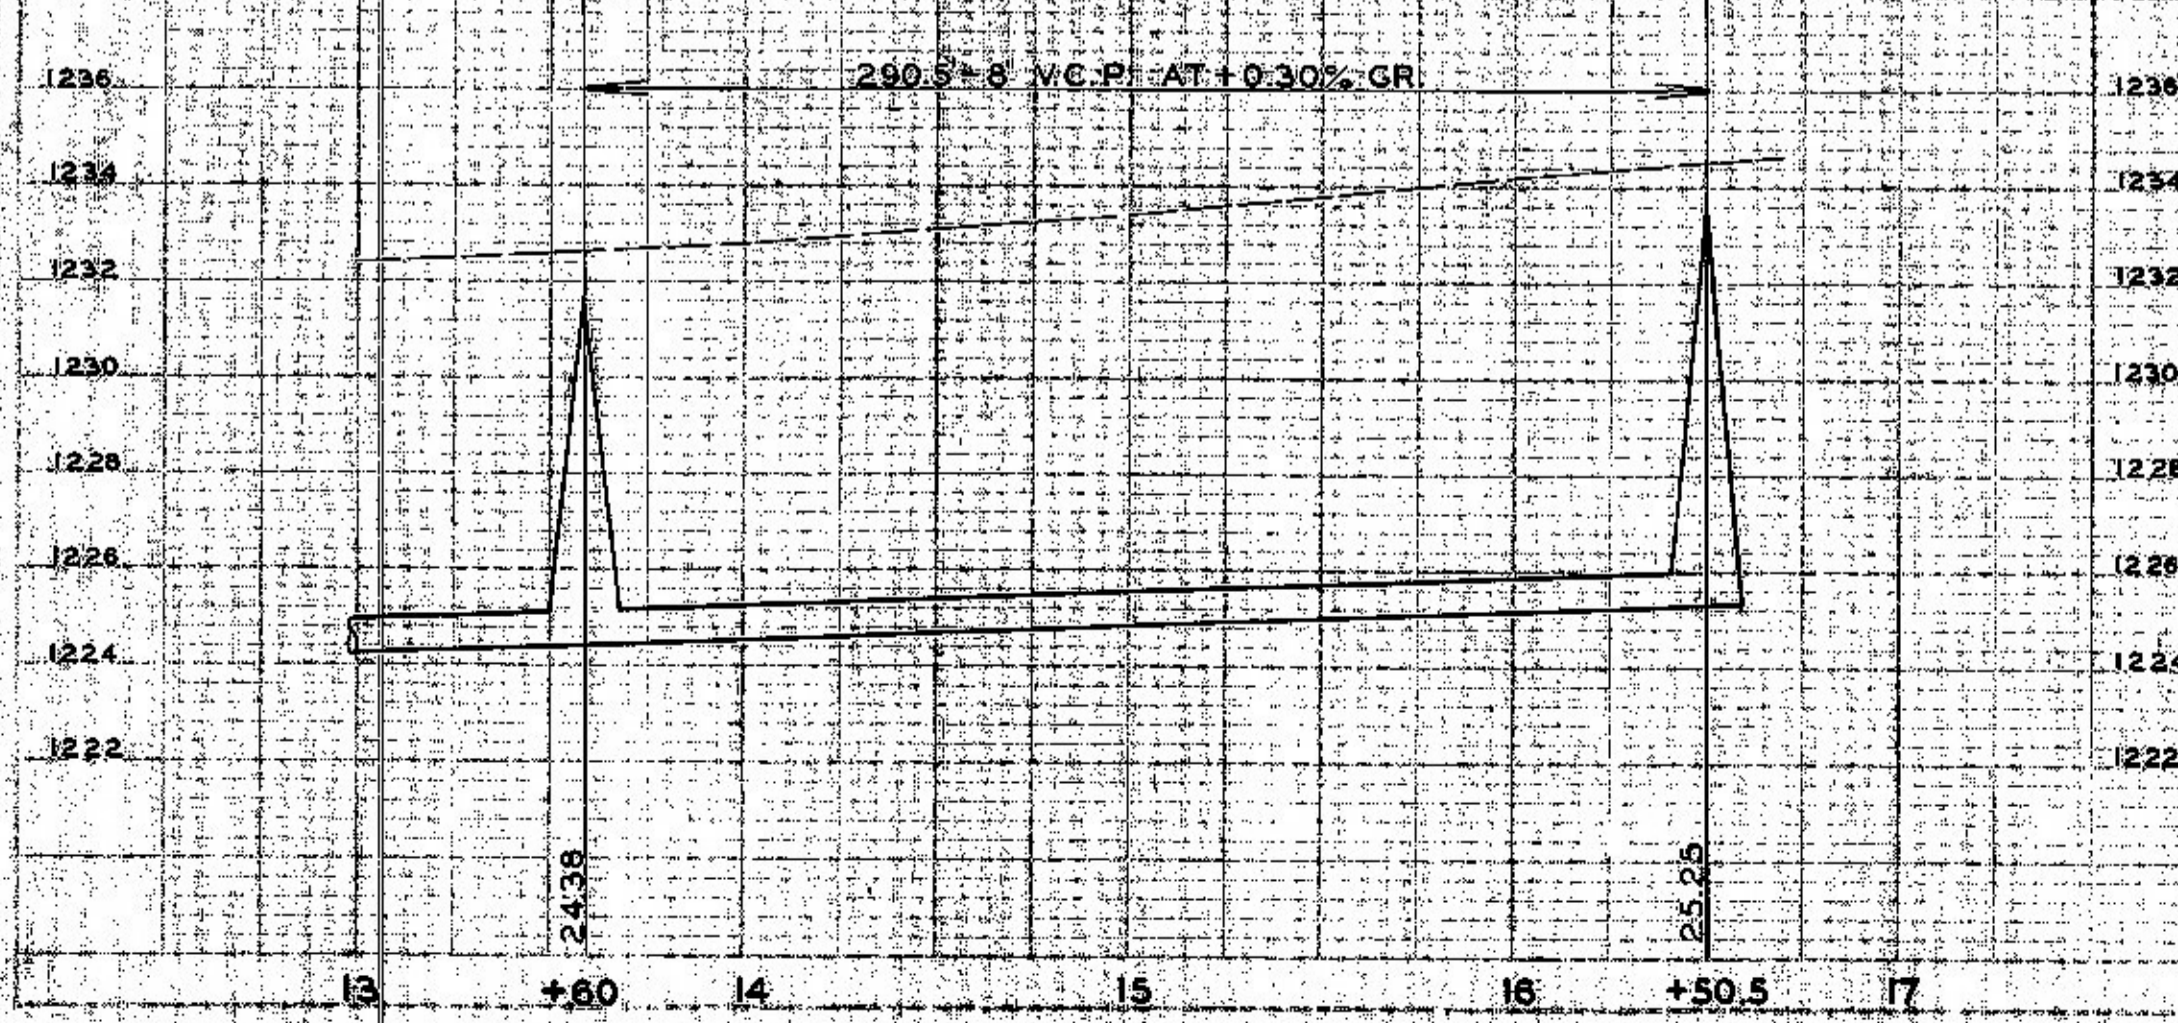

CITY OF SALINA
ENGINEERING DEPARTMENT

SANITARY SEWER
HANCOCK ST.
VENANGO ST. TO REPUBLIC AVE.
LATERAL NO. 199

JOB NO. 211

ORD. NO. 5072
C.C. MACFARLANE
CITY ENGINEER

FILED 12-18-44
CITY CLERK