
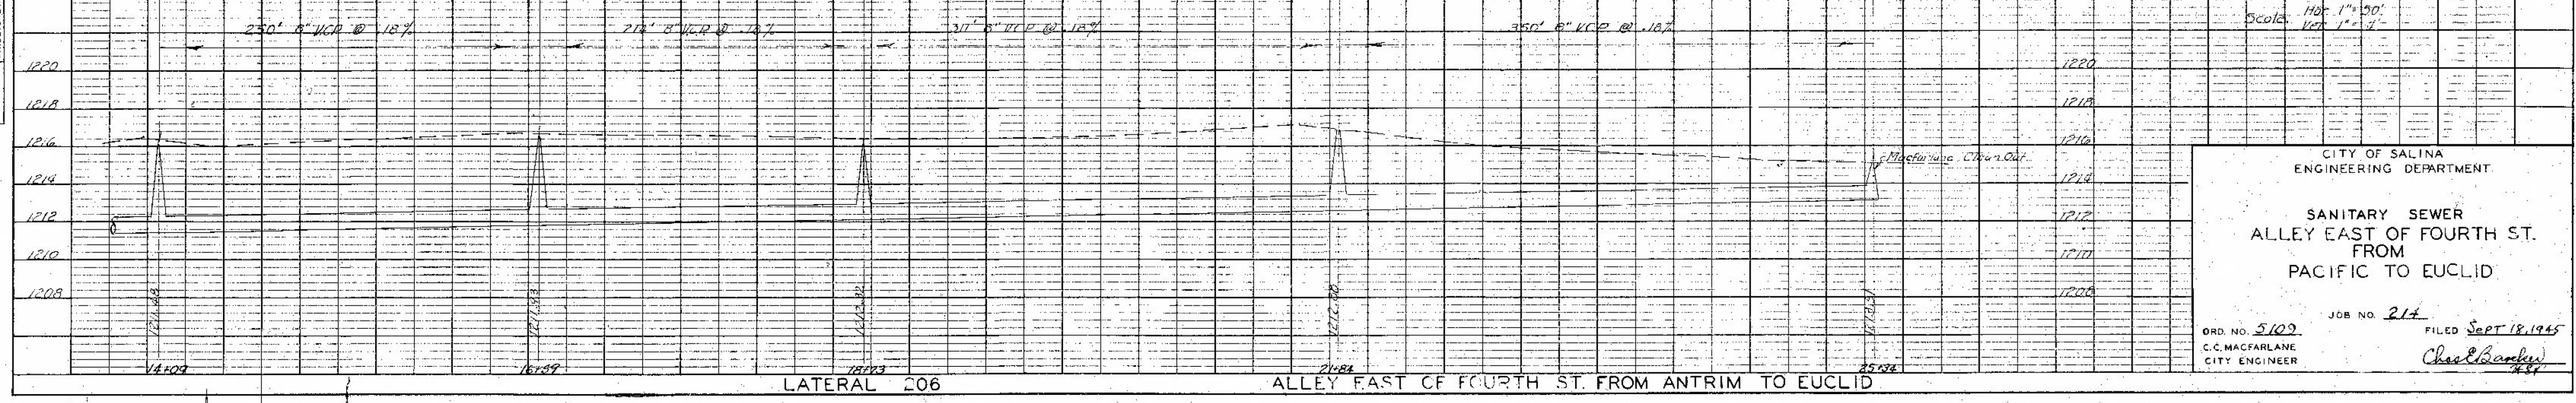
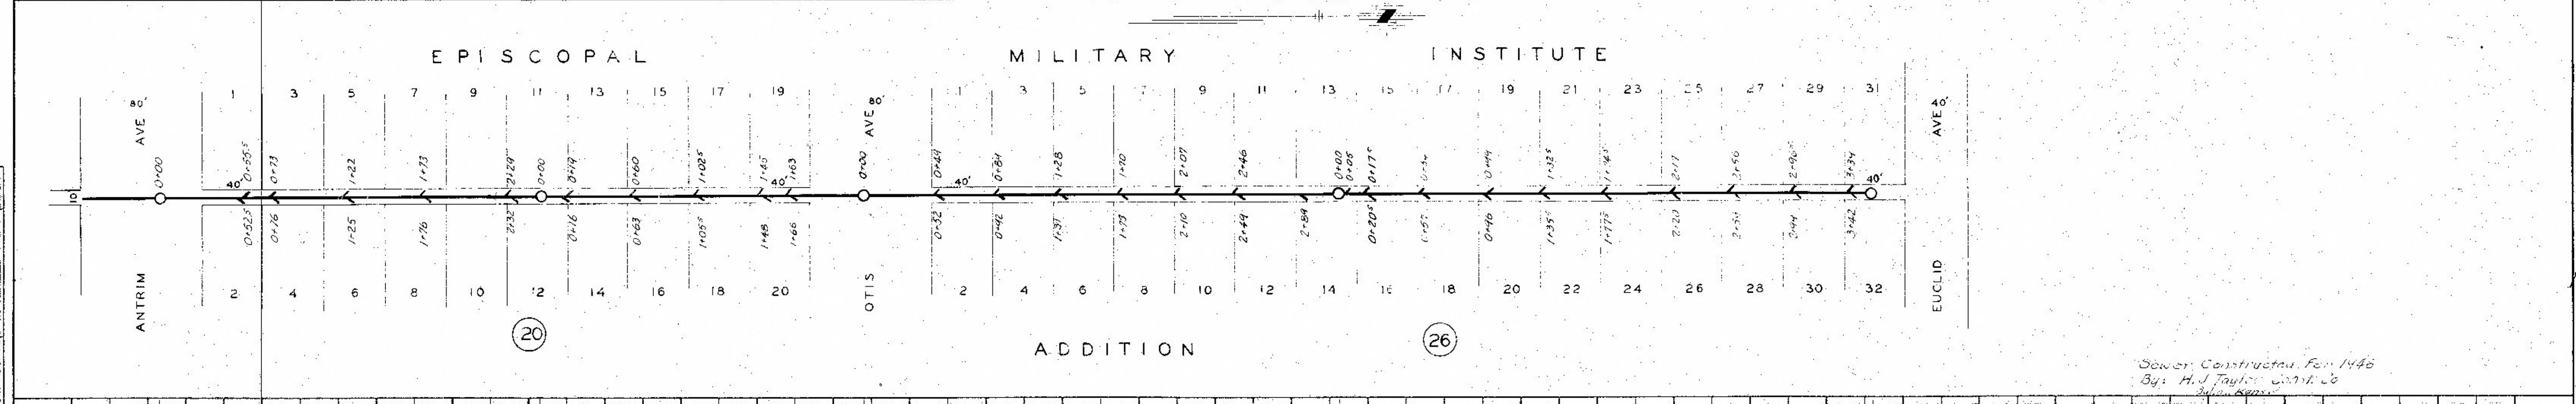
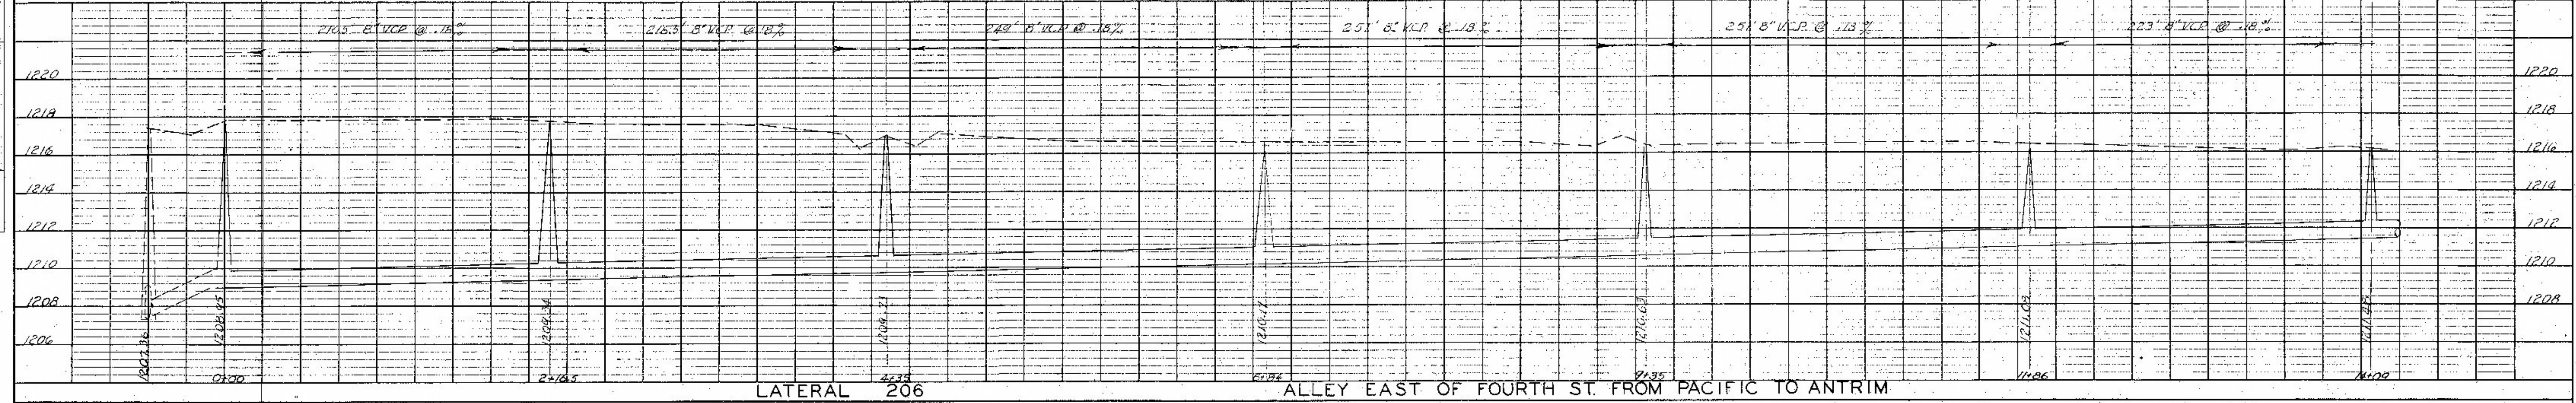


PLAN
 SURVEYED BY C. MacFarlane
 PLOTTED BY S. J. Taylor
 NOTE BOOK GRADES CHECKED
 NO. 54222

PROFILE
 SURVEYED BY C. MacFarlane
 PLOTTED BY S. J. Taylor
 NOTE BOOK GRADES CHECKED
 NO. 54222

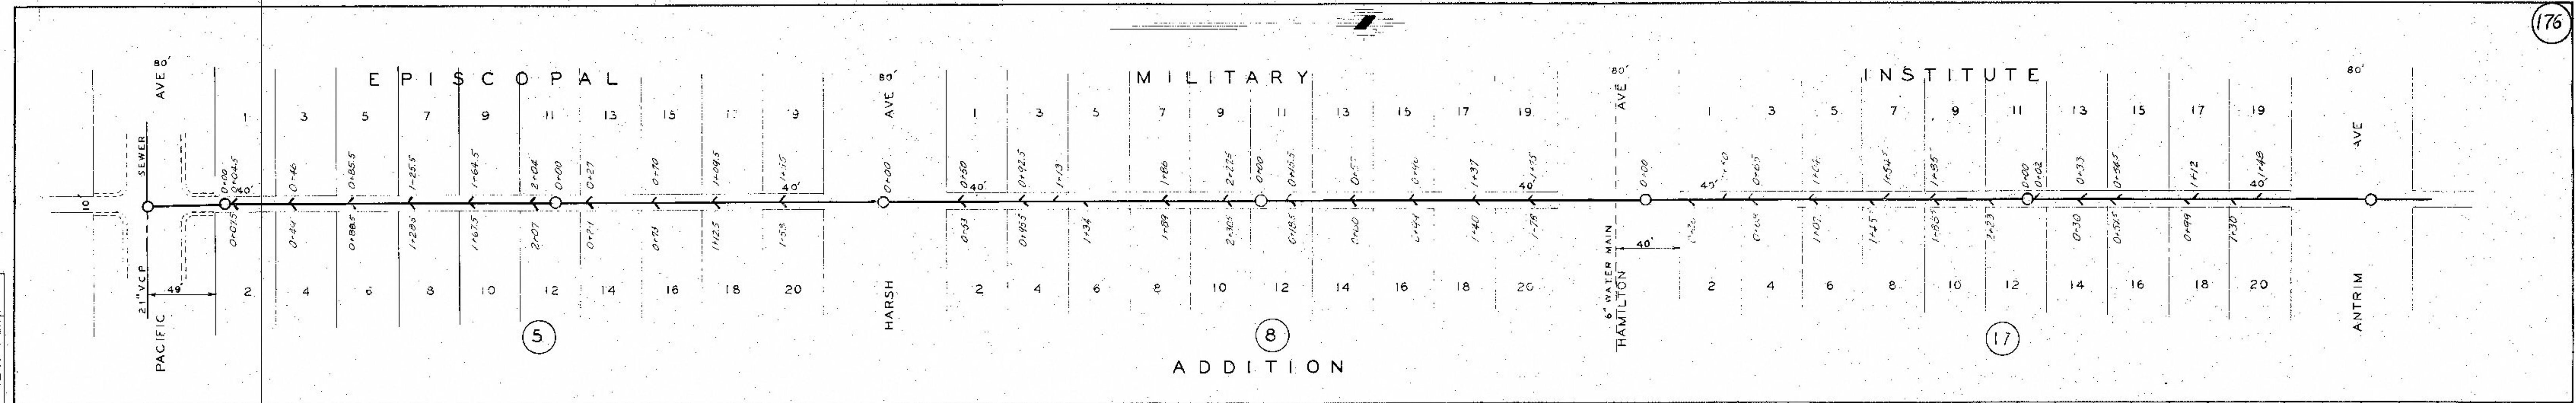

Sewer Construction Form 1946
 By: H. J. Taylor
 S. J. Taylor

CITY OF SALINA
 ENGINEERING DEPARTMENT
 SANITARY SEWER
 ALLEY EAST OF FOURTH ST.
 FROM
 PACIFIC TO EUCLID
 JOB NO. 214
 FILED SEPT 18, 1945
 C.C. MACFARLANE
 CITY ENGINEER
 Chas. & Banker