
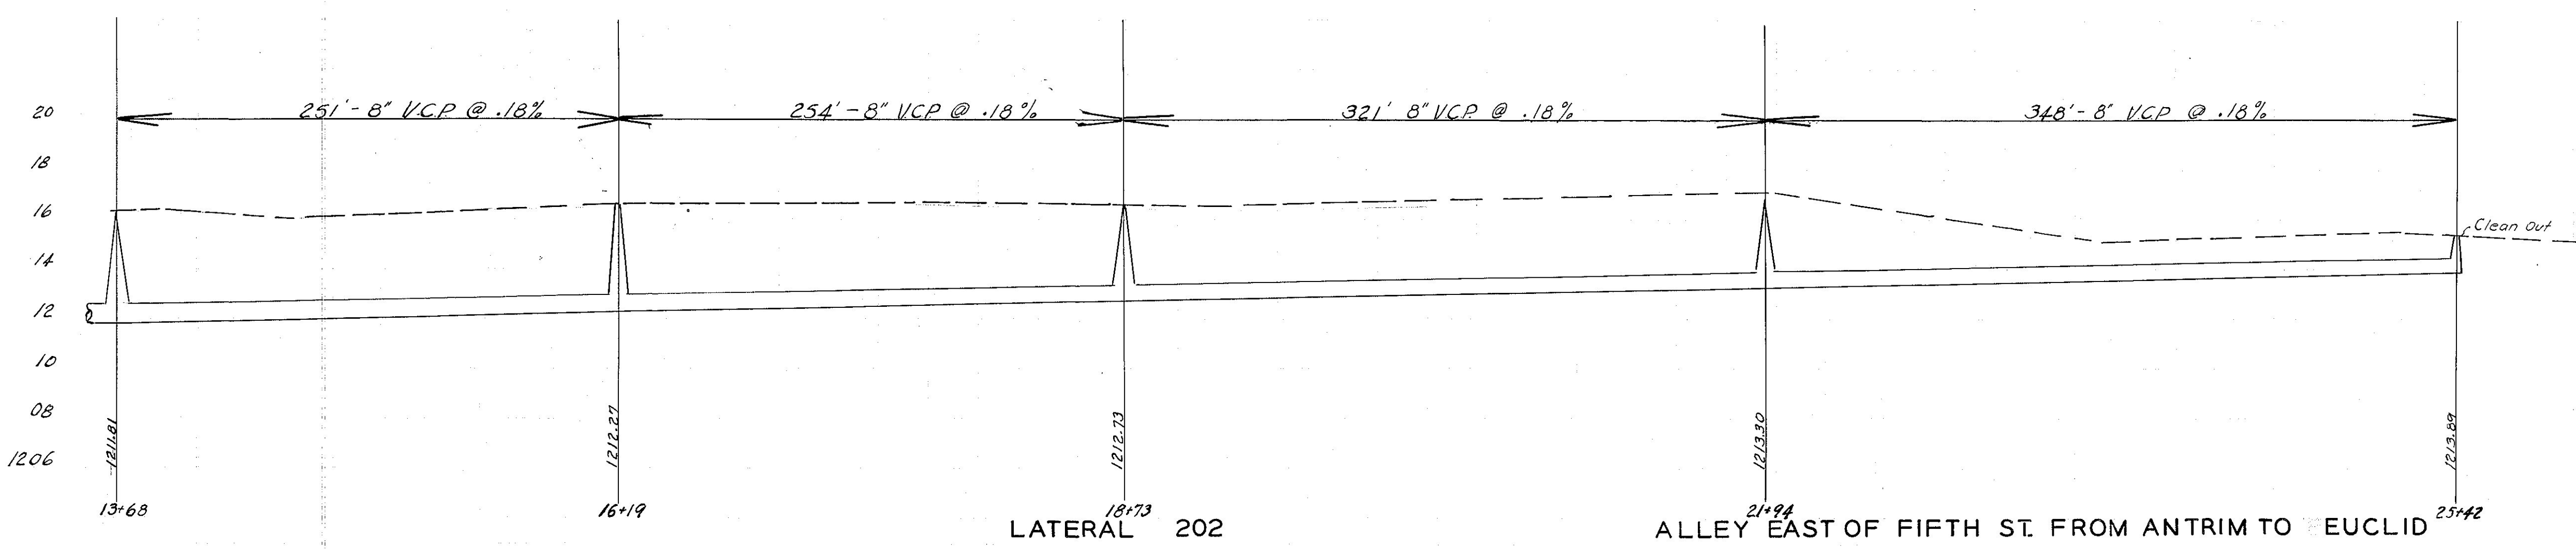
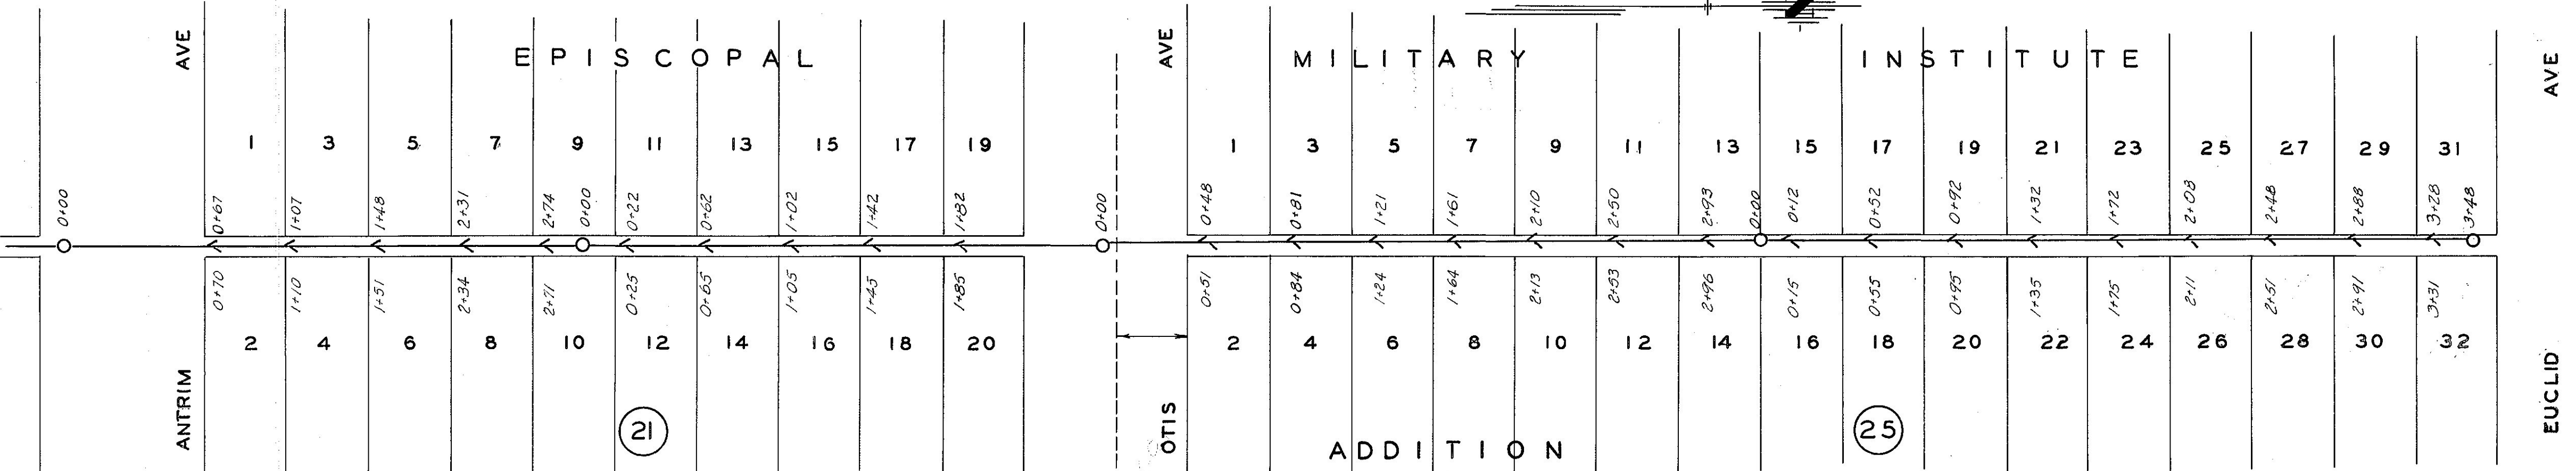
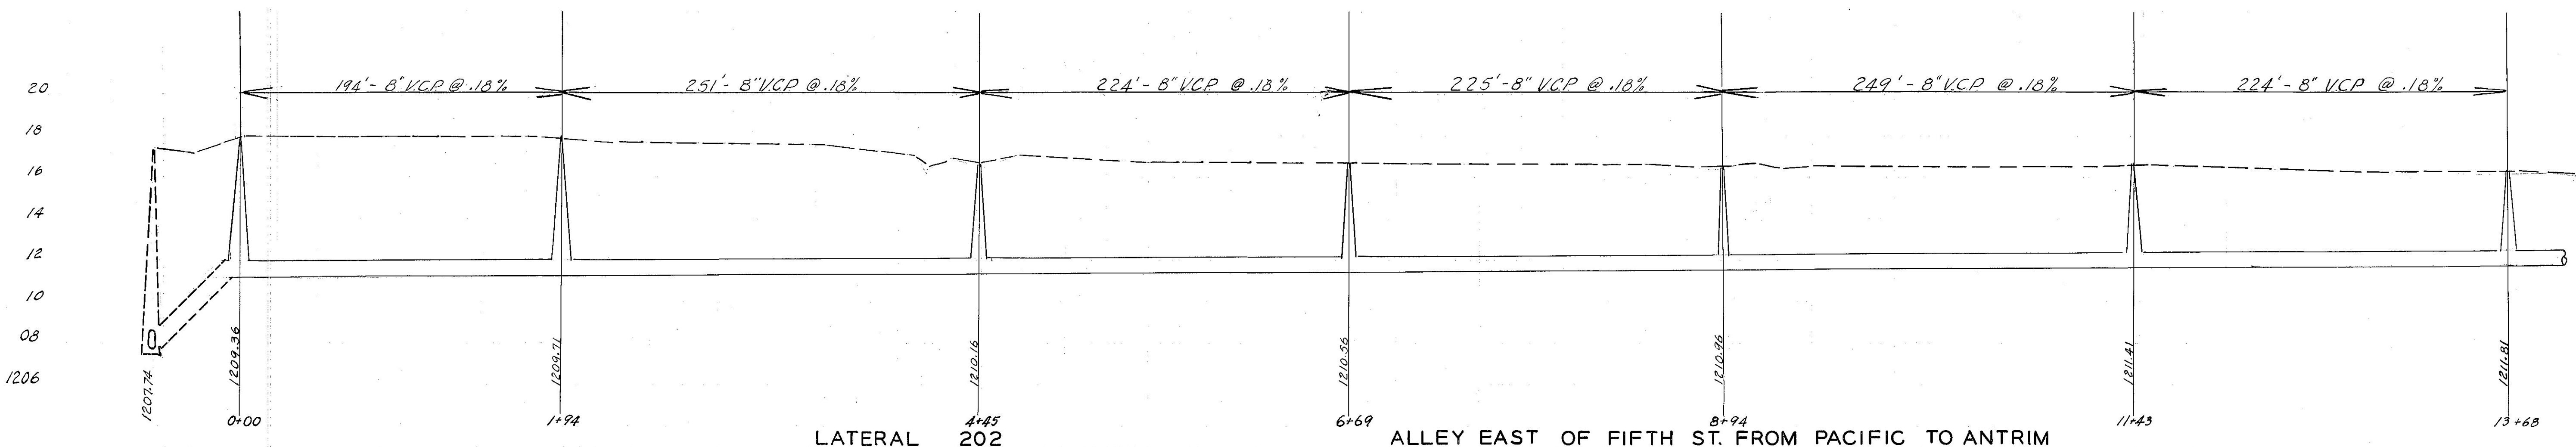


177

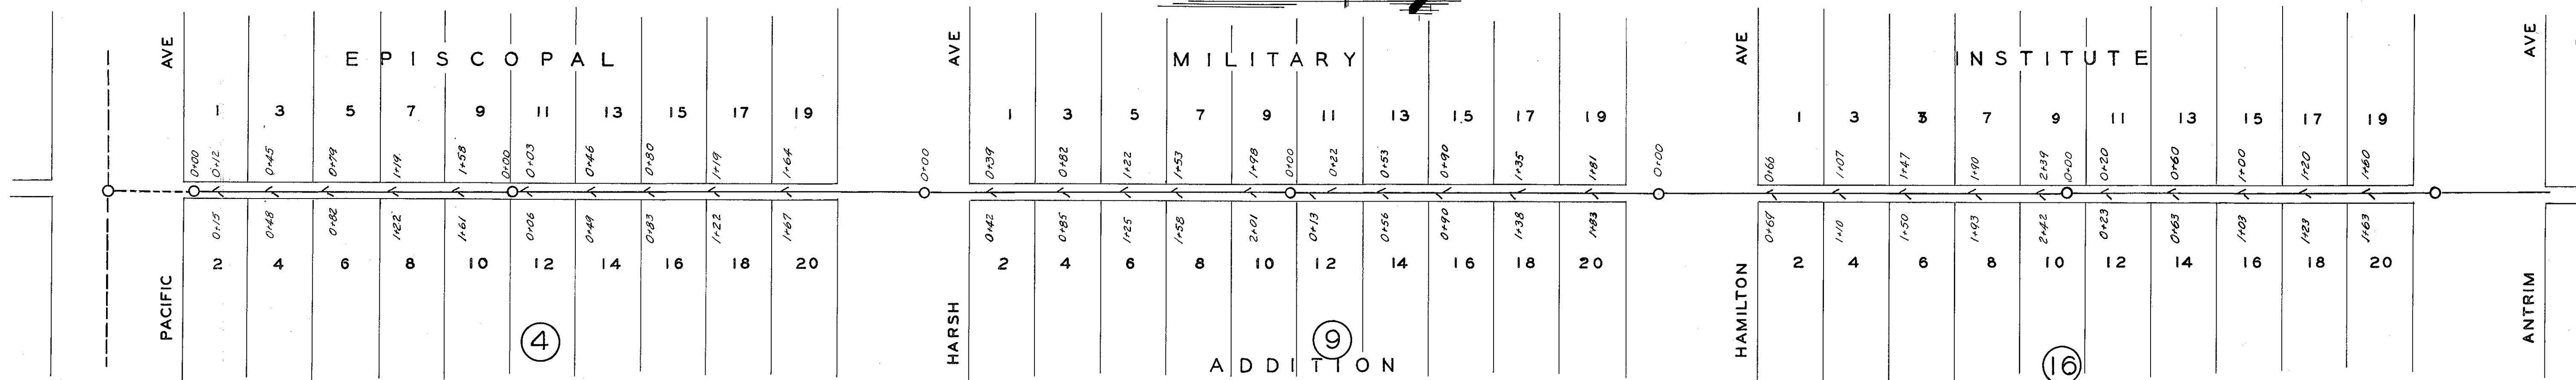

As BUILT PLAN  
 Const'd Feb 46  
 By:  
 H.J. Taylor Const. Co. Salina, Kans

CITY OF SALINA  
 ENGINEERING DEPARTMENT

ALLEY EAST OF FIFTH ST.  
 FROM  
 PACIFIC TO EUCLID  
 JOB NO. 212

ORD NO. 5237  
 H.F. HARPER  
 CITY ENGINEER

FILED Jan 1, 46  
 Charles J. Miller  
 CITY CLERK