


PLAN  
 SURVEYED BY: F. J. BERTHA  
 DATE: APR 27, 1947  
 NOTE BOOK: ALIGNED CHECKED  
 NO. 104 1/2  
 FT. OF WAY CHECKED

PROFILE  
 SURVEYED BY: F. J. BERTHA  
 DATE: APR 27, 1947  
 NOTE BOOK: GRADES CHECKED  
 NO. 104 1/2  
 STRUCTURE NOTATIONS CHECKED



"AS BUILT PLAN"  
 CONST'D 1947 BY: H.J. TAYLOR CO.  
 SALINA KANSAS  
 SCALE 1" = 50'

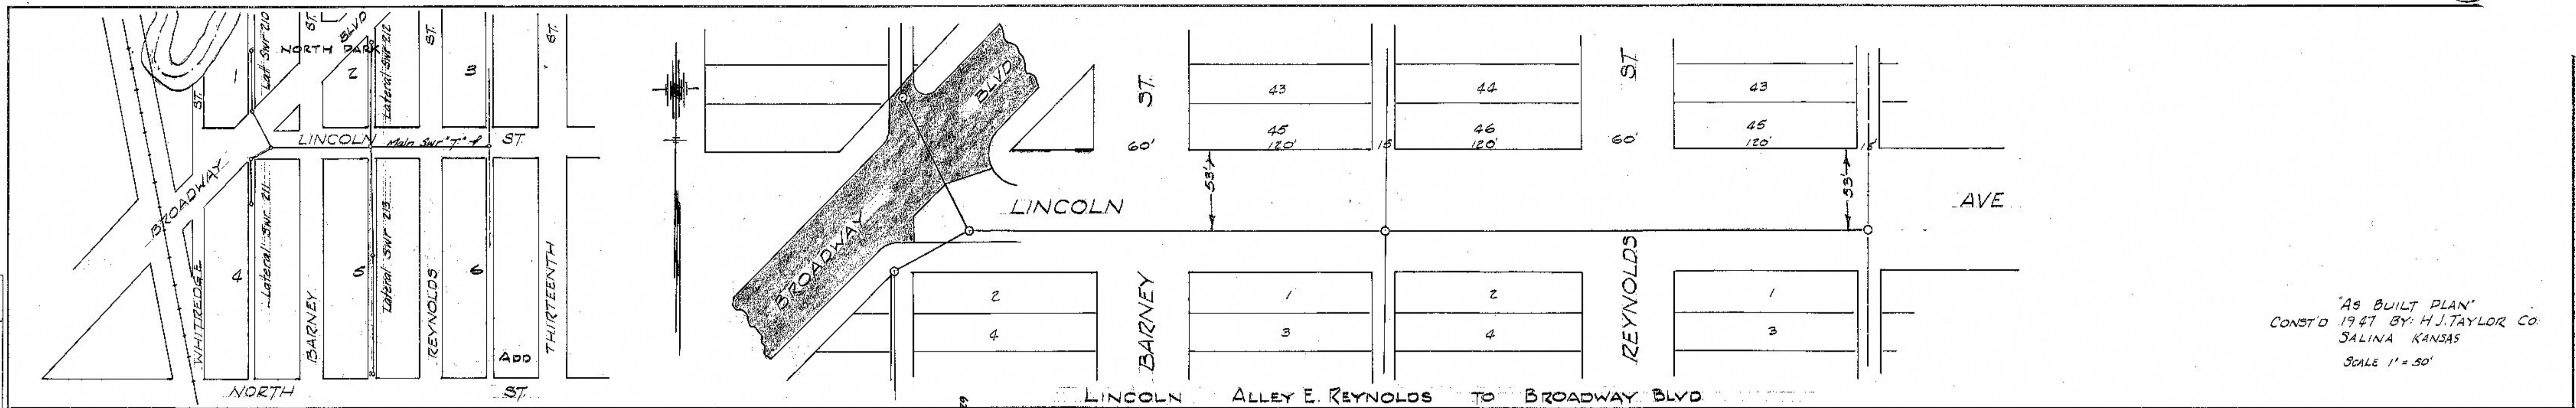