
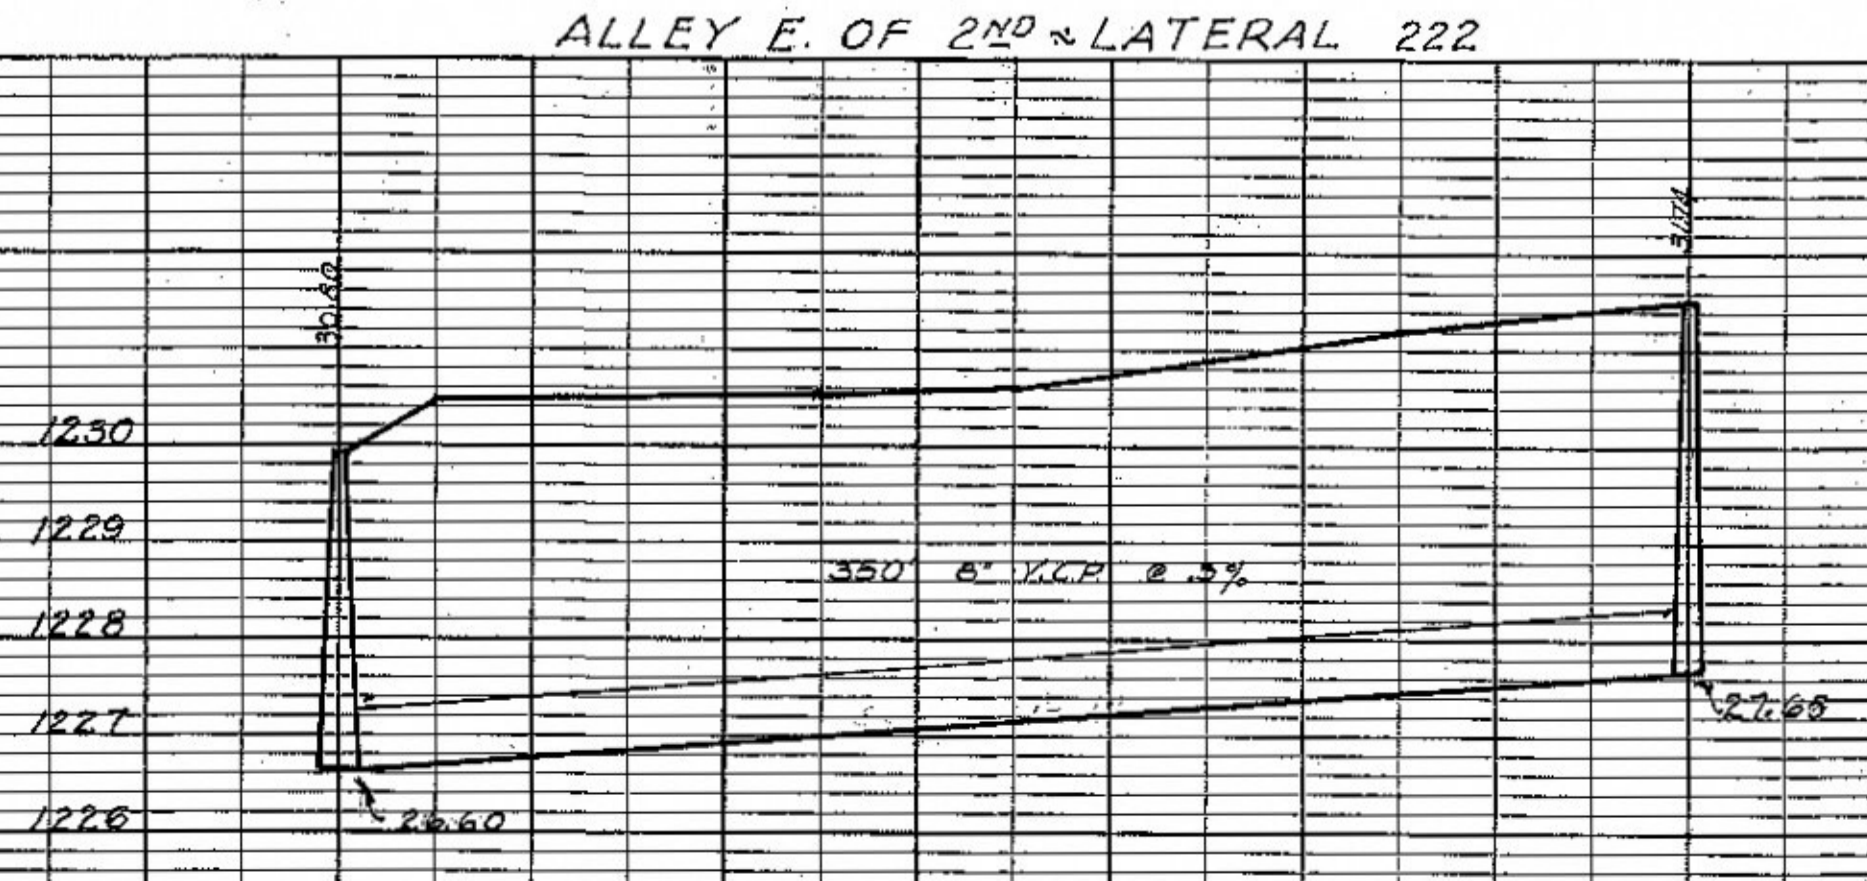
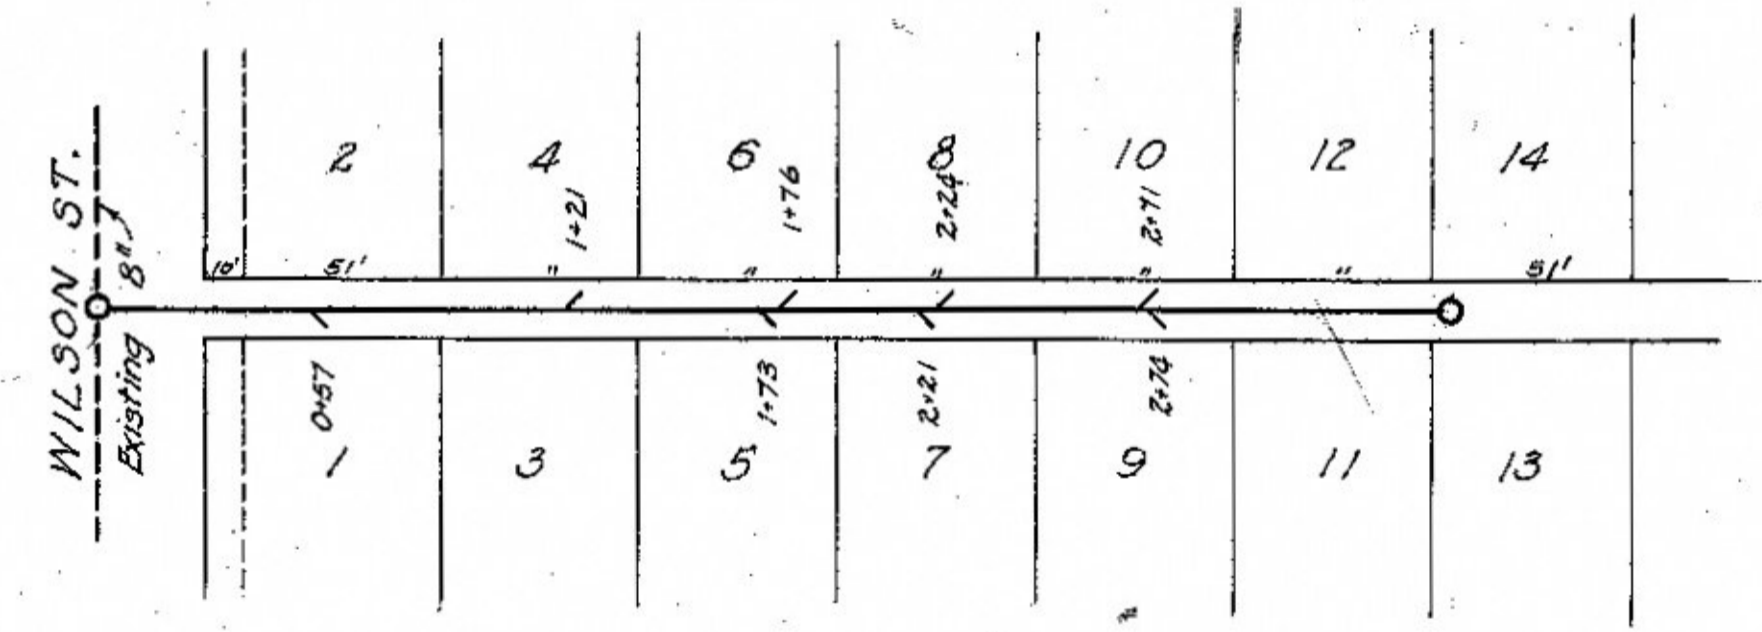
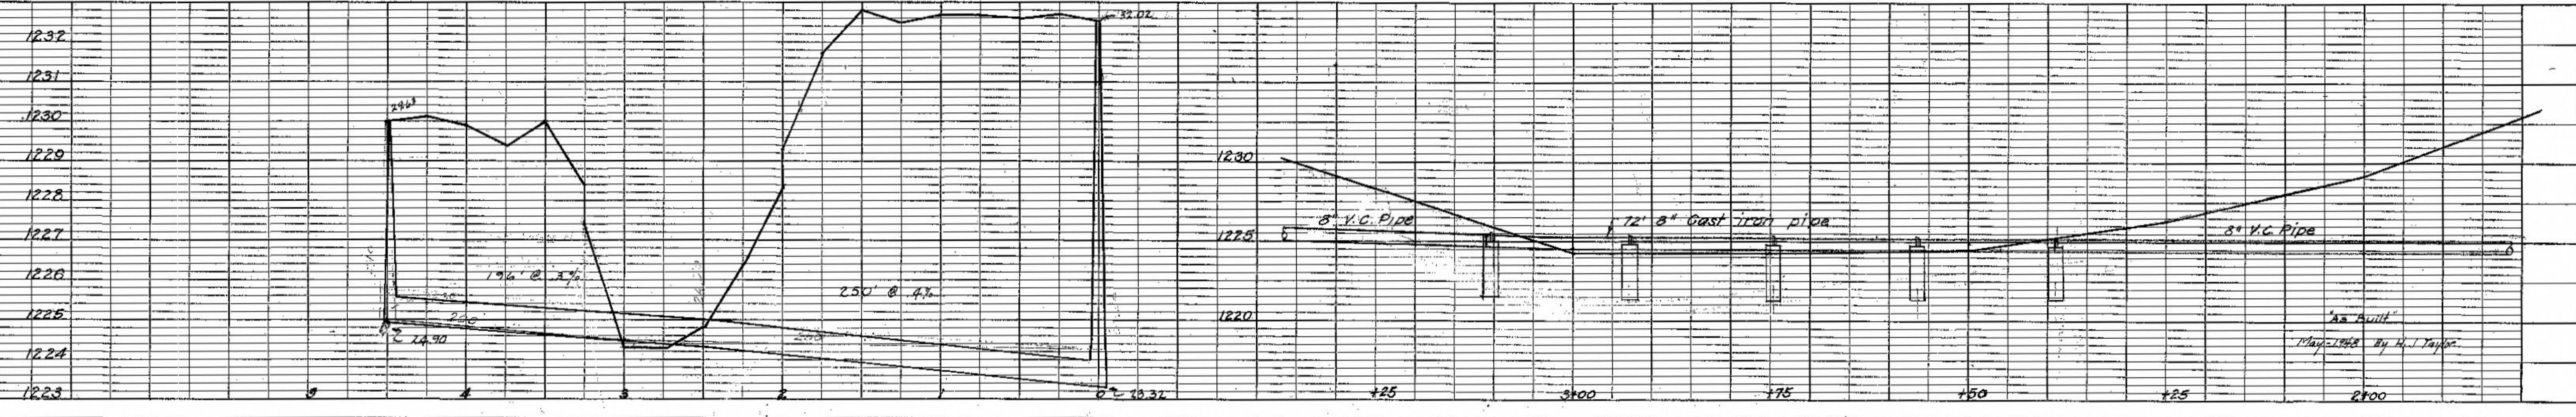
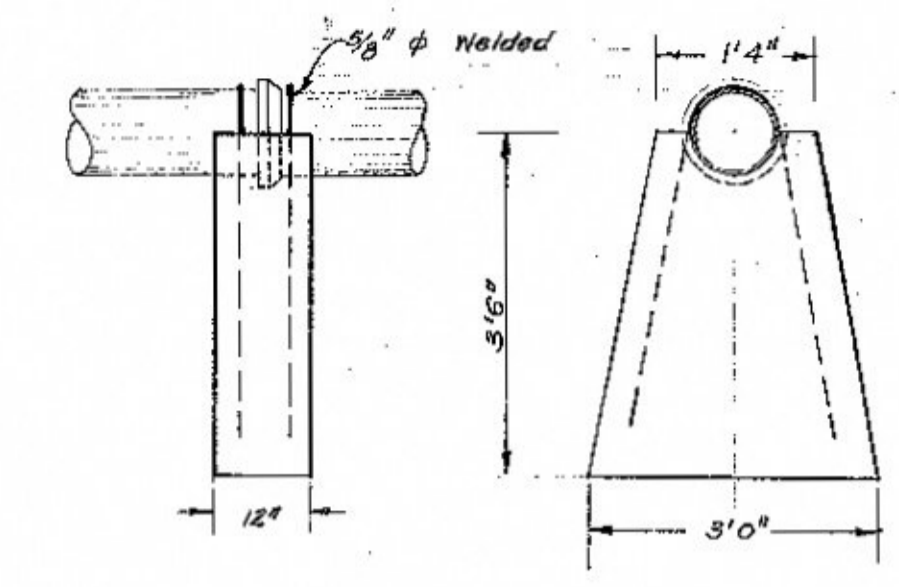


184

PLAN
 SURVEYED
 PLOTTED
 ALIGNMENT CHECKED
 RT. OF WAY CHECKED
 NO. _____

PROFILE
 SURVEYED
 PLOTTED
 GRADES CHECKED
 STRUCTURE NOTATIONS CHECKED
 NO. _____

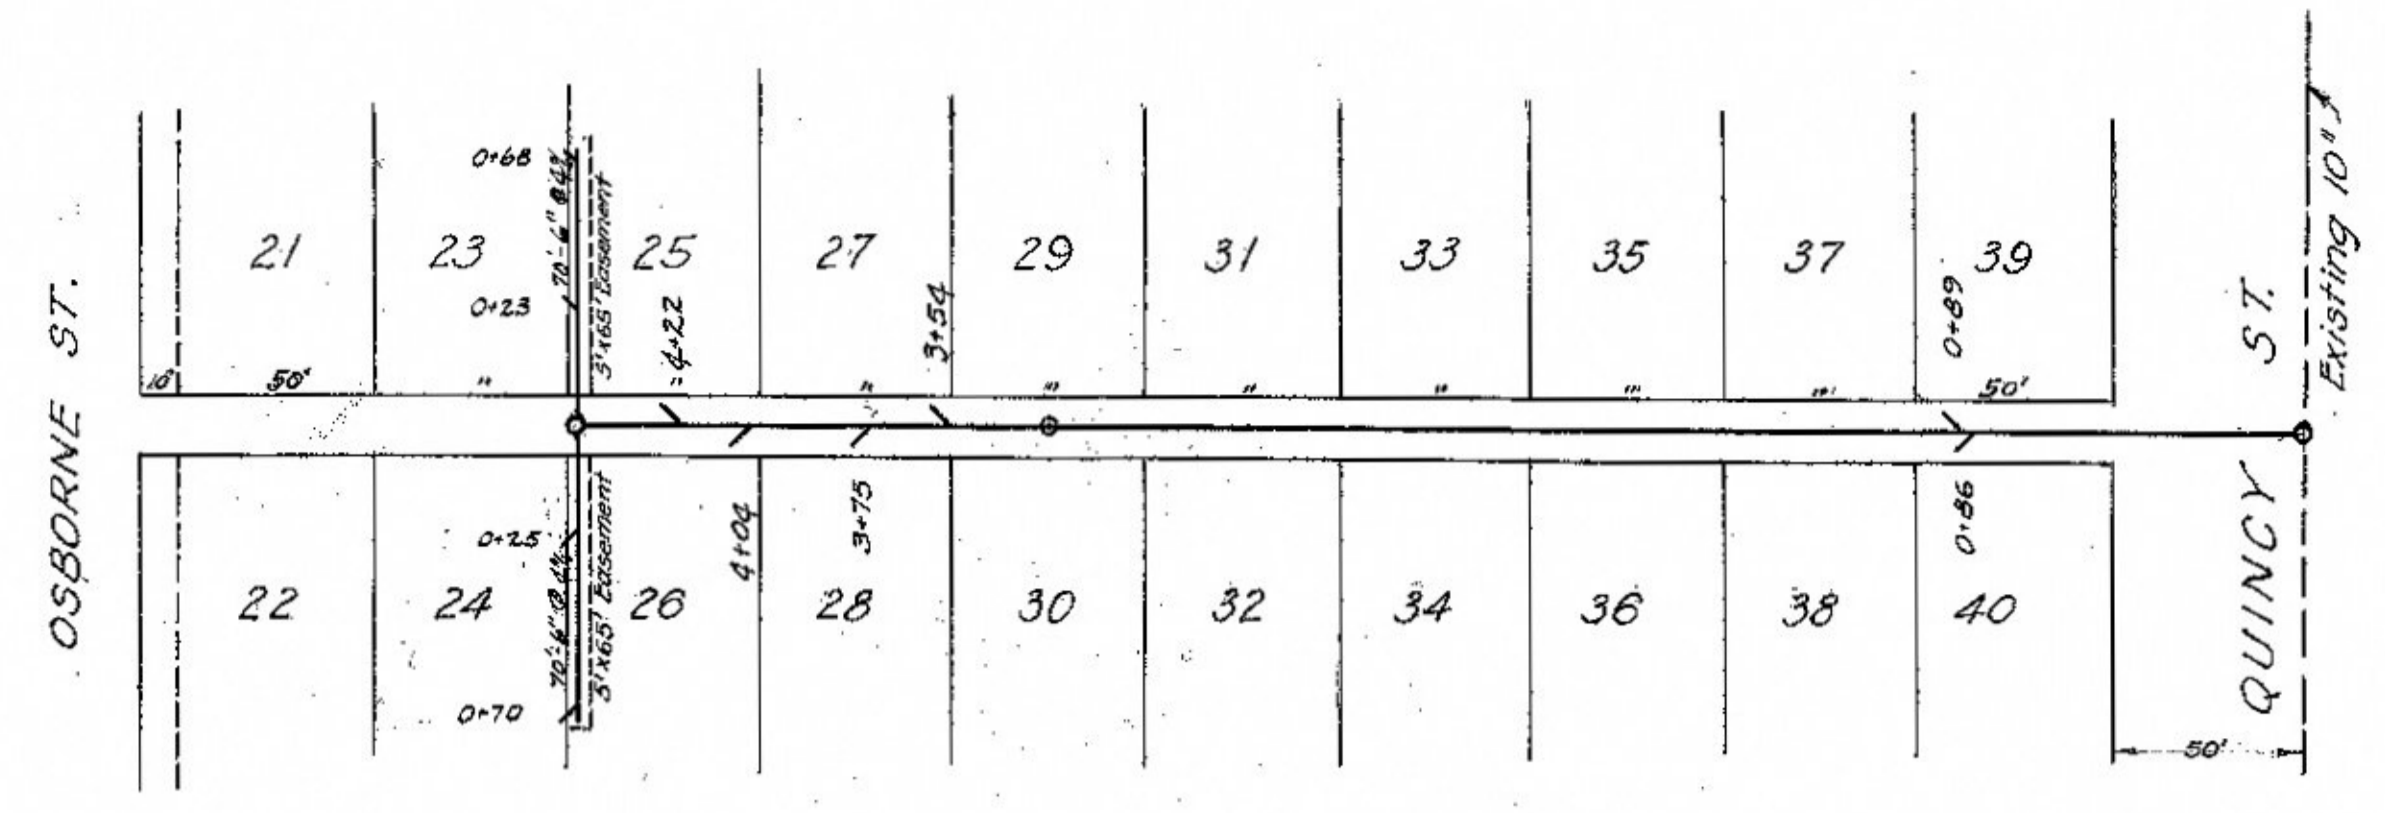

CITY OF SALINA, KANSAS
 ENGINEERING DEPARTMENT
 LATERAL SANITARY
 SEWERS ~ 222 ~ 223
 Filed 1/17/48
 City Engineer City Clerk