



185

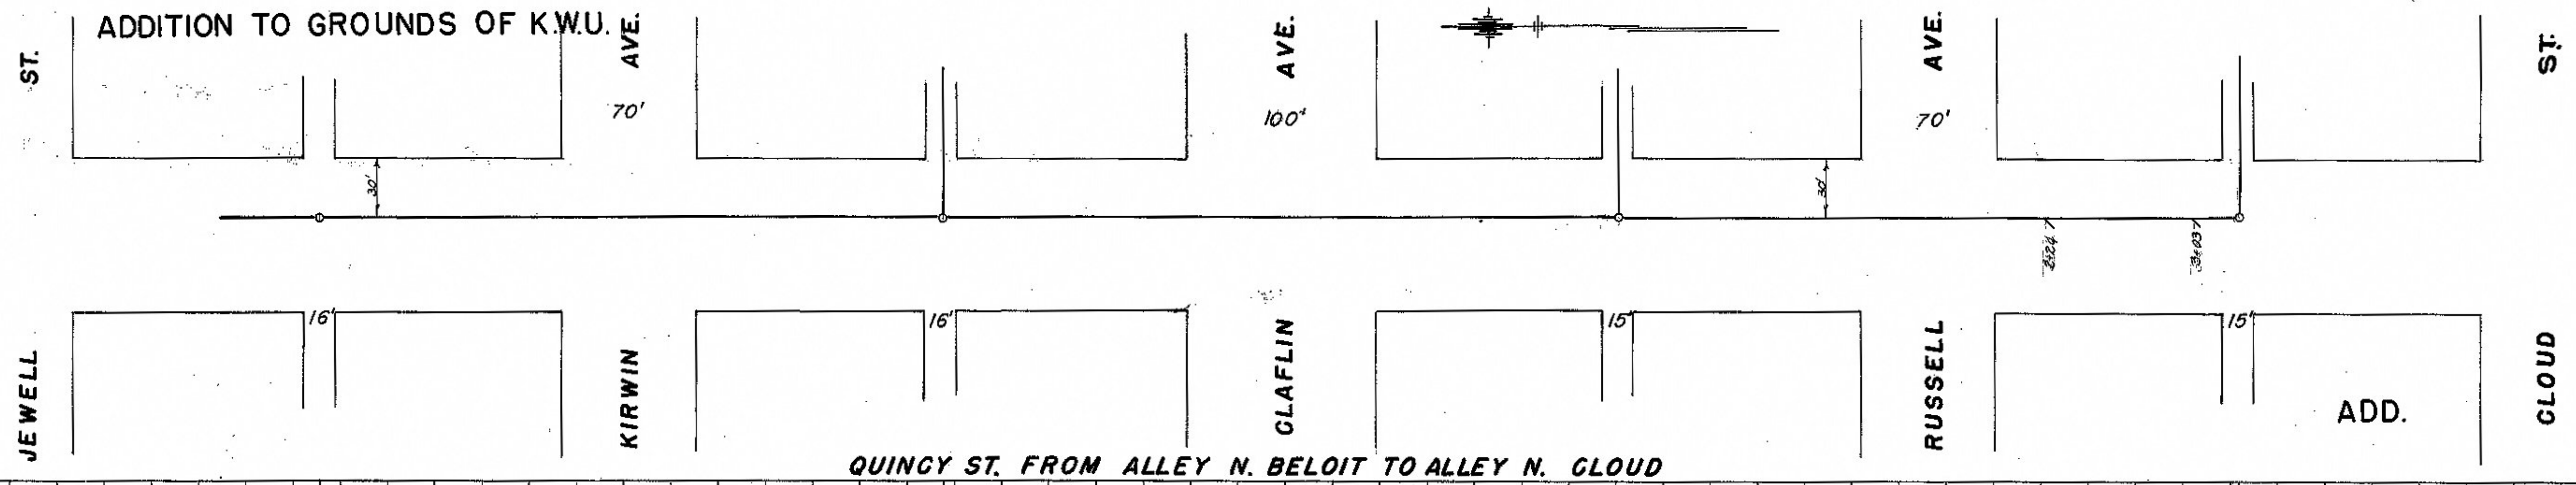


QUINCY ST. FROM ALLEY N. BELOIT TO ALLEY N. CLOUD

PLAN SURVEYED BY DATE
 PLOTTED BY
 NOTE BOOK NO. CHECKED BY
 RT. OF WAY CHECKED BY

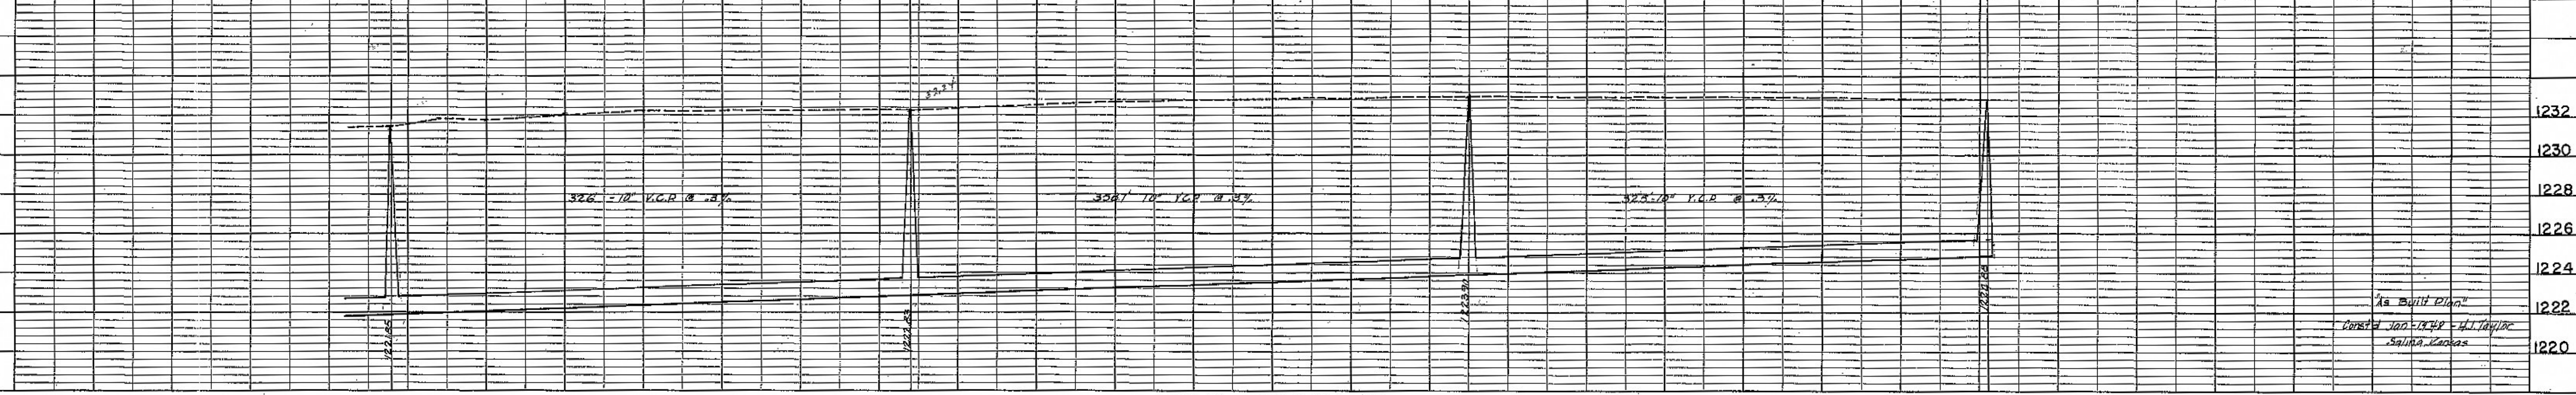


MAIN SANITARY SEWER 'W'

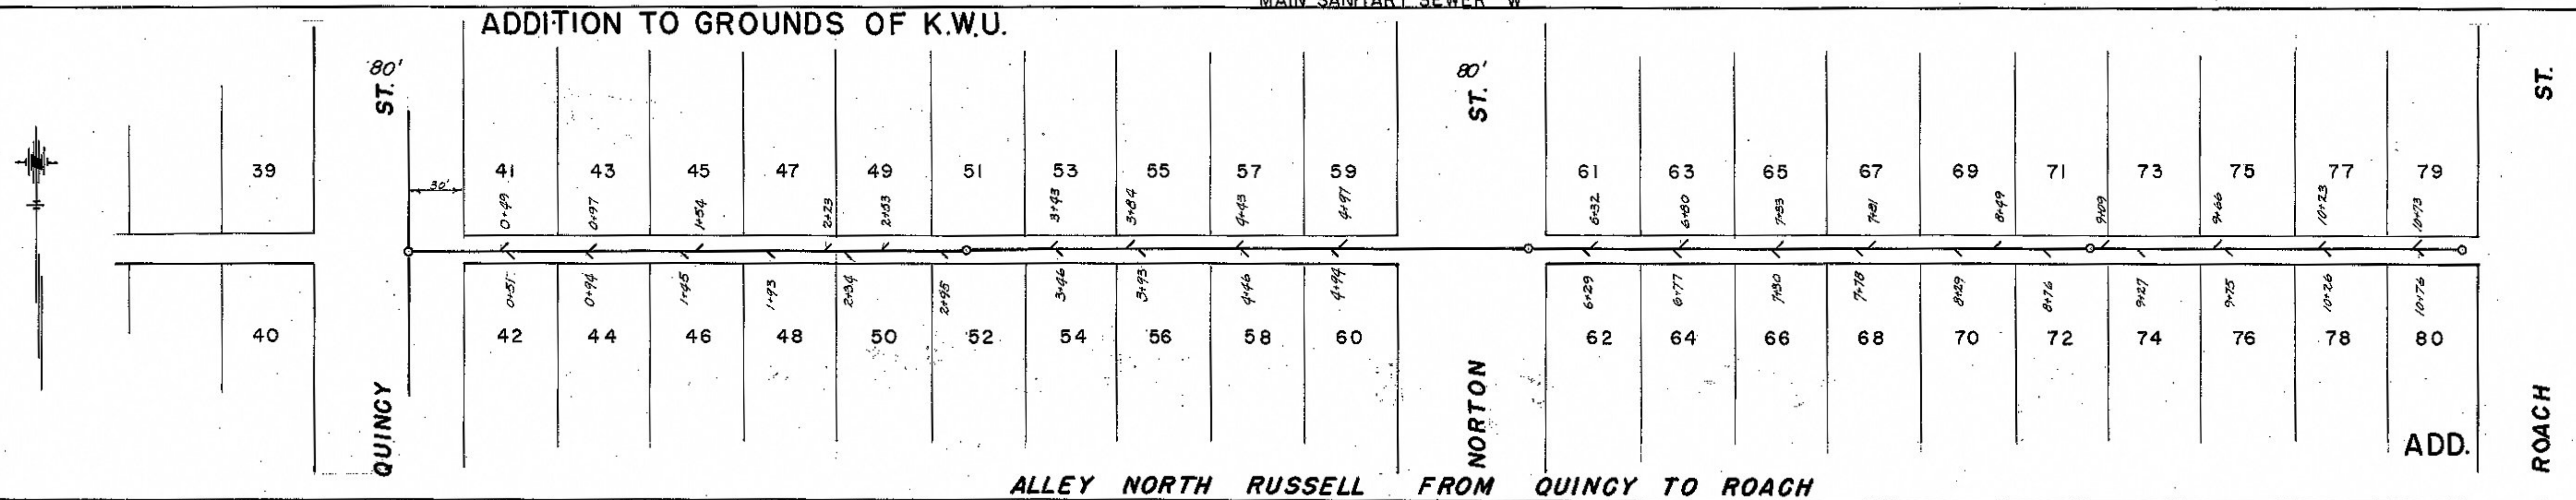

ALLEY NORTH RUSSELL FROM QUINCY TO ROACH

PROFILE SURVEYED BY DATE
 NOTE BOOK NO. CHECKED BY
 S.M.A. NOTED BY
 STRUCTURE NOTATIONS CH. CH.

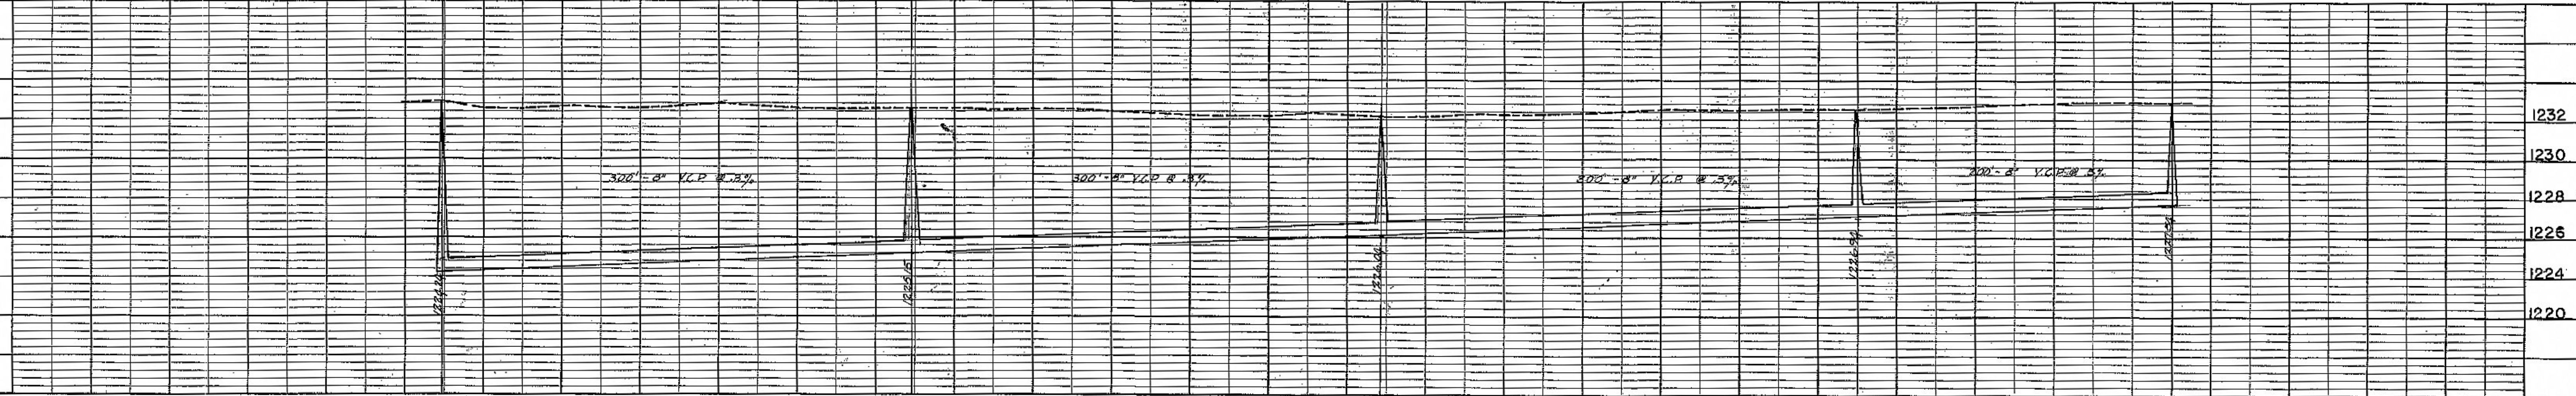

LATERAL SANITARY SEWER NO. 218