


ADDITION TO GROUNDS OF K.W.U.

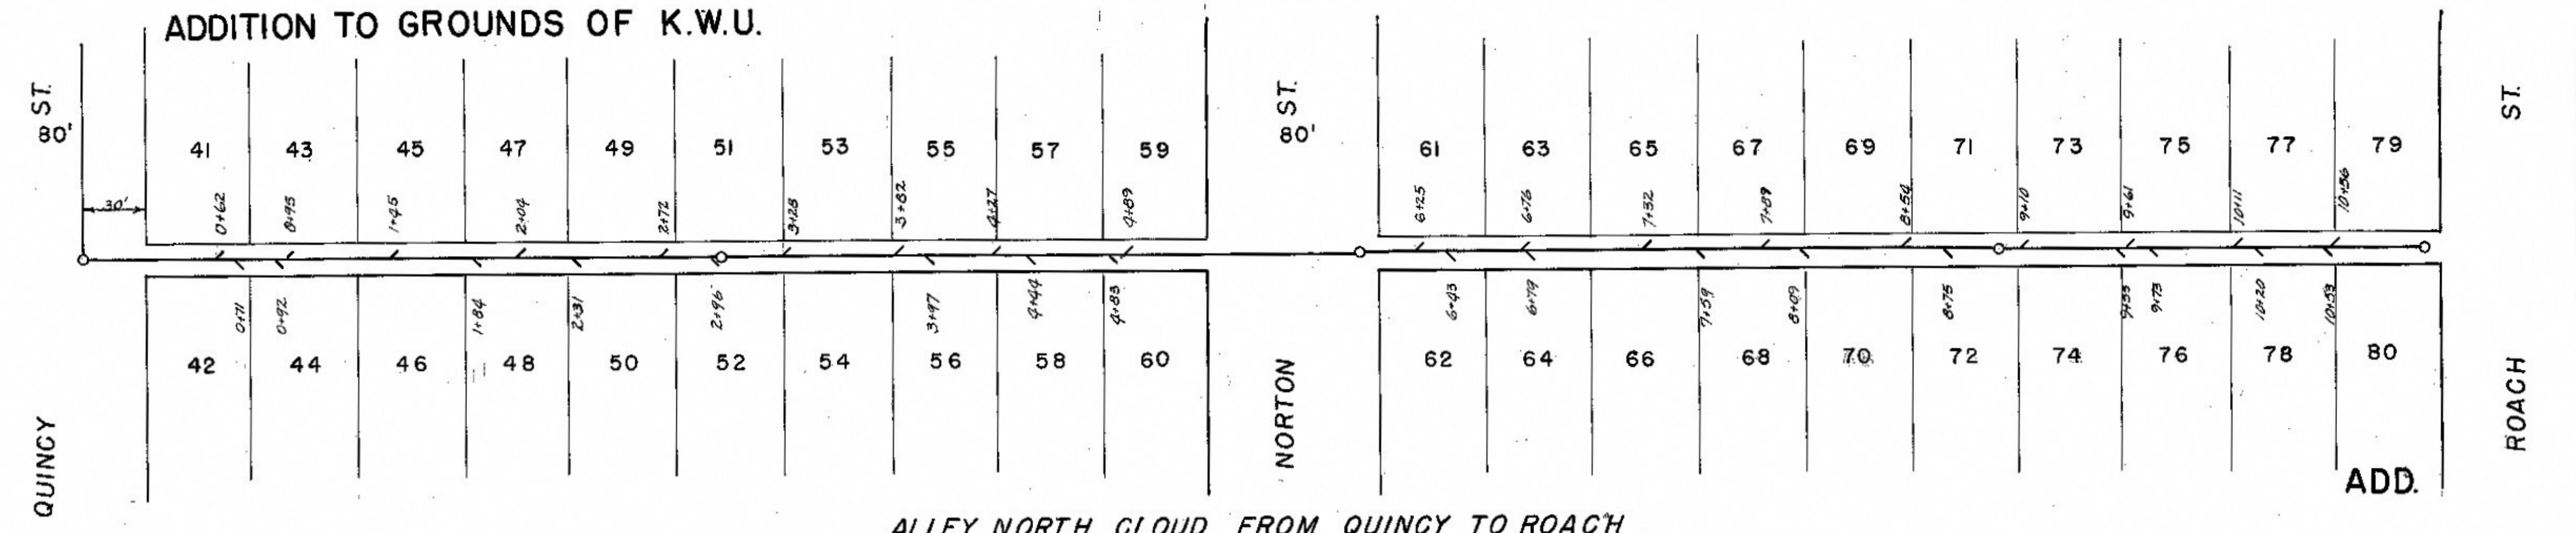

PLAN

SURVEYED BY _____ DATE _____

NOTE BOOK NO. _____

ALIGNMENT CHECKED _____

RT. OF WAY CHECKED _____

PROFILE

SURVEYED BY _____ DATE _____

NOTE BOOK NO. _____

GRADES CHECKED _____

S.M.S. NOTED _____

STRUCTURE NOT'G CHECK _____

