



188

PLAN SURVEYED, PLOTTED, ALIGNED, CHECKED, BY: ST. DATE: NO. NOTE BOOK NO. STRUCTURE NOTATION CHECK


PROFILE SURVEYED, PLOTTED, CHECKED, BY: ST. DATE: NO. NOTE BOOK NO. STRUCTURE NOTATION CHECK

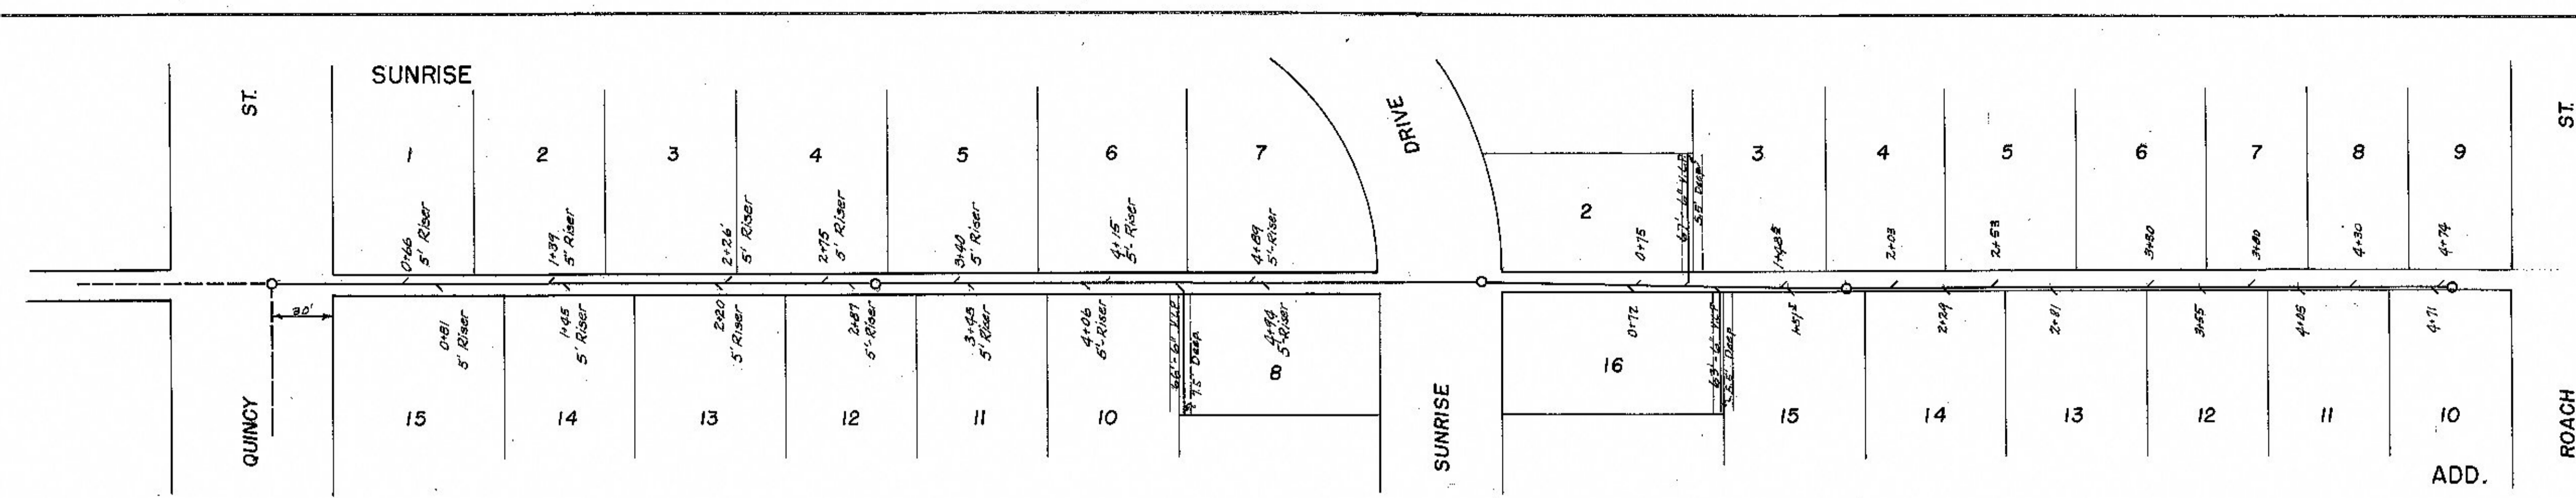



ALLEY N. BELOIT FROM QUINCY TO ROACH

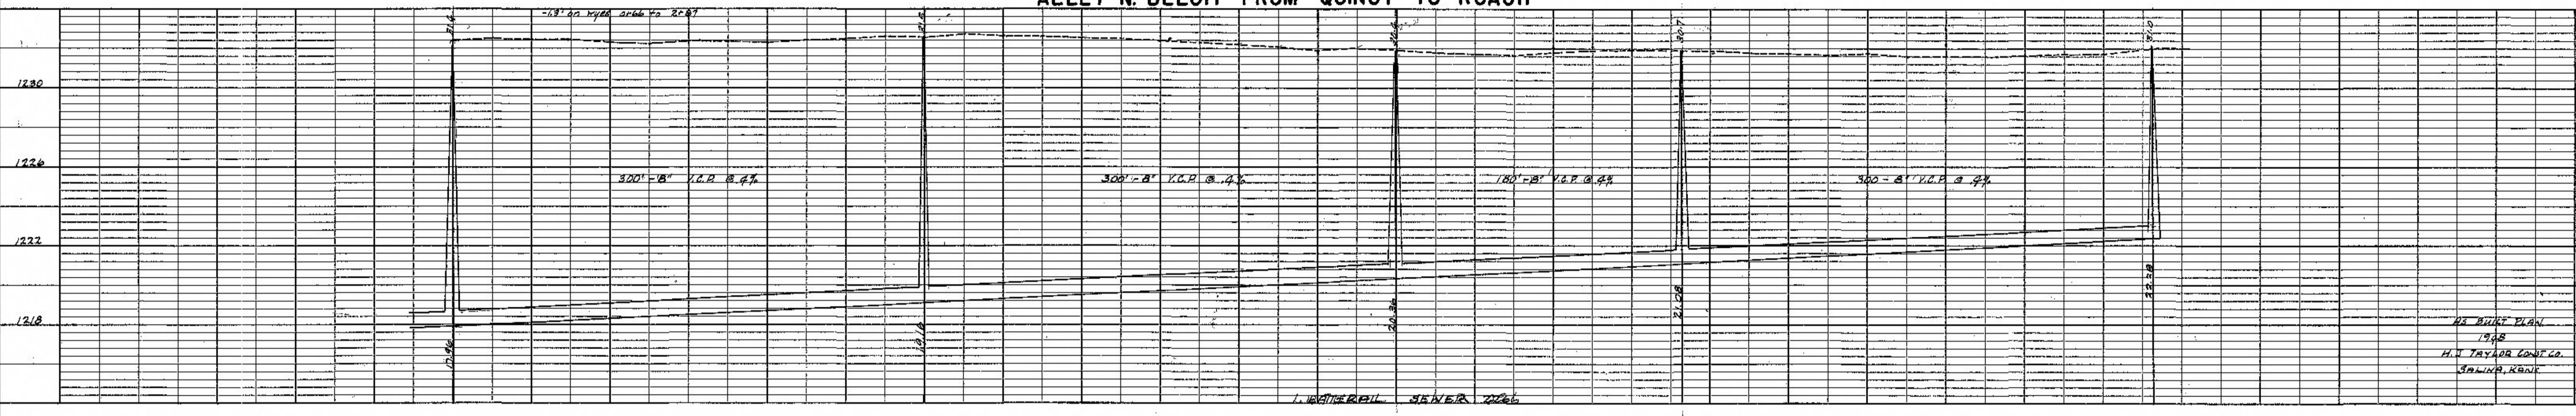

AS BUILT PLAN
1948
H. J. TAYLOR CONCRETE CO.
SALINA, KANSAS

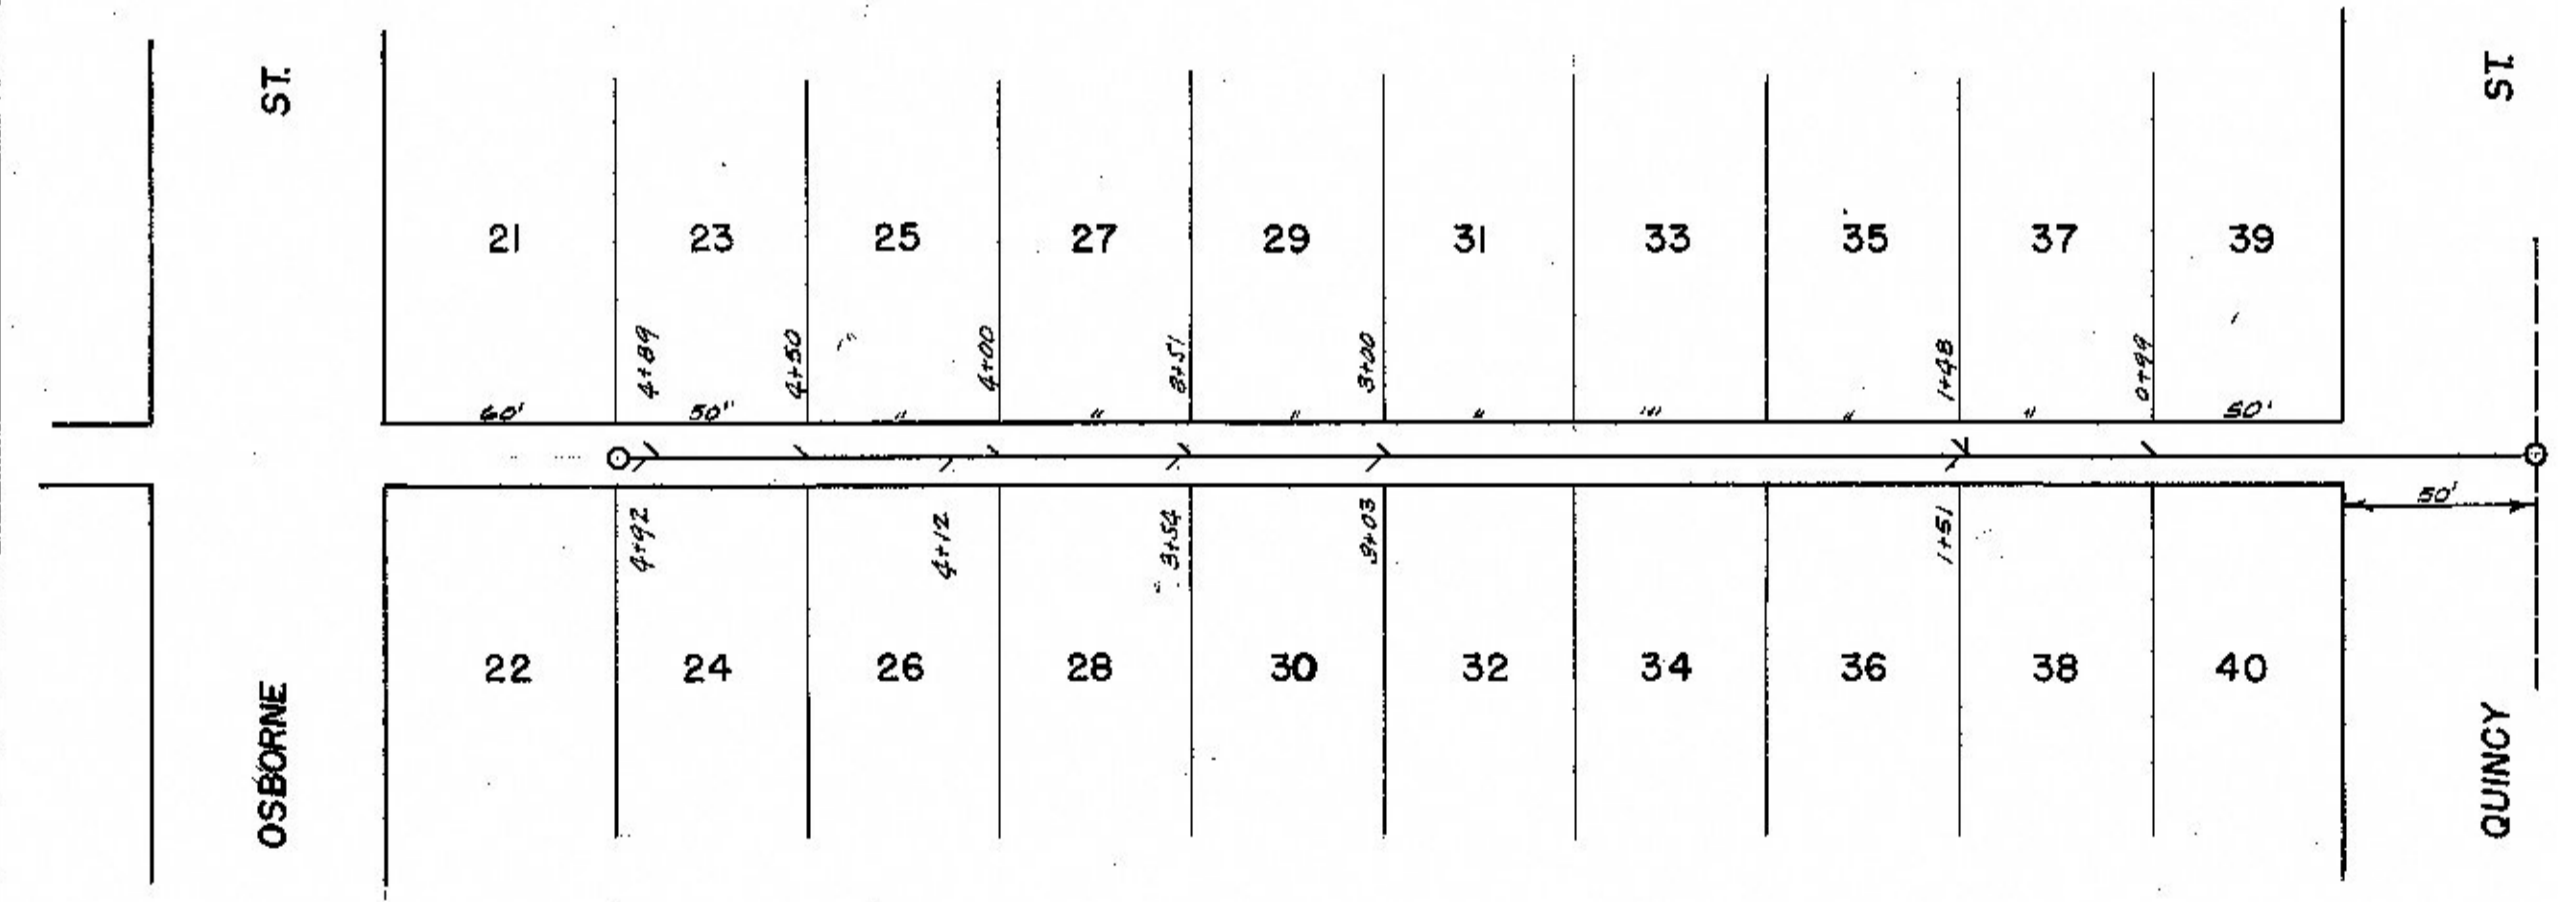

ALLEY N. CLAFLIN - QUINCY TO OSBORNE

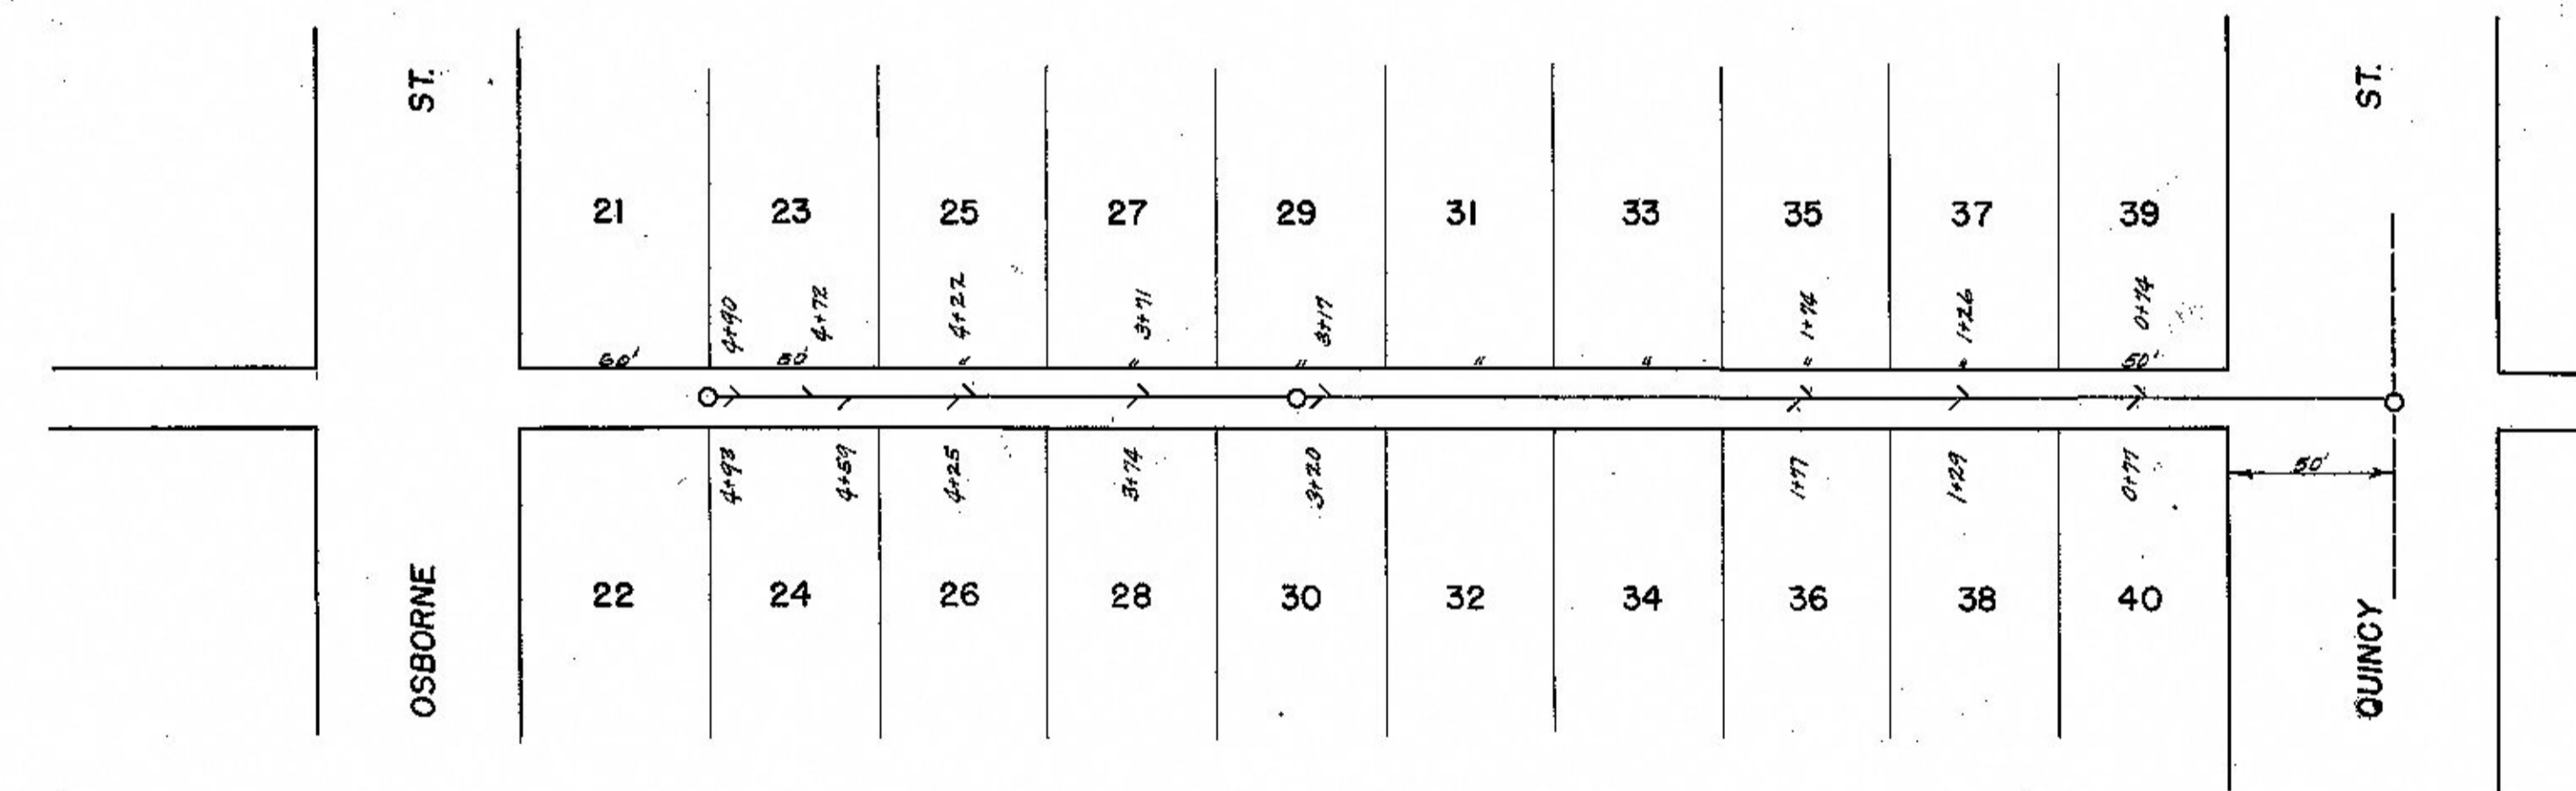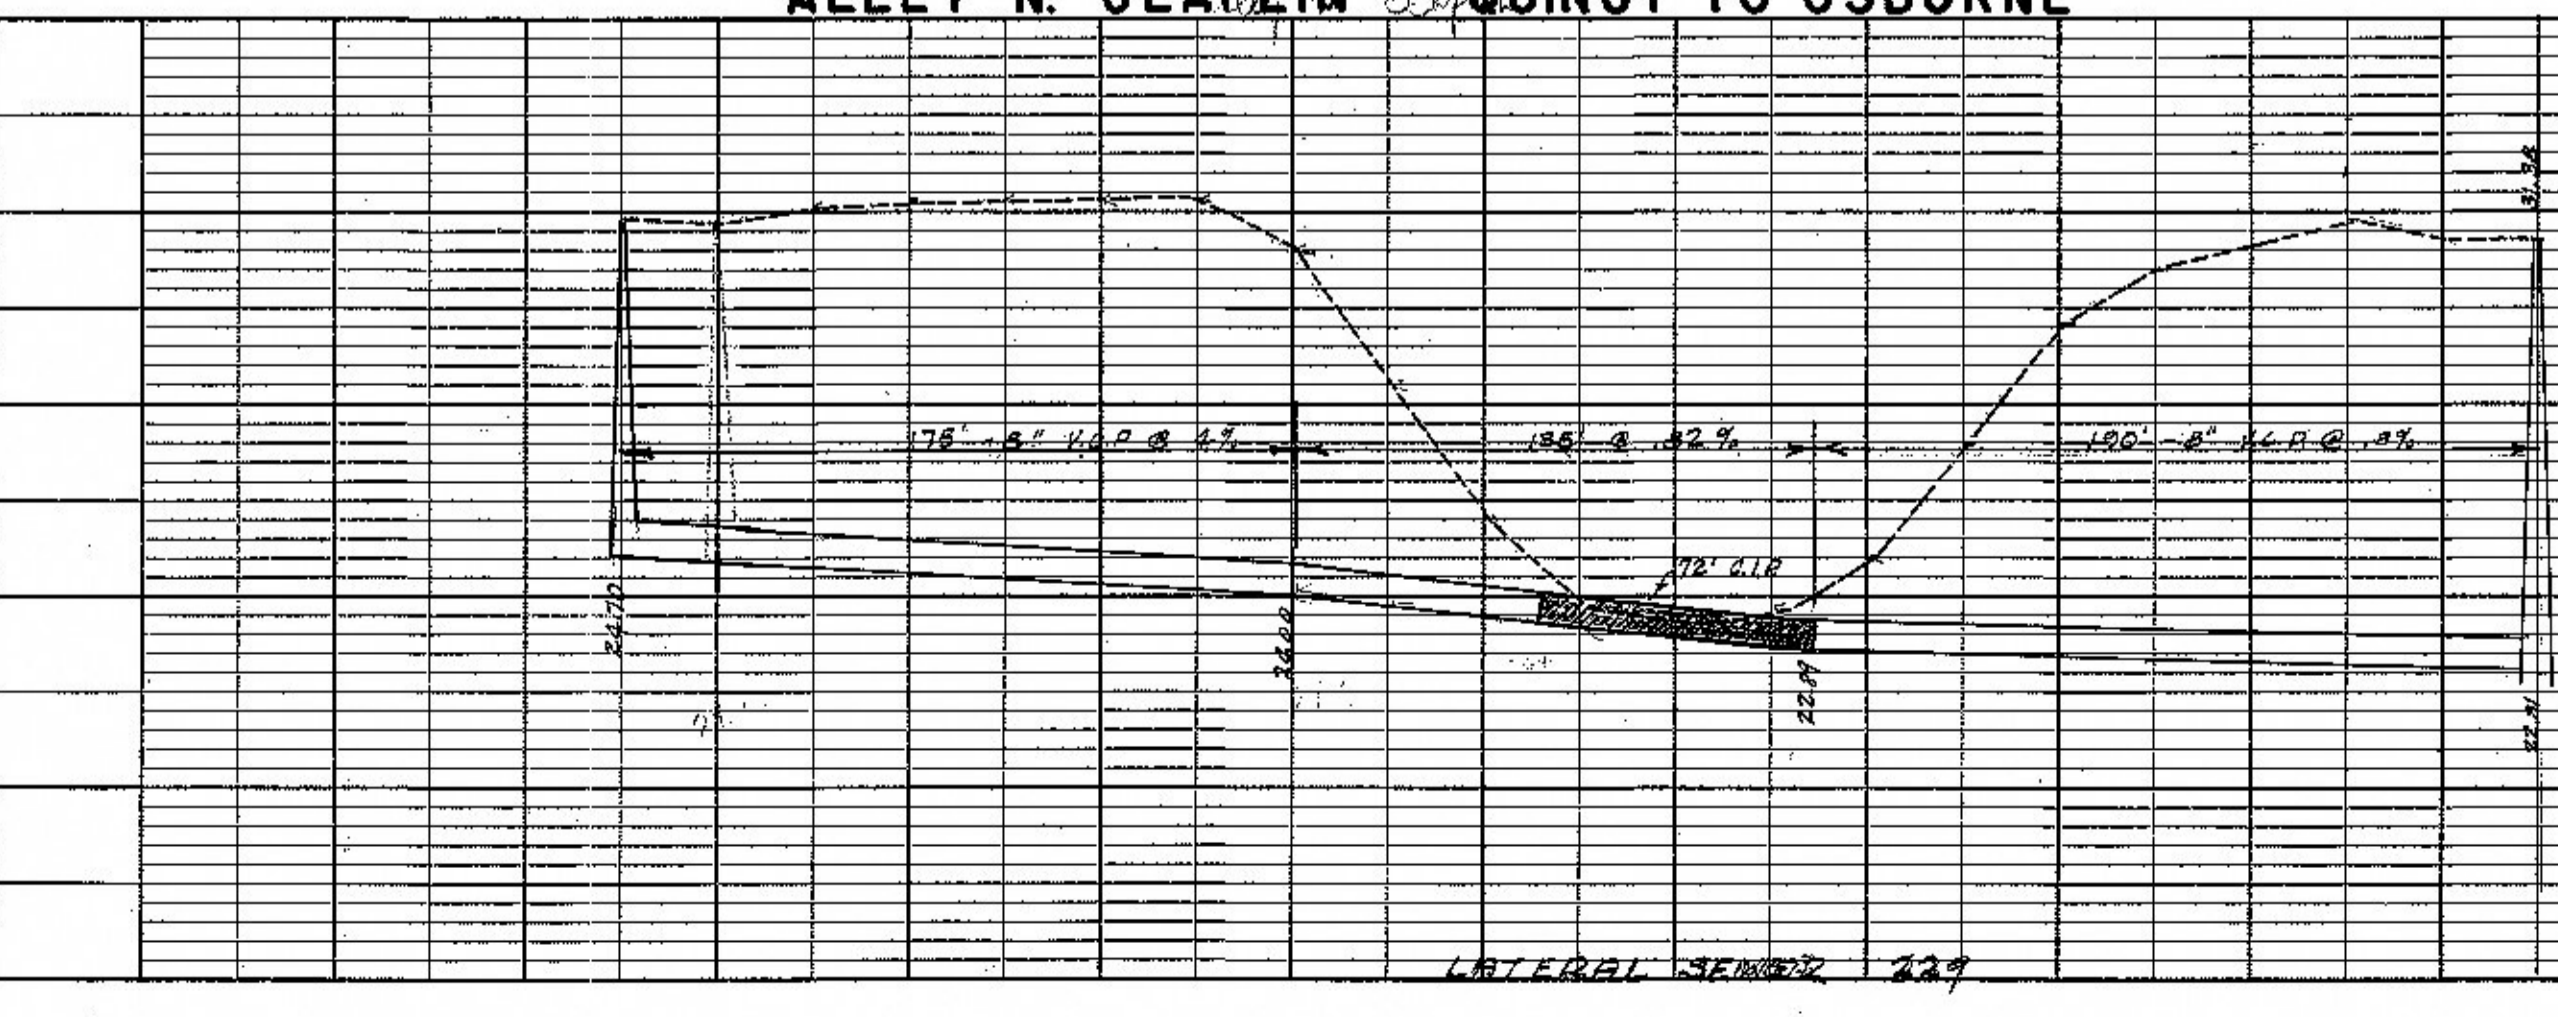

ALLEY N. ELLSWORTH - QUINCY TO OSBORNE

