



189

DATE	APR 24 1927
BY	B. H. H. & E. S. S.
SURVEYED	BY
PLANNED	BY
NOTE BOOK	CHECKED
NO.	RT. OF WAY CHECKED

DATE	
BY	
SURVEYED	BY
NOTE BOOK	CHECKED
NO.	STRUCTURE NOTATIONS CHECKED

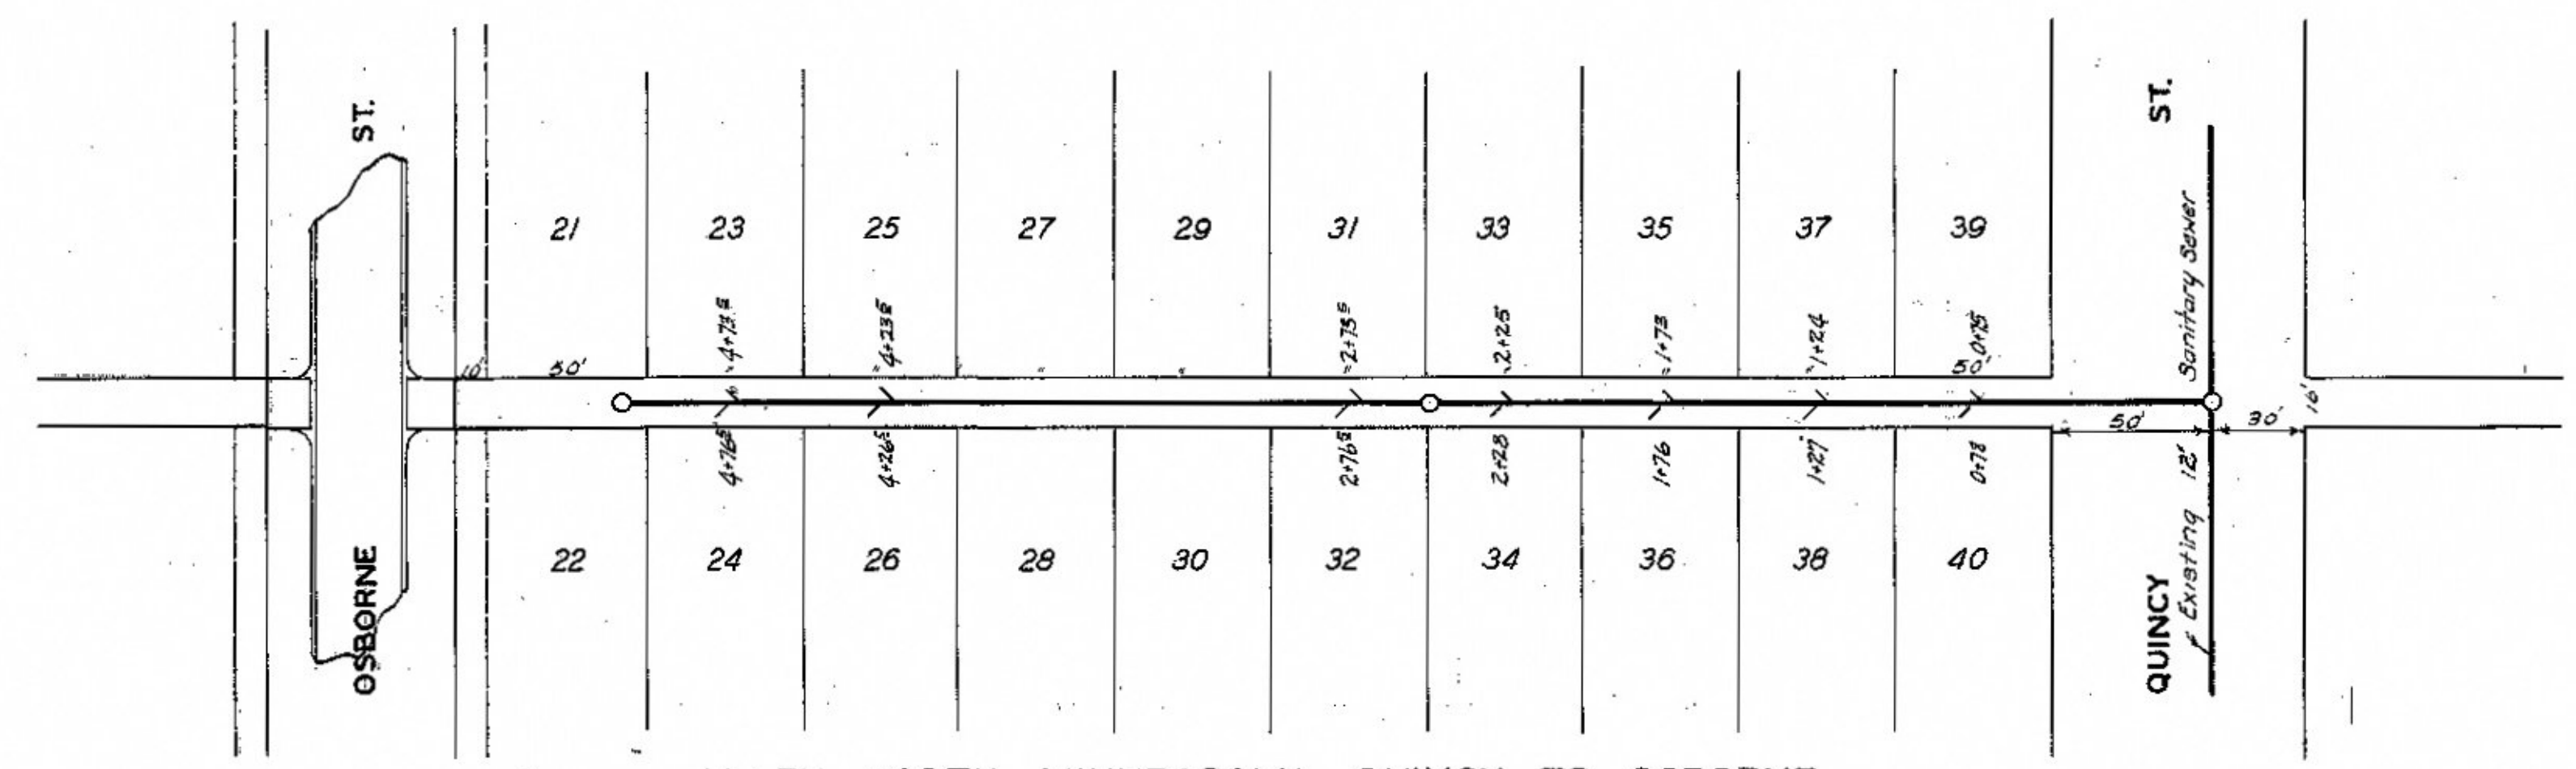


ALLEY NORTH MINNEAPOLIS QUINCY TO OSBORNE

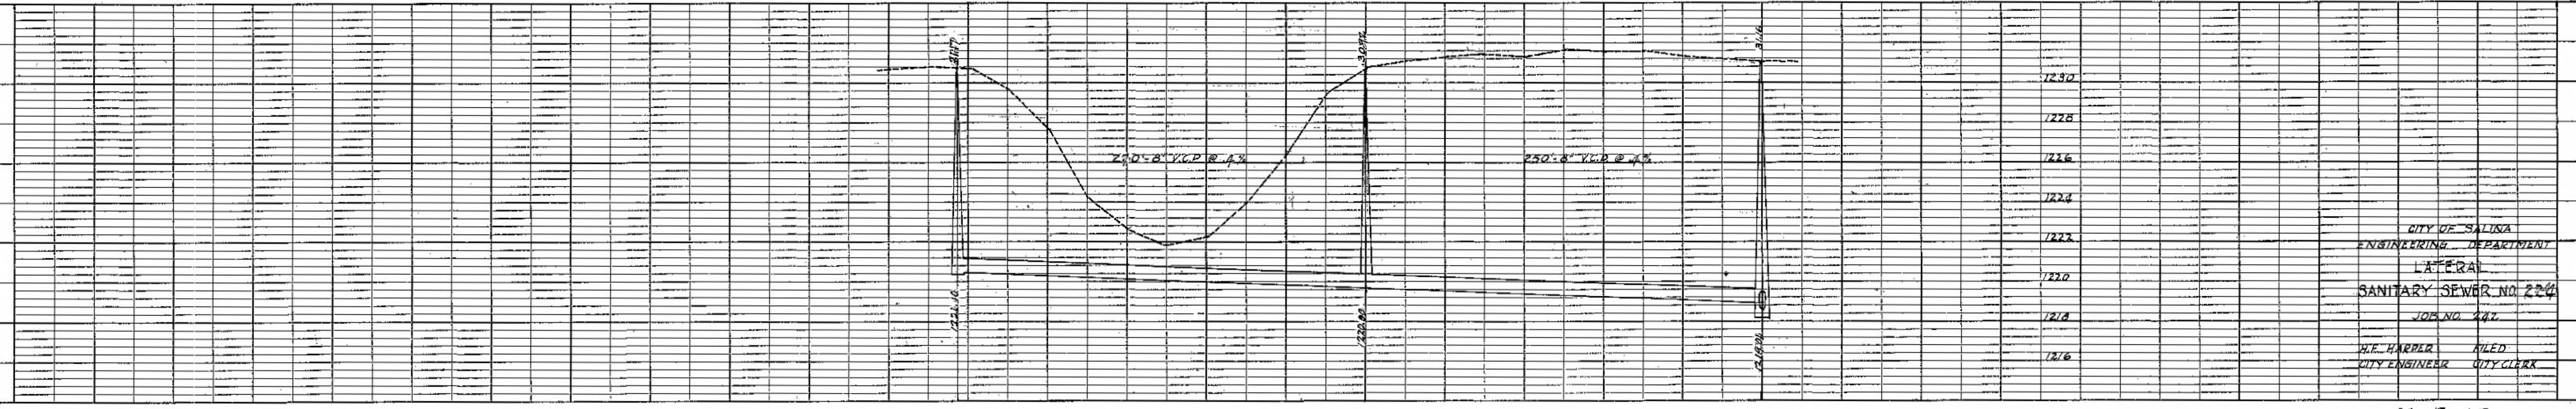


CITY OF SALINA
ENGINEERING DEPARTMENT
LATERAL
SANITARY SEWER NO. 224
JOB NO. 227
H. F. HARPER FILED
CITY ENGINEER CITY CLERK

AS BUILT

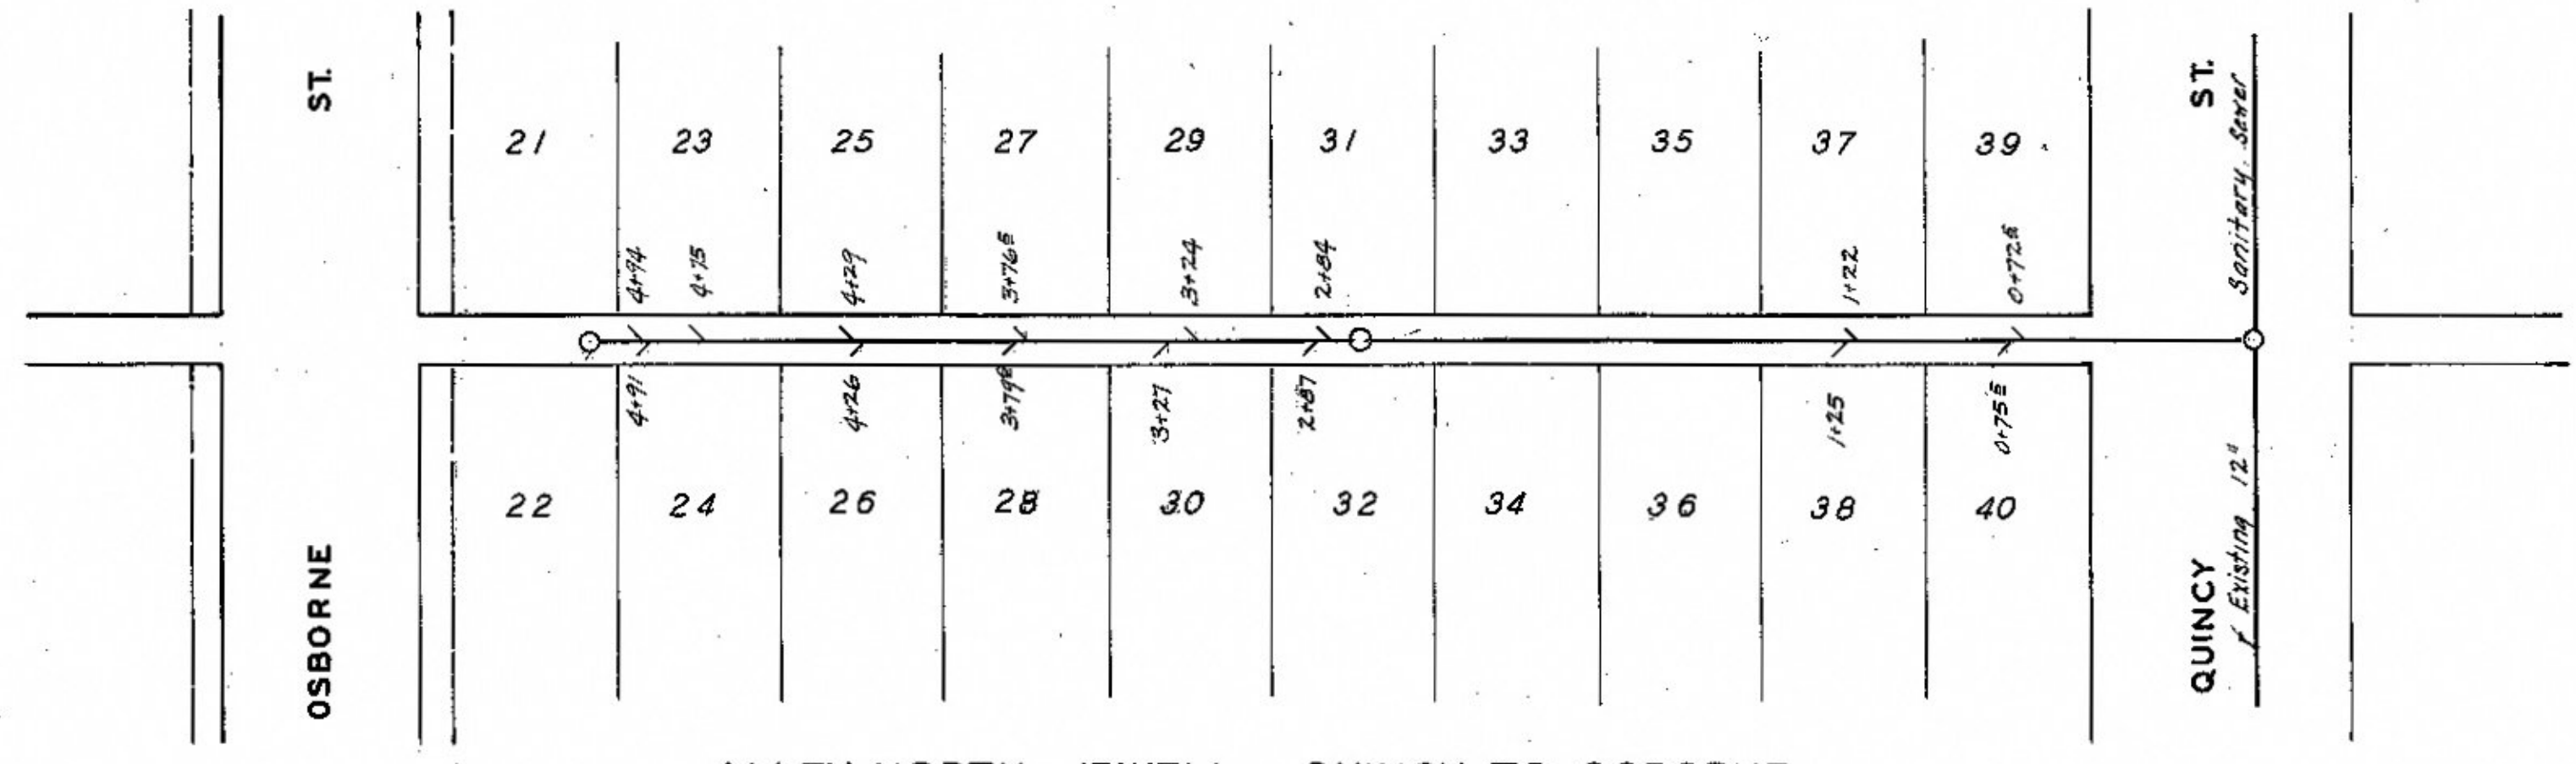

ALLEY NORTH JEWELL - QUINCY TO OSBORNE

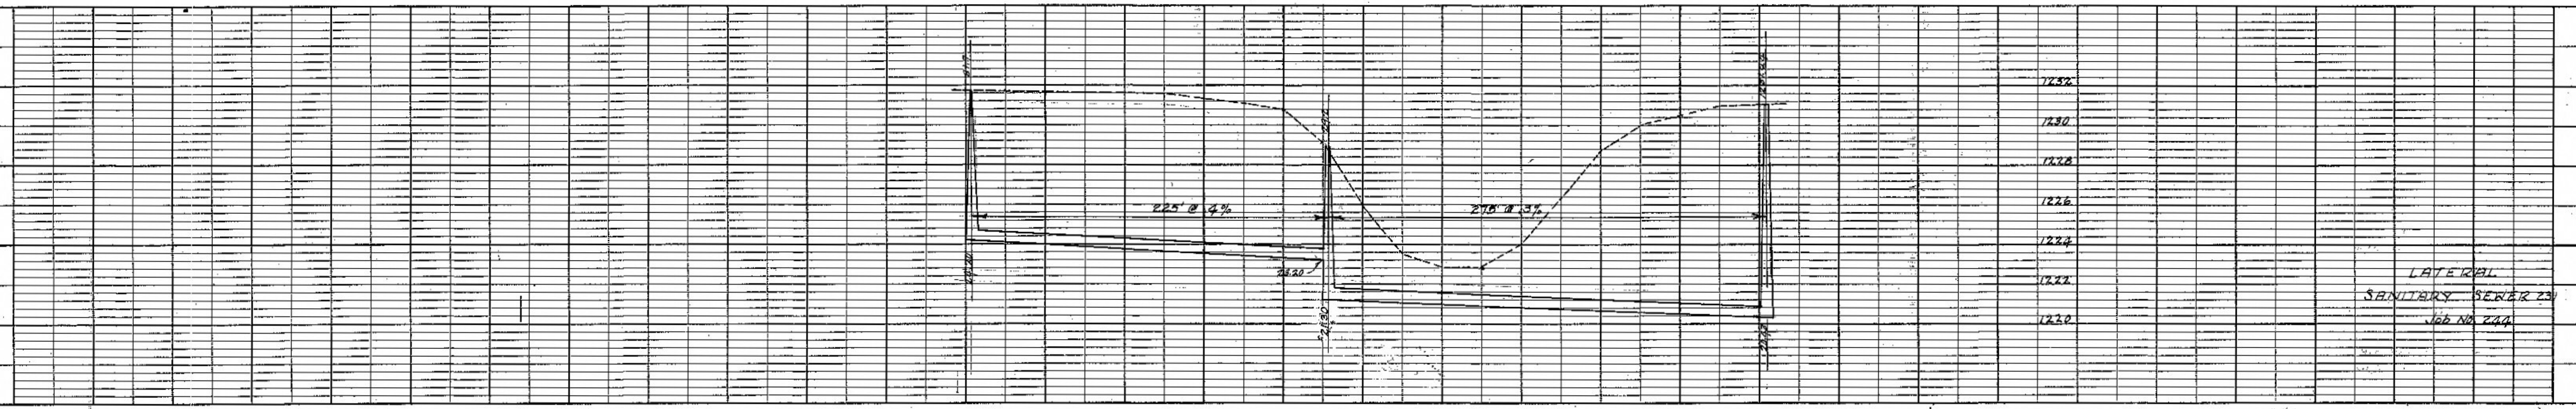

LATERAL
SANITARY SEWER 23
JOB NO. 224