


190

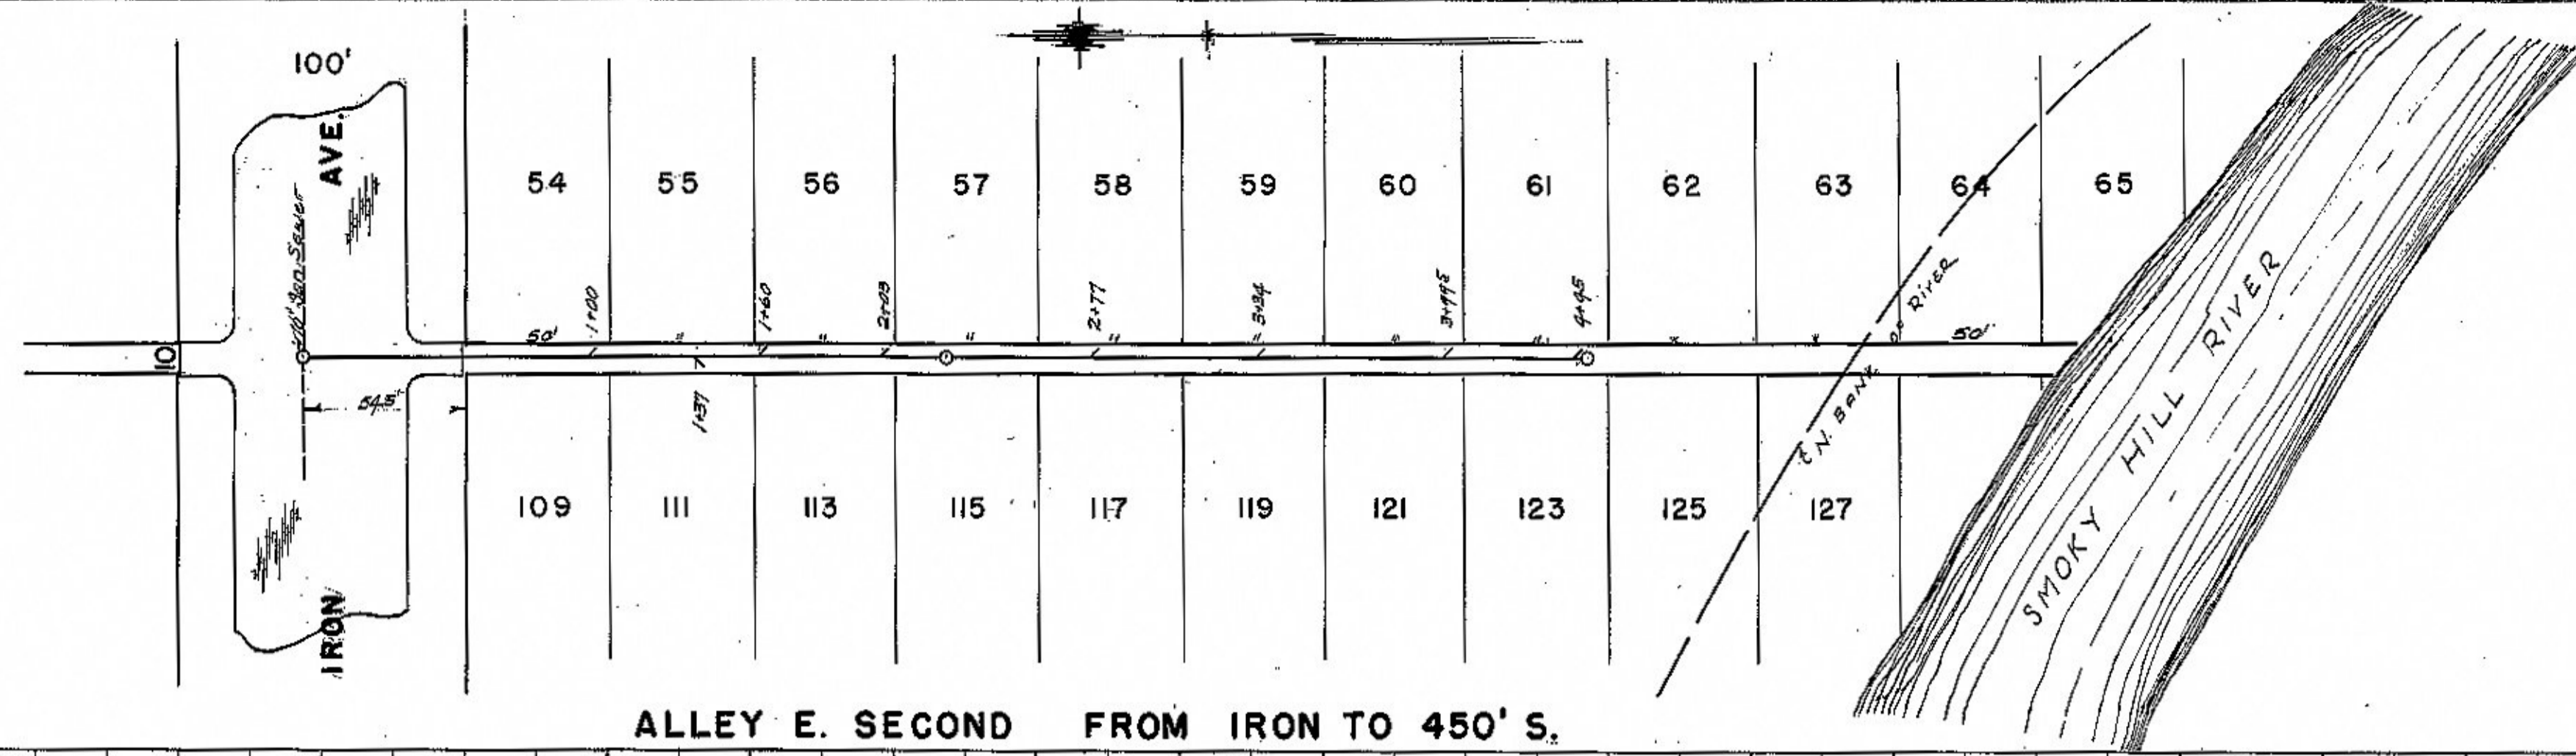

ALLEY E. SECOND FROM IRON TO 450' S.

PLAN

DATE _____ BY _____


NO. _____

NOTE BOOK _____


SURVEYED _____

ALGEMENT CHECKED _____

RT. OF WAY CHECKED _____

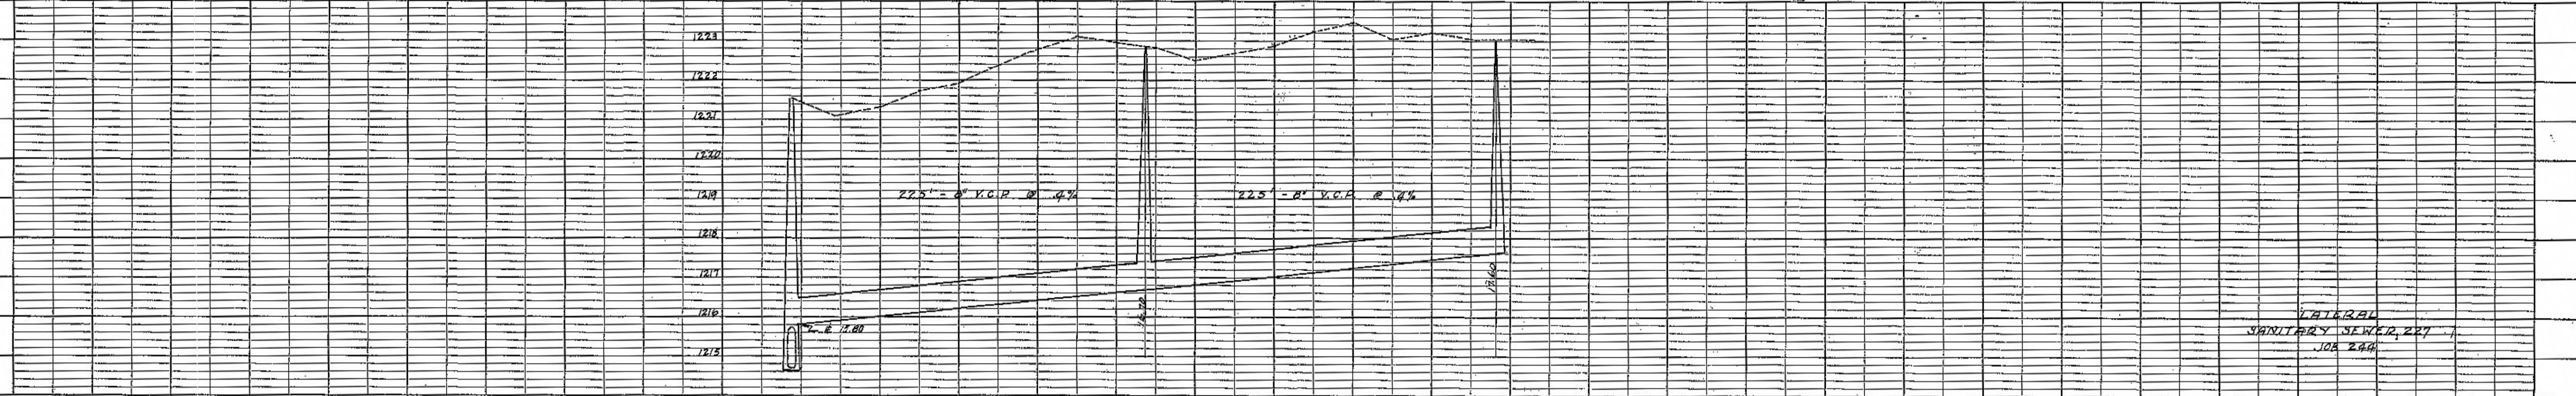

LATERAL
SANITARY SEWER, 227
JOB 246

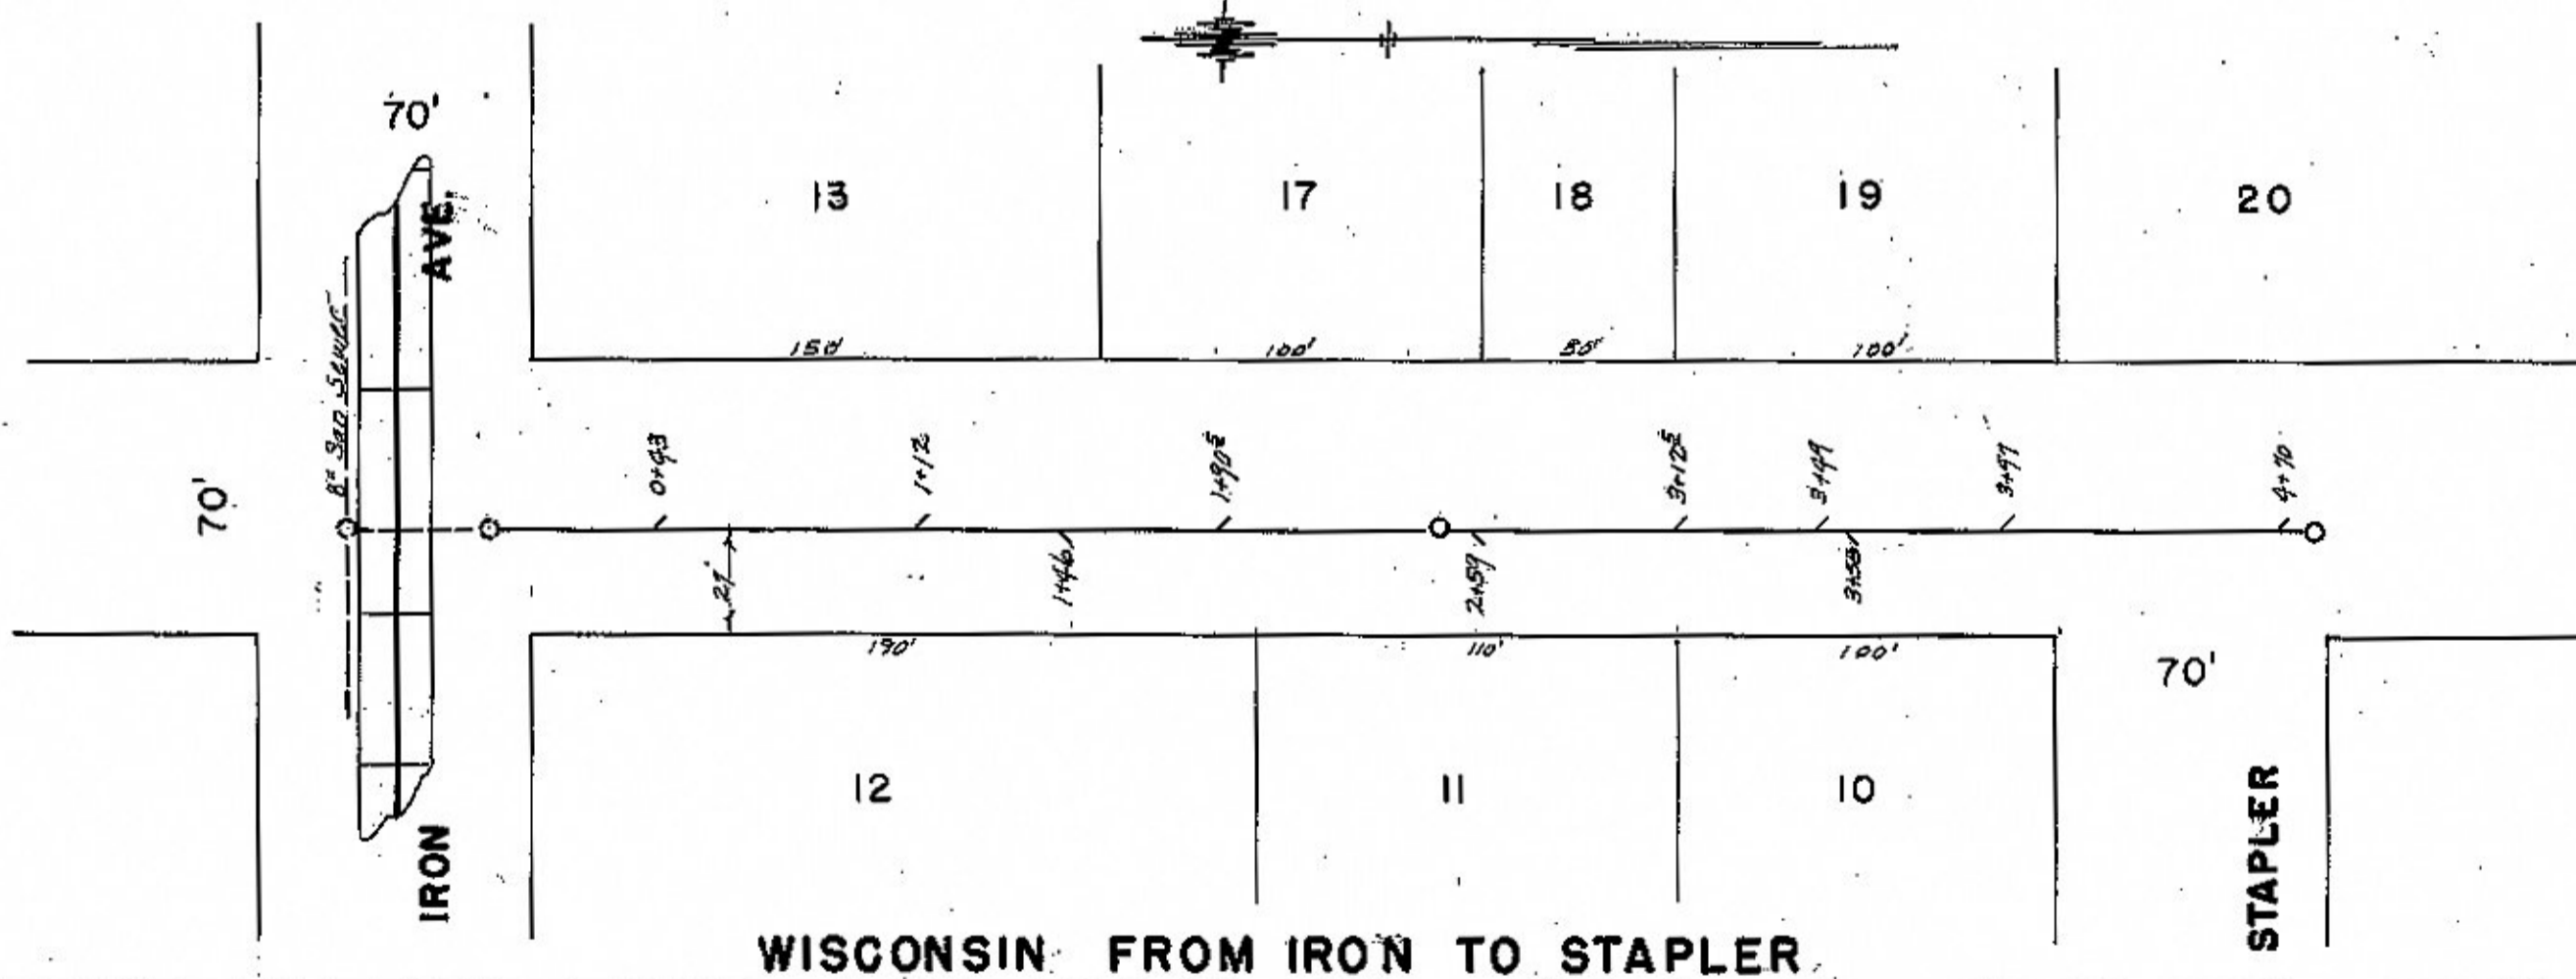

WISCONSIN FROM IRON TO STAPLER

PROFILE

DATE _____ BY _____

NO. _____


NOTE BOOK _____

SURVEYED _____

GRADES CHECKED _____

B.M. & NOTED _____

STRUCTURE NOTING CHECK _____

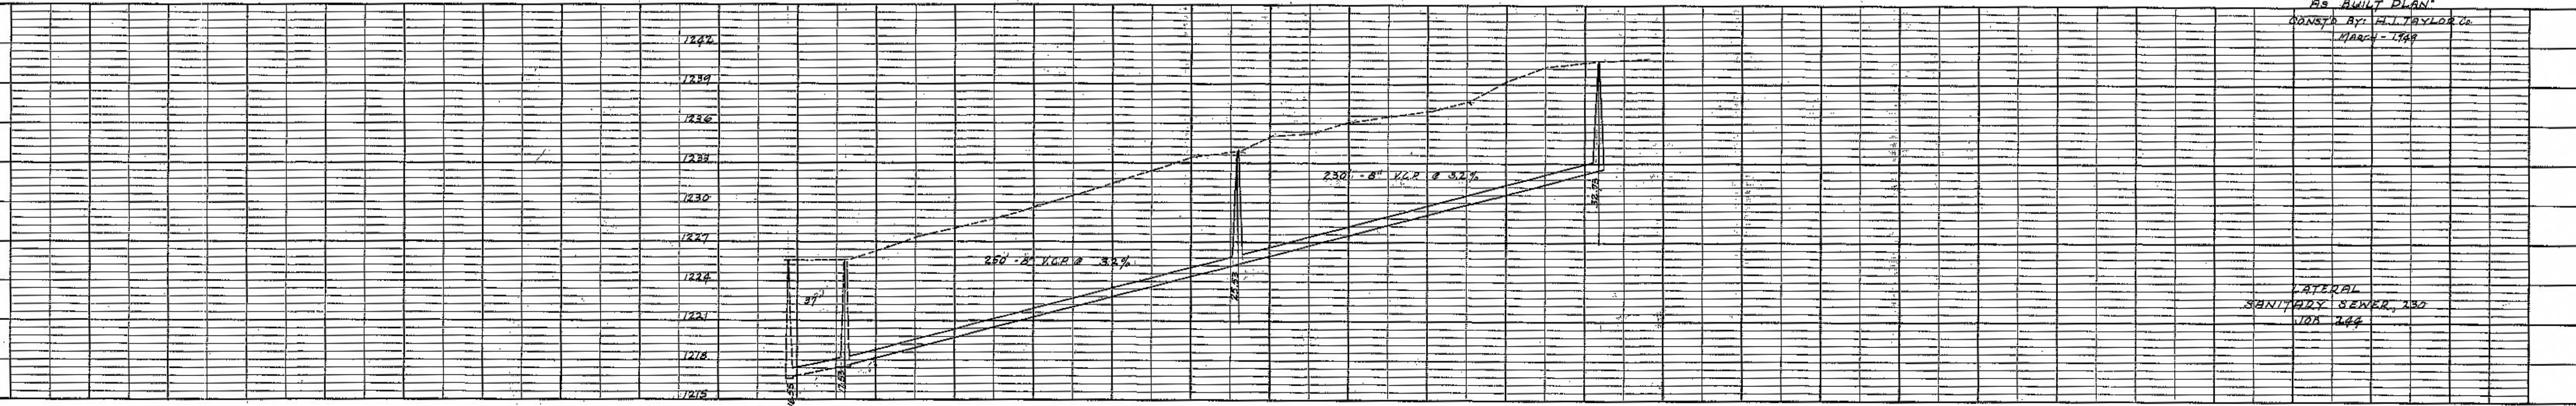

AS BUILT PLAN
DRAFT BY H.I. TAYLOR
MARCH - 1949

LATERAL
SANITARY SEWER, 230
JOB 246