

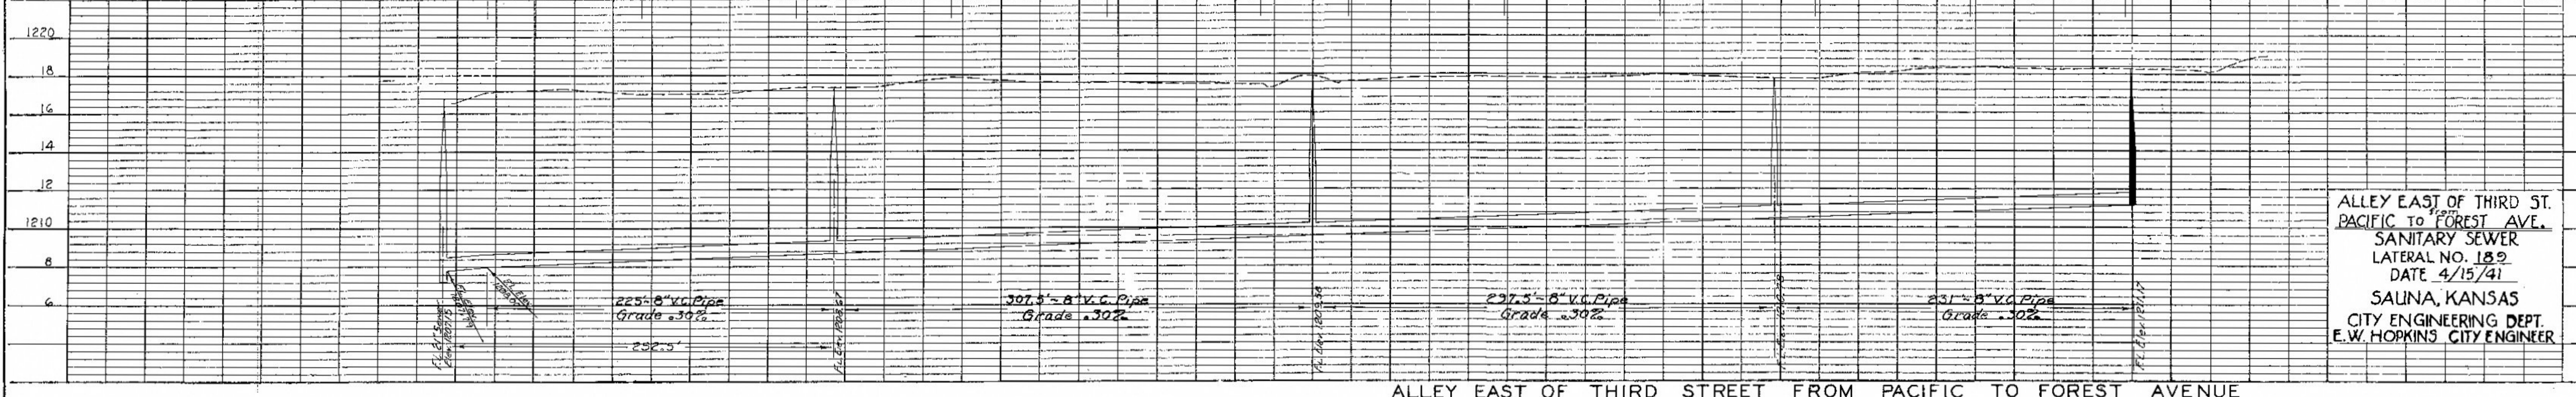
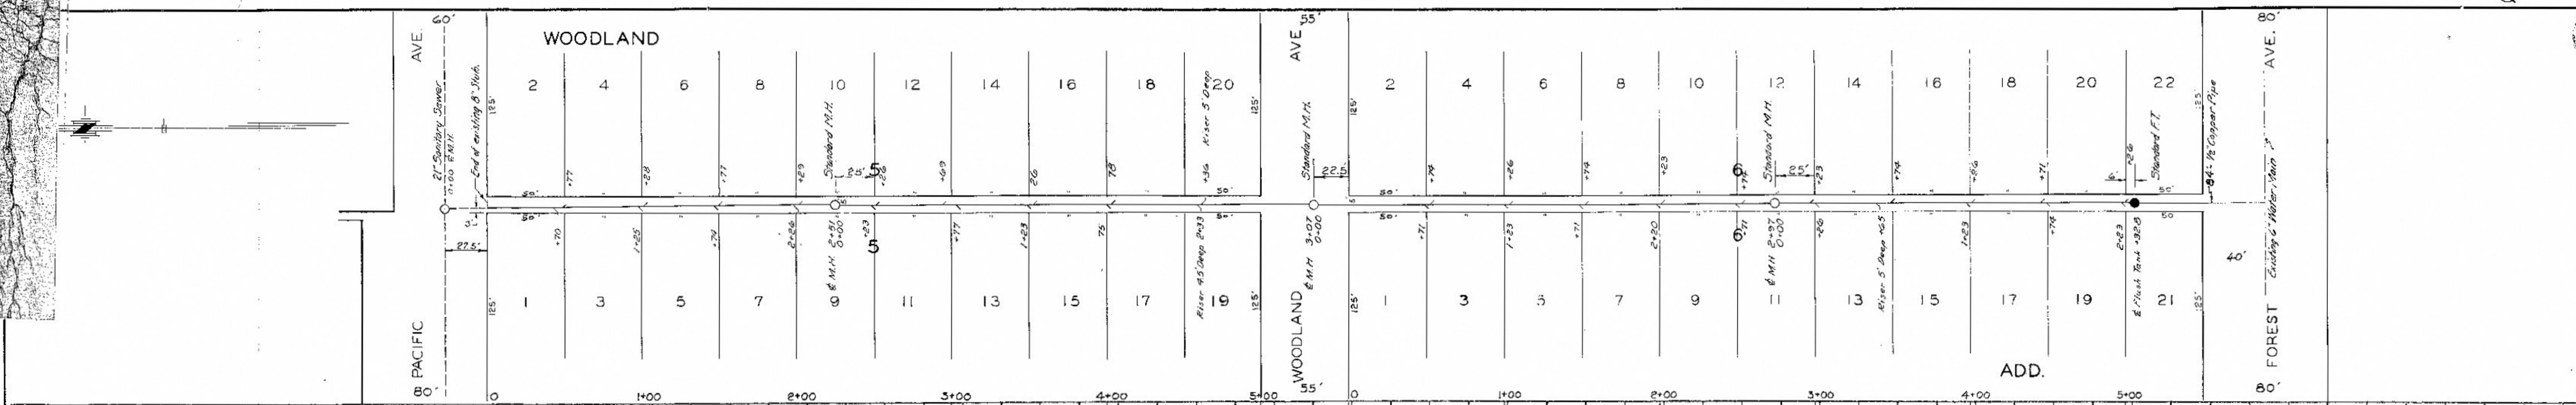


DATE	
BY	
SURVEYED	
PLOTTED	
NOTE BOOK	
NO.	

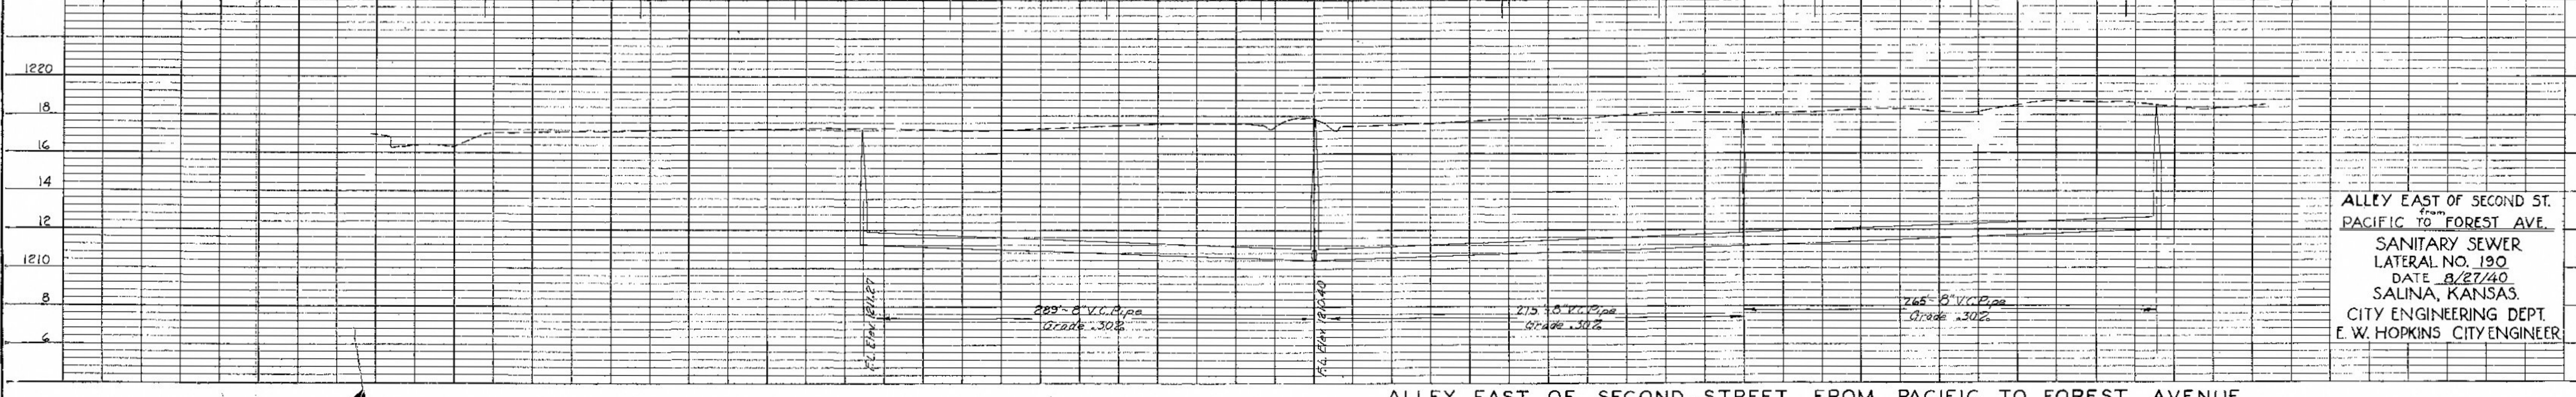

ALLEY EAST OF THIRD ST.
 FROM
 PACIFIC TO FOREST AVE.
 SANITARY SEWER
 LATERAL NO. 189
 DATE 4/15/41
 SALINA, KANSAS
 CITY ENGINEERING DEPT.
 E.W. HOPKINS CITY ENGINEER

DATE	
BY	
SURVEYED	
PLOTTED	
NOTE BOOK	
NO.	

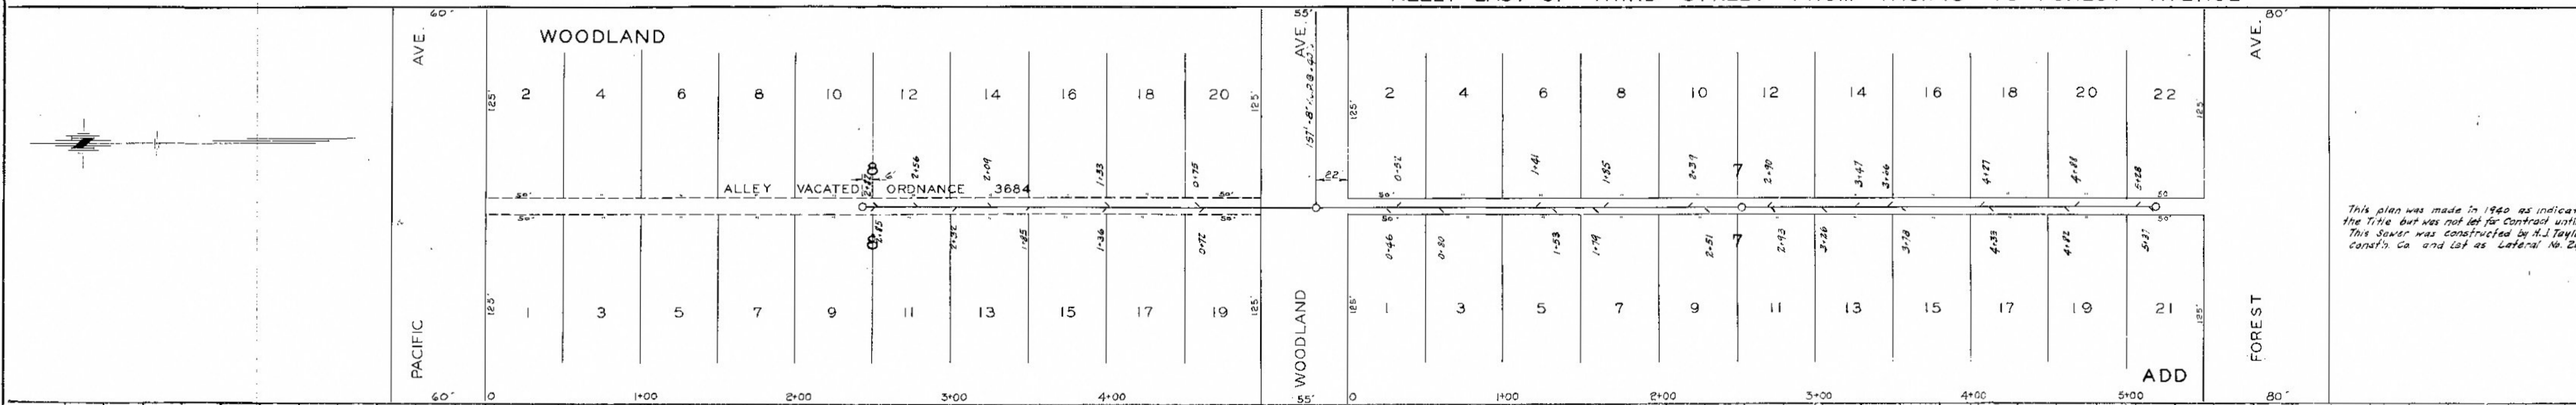

ALLEY EAST OF SECOND ST.
 FROM
 PACIFIC TO FOREST AVE.
 SANITARY SEWER
 LATERAL NO. 190
 DATE 8/27/40
 SALINA, KANSAS
 CITY ENGINEERING DEPT.
 E.W. HOPKINS CITY ENGINEER

This plan was made in 1940 as indicated by the title but was not left for contract until 1941. This sewer was constructed by H.J. Taylor const'n. Co. and let as Lateral No. 240