

195

PLAN

BY _____ DATE _____

SURVEYED _____

PLOTTED _____

ALIGNMENT CHECKED _____

RT. OF WAY CHECKED _____

NOTE BOOK NO. _____

PROFILE

BY _____ DATE _____

SURVEYED _____



PLOTTED _____

GRADES CHECKED _____



B. M. NOTED _____

STRUCTURE NOTATIONS CHECKED _____


NOTE BOOK NO. _____

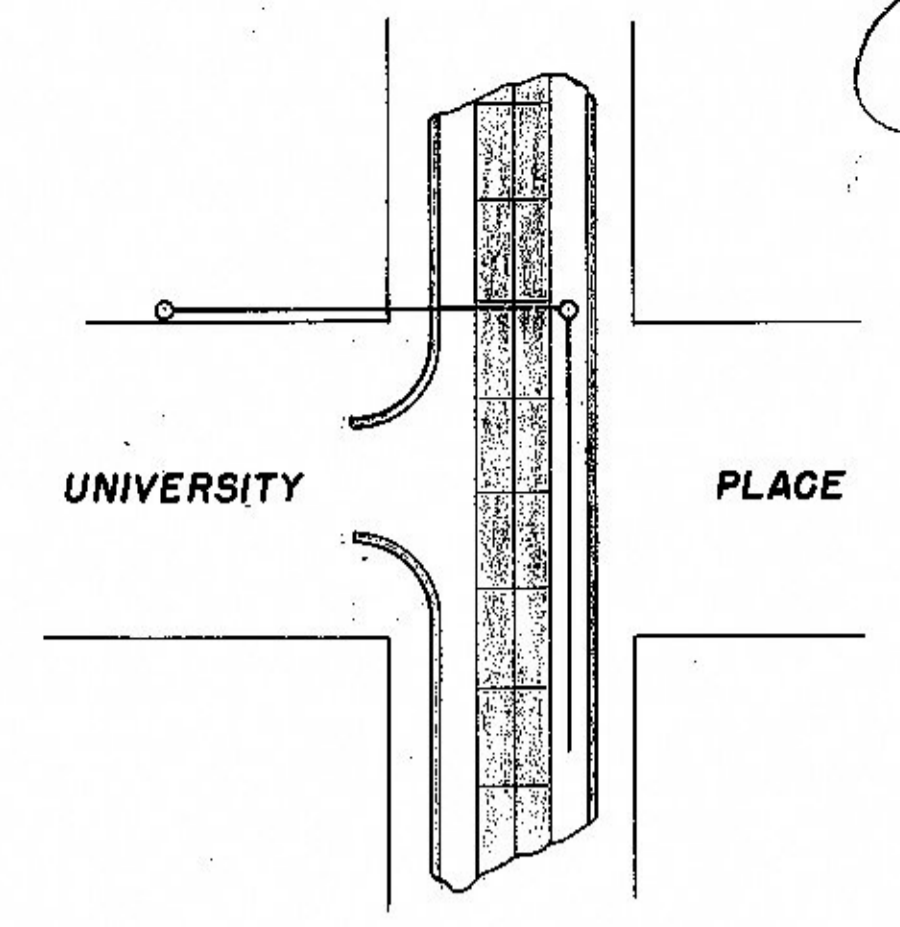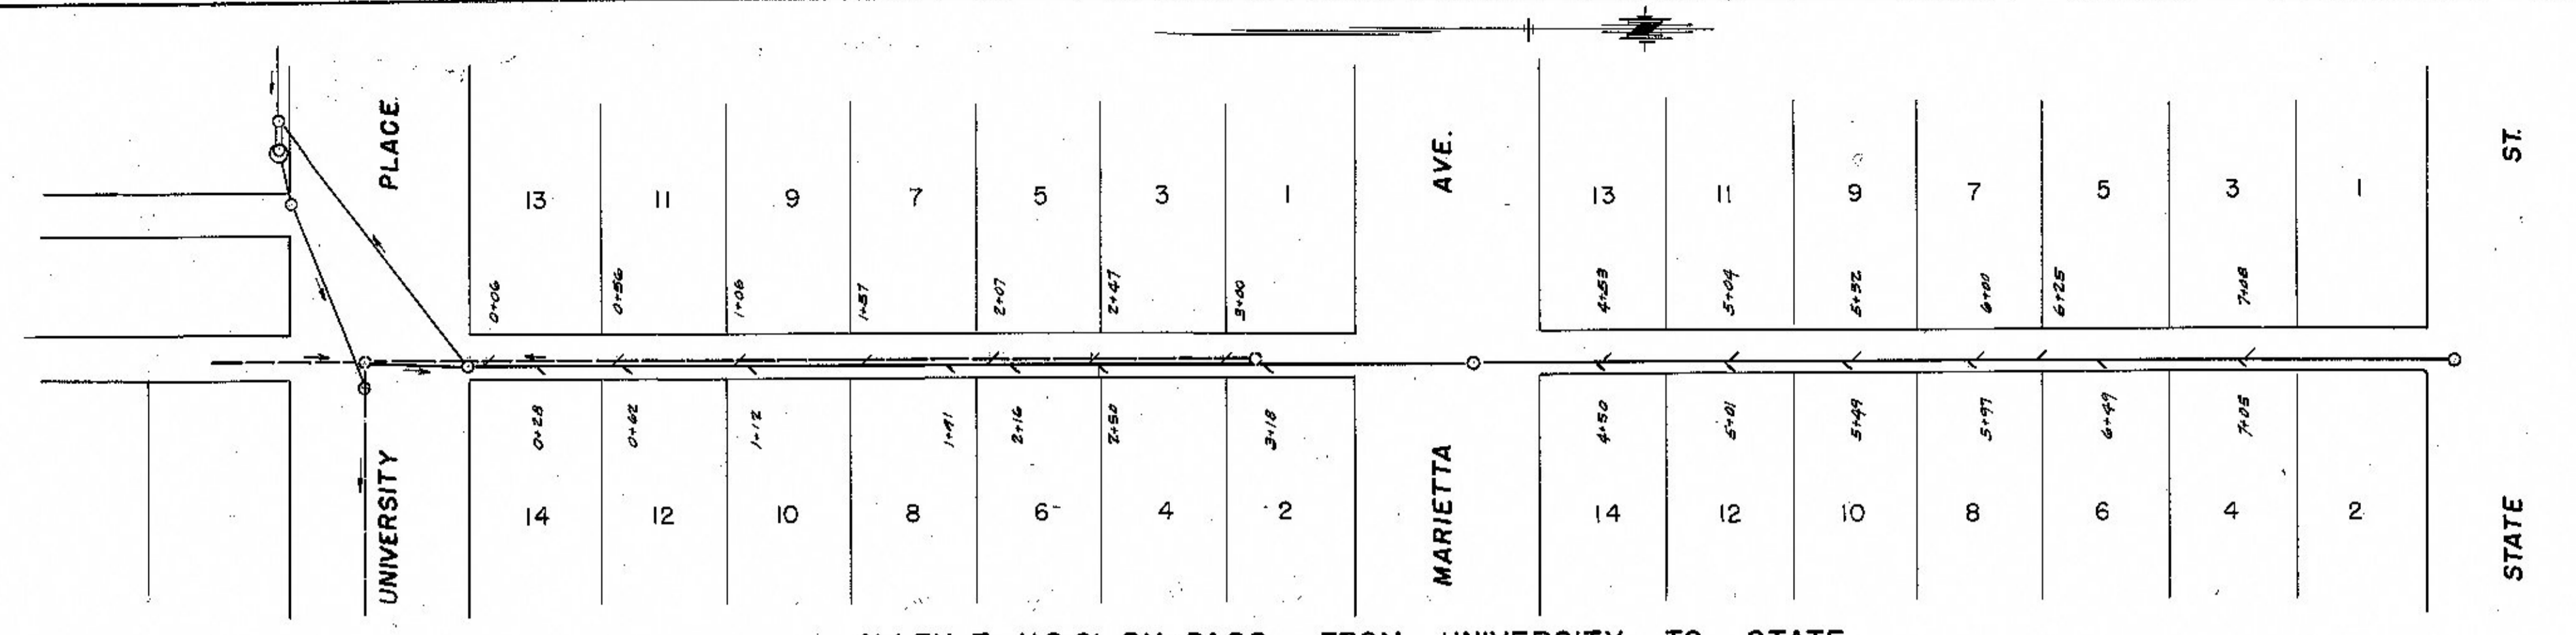

ALLEY E. U.S. 81 BY-PASS FROM UNIVERSITY TO STATE.

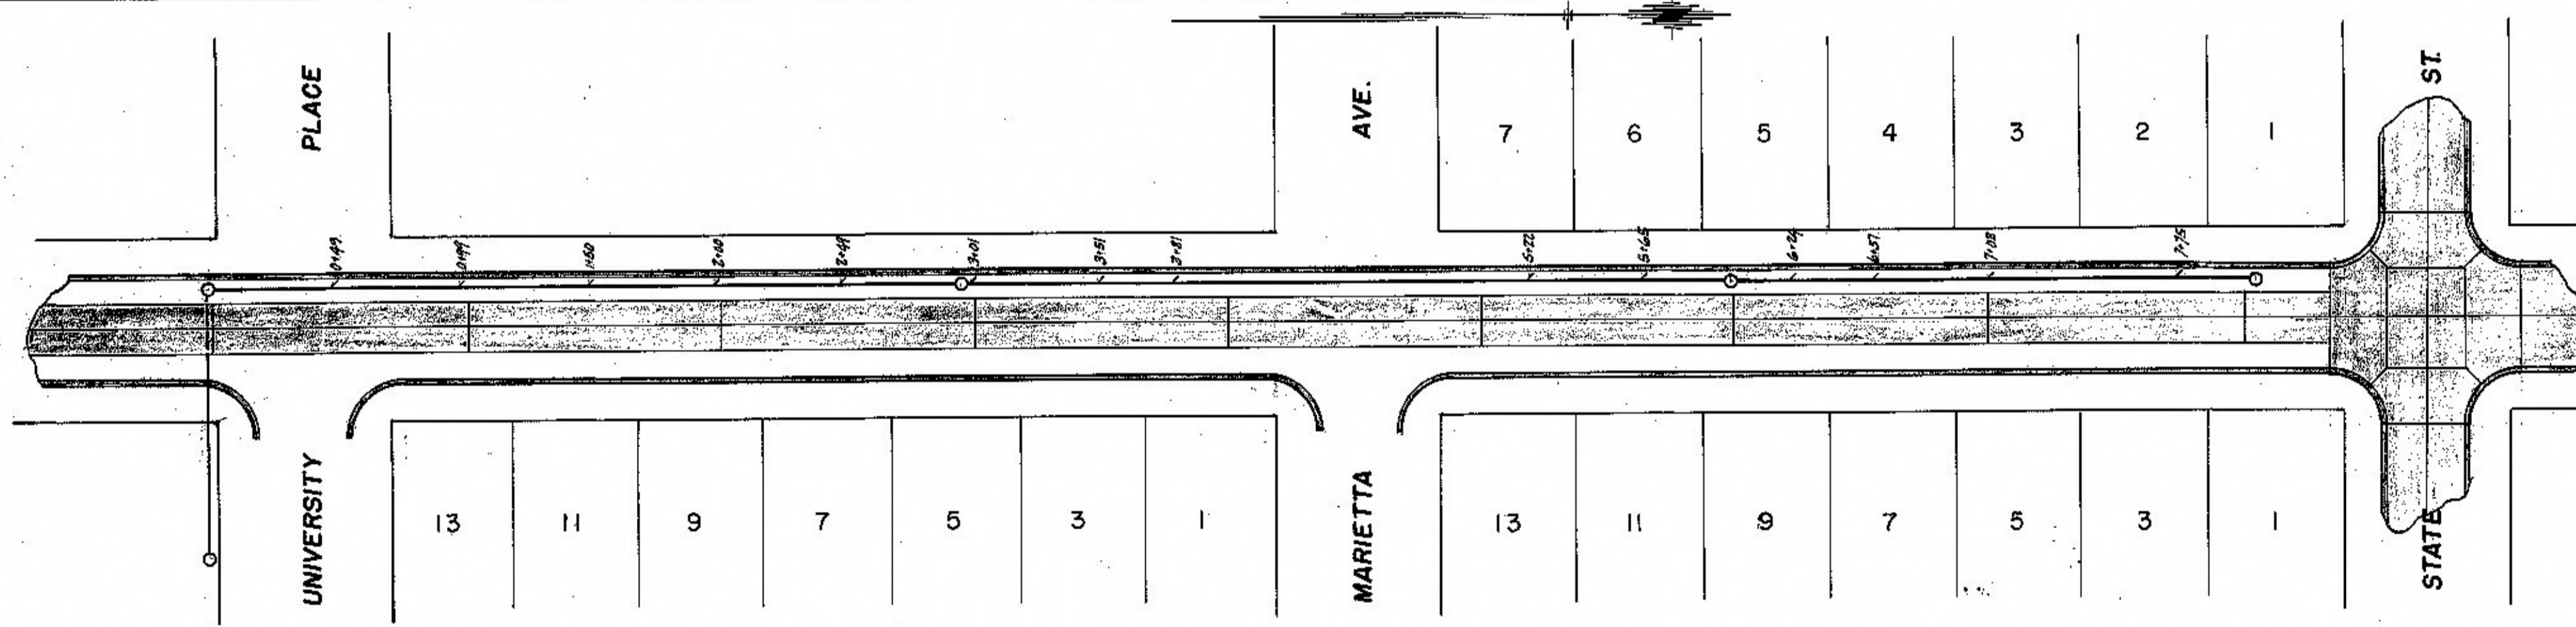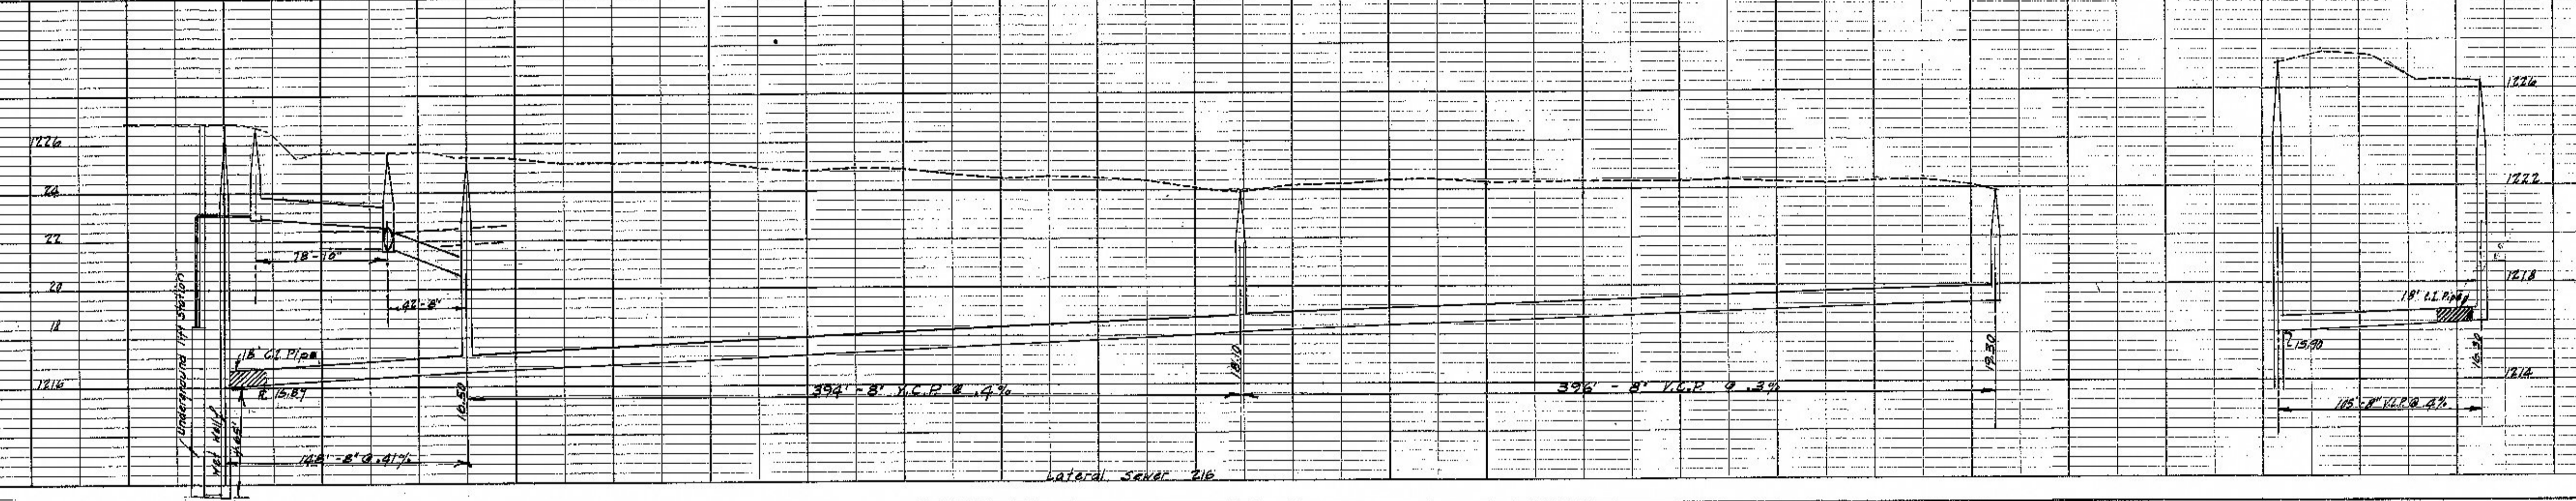

U.S. 81 BY-PASS FROM UNIVERSITY TO STATE

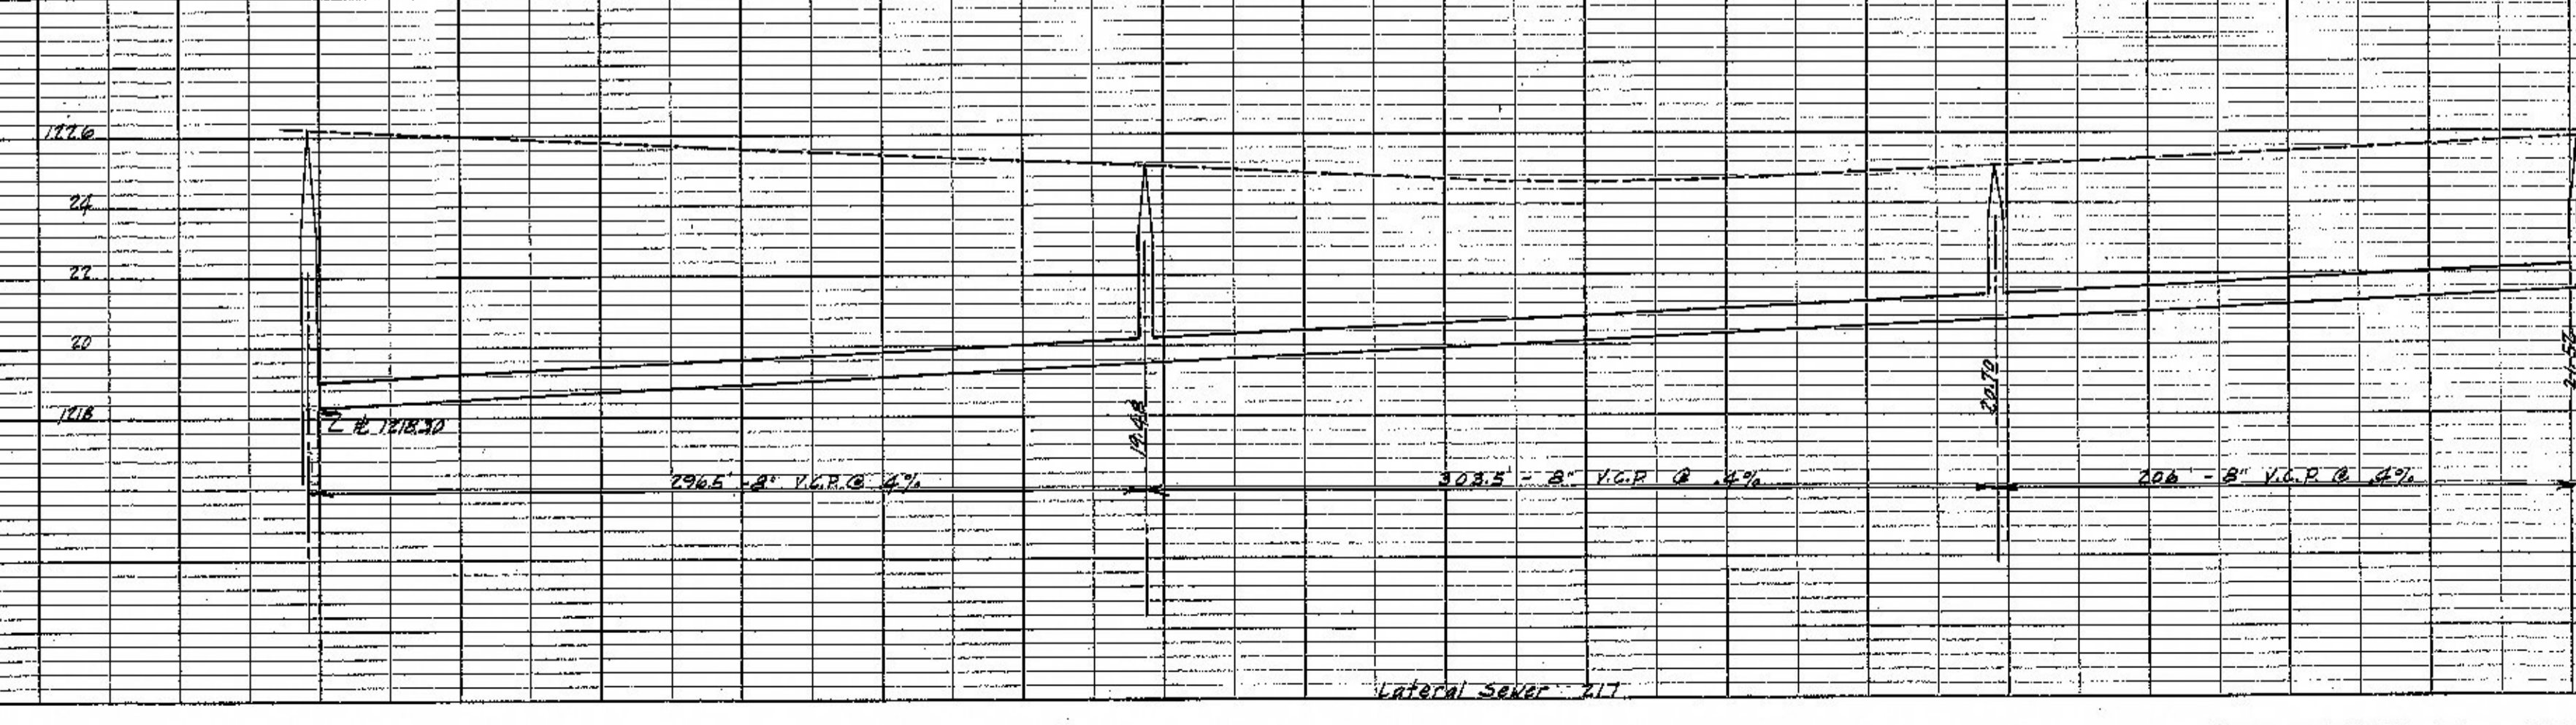

AS BUILT PLAN
 CONSTRUCTED BY
 TAYLOR CONSTR. CO.
 1949