
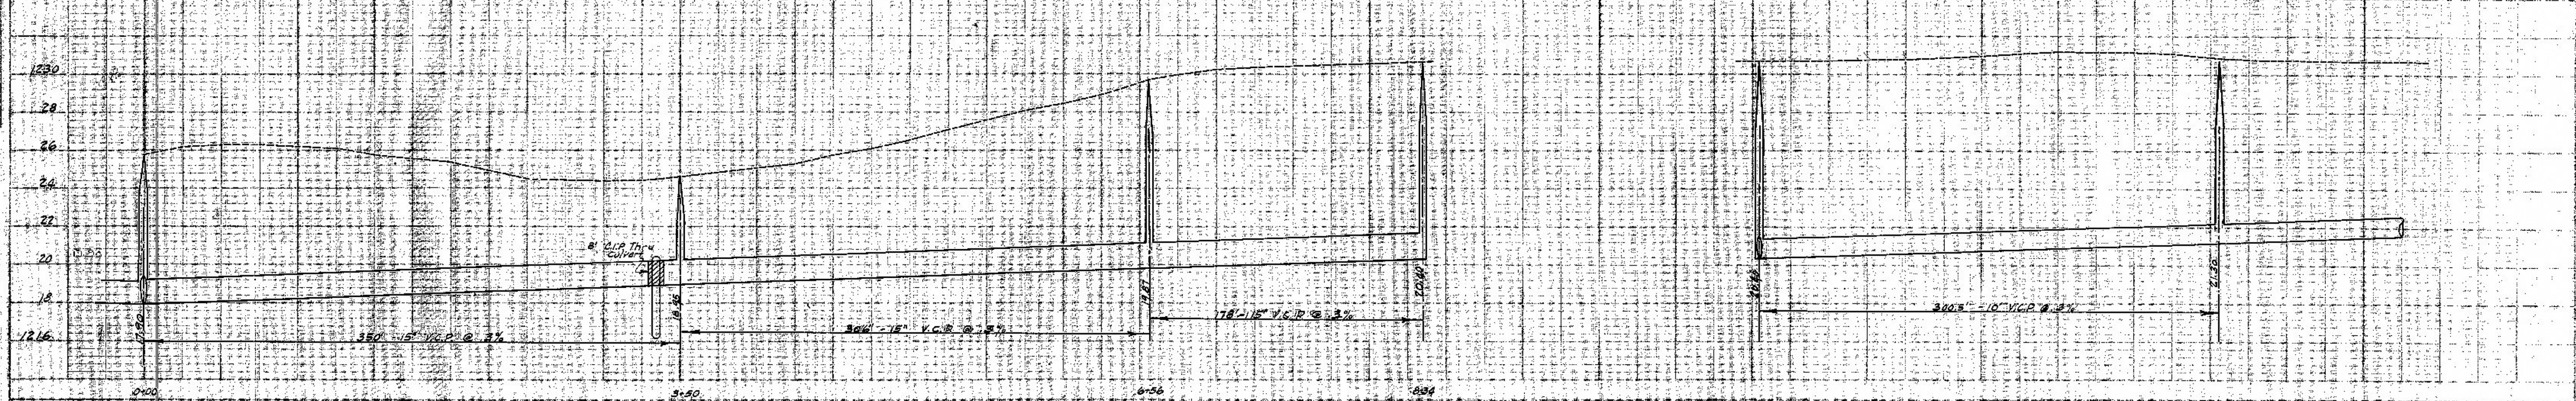
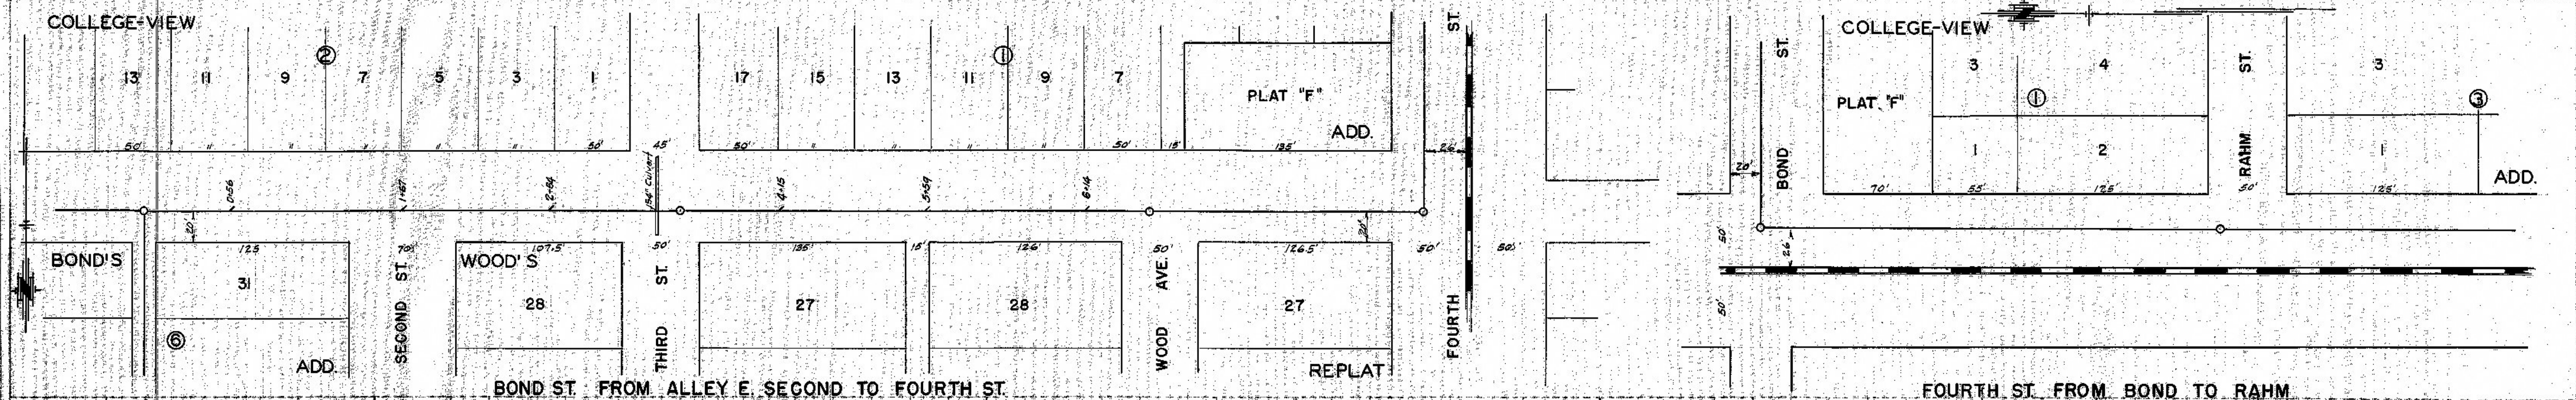
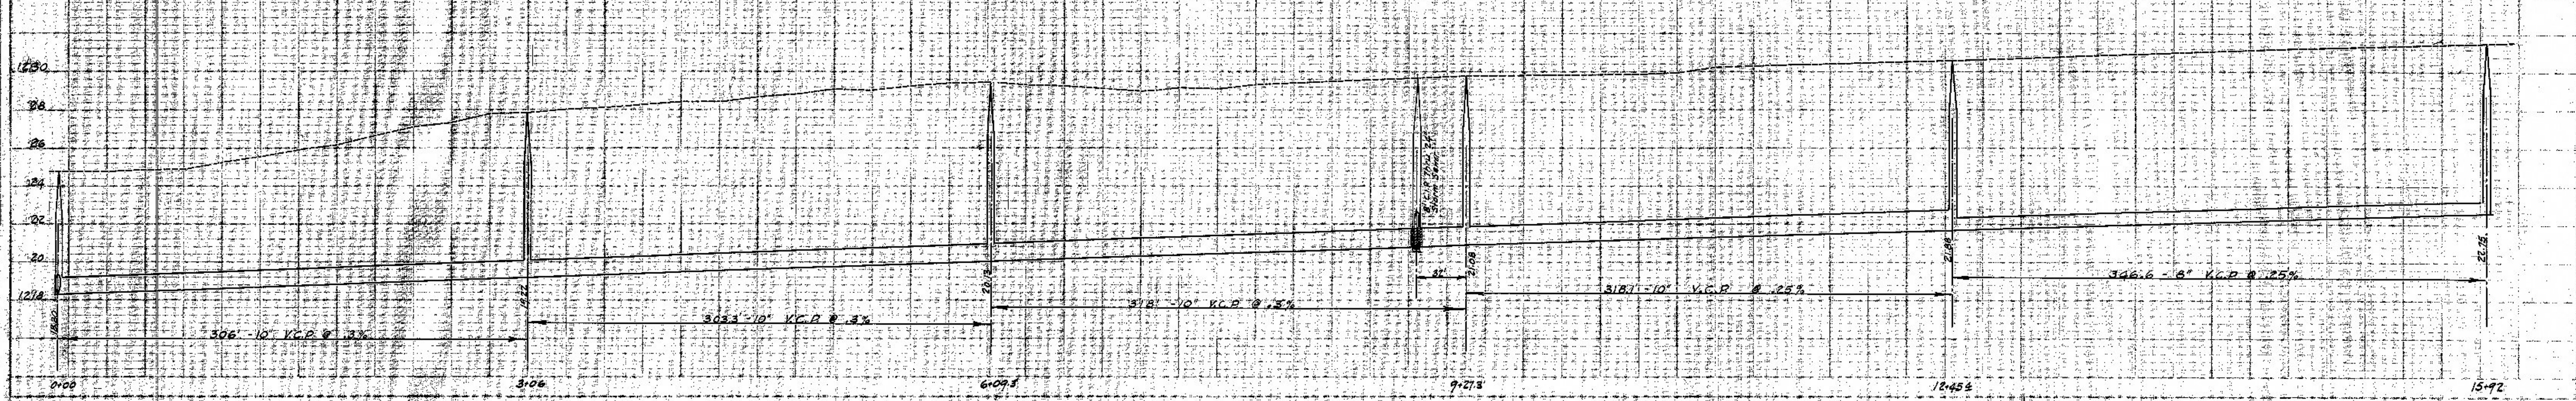


198

PLAN
DATE: 11/5/4
DRAWN BY: [illegible]
CHECKED BY: [illegible]
NO. 1154

PROFILE
DATE: 11/5/4
DRAWN BY: [illegible]
CHECKED BY: [illegible]
NO. 1154

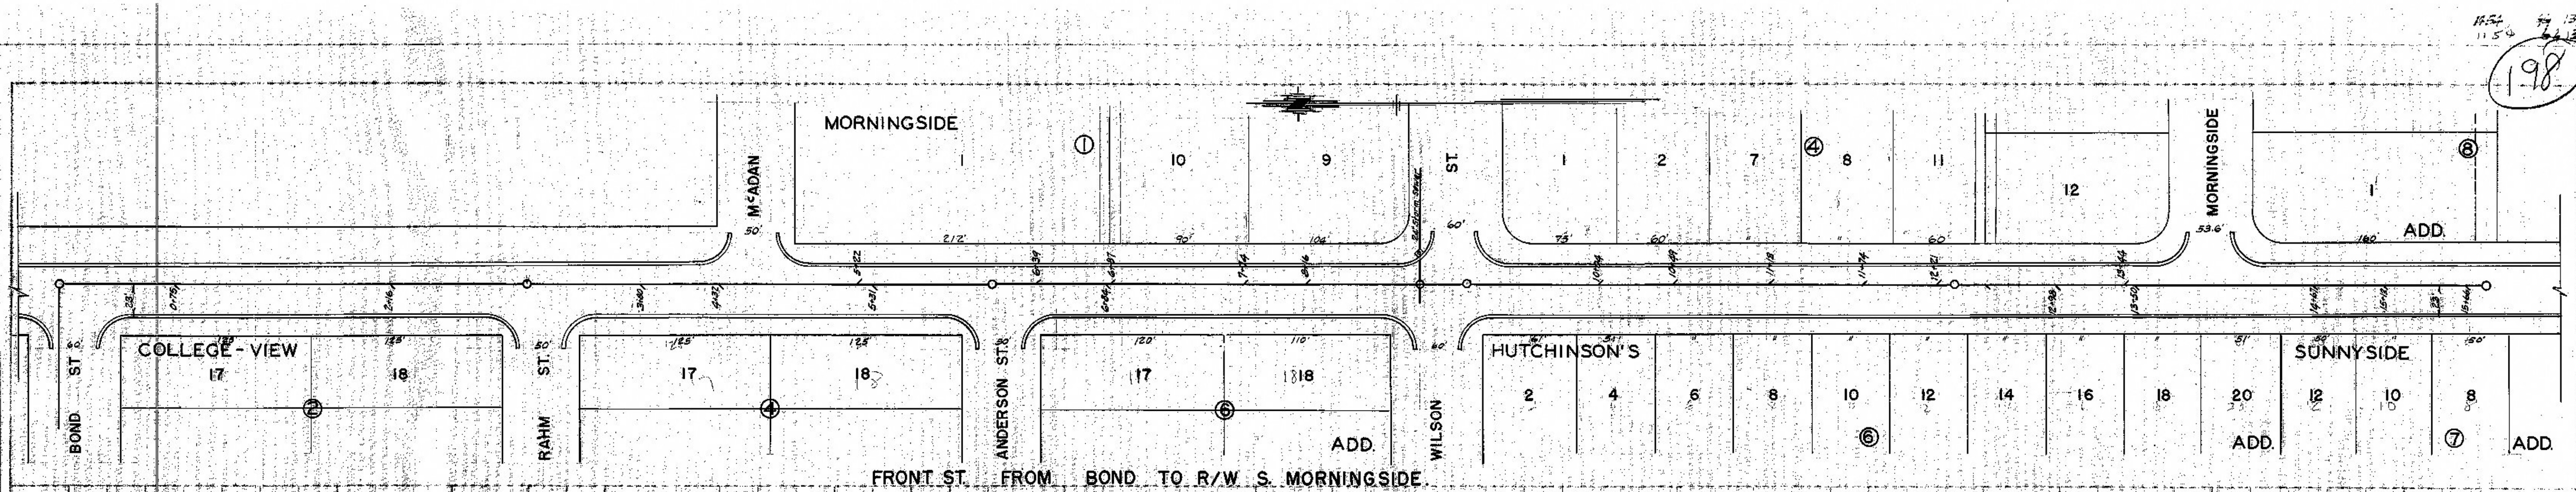

FOURTH ST. FROM BOND TO RAHM