


199

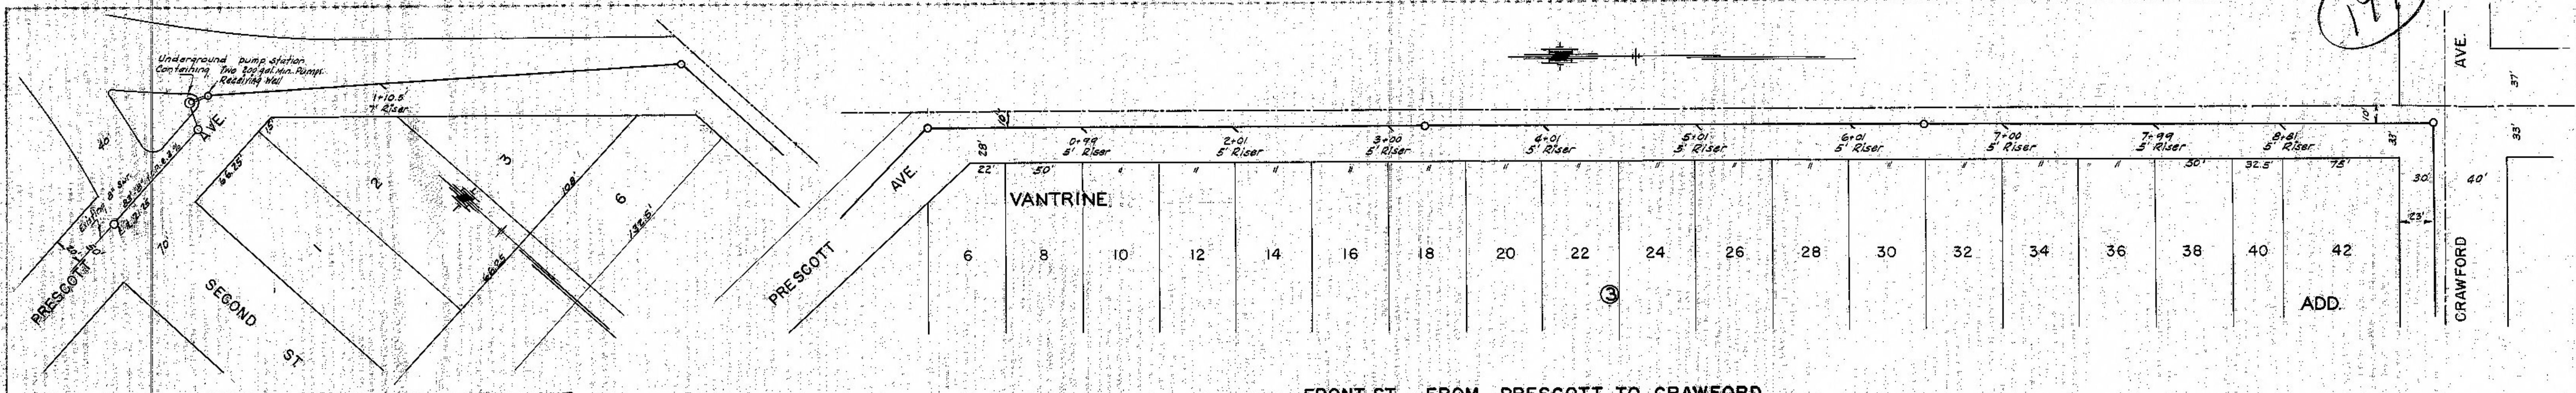

PRESGOTT FROM SECOND TO FRONT


FRONT ST FROM PRESGOTT TO CRAWFORD



CRAWFORD FROM FRONT TO ALLEY E. SECOND

ALLEY E. SECOND FROM CRAWFORD TO BOND

BOND FROM ALLEY E. SECOND TO FRONT

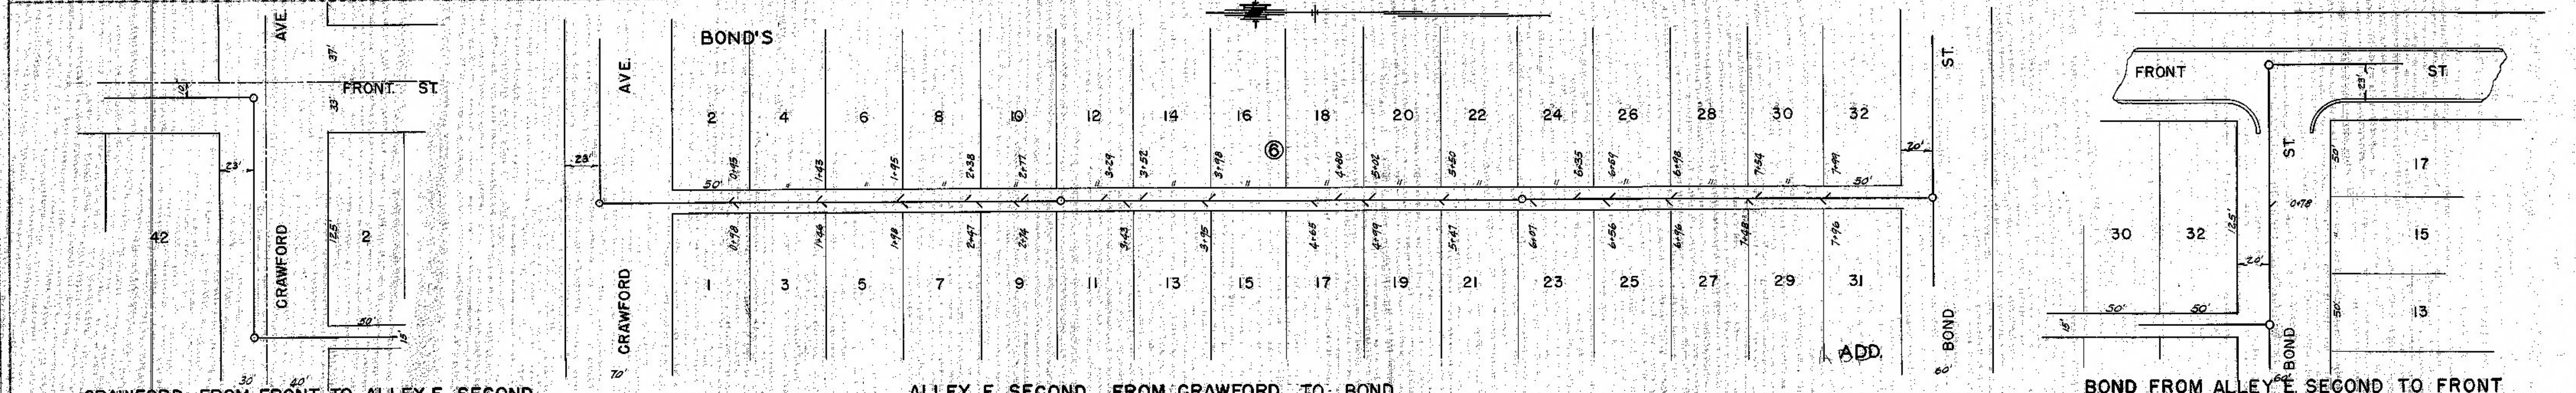

PLAN

BY: []

DATE: []

REVISIONS:

1. []

2. []

3. []

NOTE: WORK ALTERNATELY CHECKED BY []

NO. []

PROFILE

BY: []

DATE: []

REVISIONS:

1. []

2. []

3. []

NOTE: WORK ALTERNATELY CHECKED BY []

NO. []