
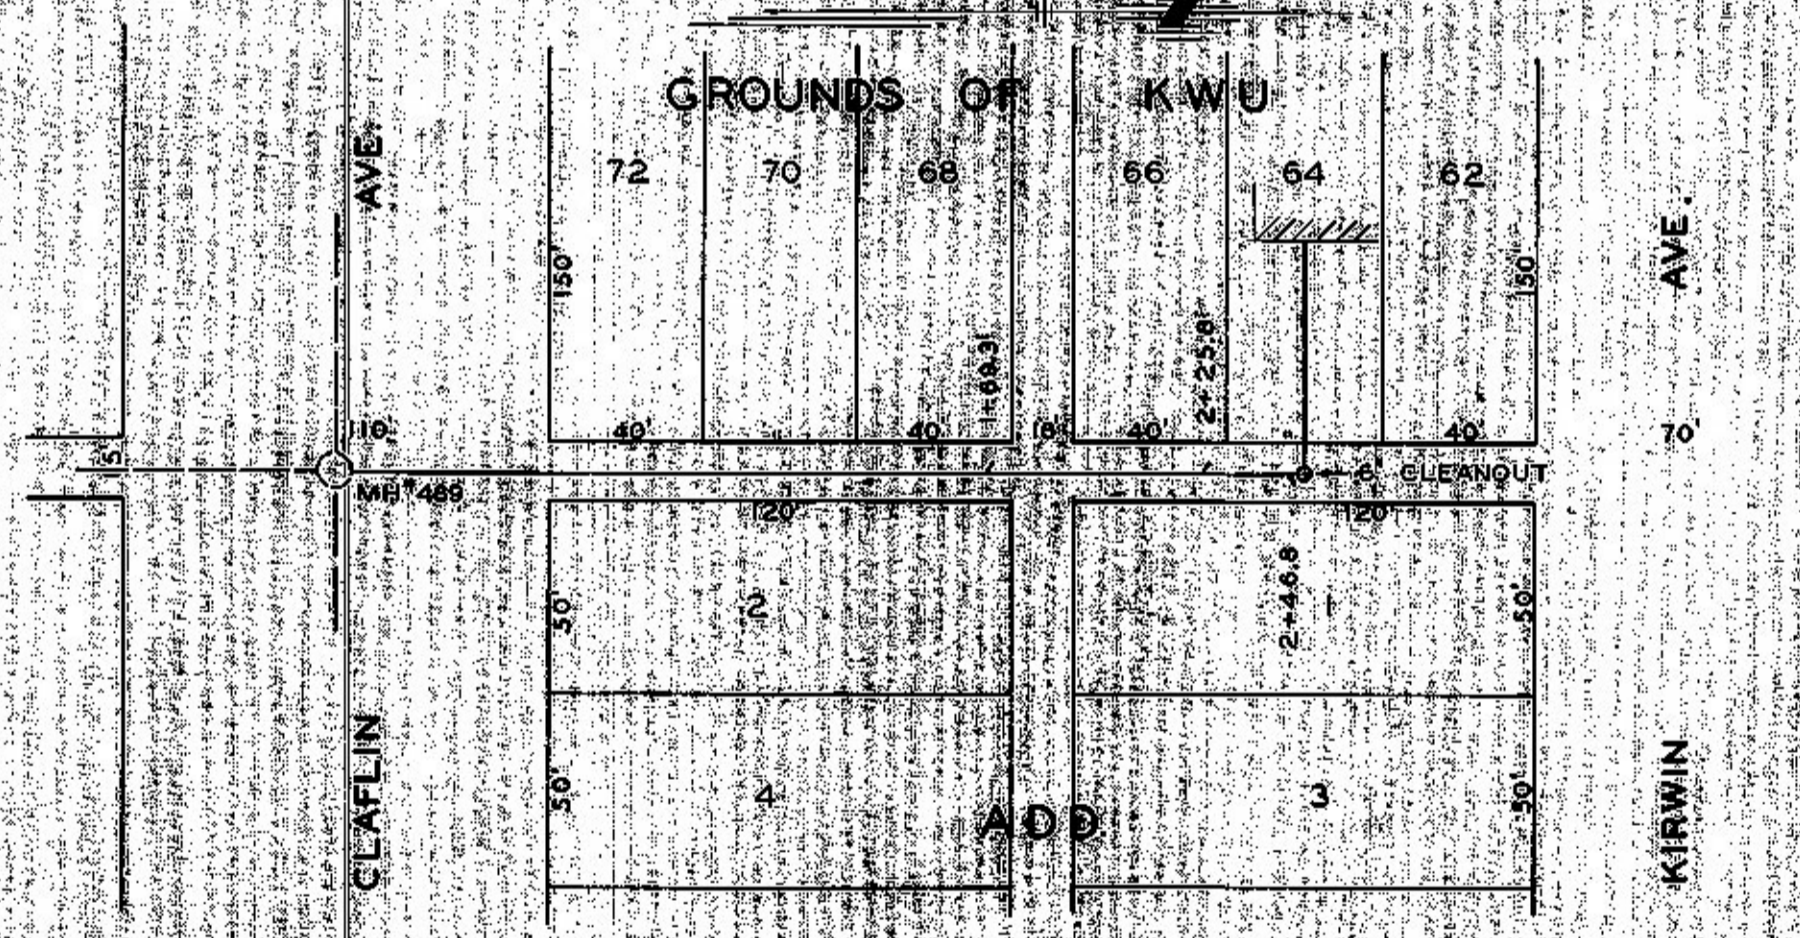



PRESCOTT ST - ALLEY E. OF 4TH TO 132.5 E. OF 3RD ST. LATERAL 198

BM 413 ELEV. 1228.58 M IN MFG. EH NE COR. 3RD ST & PRESCOTT


132.5 E OF 3RD ST. FROM PRESCOTT AVE TO CRAWFORD AVE. LATERAL 198

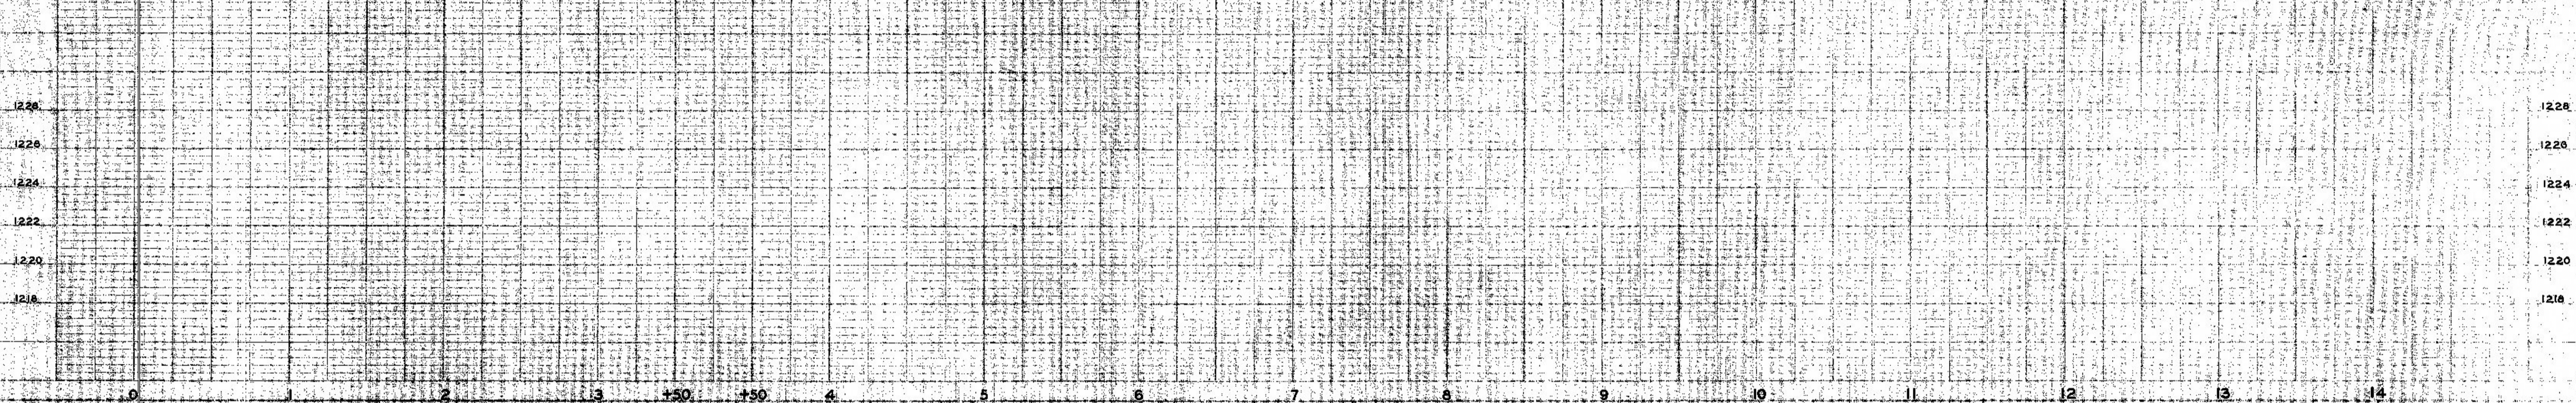

ALLEY E. OF 9TH FROM CLAFLIN TO KIRWIN. LAT 200

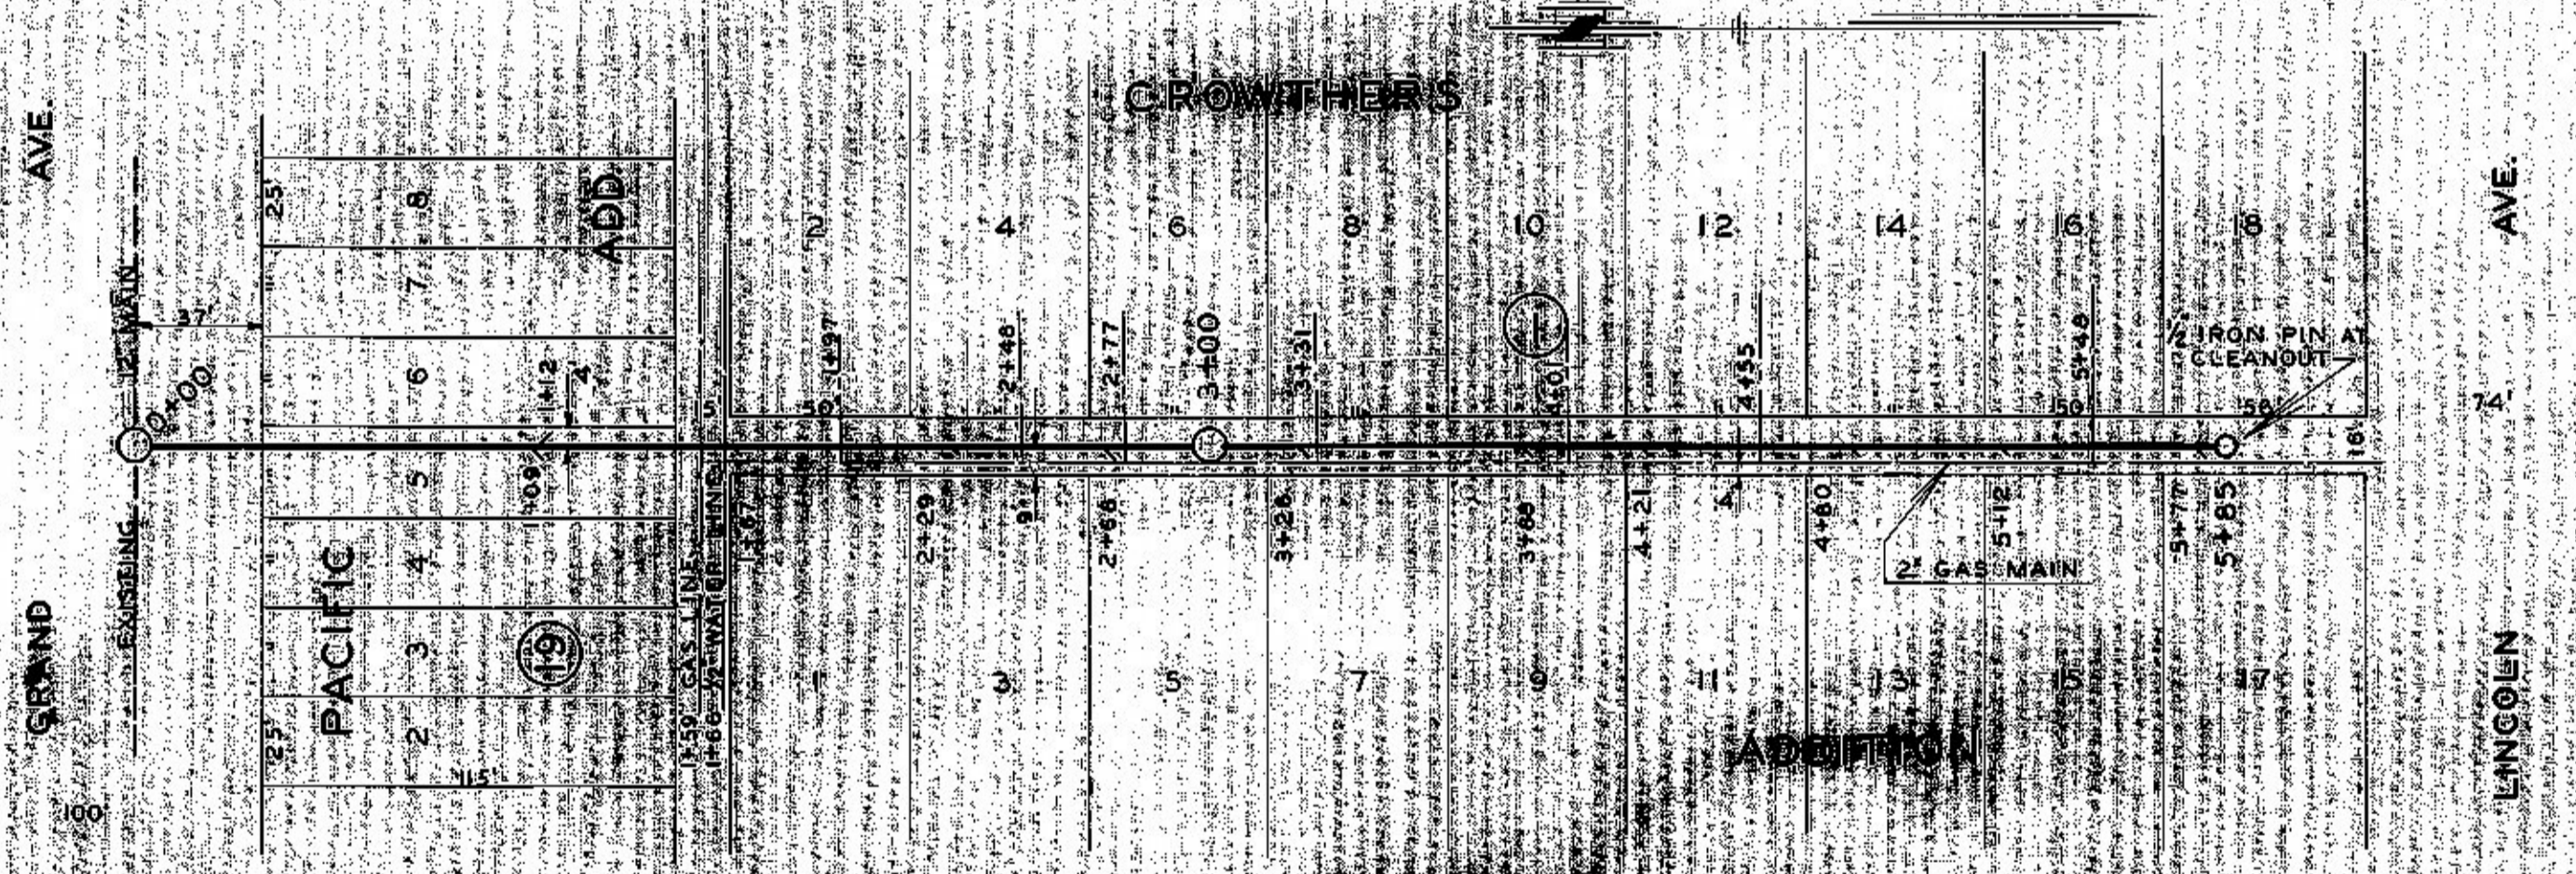

ALLEY E. OF 11TH FROM GRAND TO LINCOLN. LATERAL 203

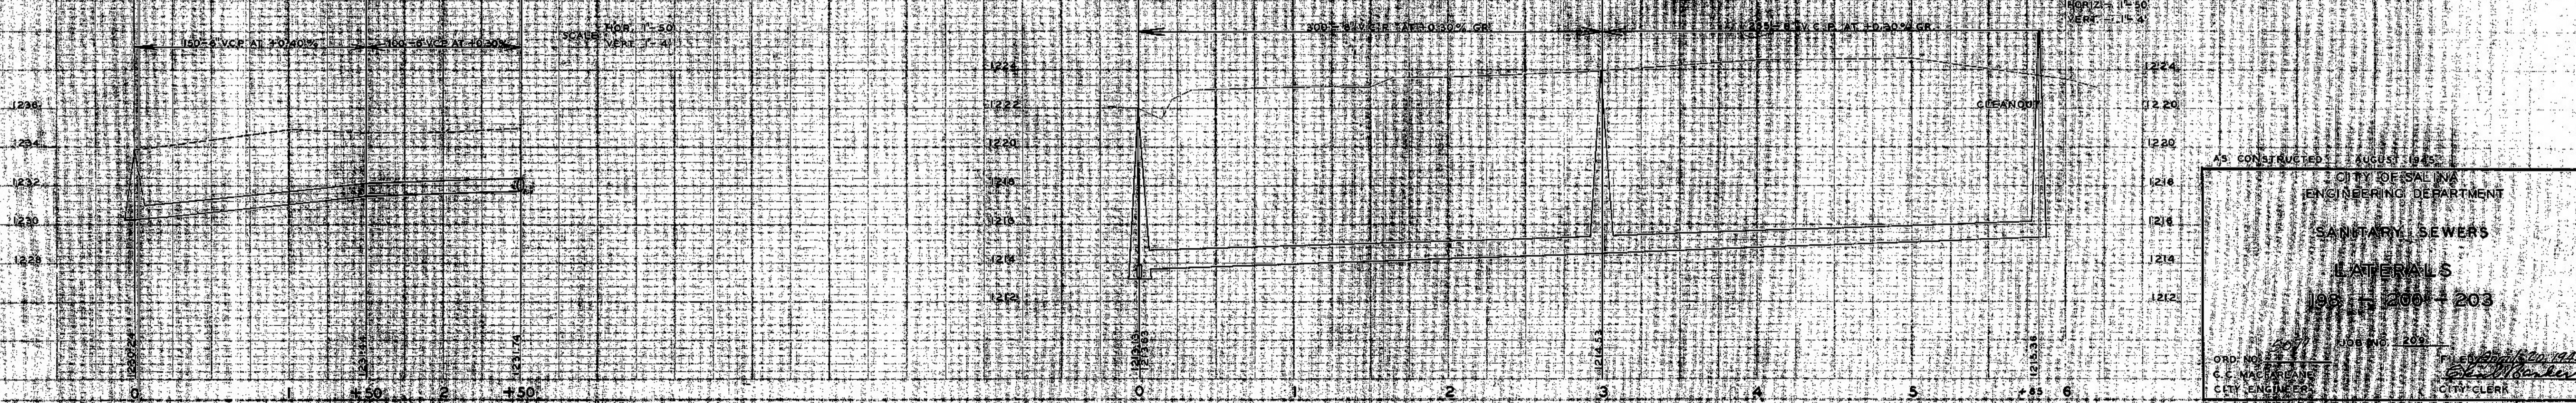

AS CONSTRUCTED AUGUST 1945
 CITY OF SALT LAKE
 ENGINEERING DEPARTMENT
 SANITARY SEWERS
 LATERALS
 198 - 200 - 203
 ORD. NO. 203
 C. C. MACFARLANE
 CITY ENGINEER
 J. W. MCKAY
 CITY CLERK