
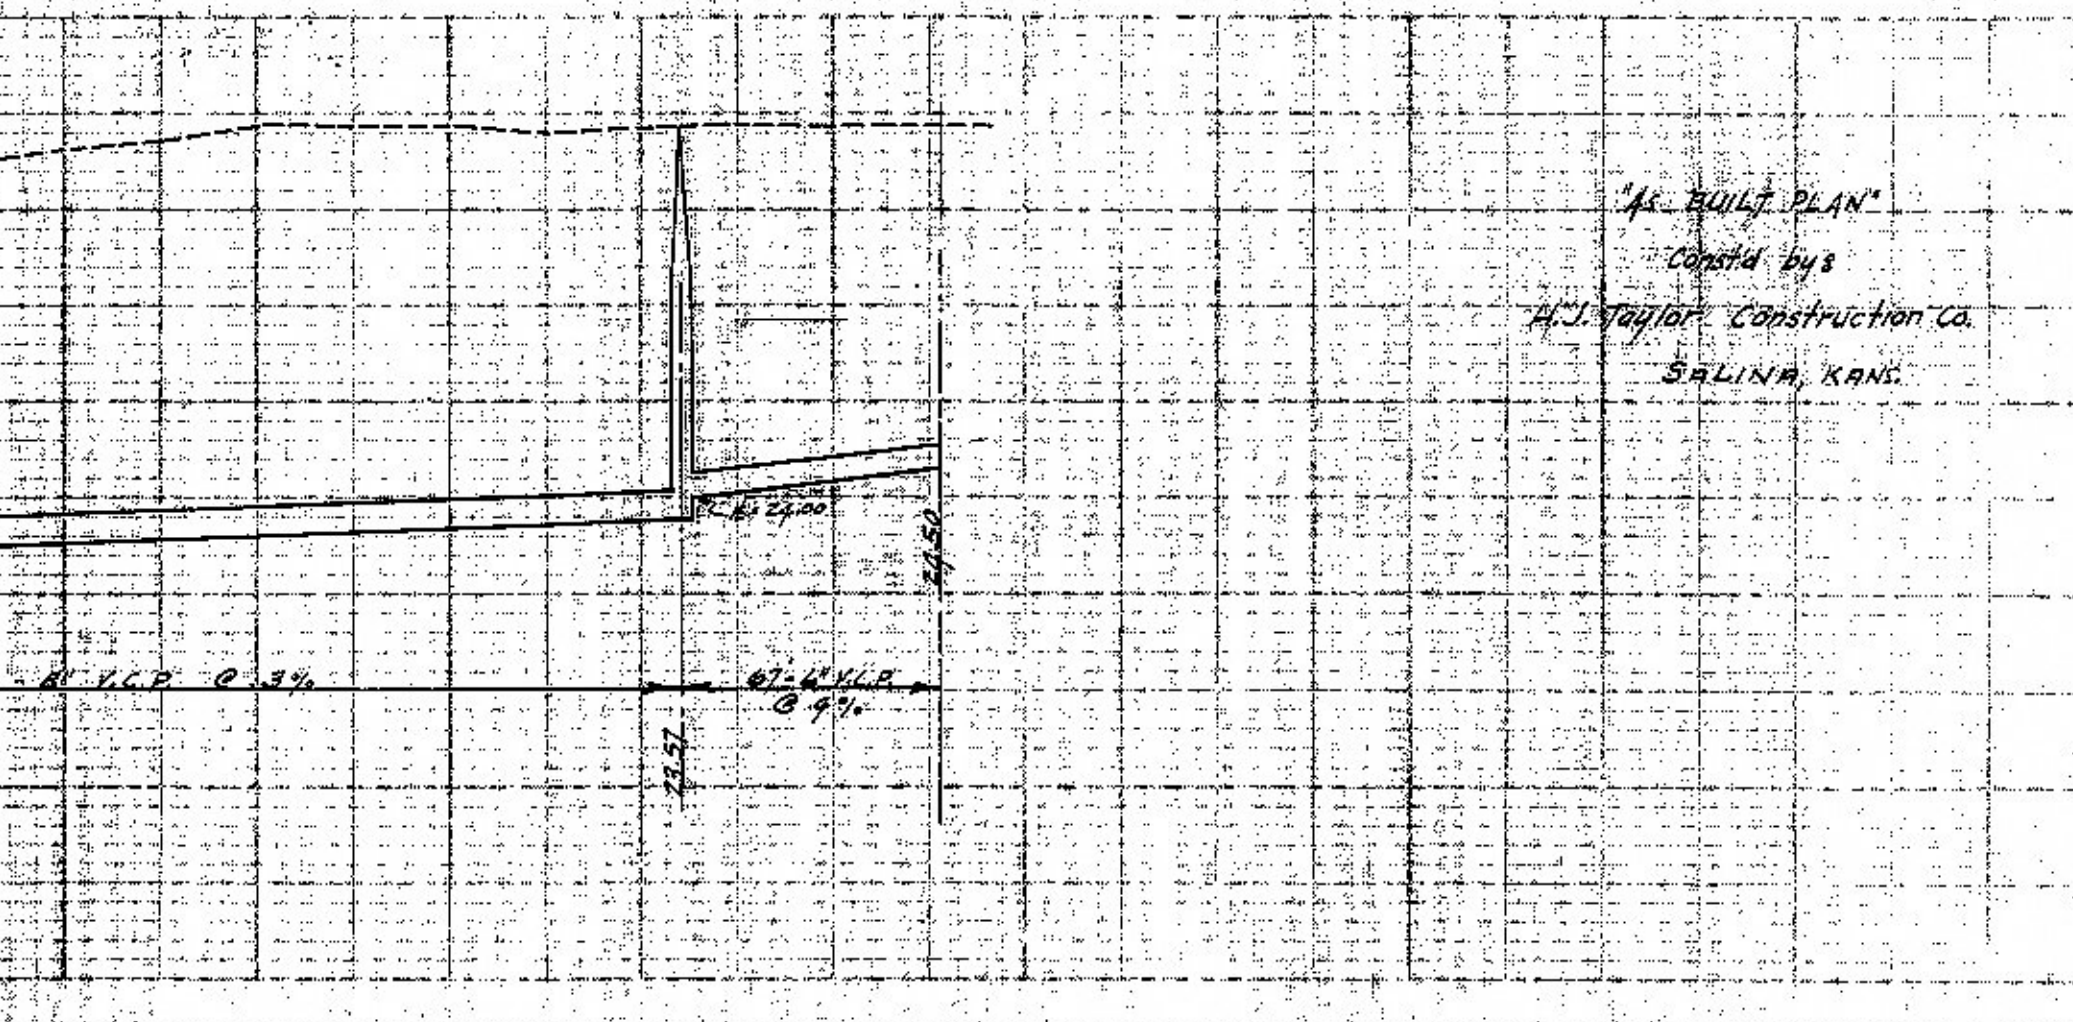
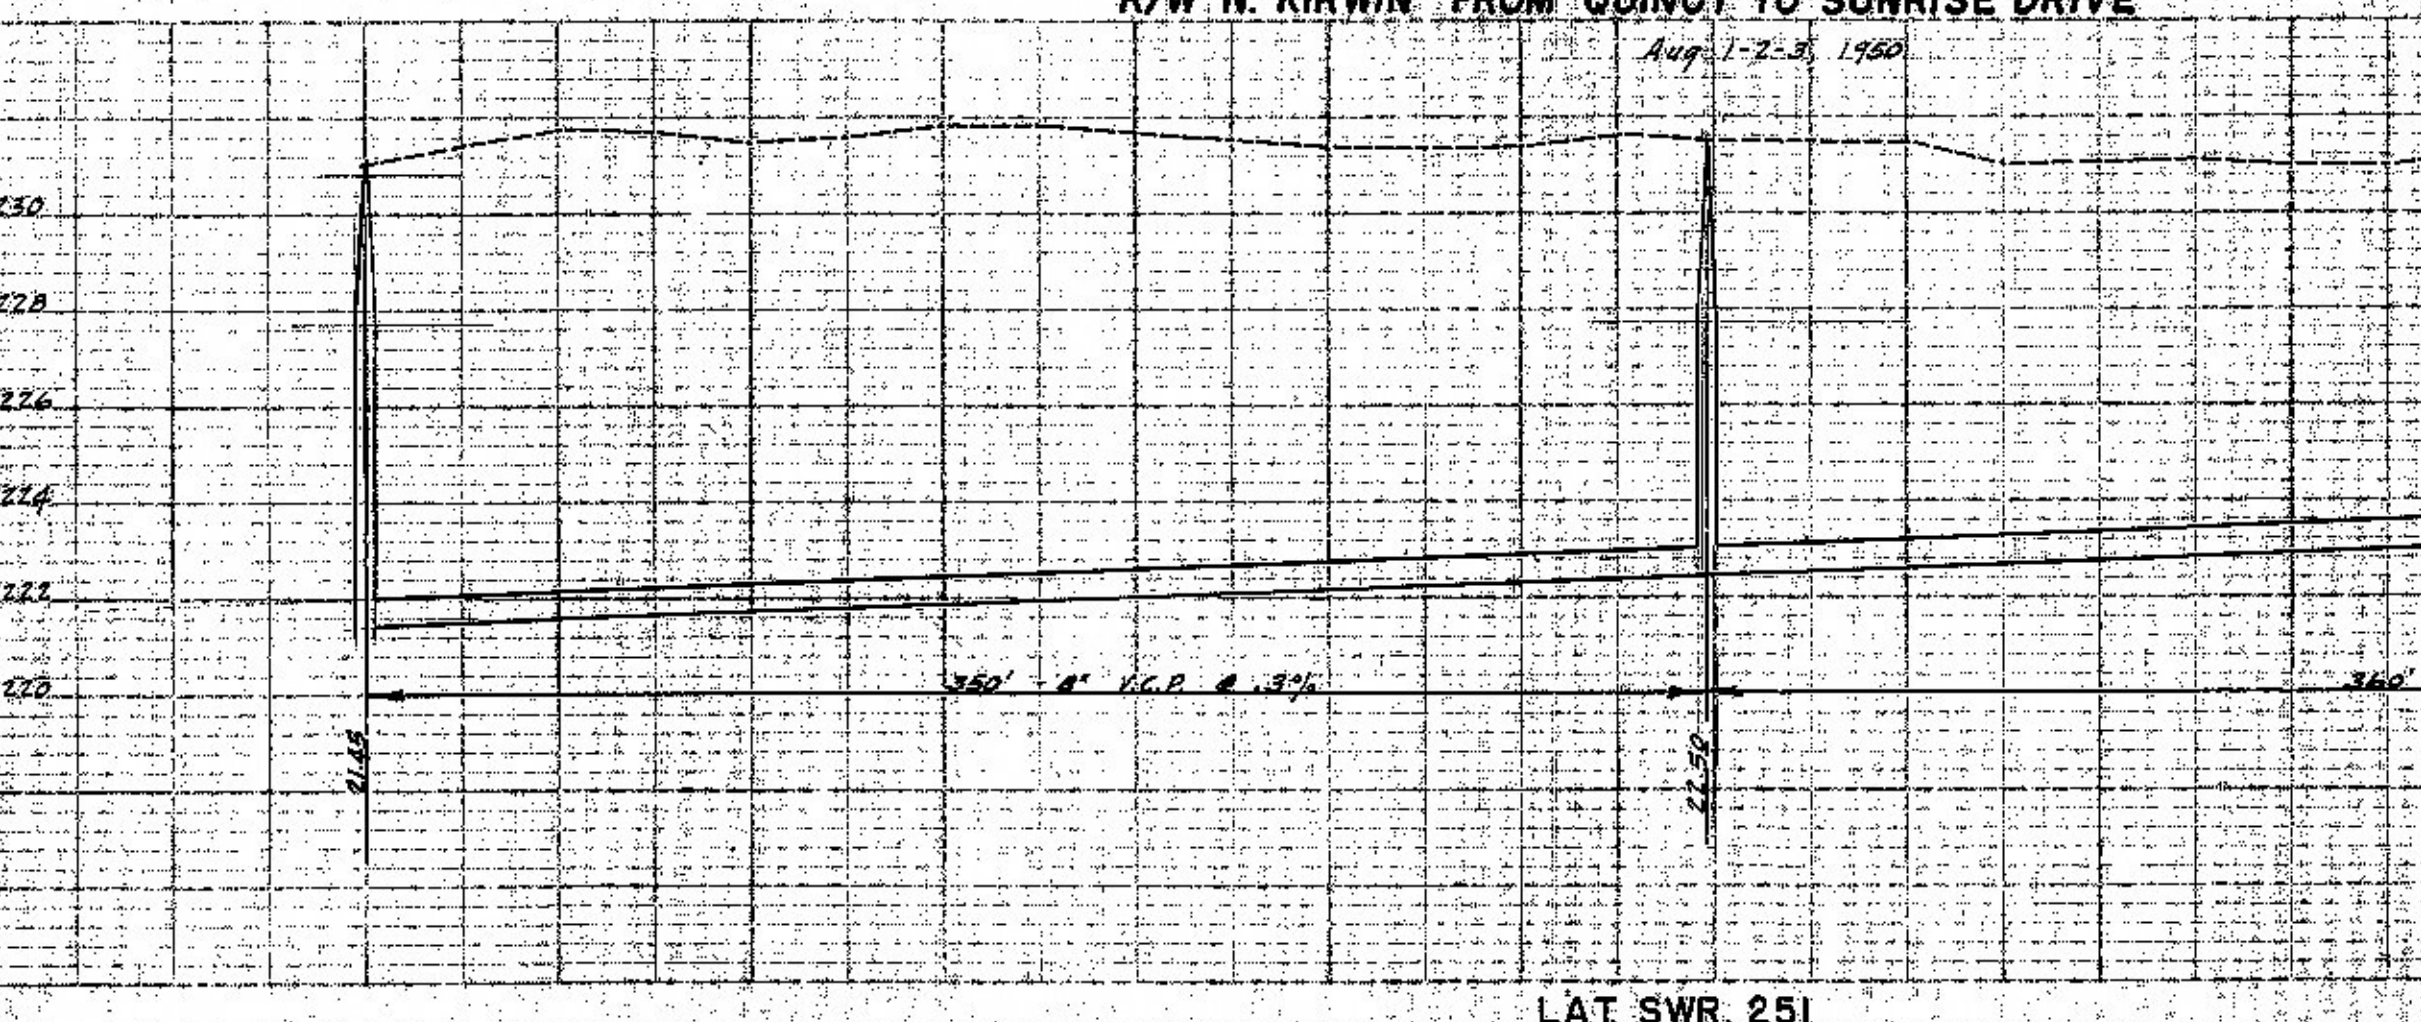
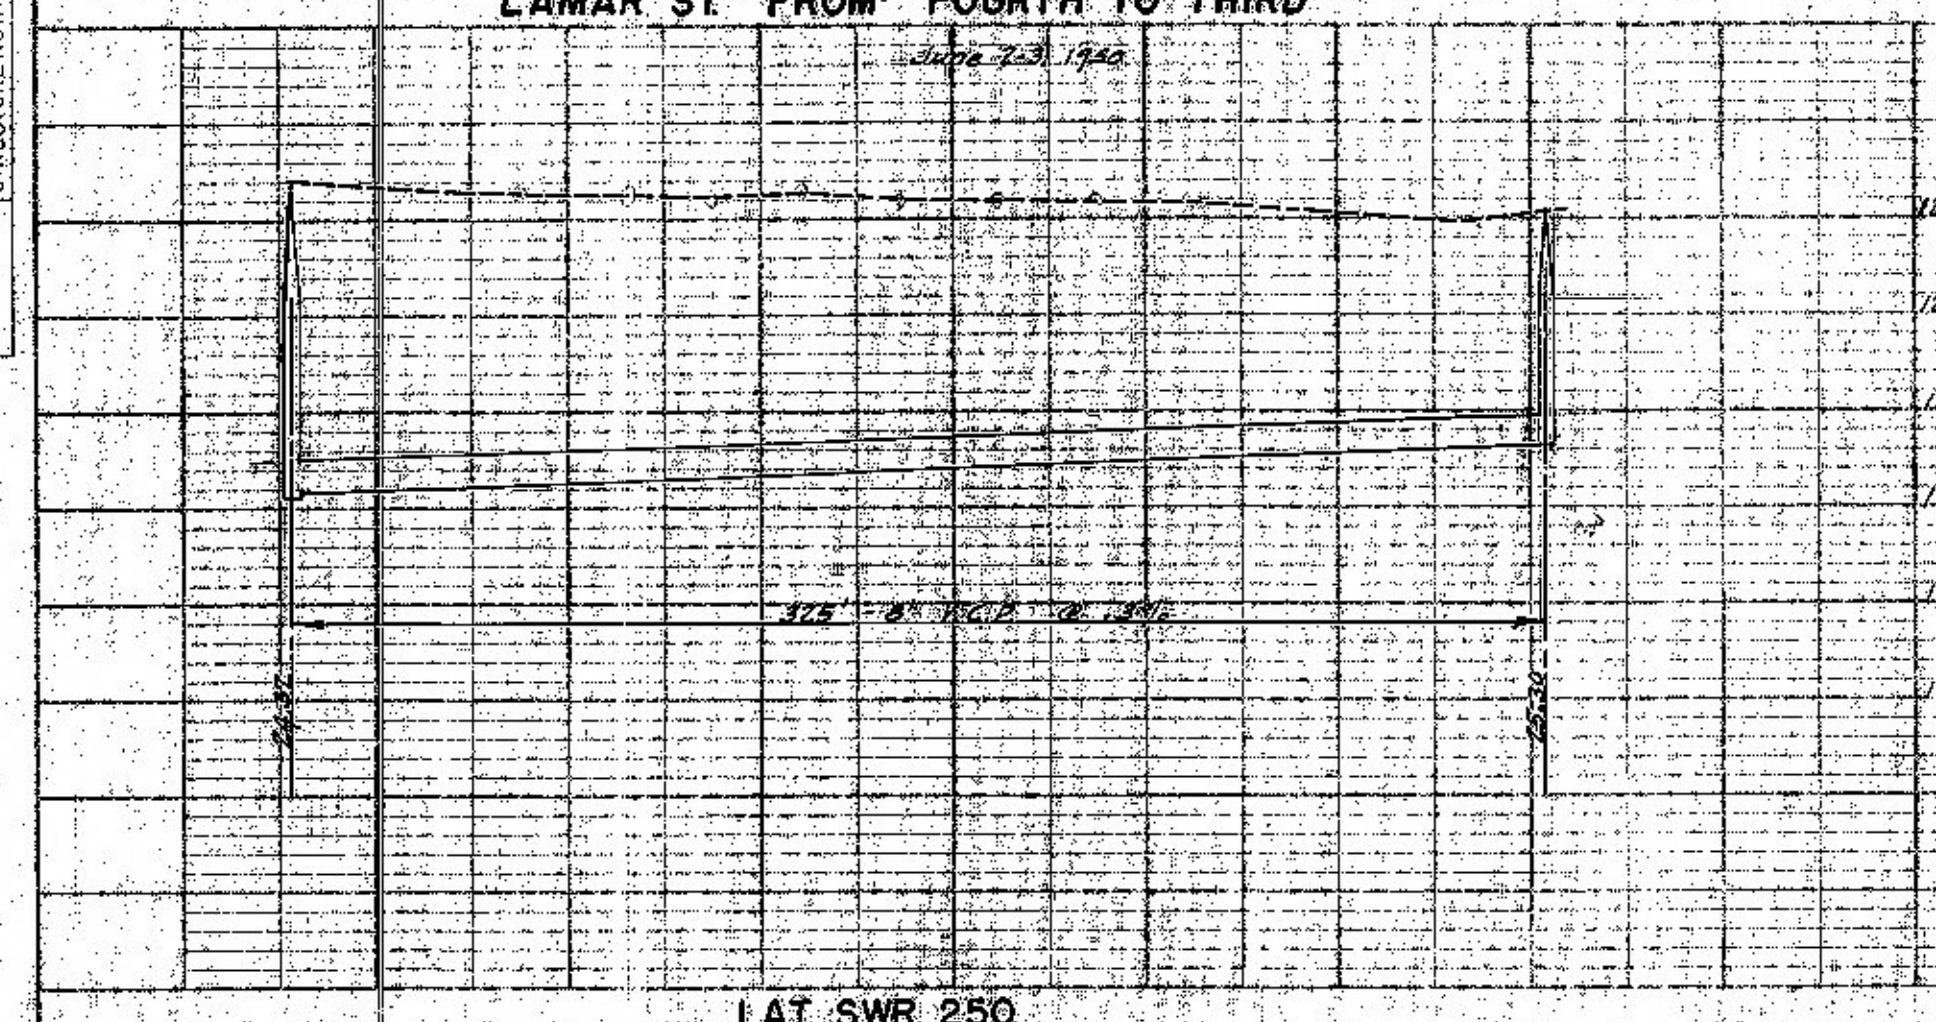
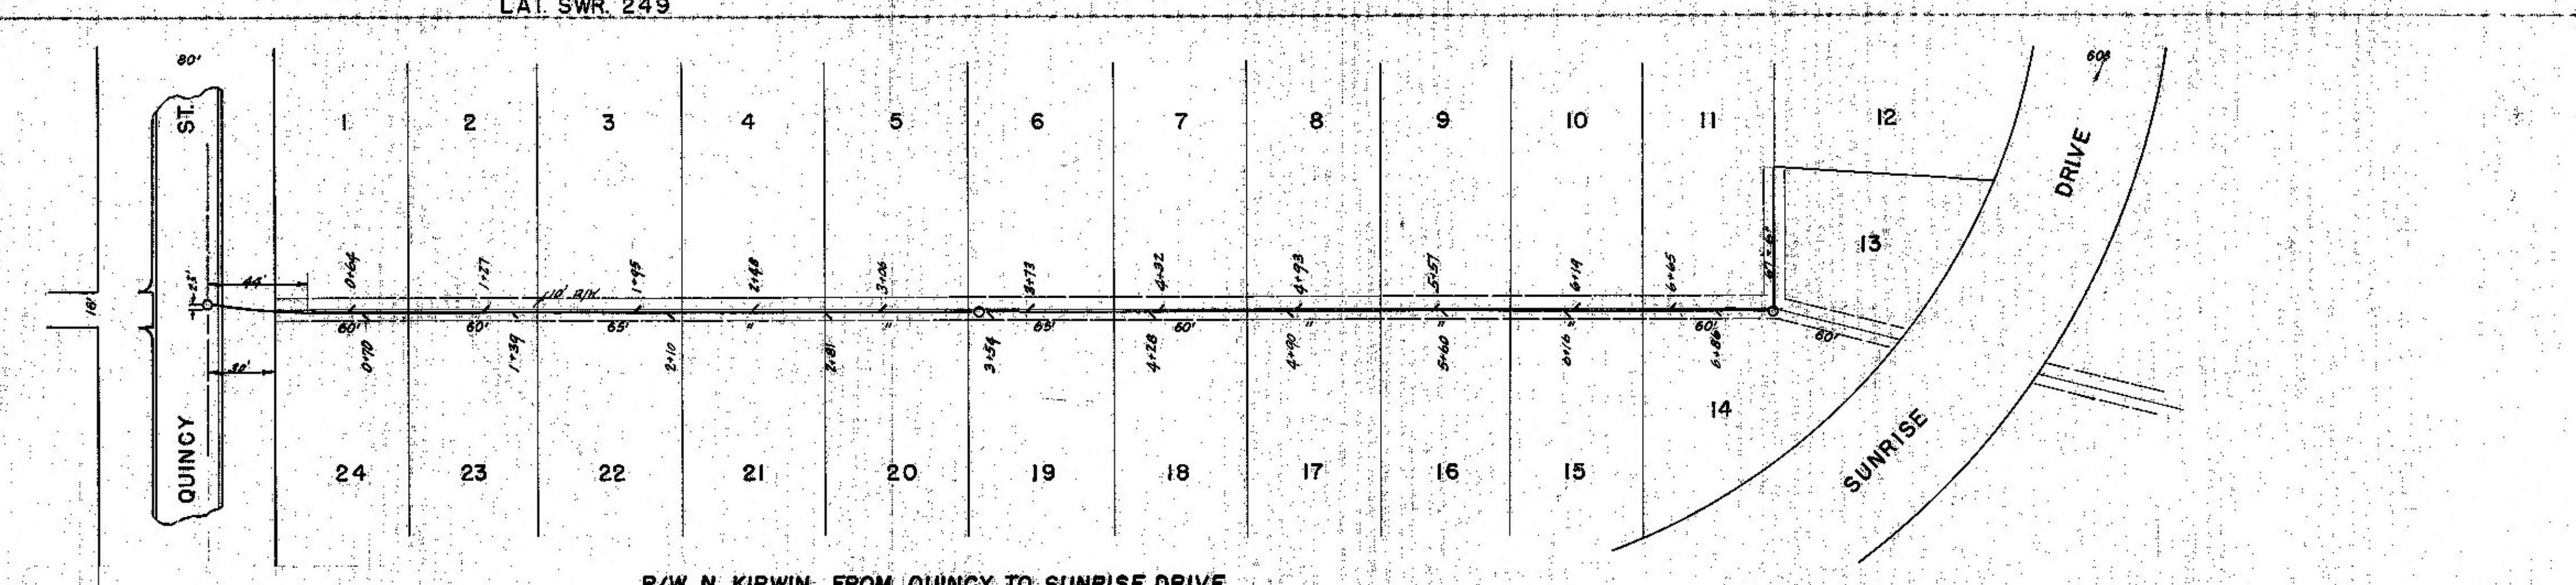
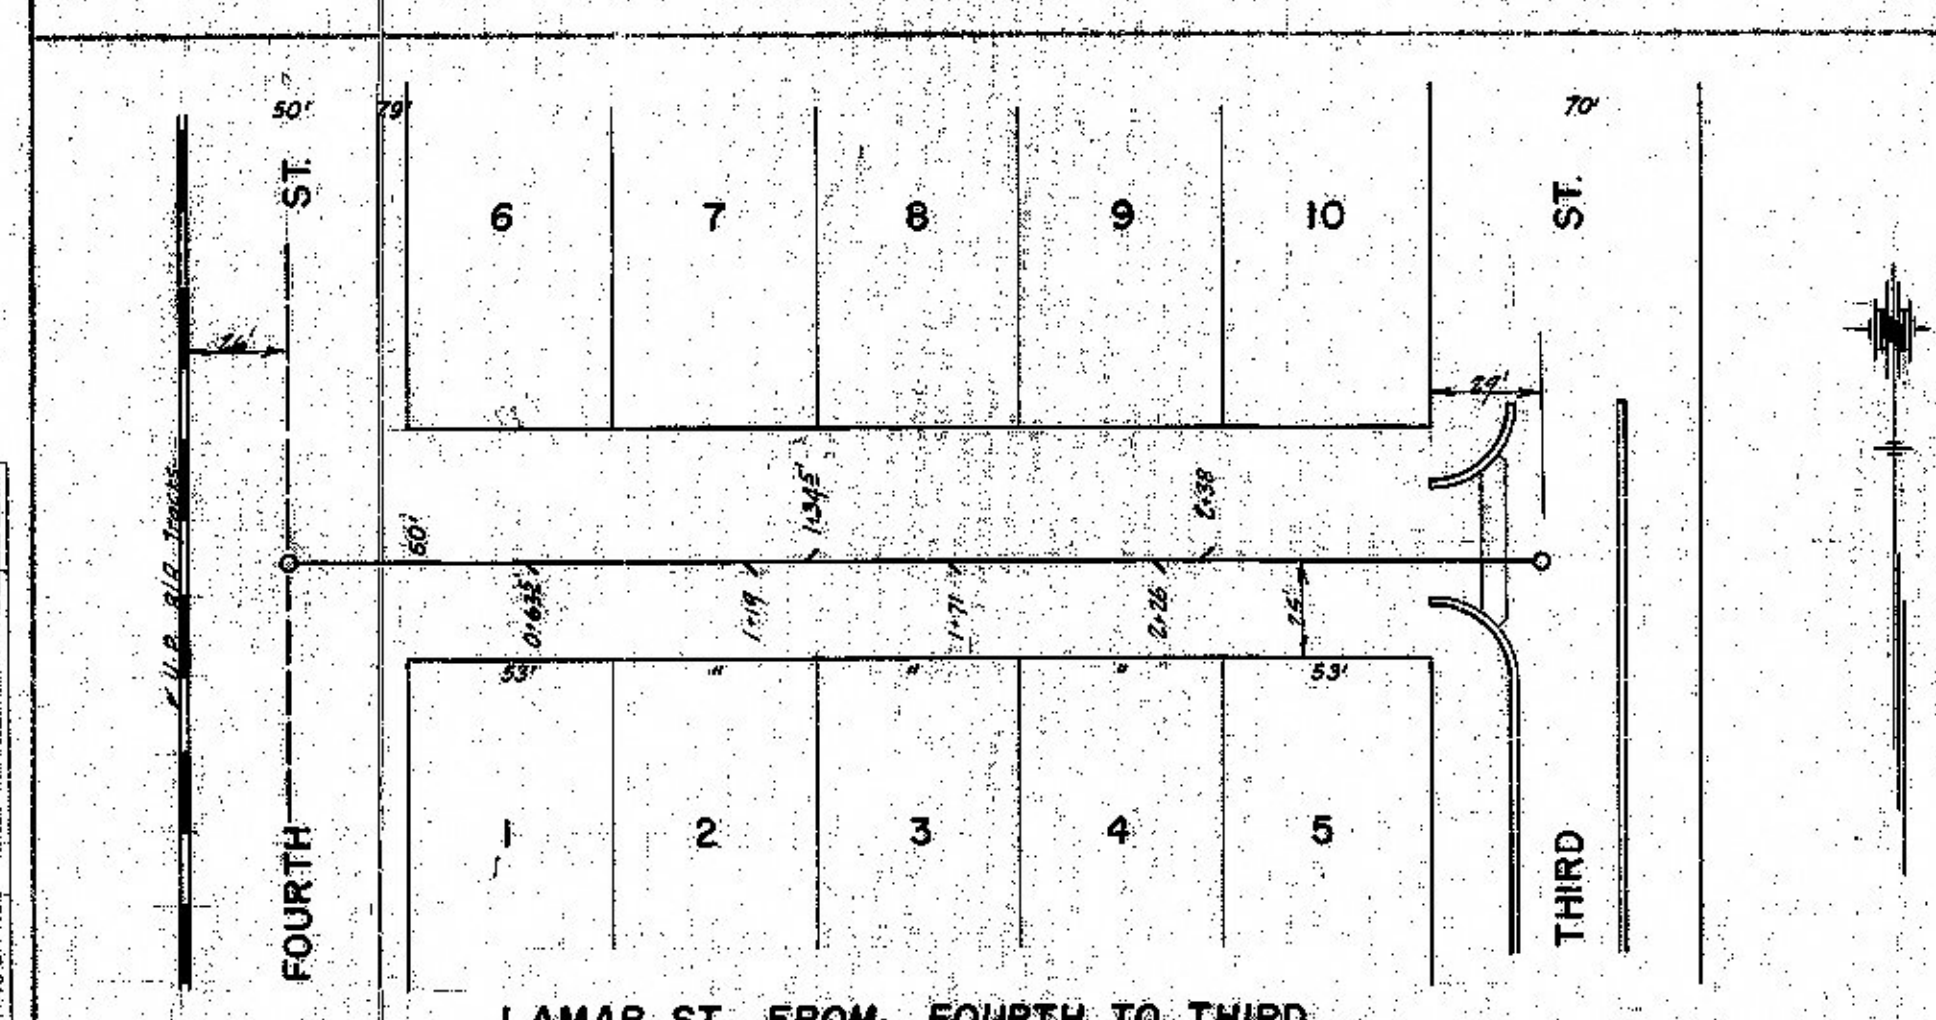
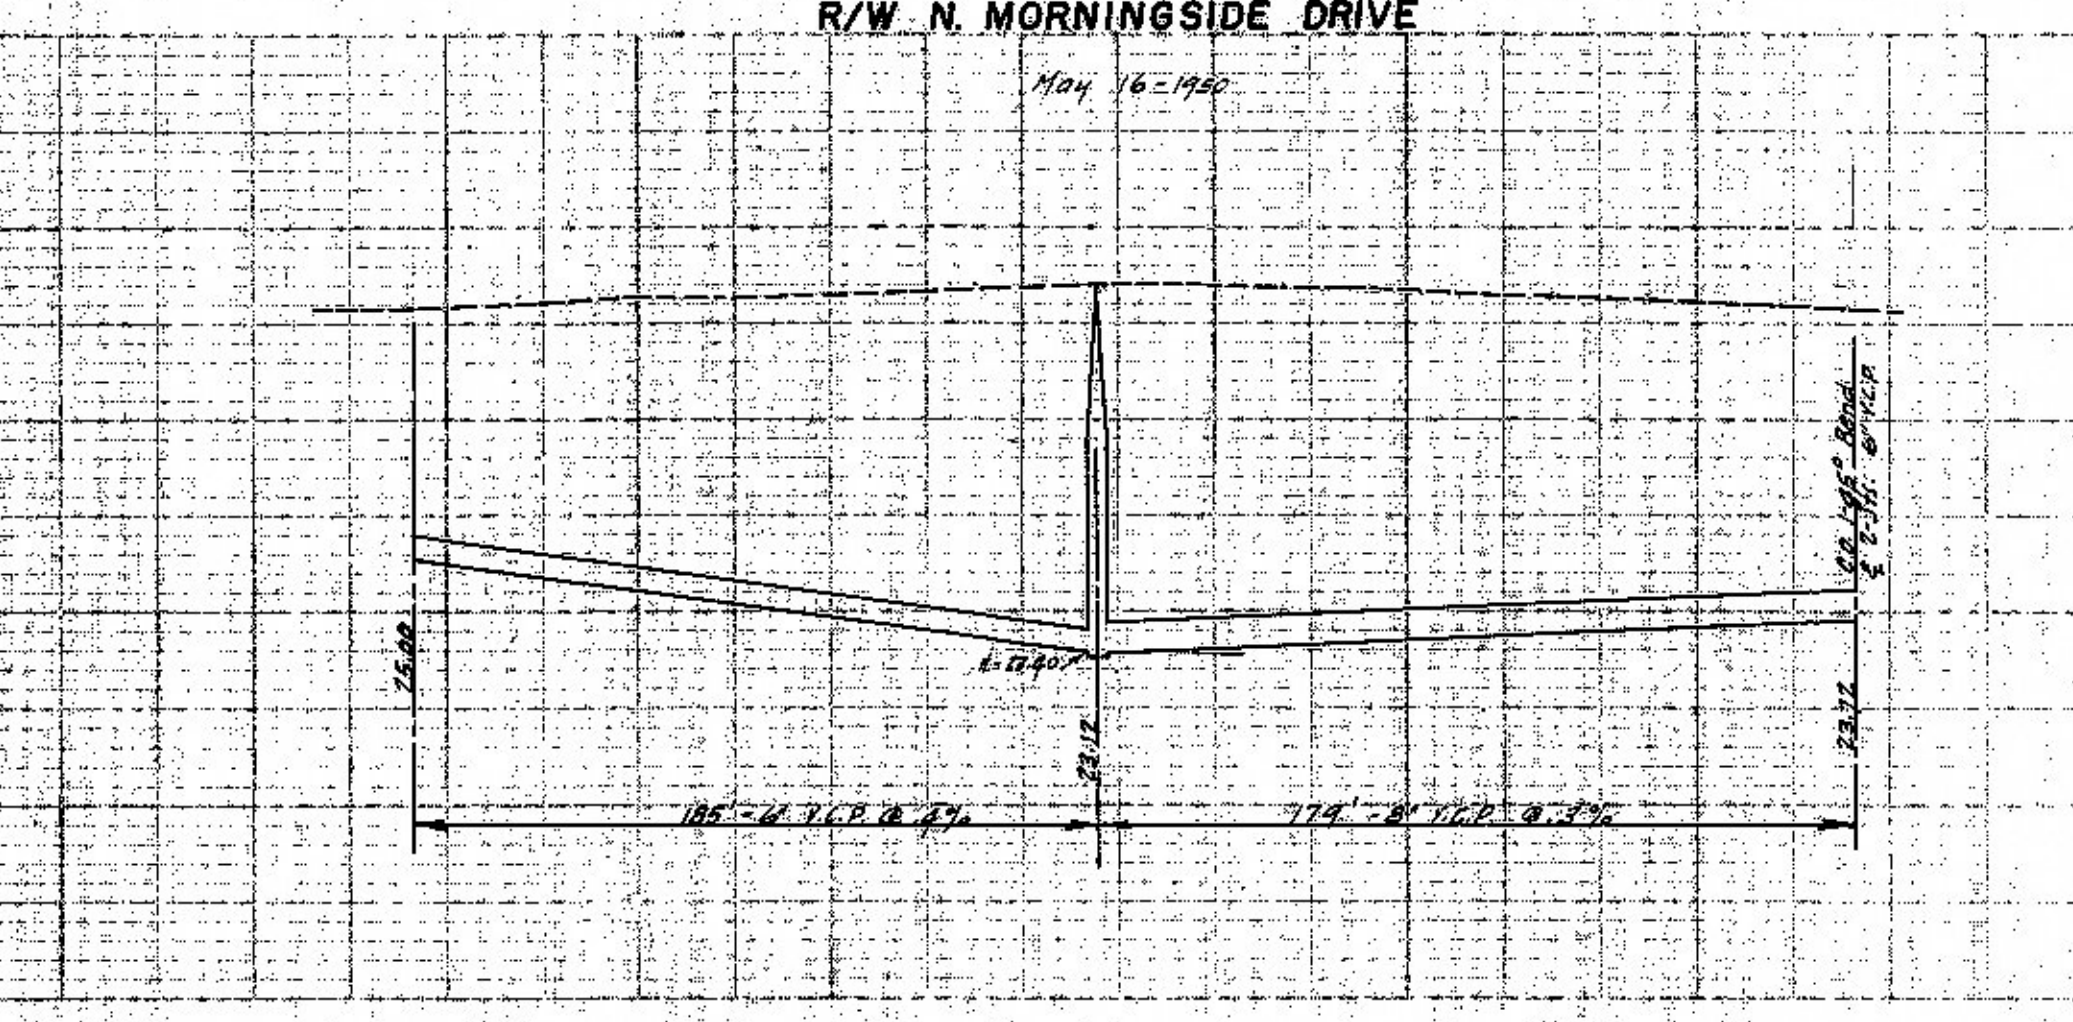
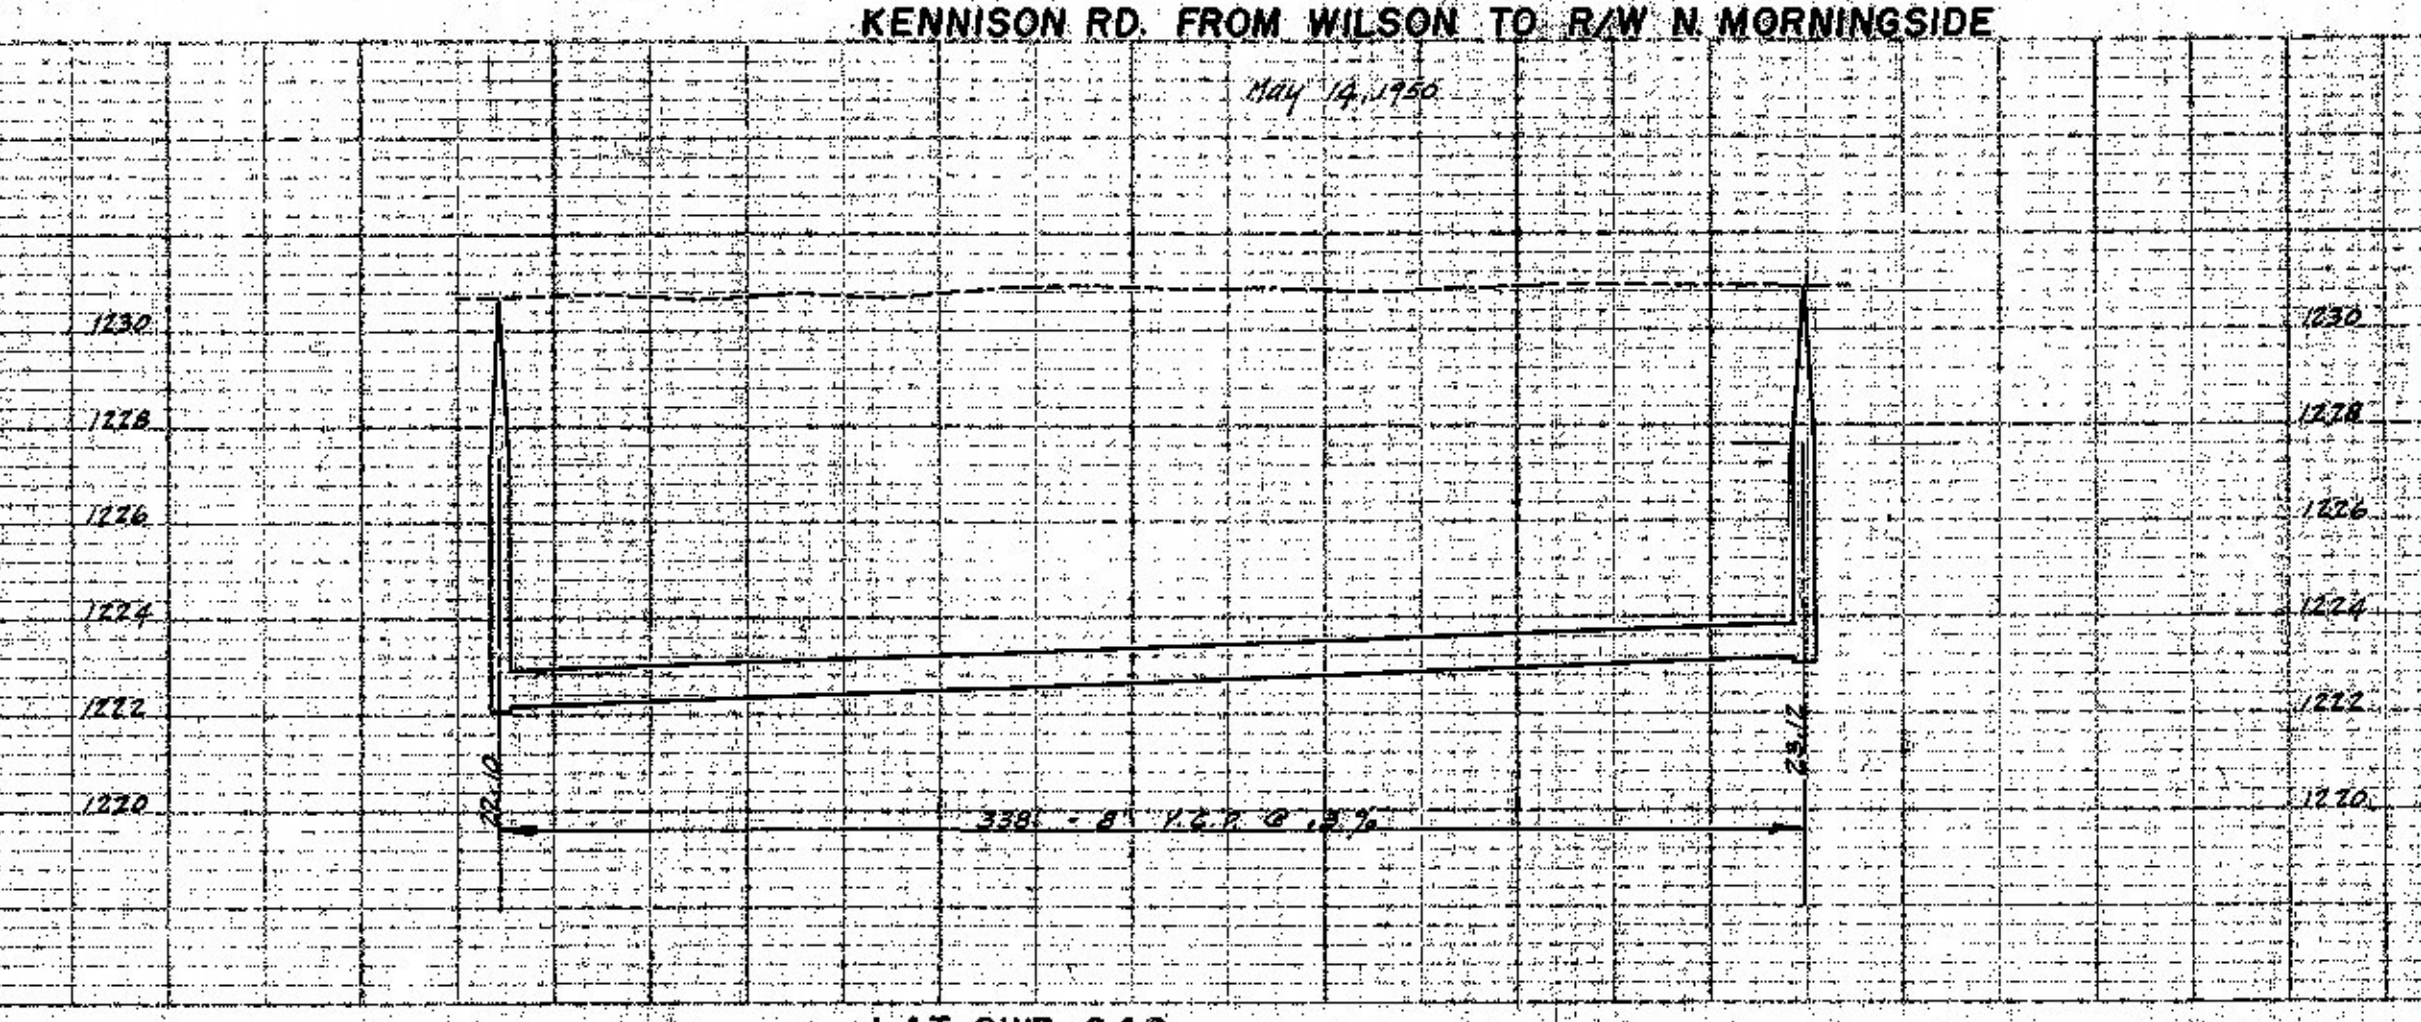
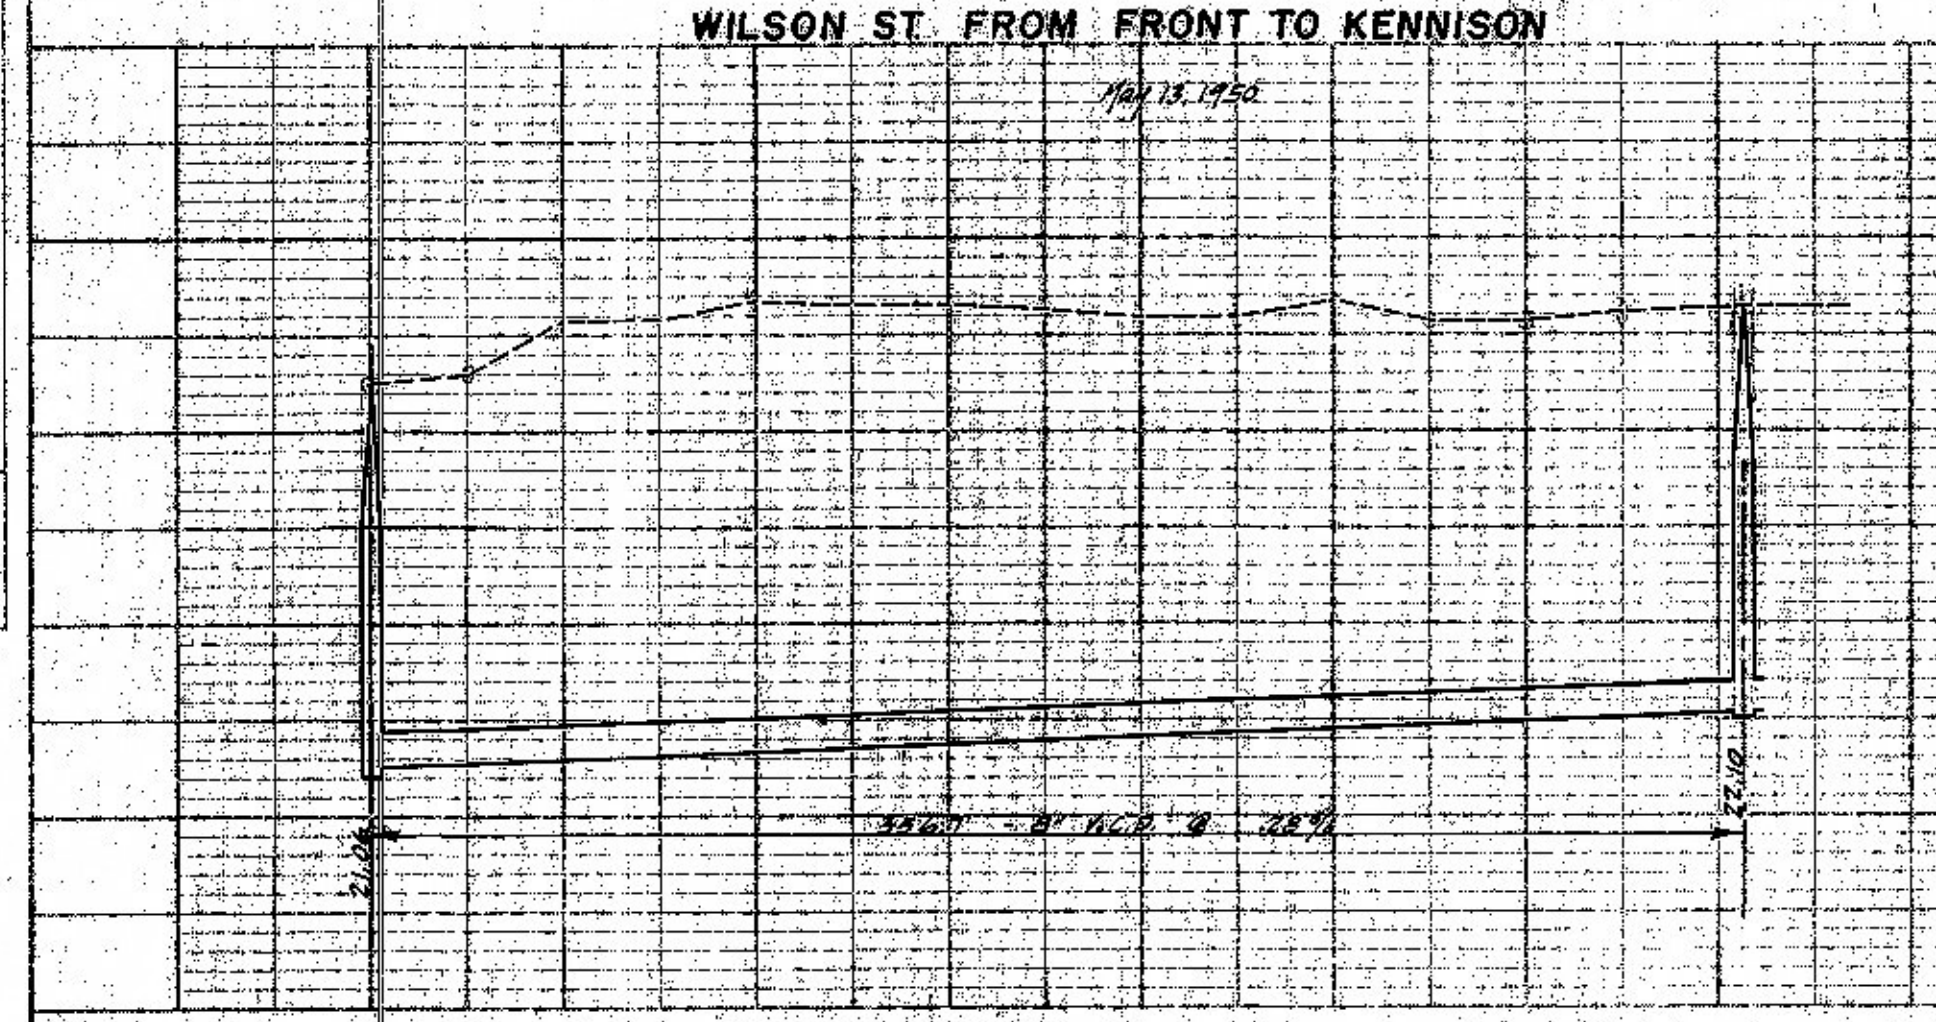
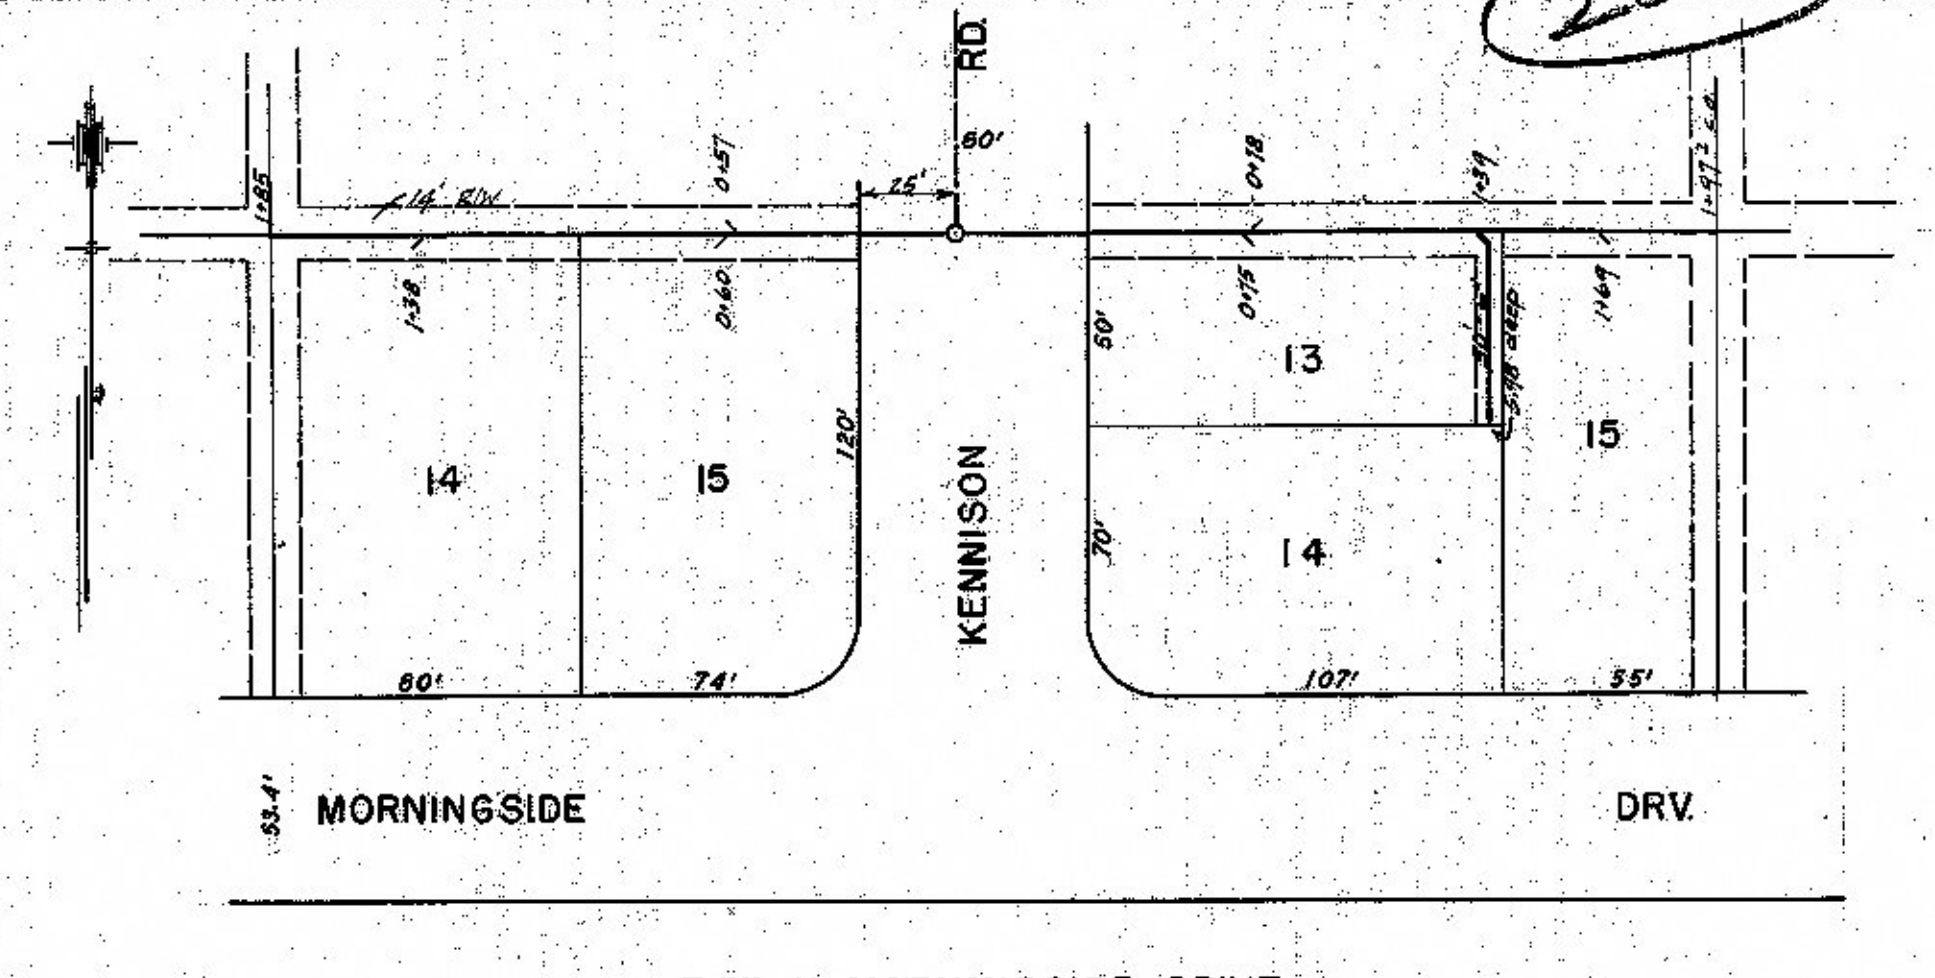


203

**PLAN**  
 SURVEYED...  
 PLOTTED...  
 NOTE BODY...  
 NO.

**PROFILE**  
 SURVEYED...  
 PLOTTED...  
 NOTE BODY...  
 NO.

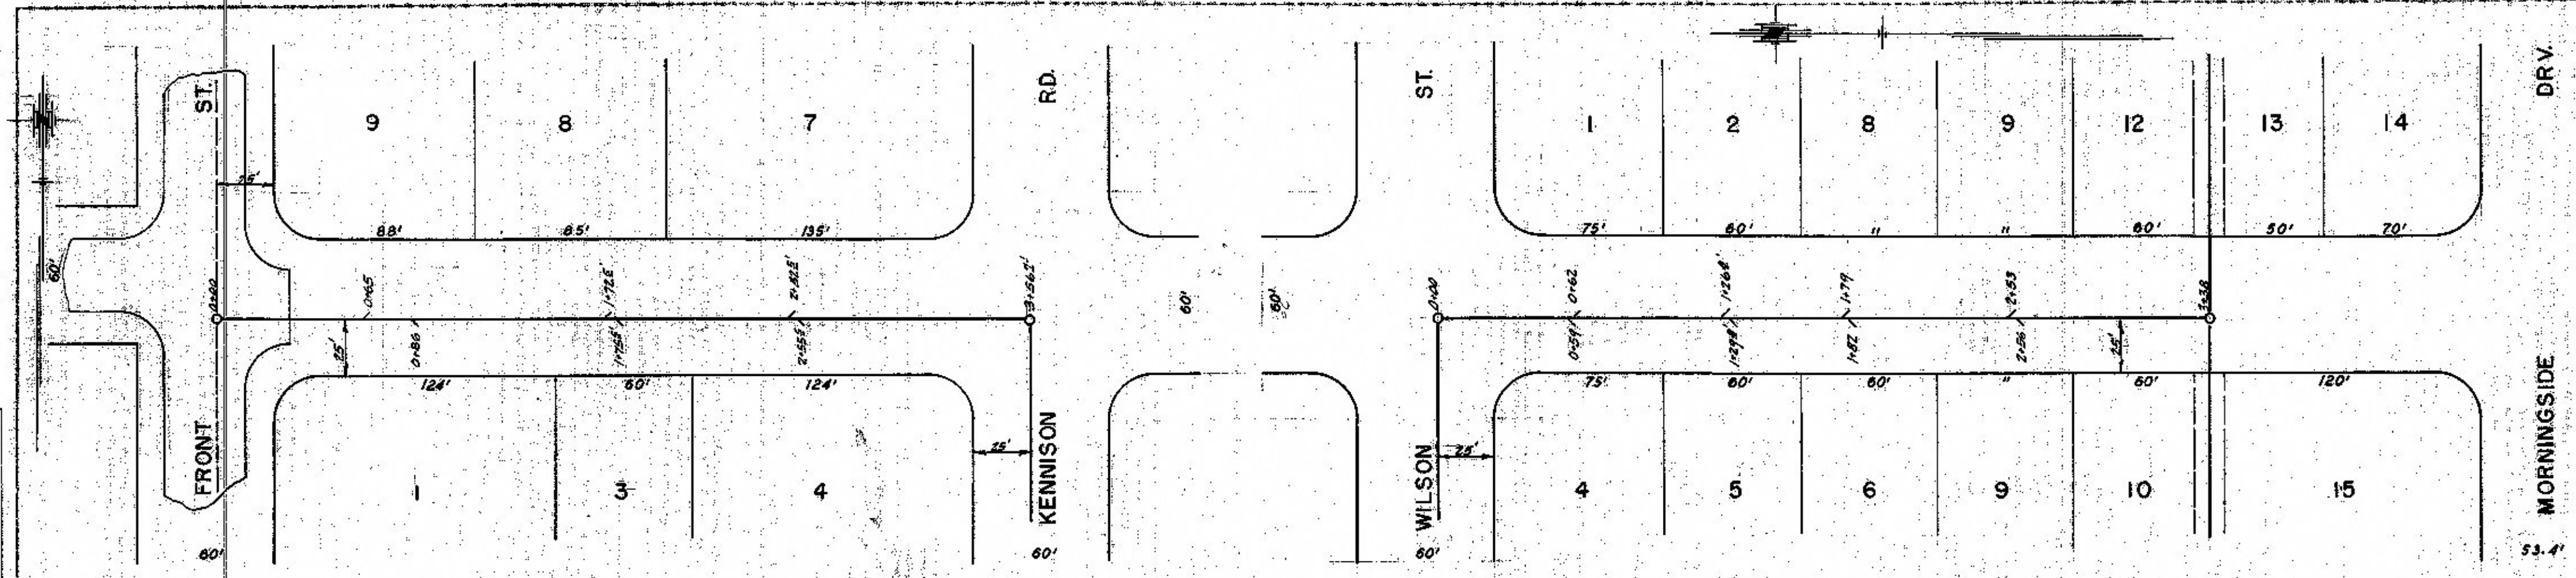

"As BUILT PLAN"  
 Compiled by  
 H.J. Taylor Construction Co.  
 SALINA, KANS.