

**PLAN**

DATE: \_\_\_\_\_ BY: \_\_\_\_\_

NO. \_\_\_\_\_

REVISIONS:

1. \_\_\_\_\_

2. \_\_\_\_\_


96. \_\_\_\_\_

97. \_\_\_\_\_


98. \_\_\_\_\_

99. \_\_\_\_\_



100. \_\_\_\_\_

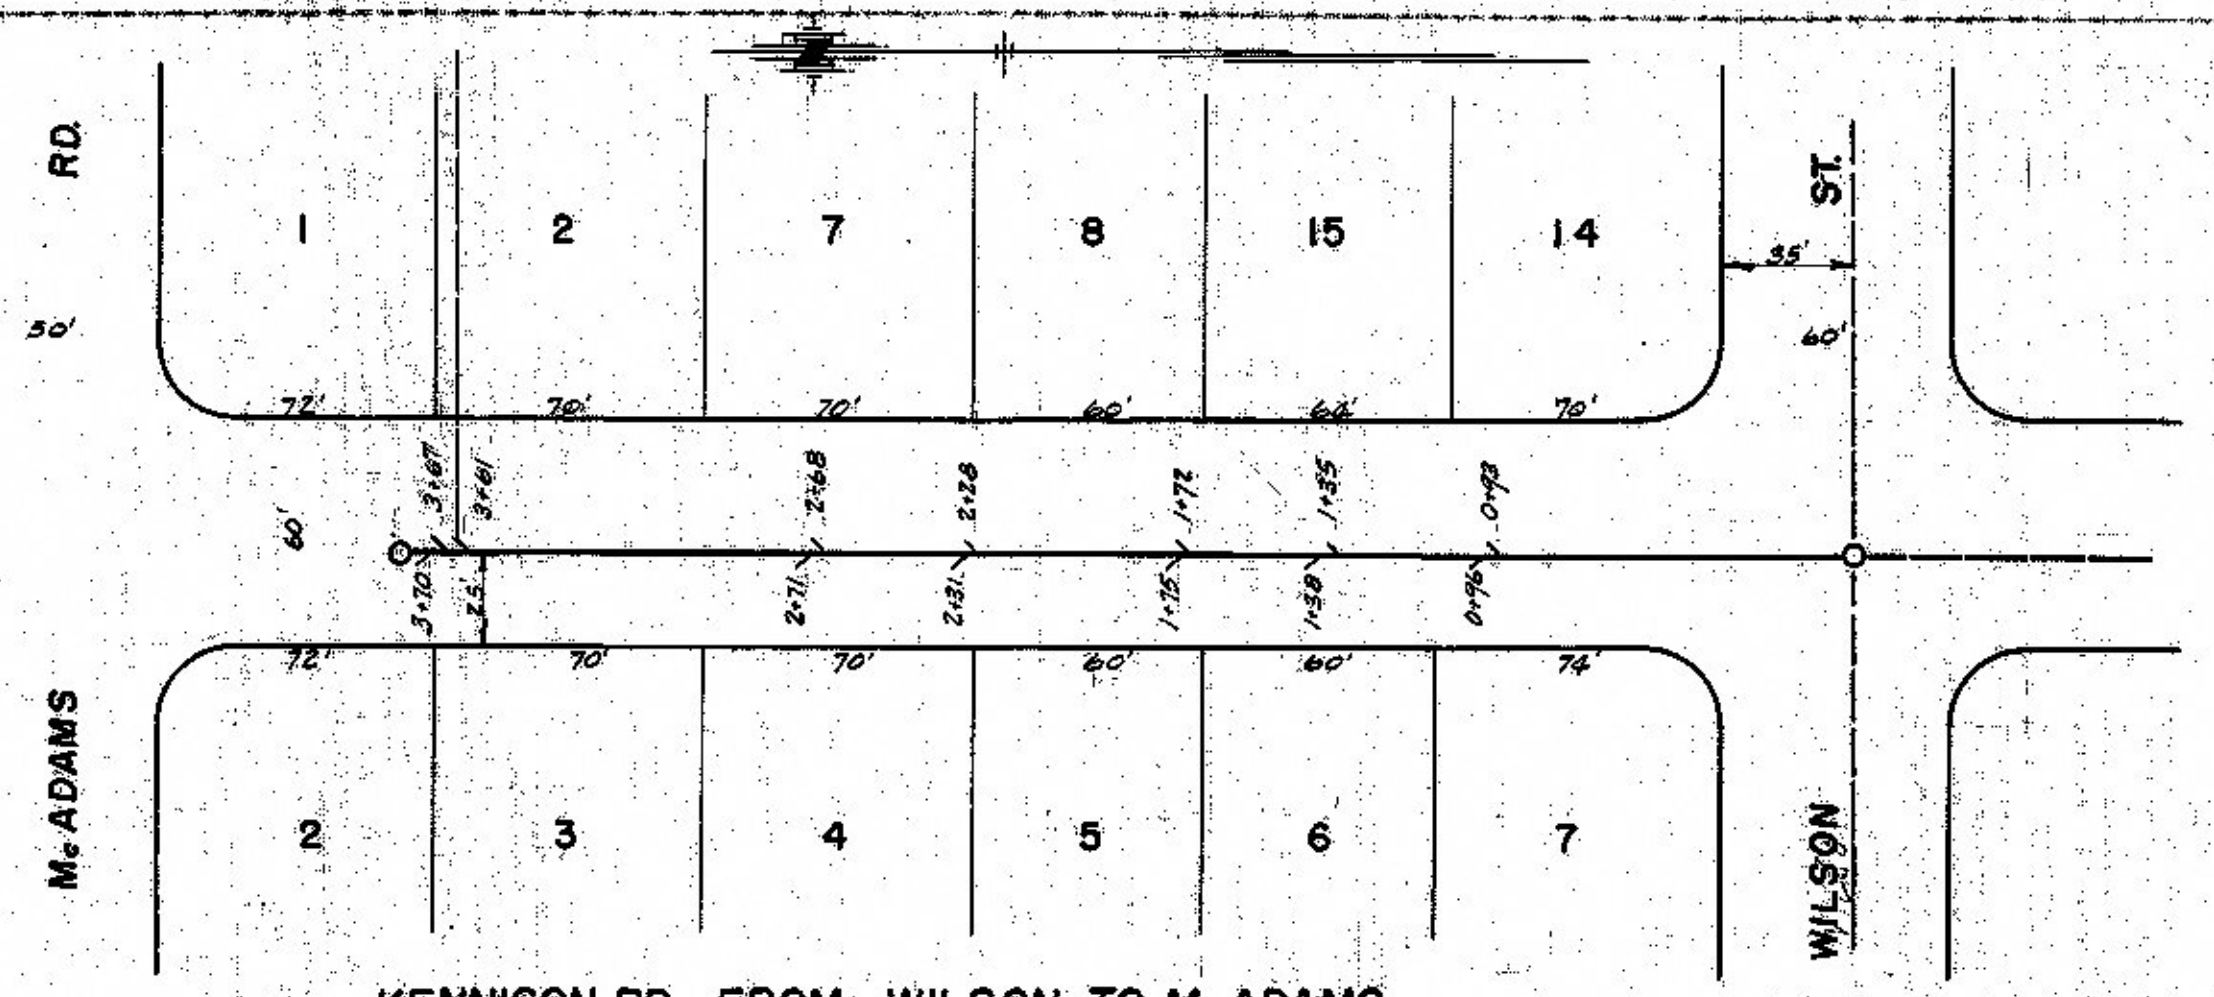

KENNISON RD. FROM WILSON TO M. ADAMS

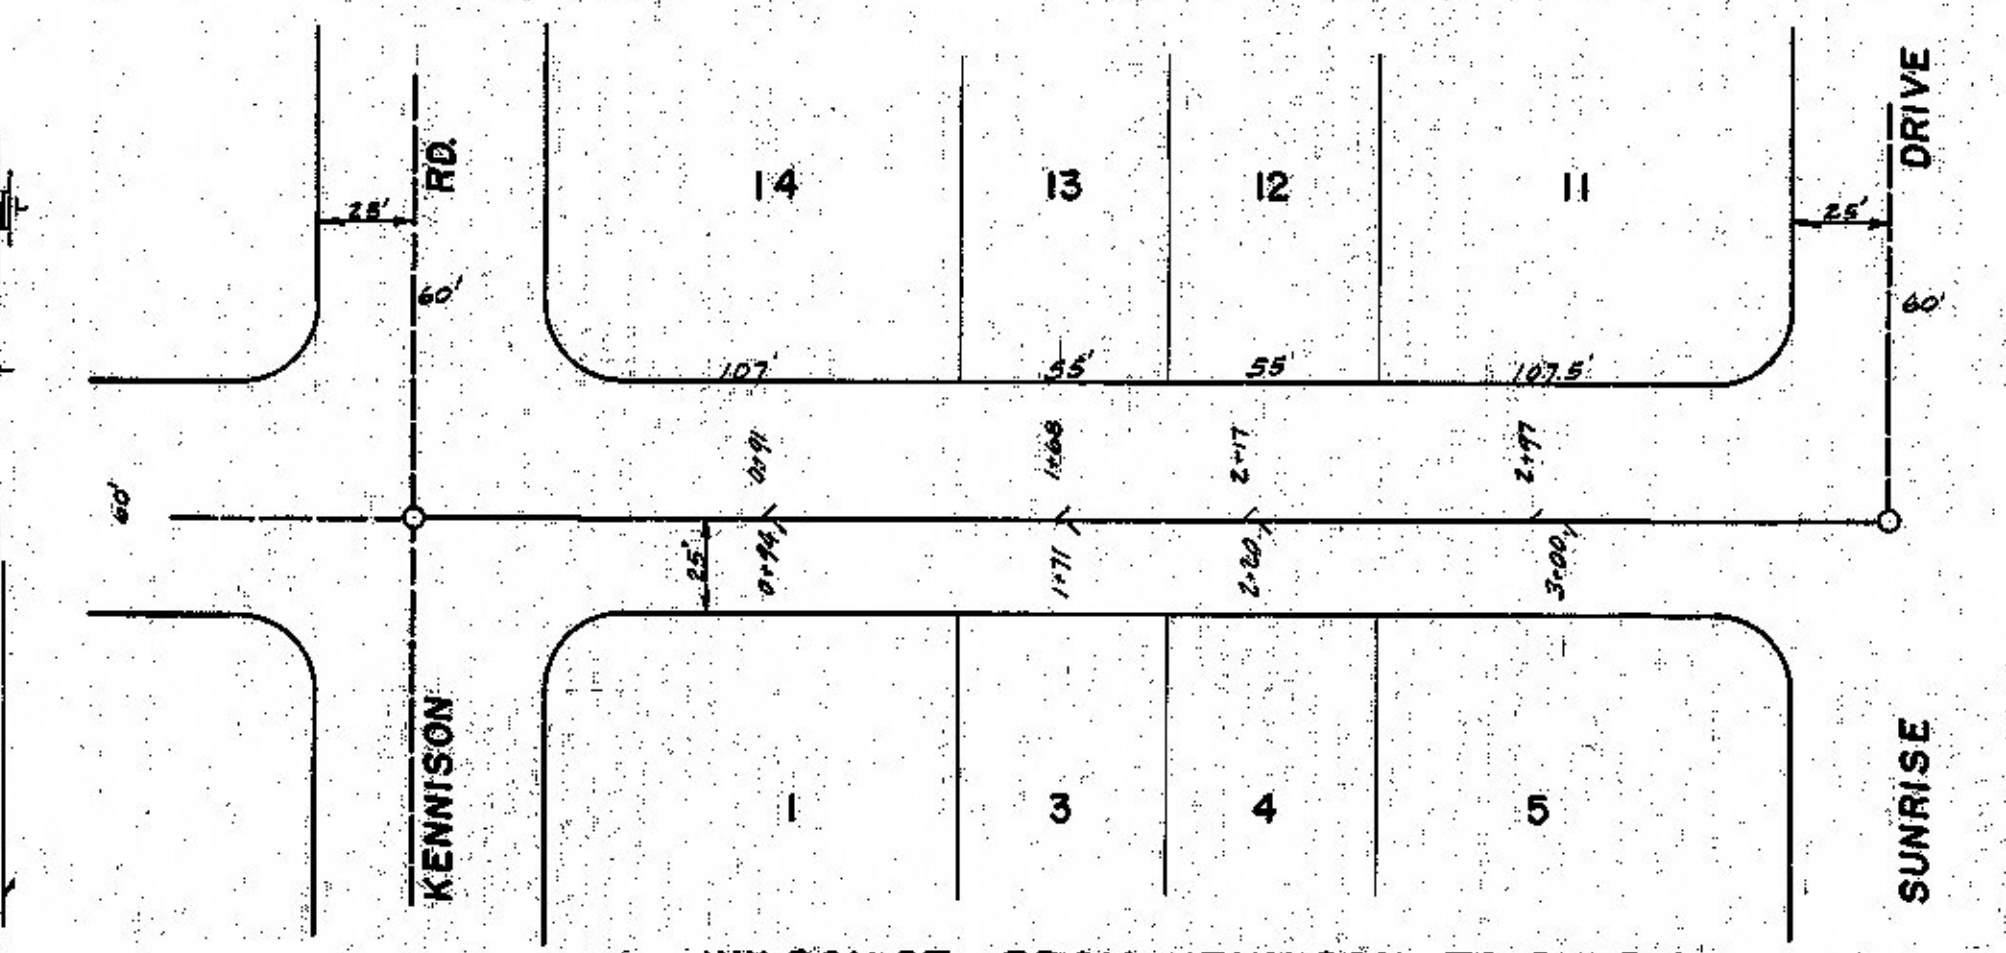

WILSON ST. FROM KENNISON TO SUNRISE

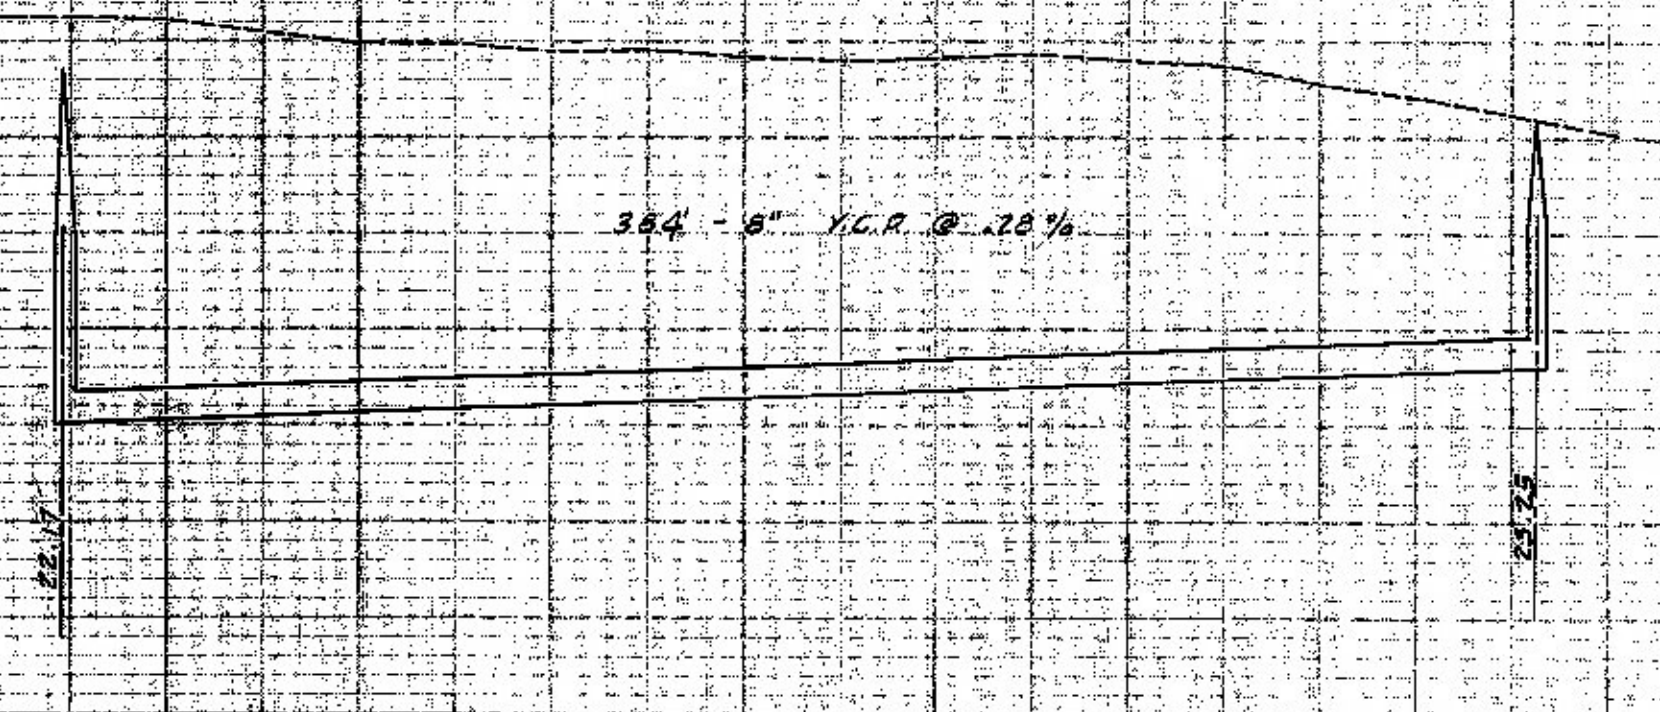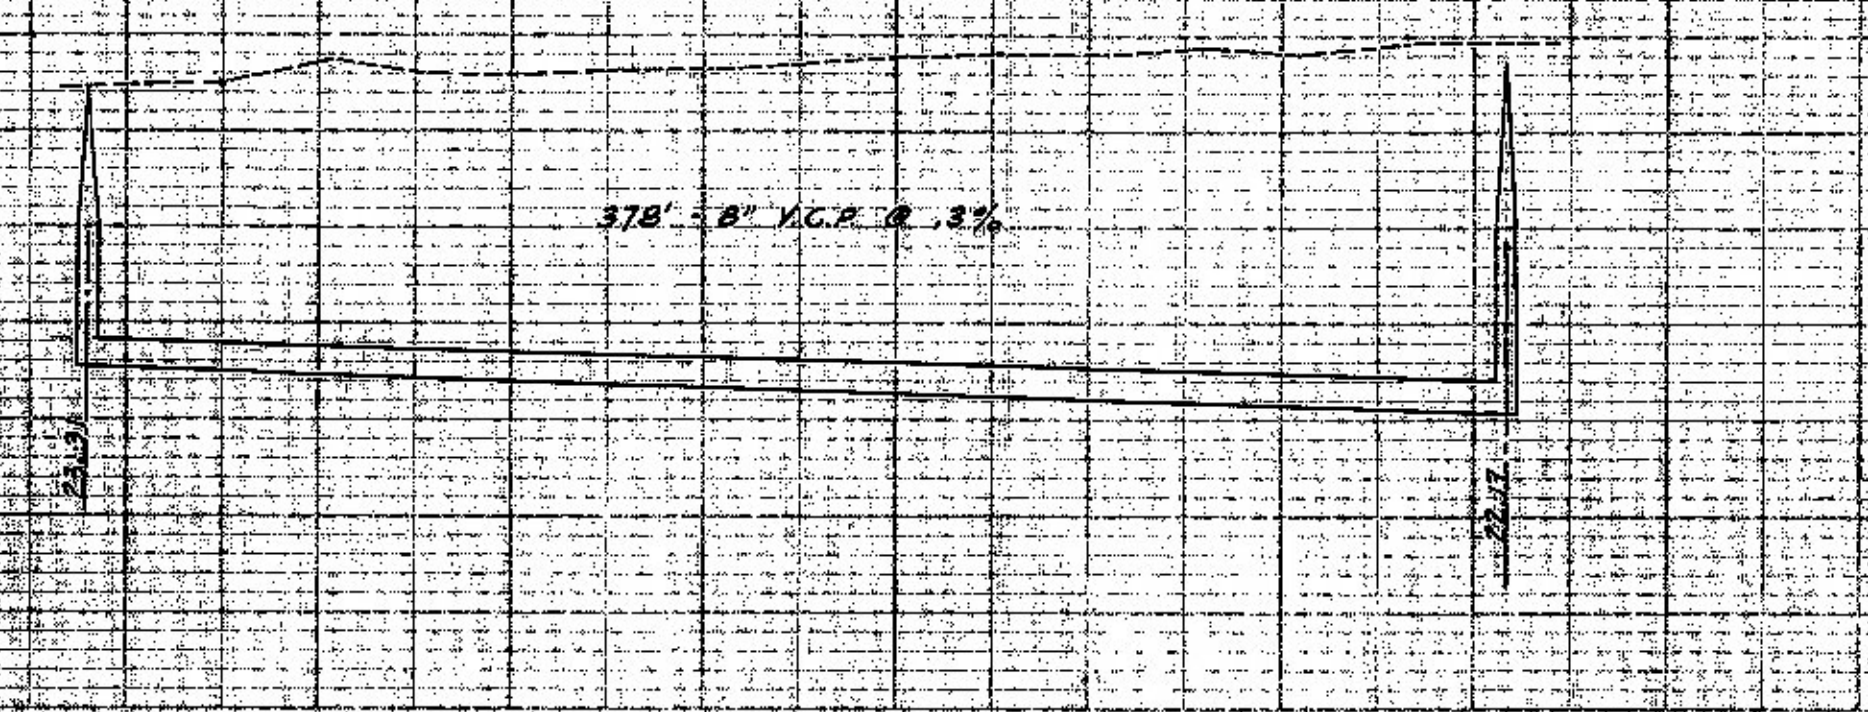

"AS BUILT PLAN"  
Constructed Dec. 1980  
by:  
H. J. Taylor Const. Co.  
Salina, Kans.

**PROFILE**

DATE: \_\_\_\_\_ BY: \_\_\_\_\_

NO. \_\_\_\_\_

REVISIONS:

1. \_\_\_\_\_

2. \_\_\_\_\_


96. \_\_\_\_\_

97. \_\_\_\_\_


98. \_\_\_\_\_

99. \_\_\_\_\_

100. \_\_\_\_\_

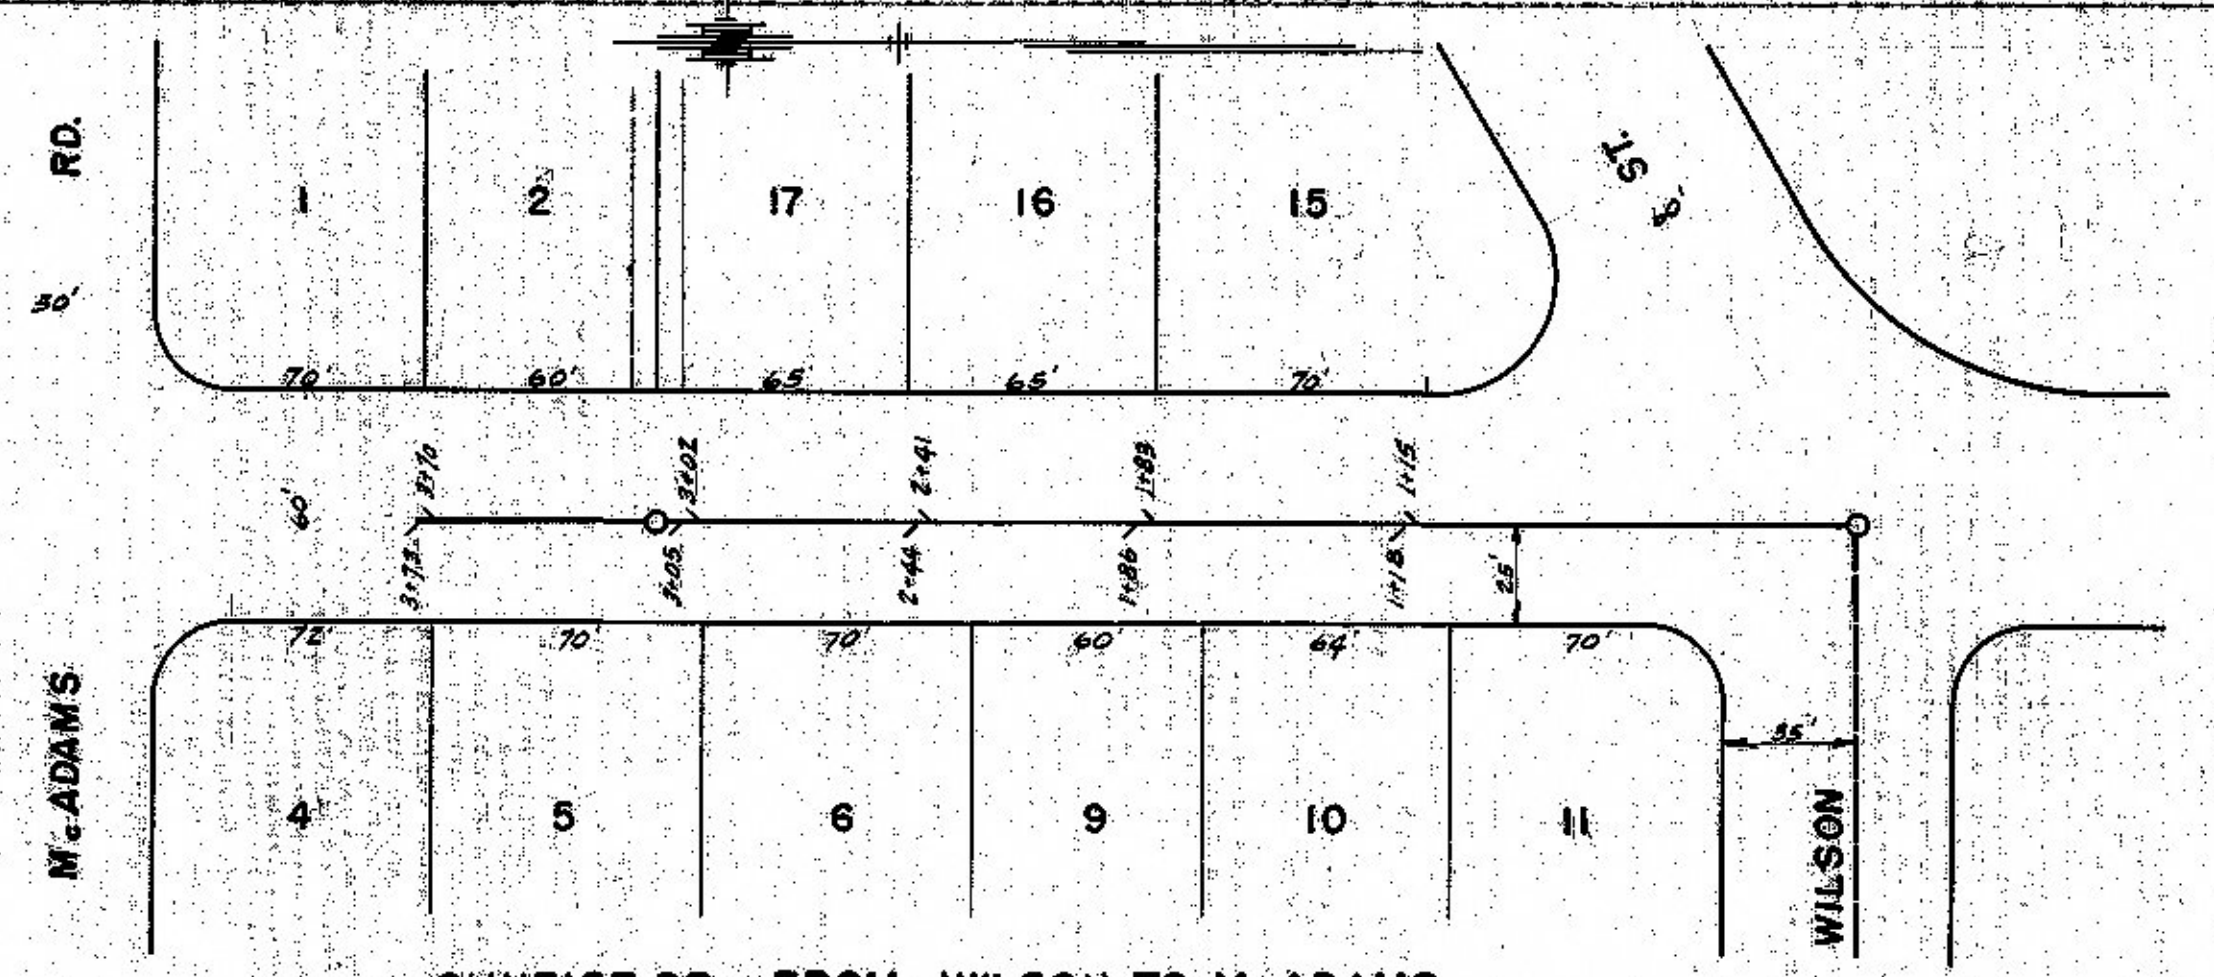

SUNRISE DR. FROM WILSON TO M. ADAMS

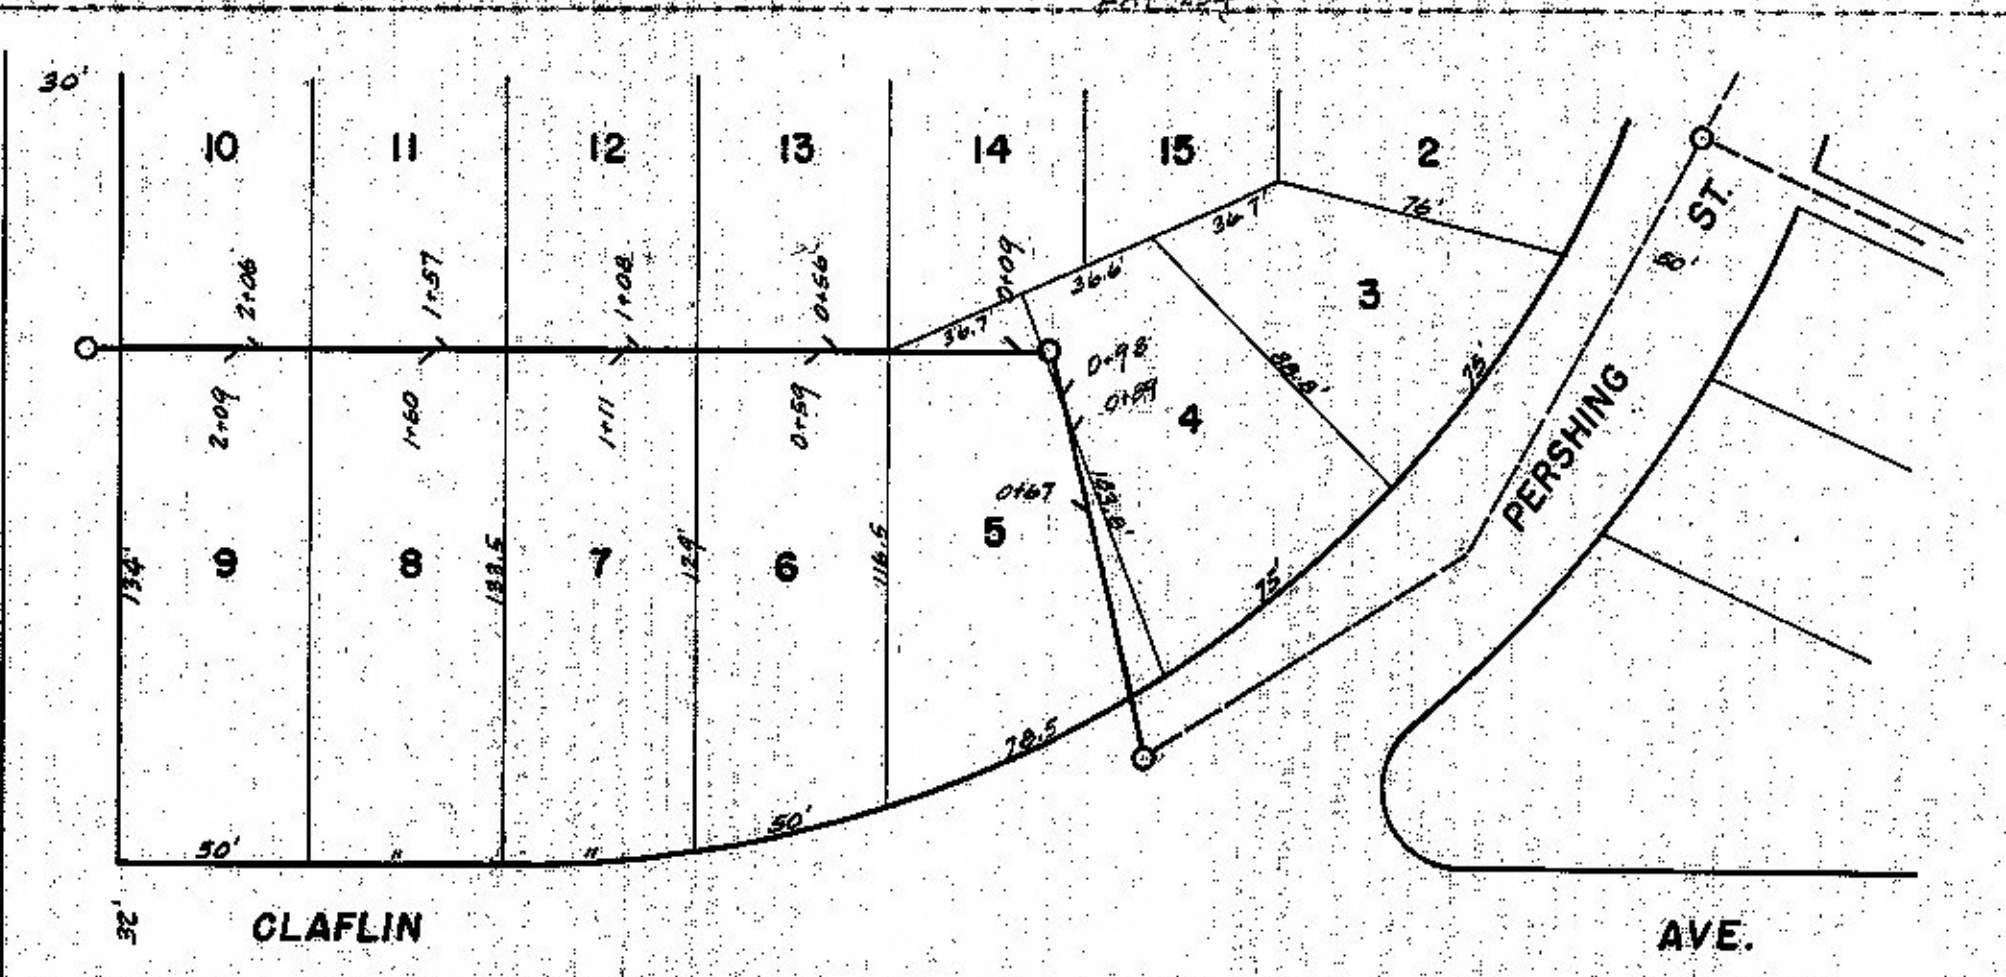

R/W NORTH OF CLAFLIN FROM PERSHING TO RUSH

