



206

PLAN	SURVEYED	DATE
NOTE BOOK NO.	PLOTTED	BY
	CHECKED	
	PT. OF WAY CHECKED	

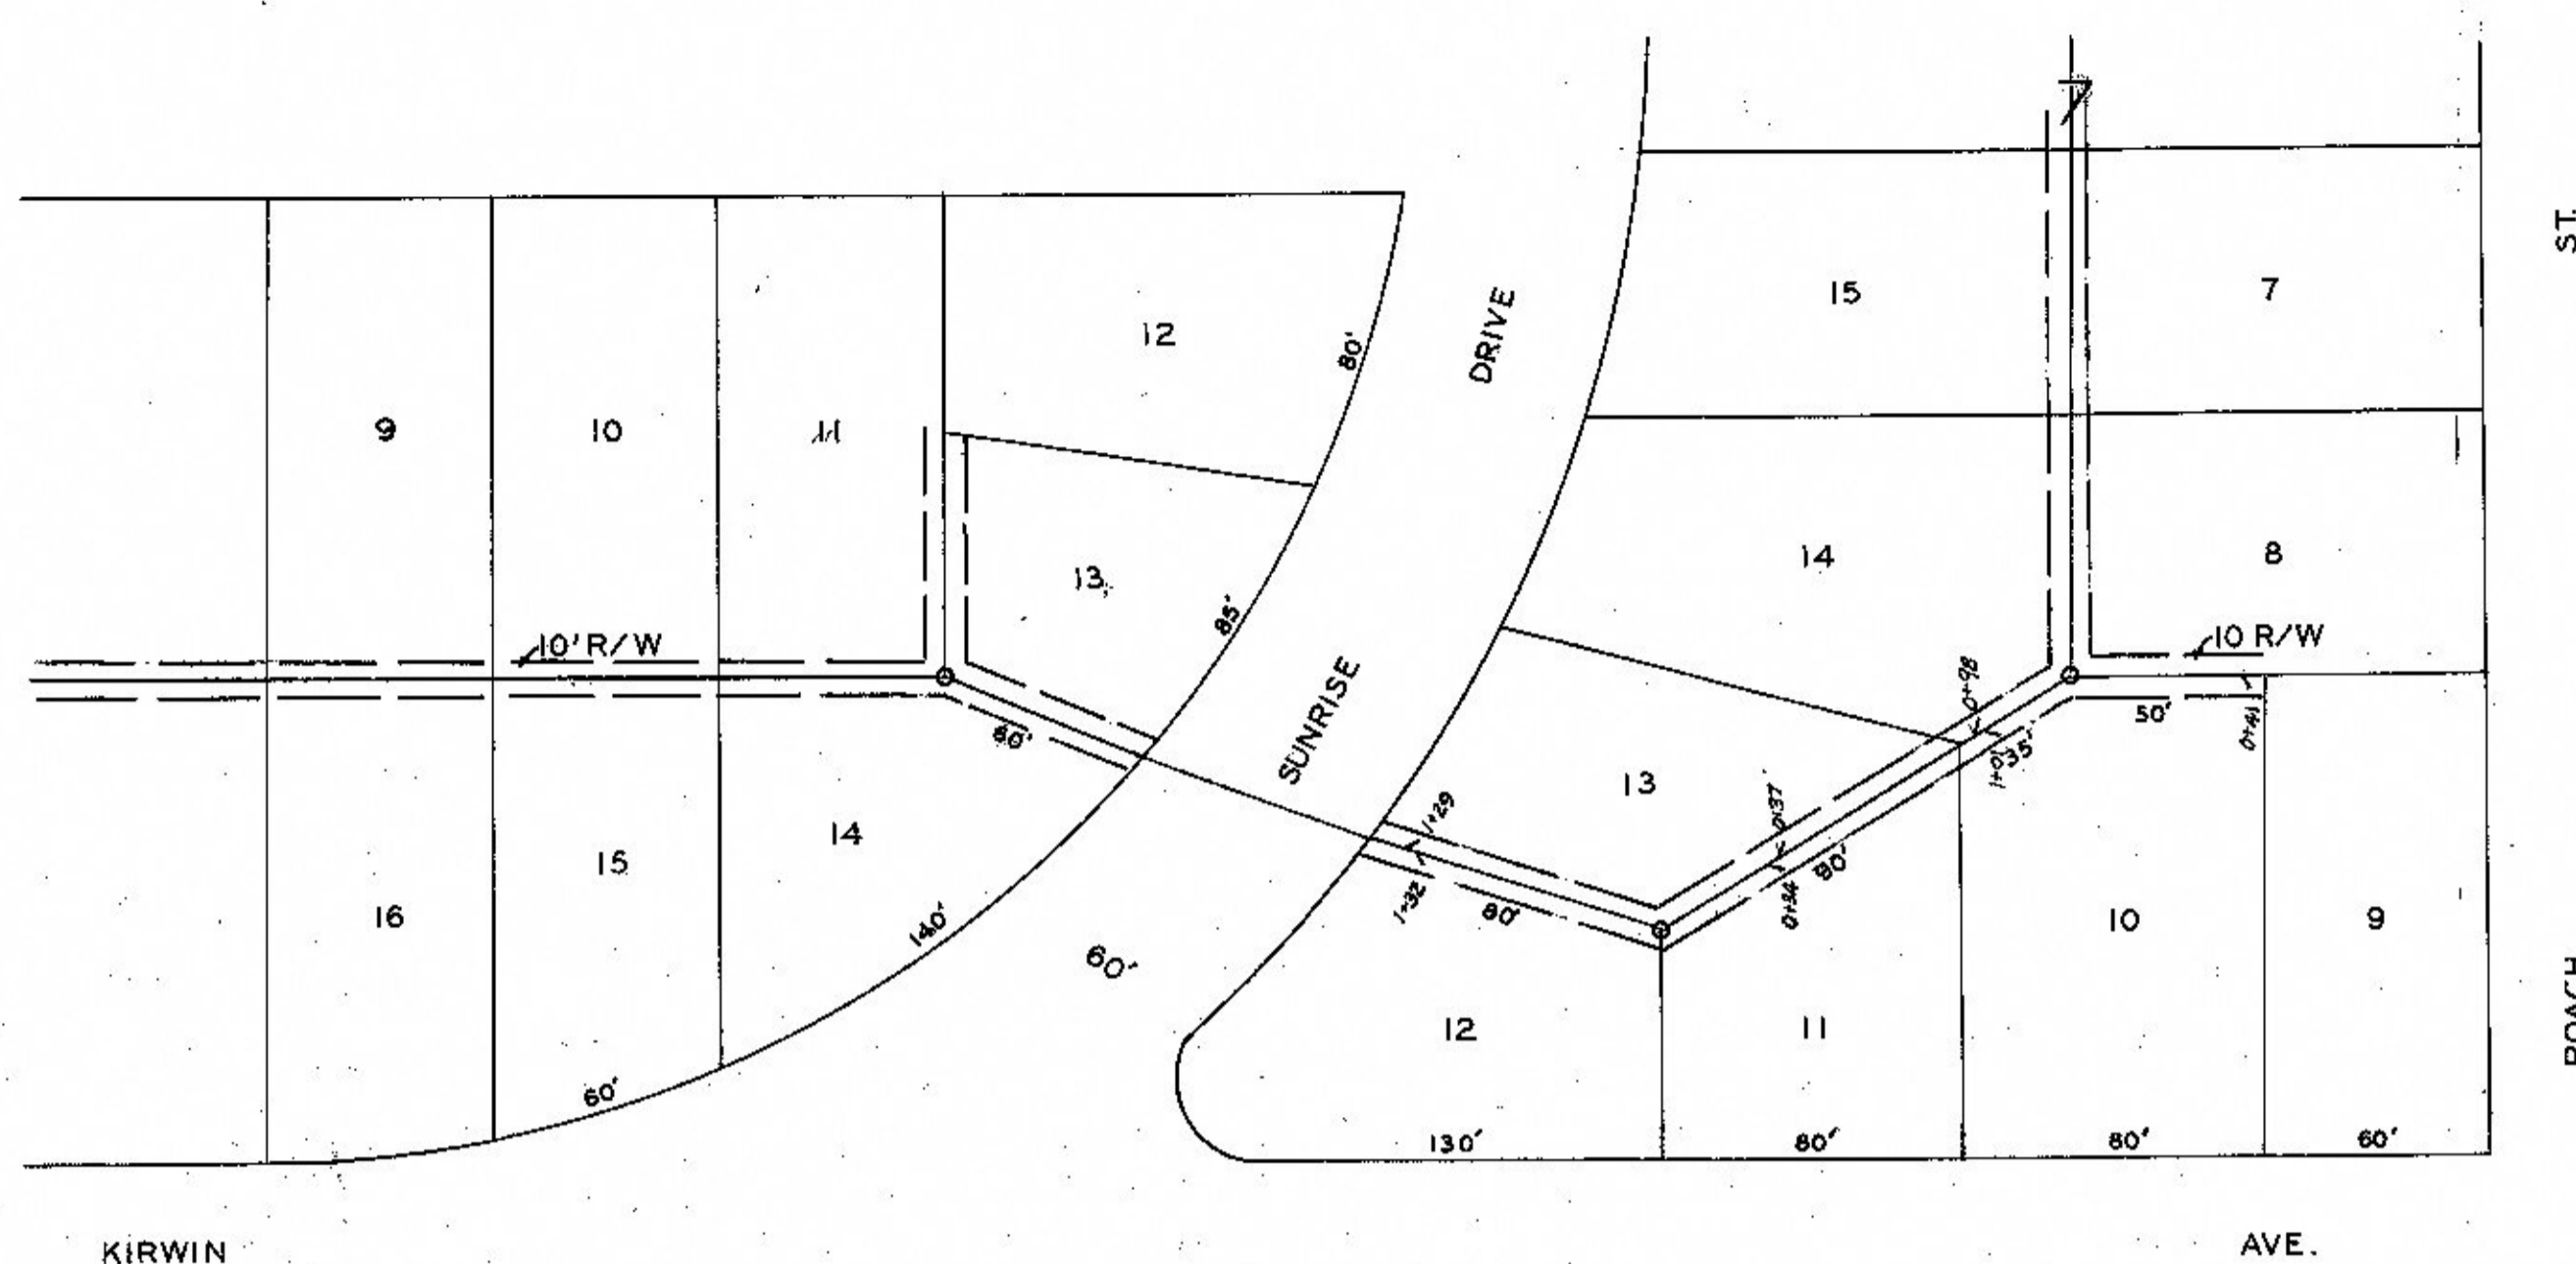

R/W N. KIRWIN FROM SUNRISE DRIVE TO ROACH

PROFILE	SURVEYED	DATE
NOTE BOOK NO.	PLOTTED	BY
	CHECKED	
	STRUCTURE NOTATION CHECKED	

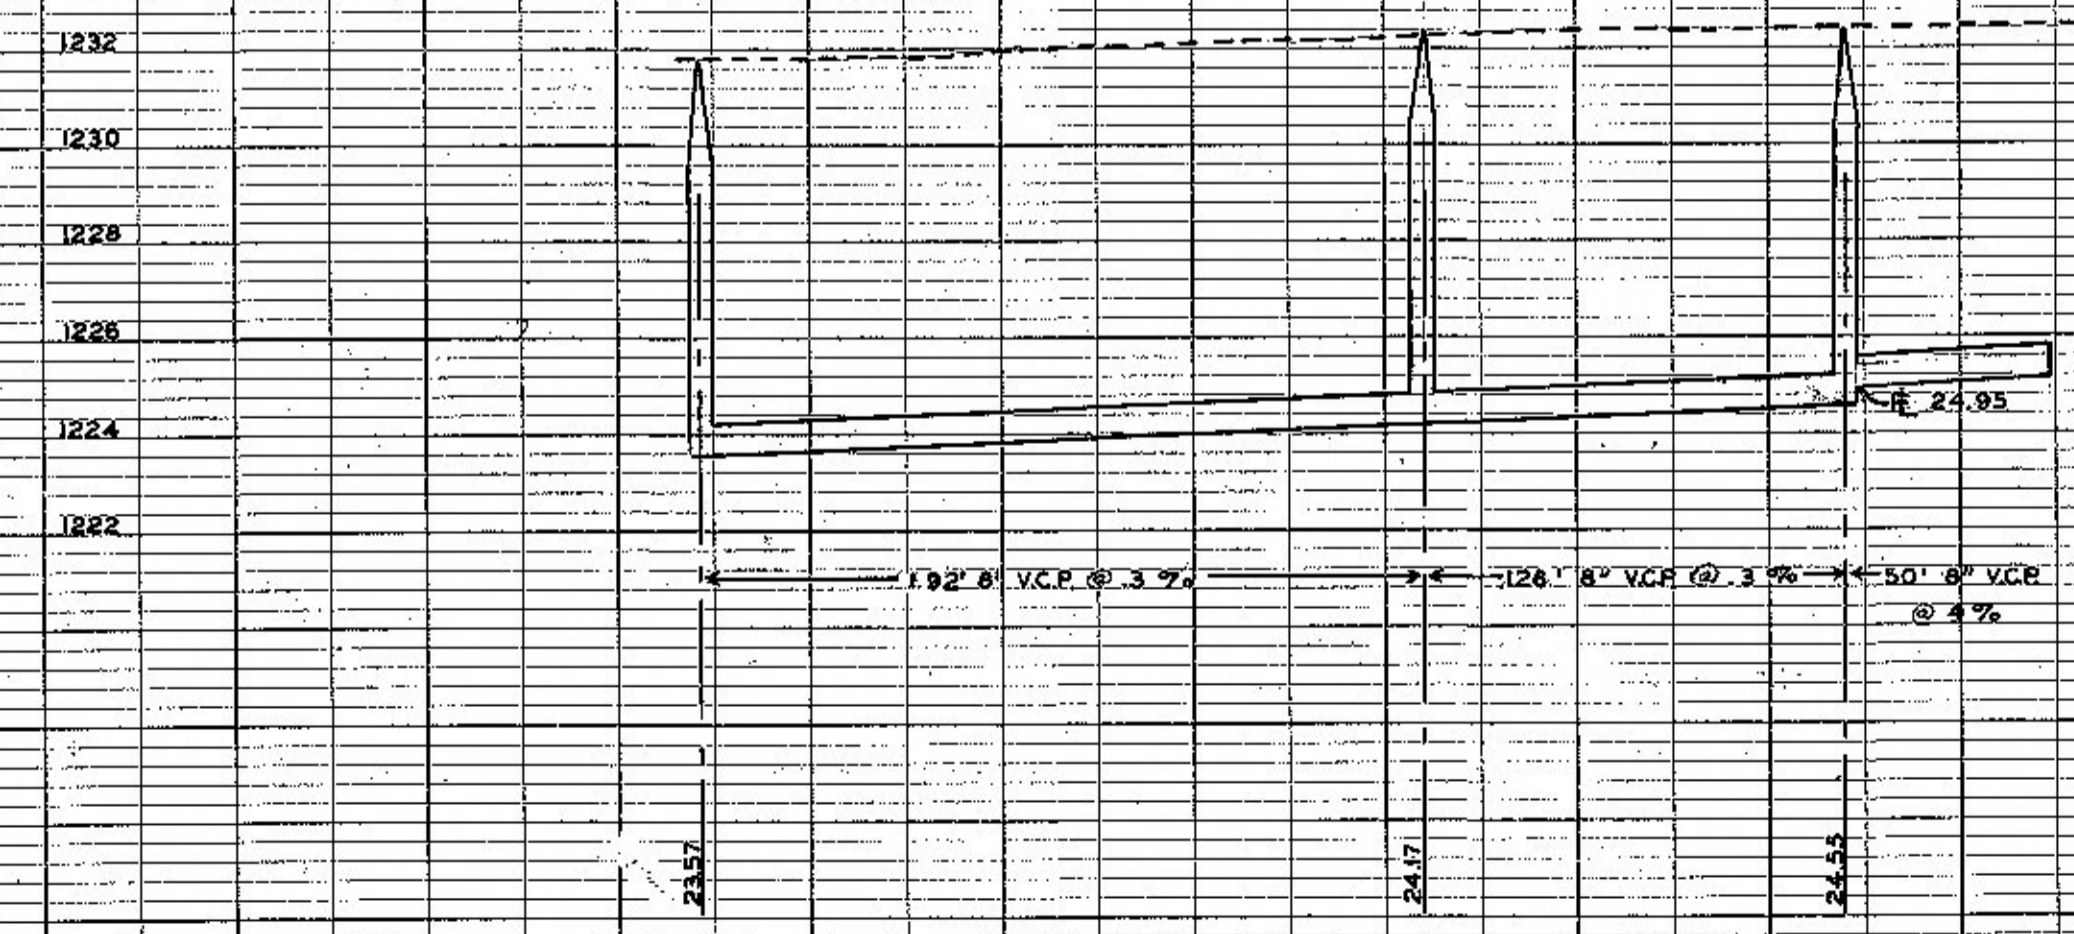

AS BUILT PLAN
 Constructed Feb. 3, 1931
 By
 H. J. TAYLOR & CONST. CO.
 Salina, Kans.