


209

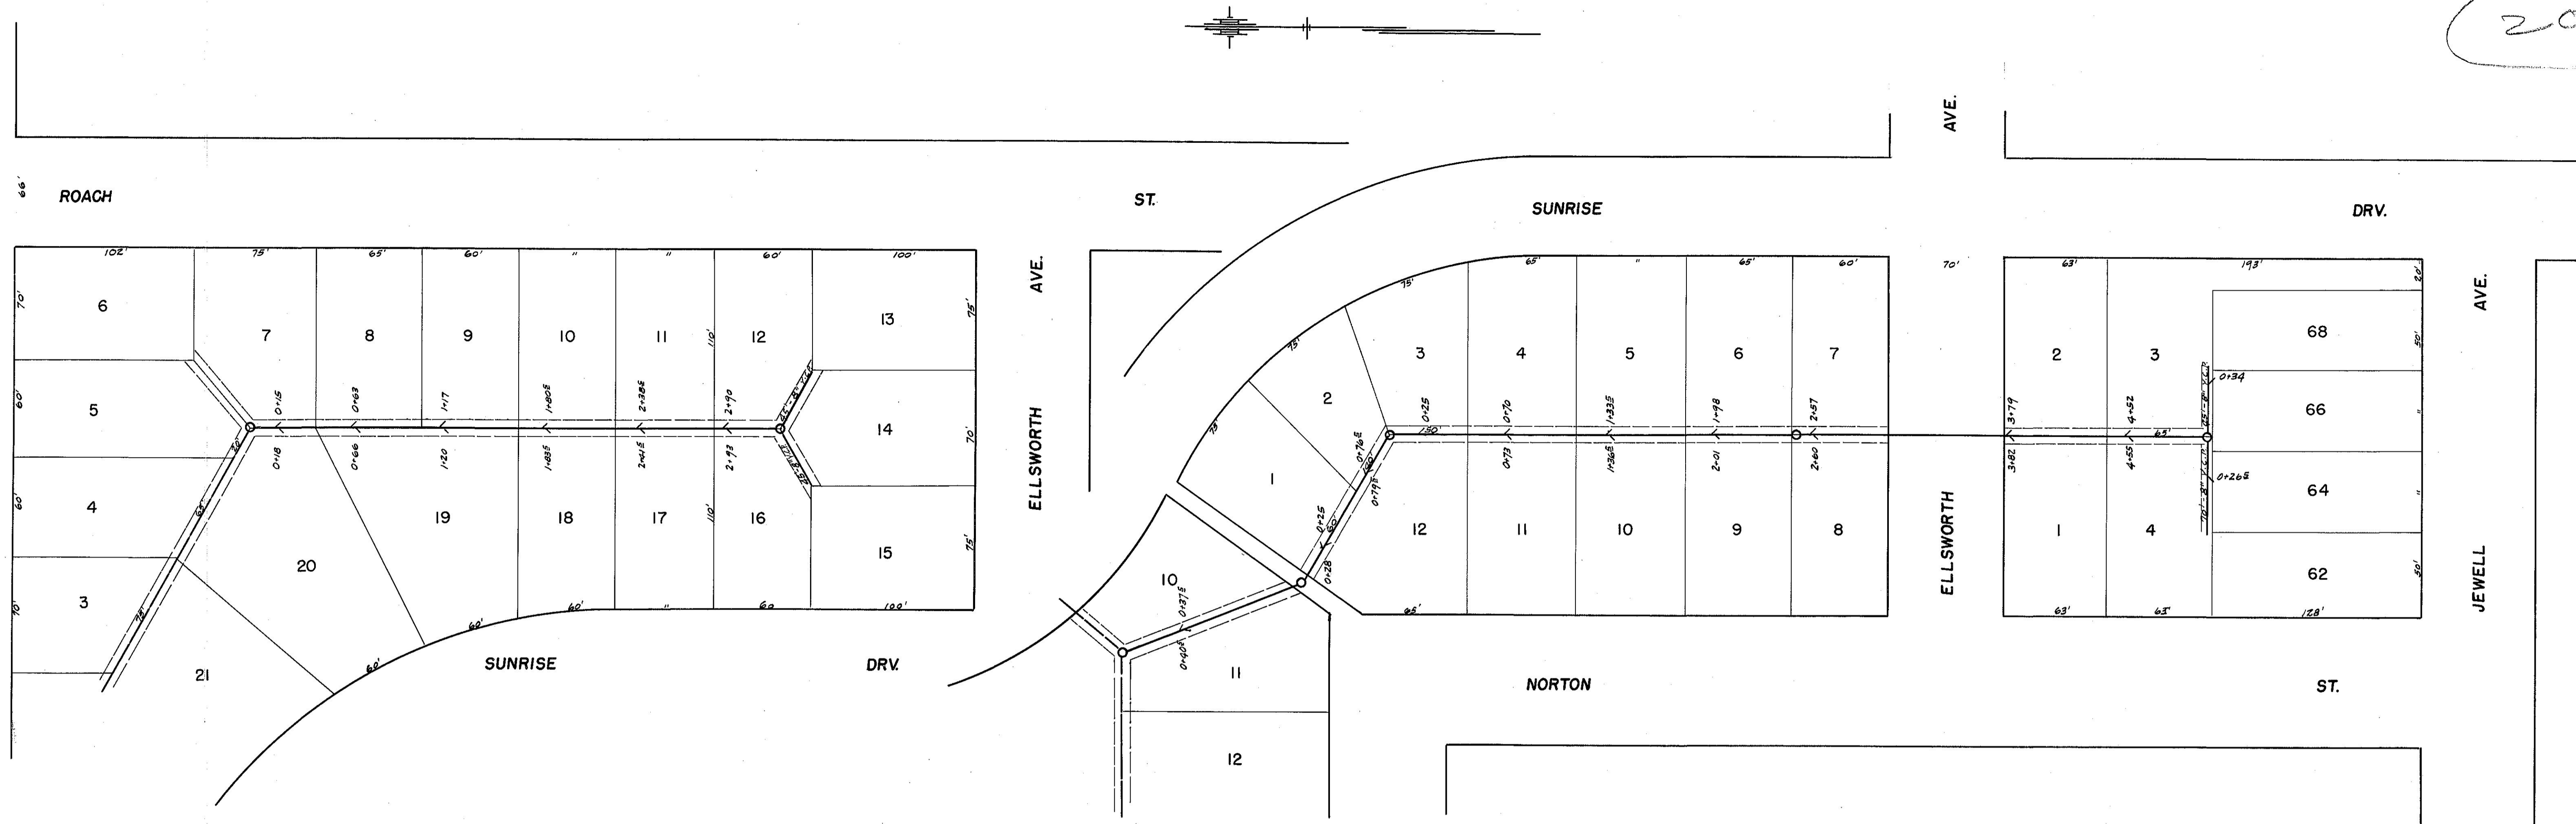


R/W E/ SUNRISE DRIVE FROM BELOIT TO ELLSWORTH


R/W E. OF NORTON FROM BELOIT TO JEWELL

'AS BUILT PLAN'
 Constructed May 1951
 by
 H. J. TAYLOR CONST Co.
 Salina, Kansas

John F. Burtles June 20, 57

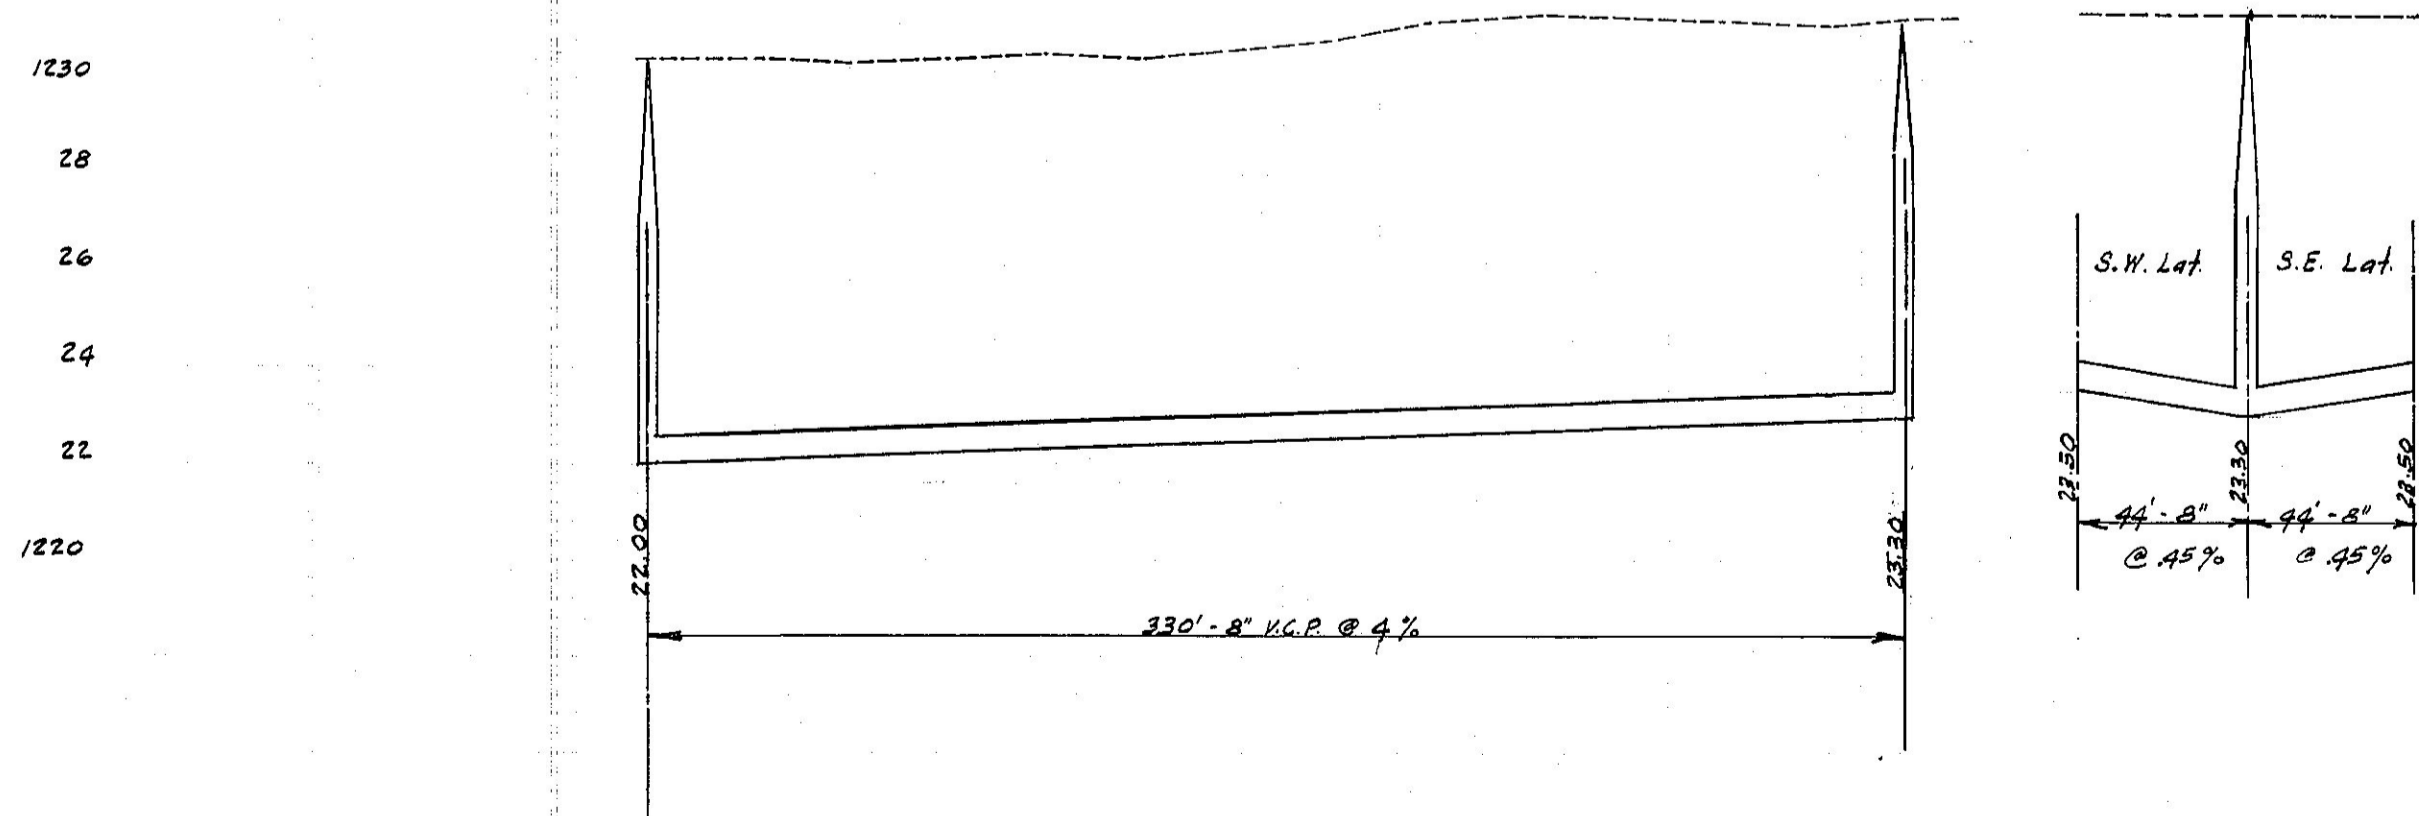

LAT. SWR. 260

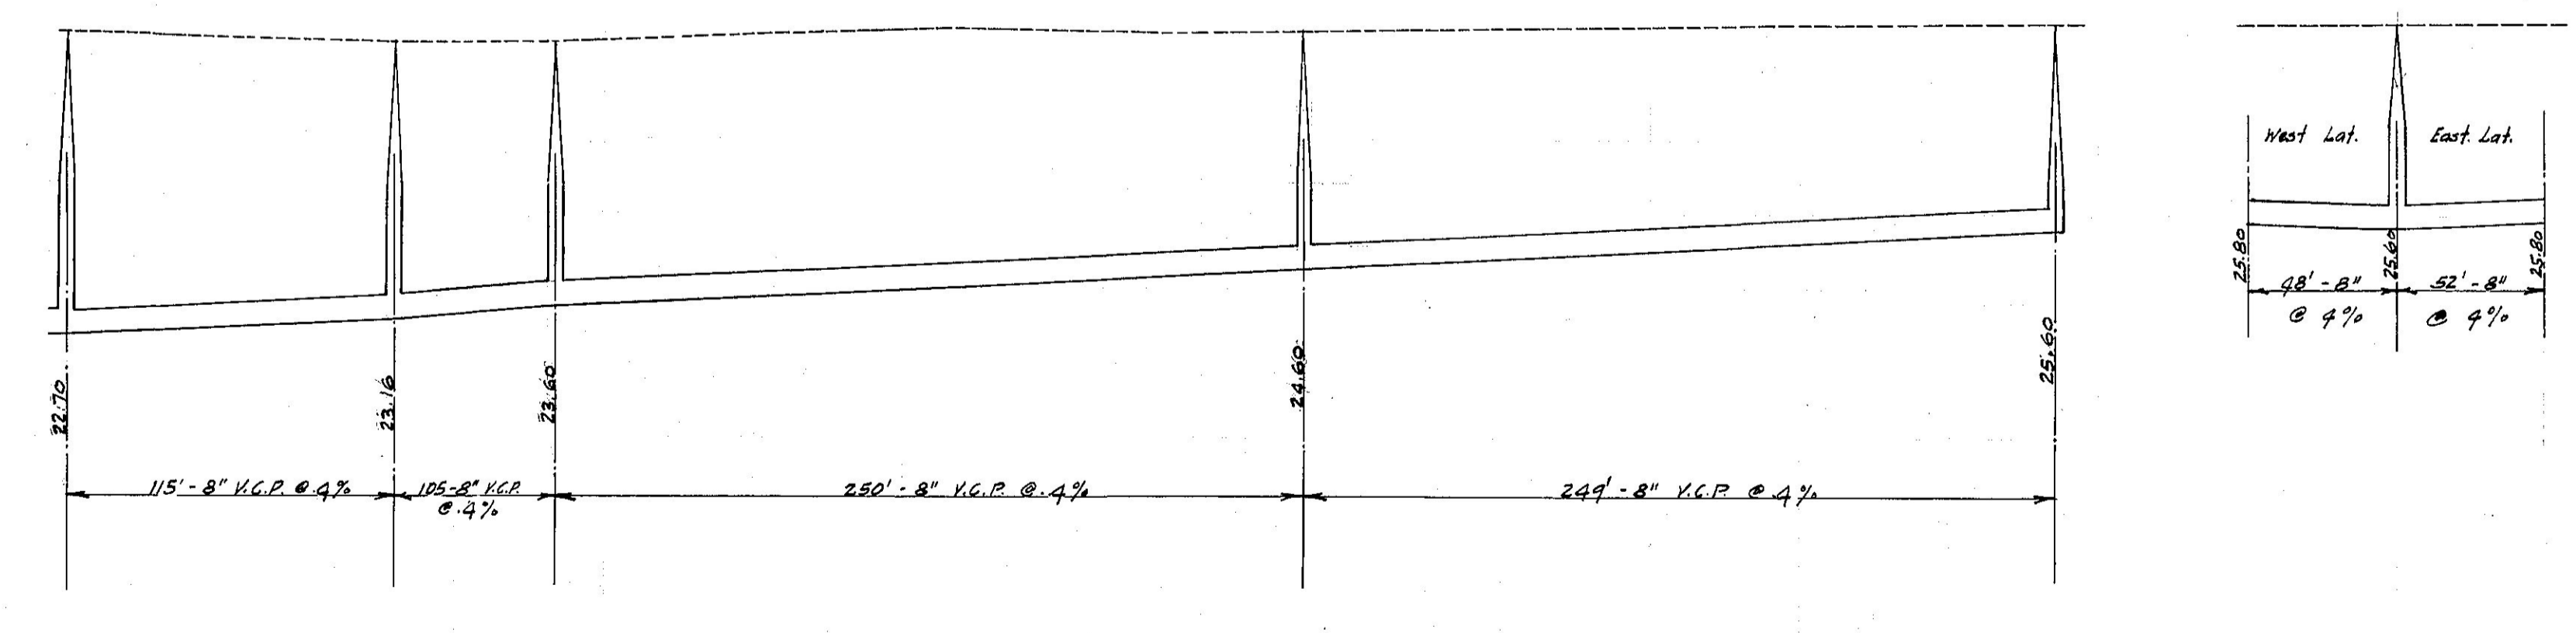

LAT. SWR. 261