



R/W N. MARTIN — SUNRISE TO ROACH  
July 31, 1951

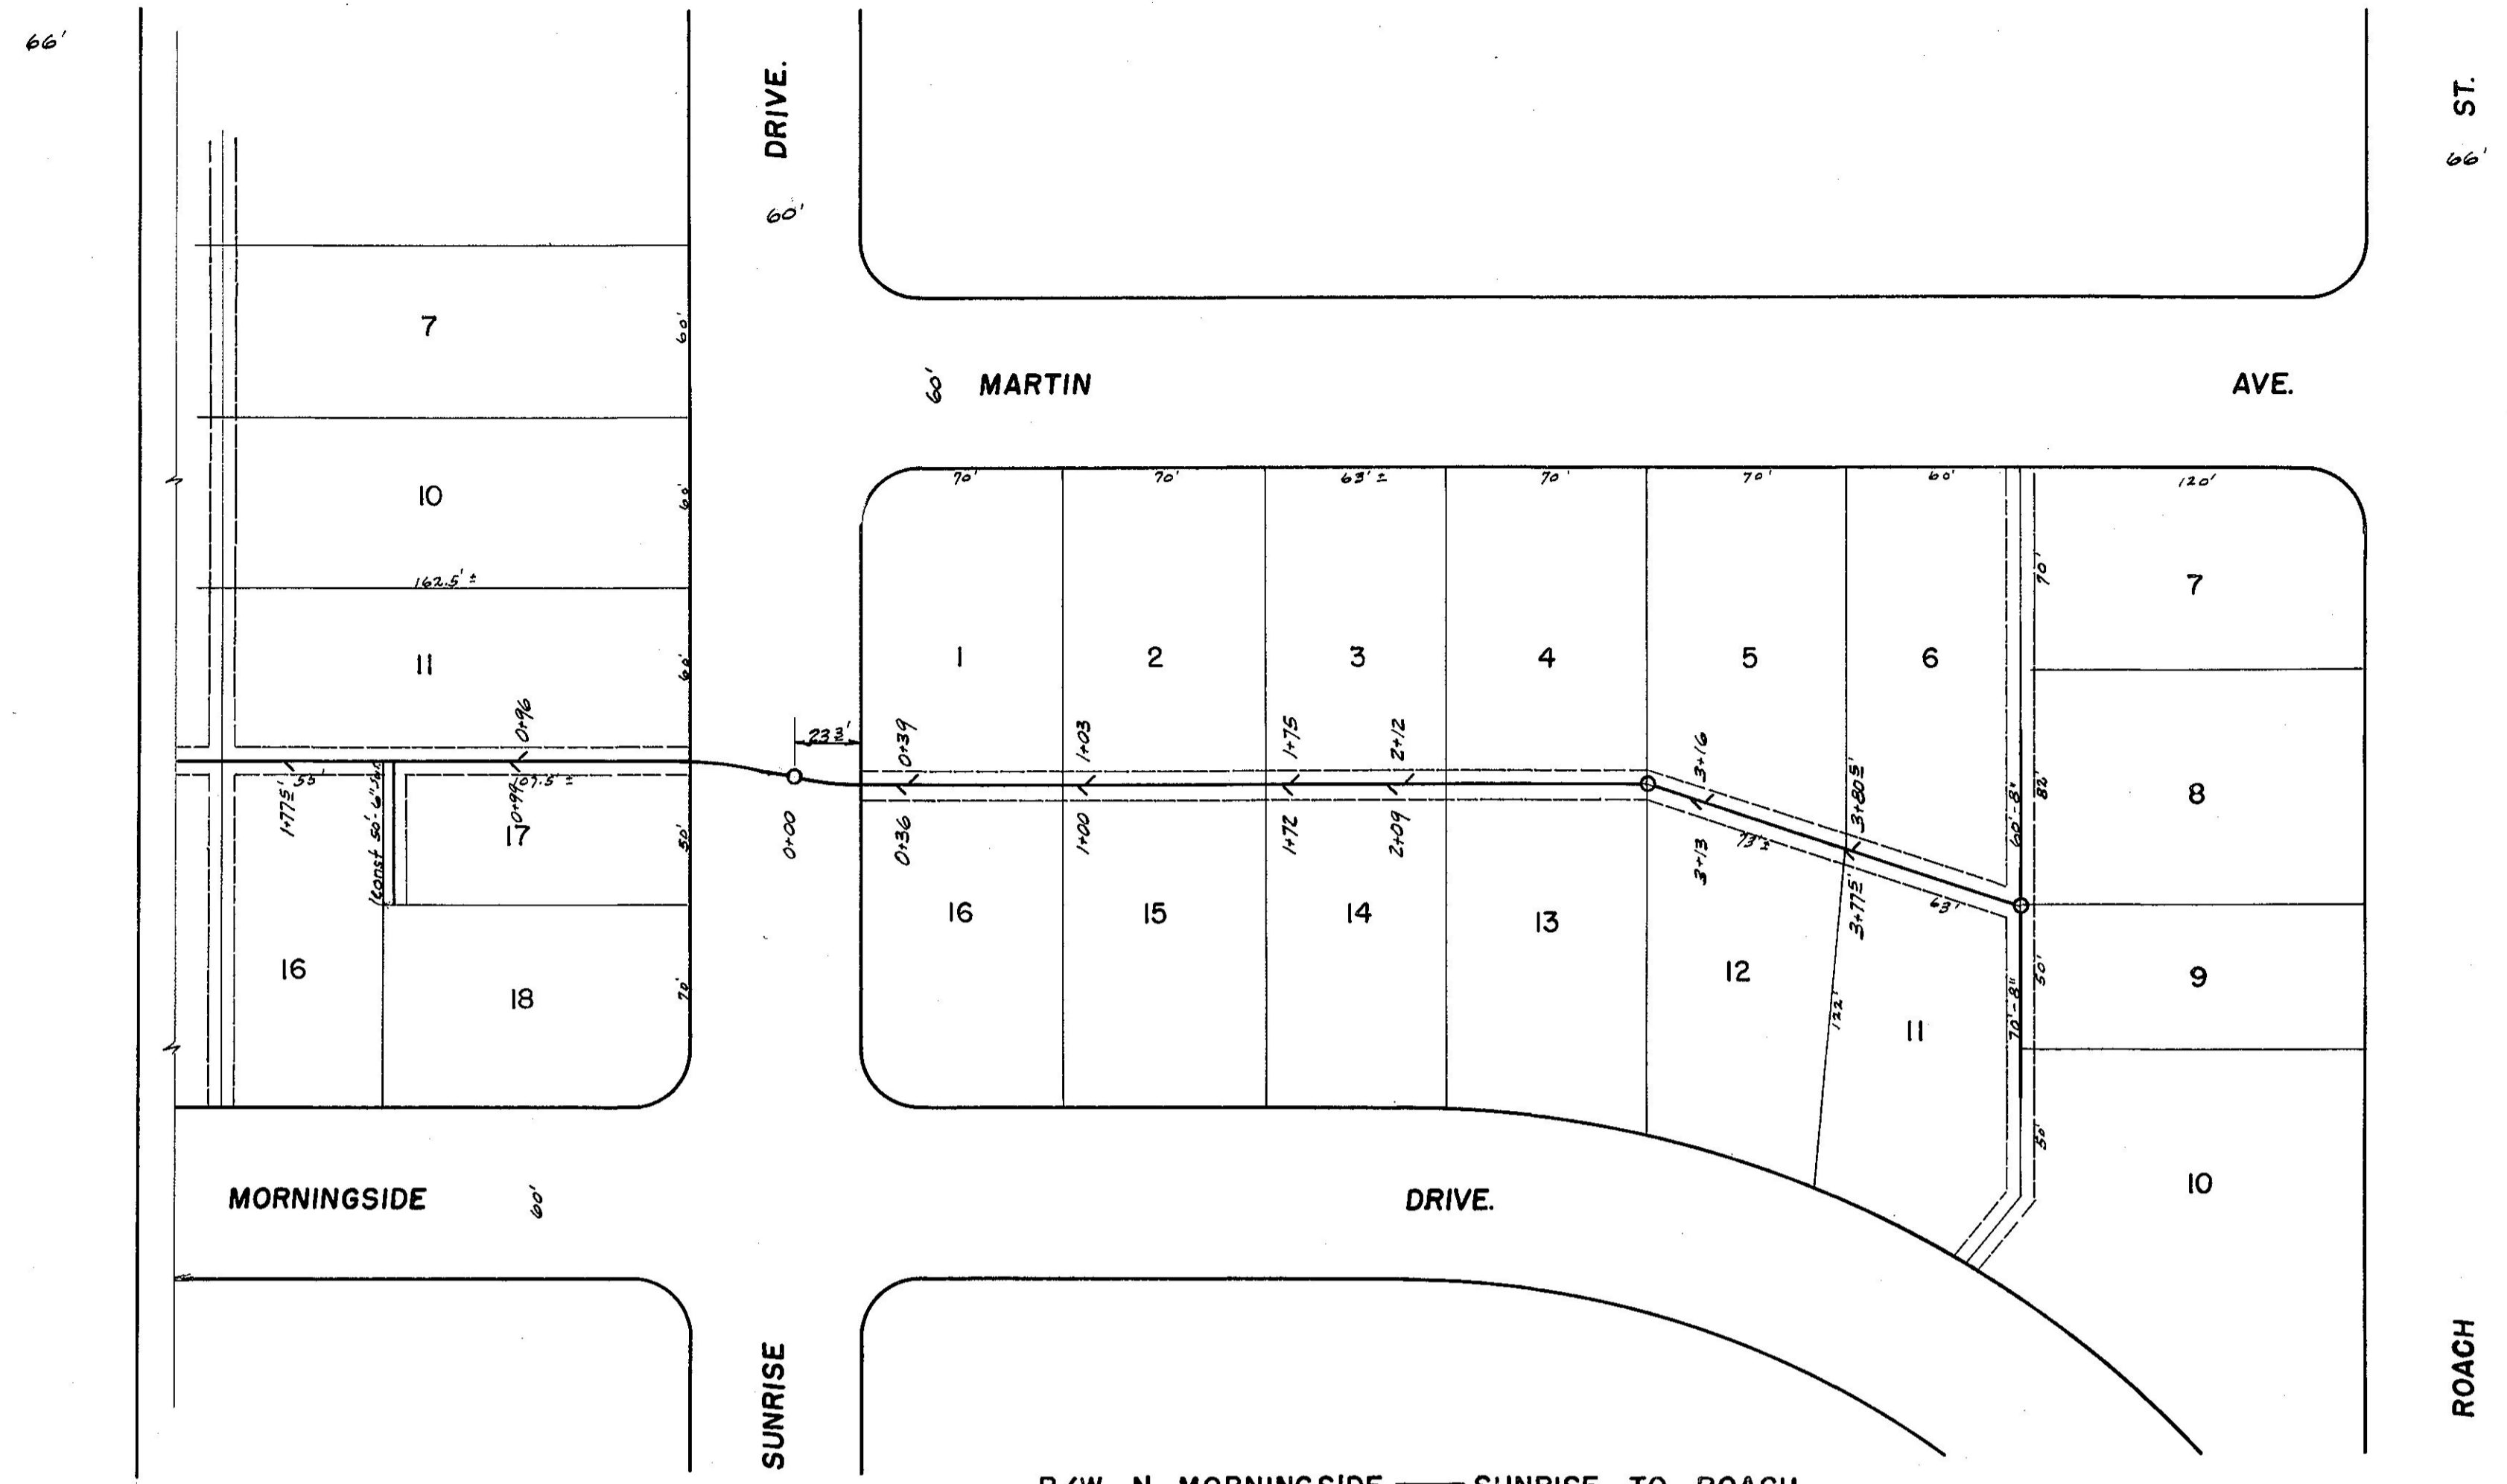


R/W N MORNINGSIDE — SUNRISE TO ROACH  
Aug 11, 1951

210

"AS BUILT PLANS"  
By:  
H. J. TAYLOR, CONST. CO.  
SALINA, KANT.

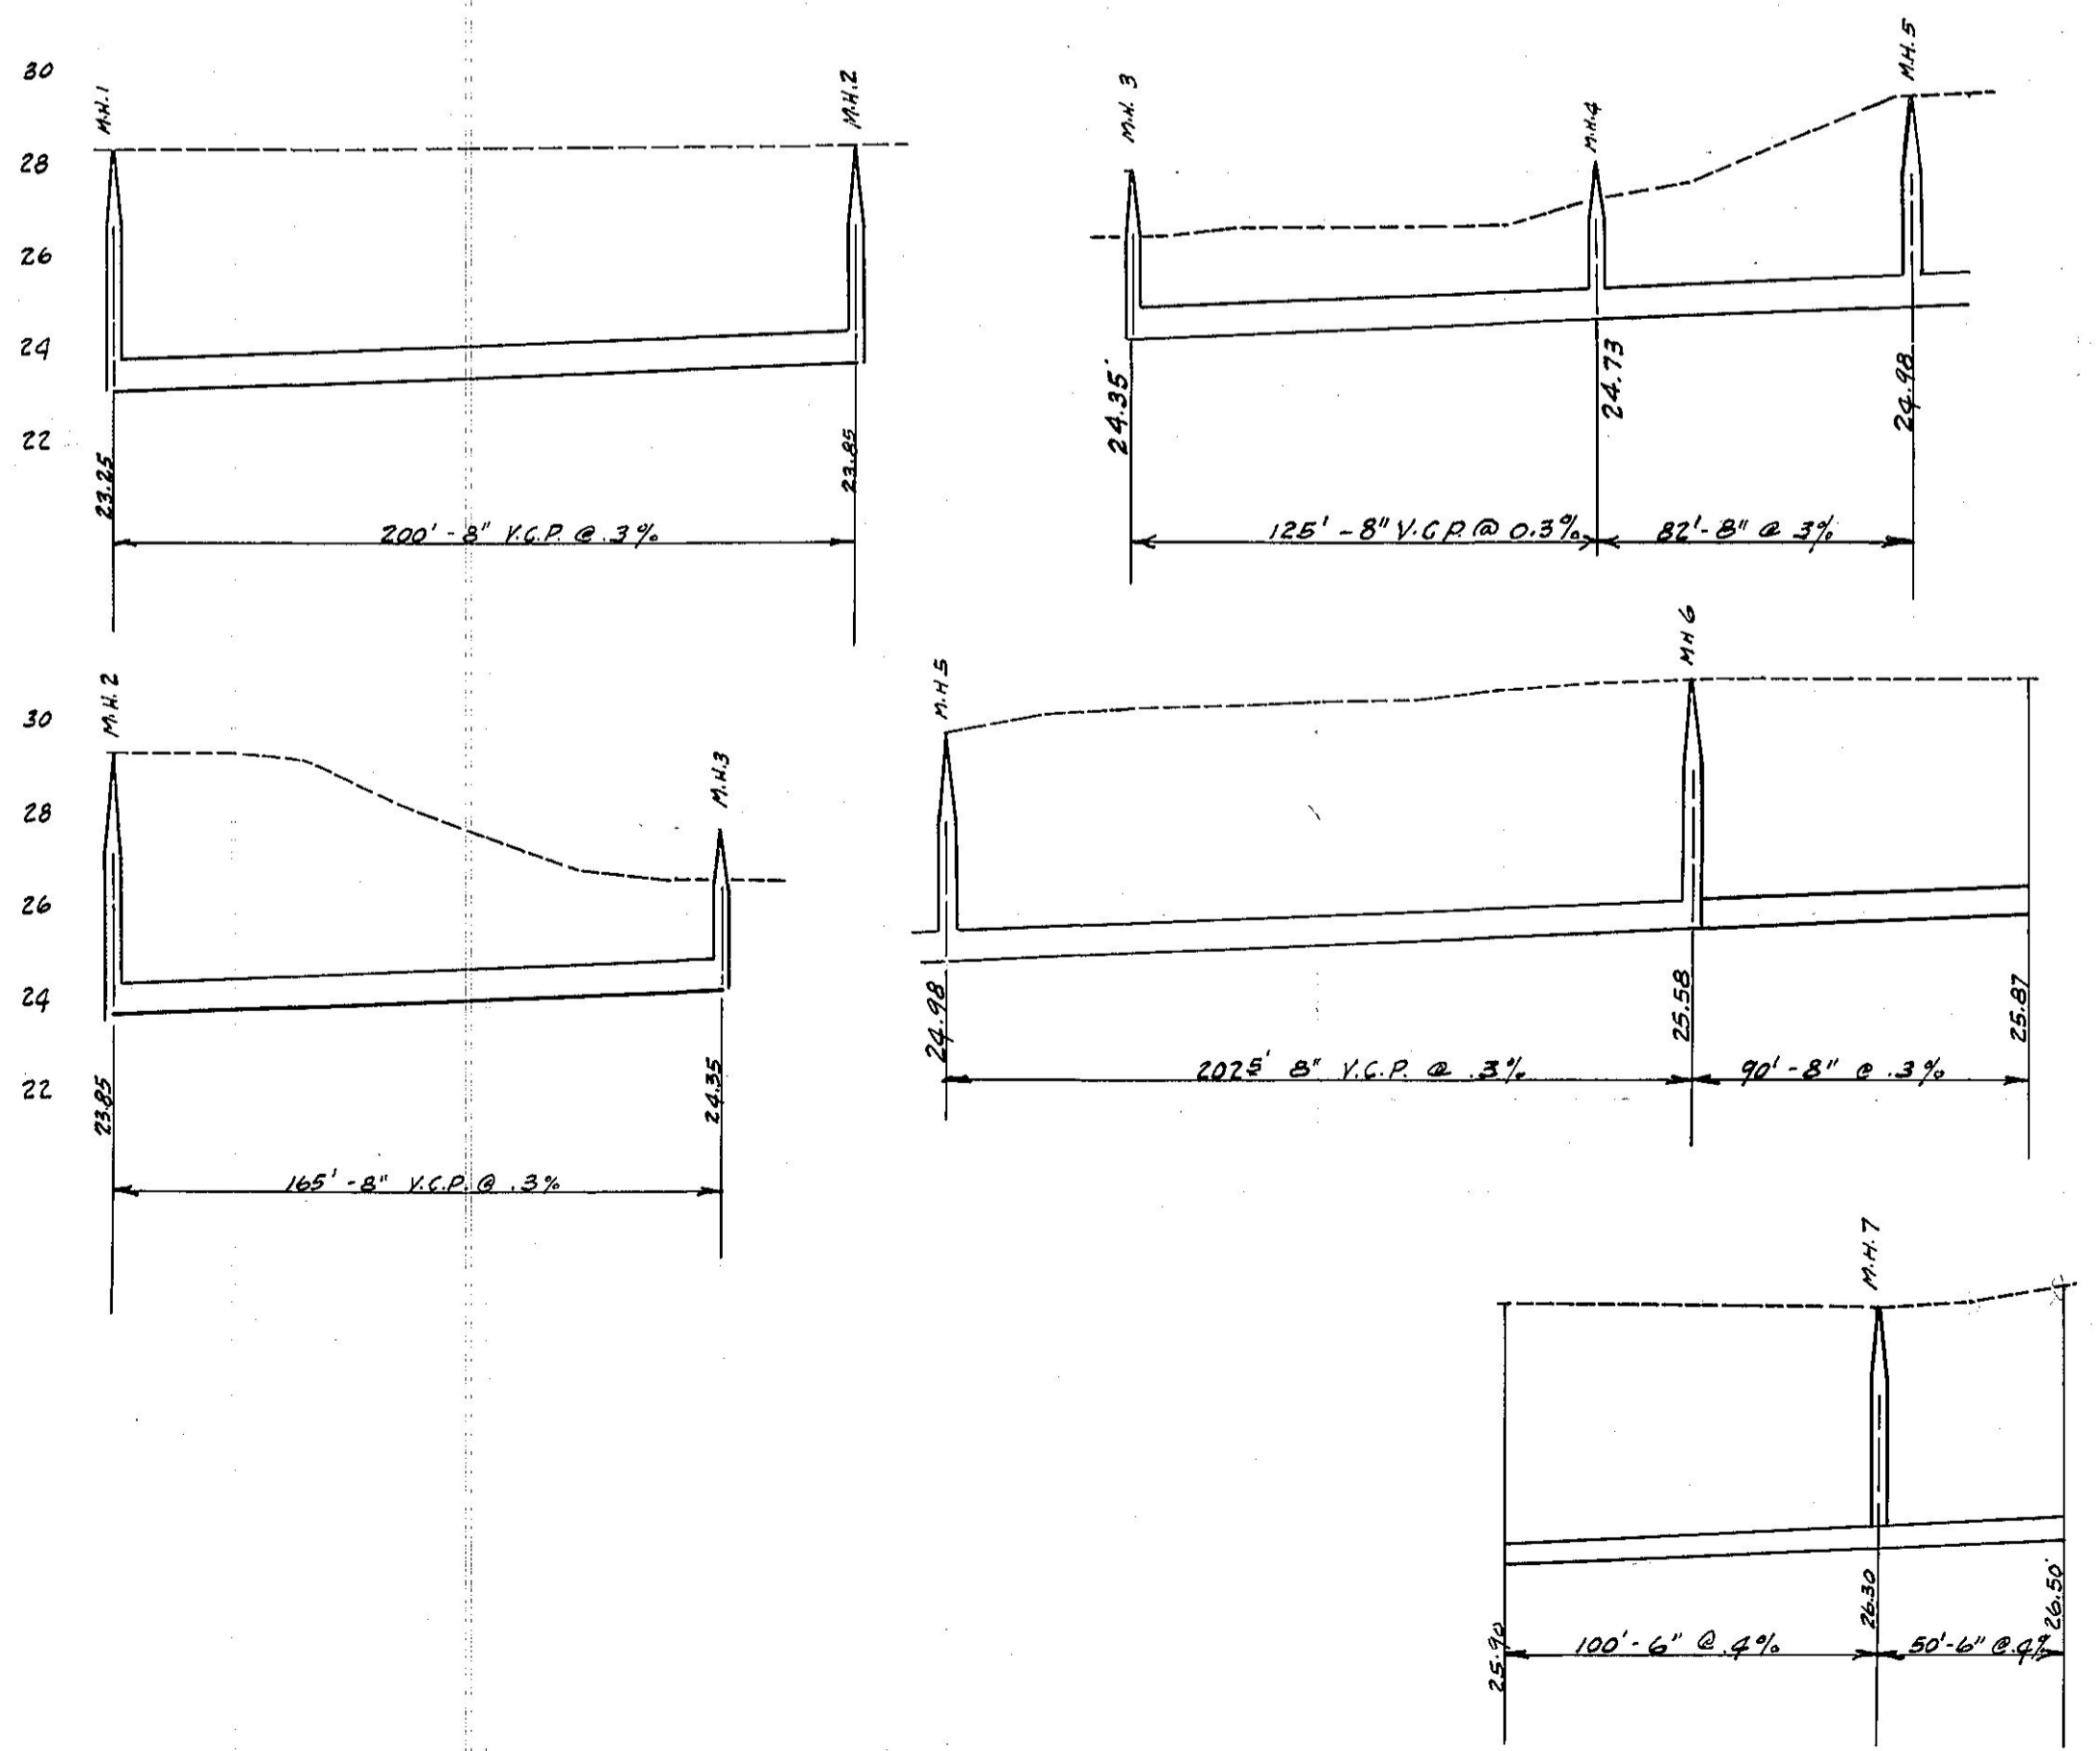

LAT. 263

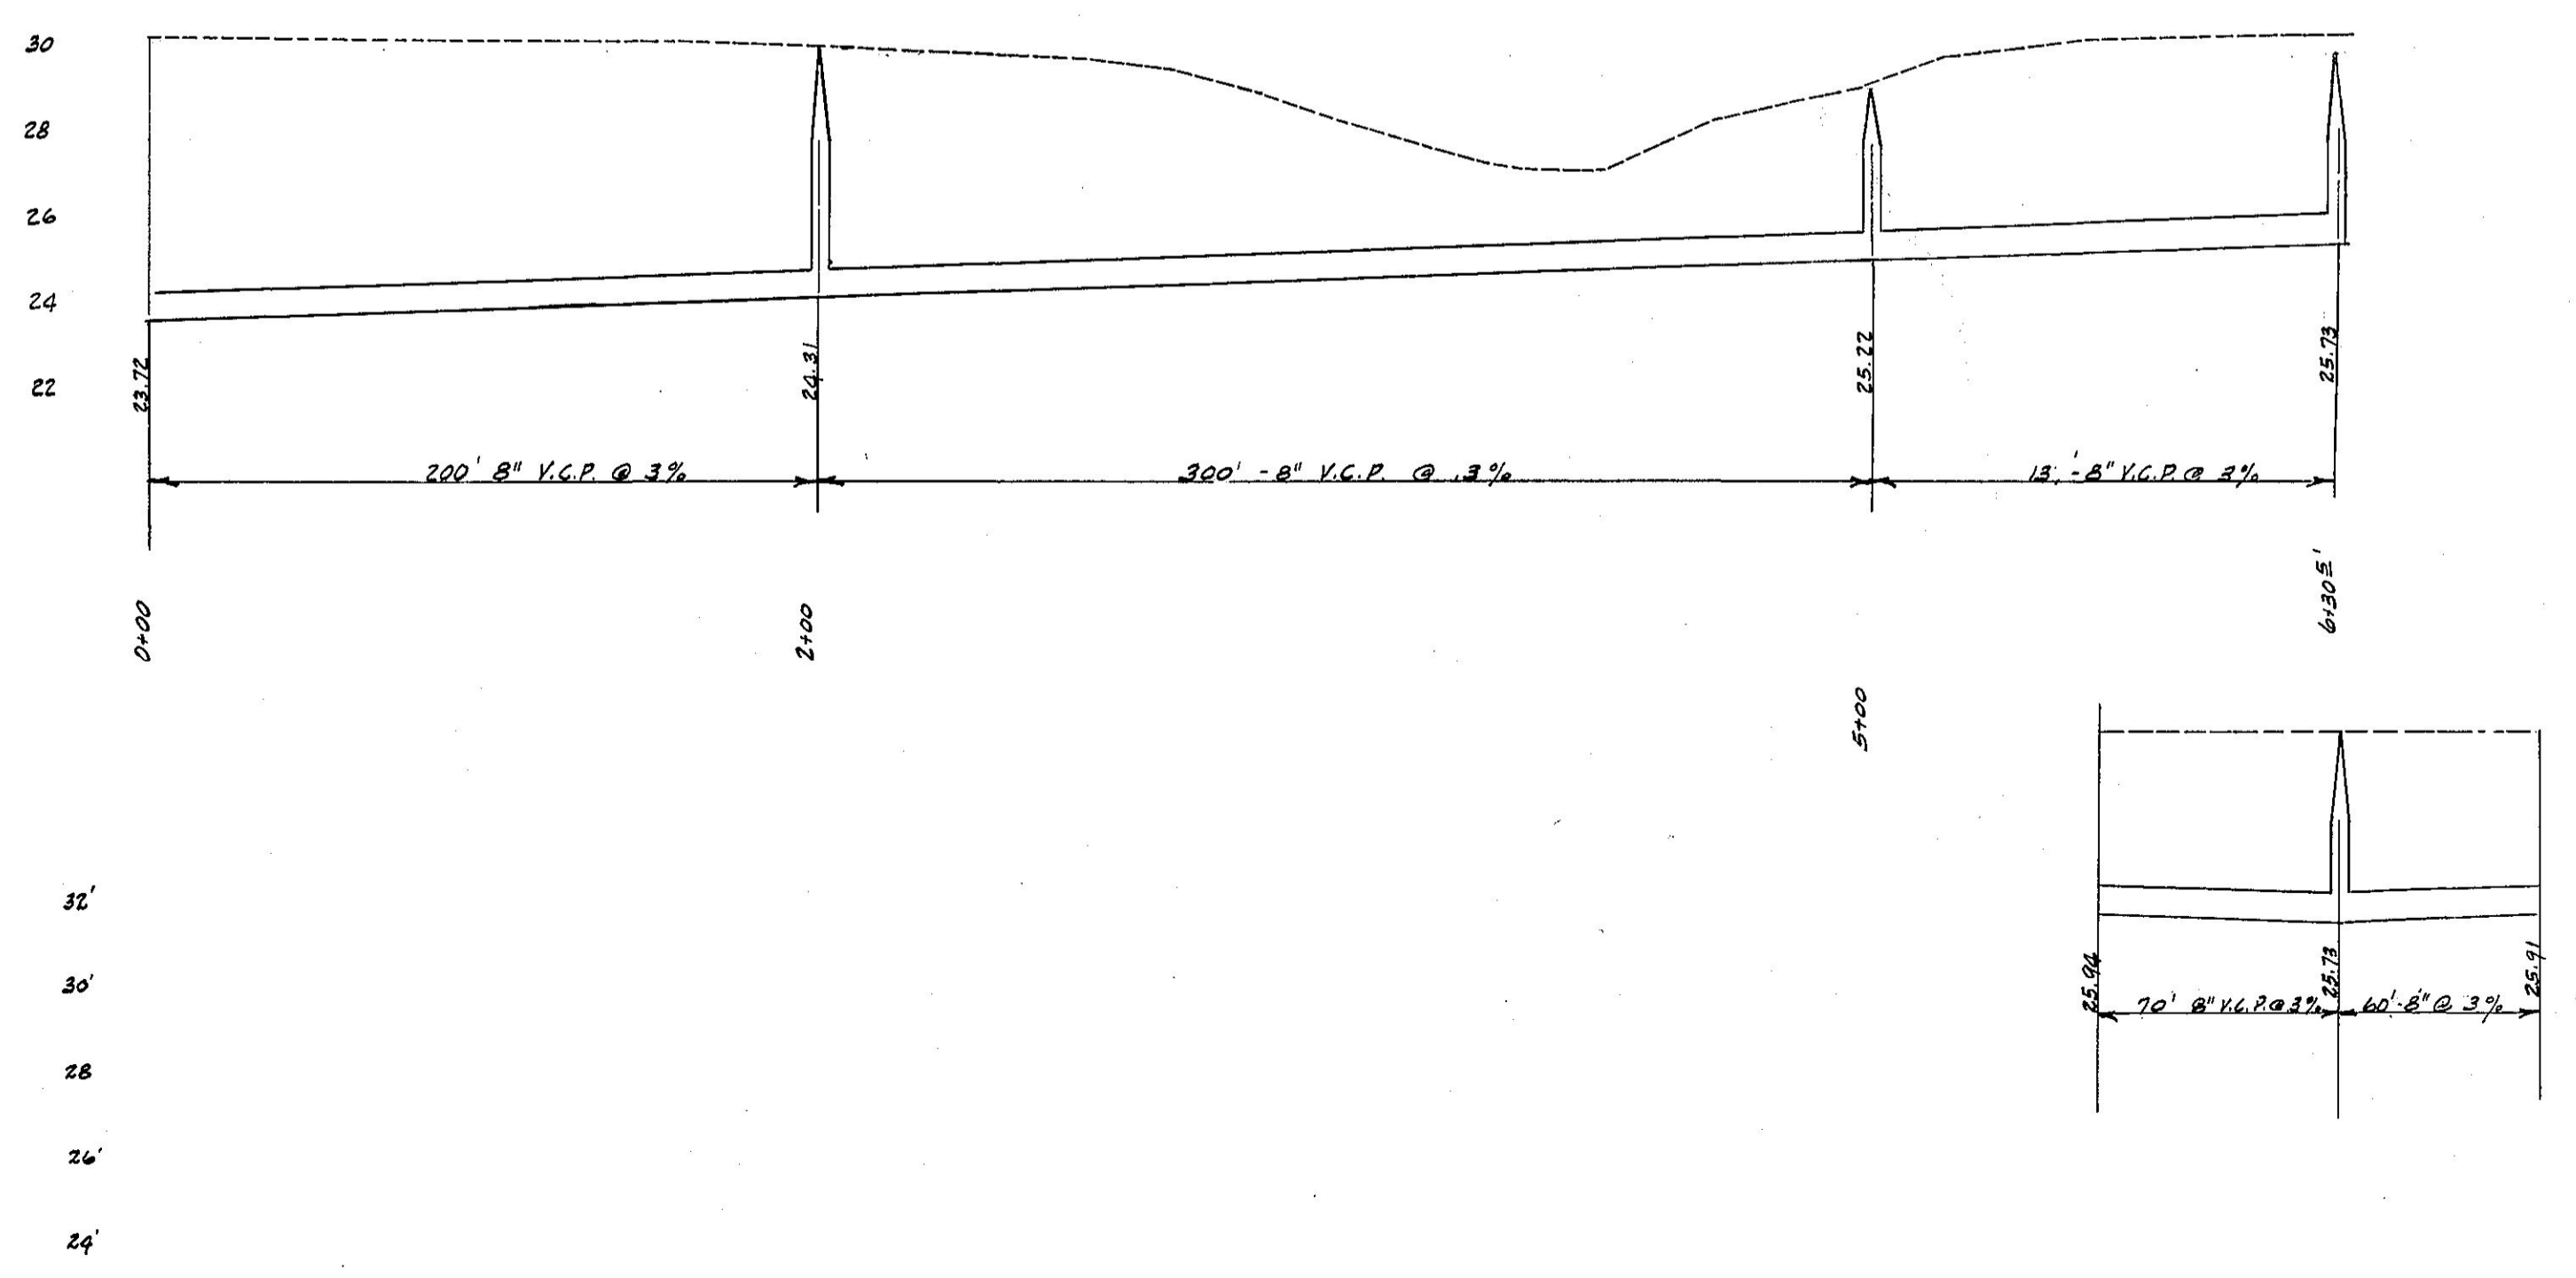

LAT. 262