


211


PLAN	SUPPLIED	DATE
REVISION	BY	
NOTED	BY	
NO.		

PROFILE	SUPPLIED	DATE
REVISION	BY	
NOTED	BY	
NO.		

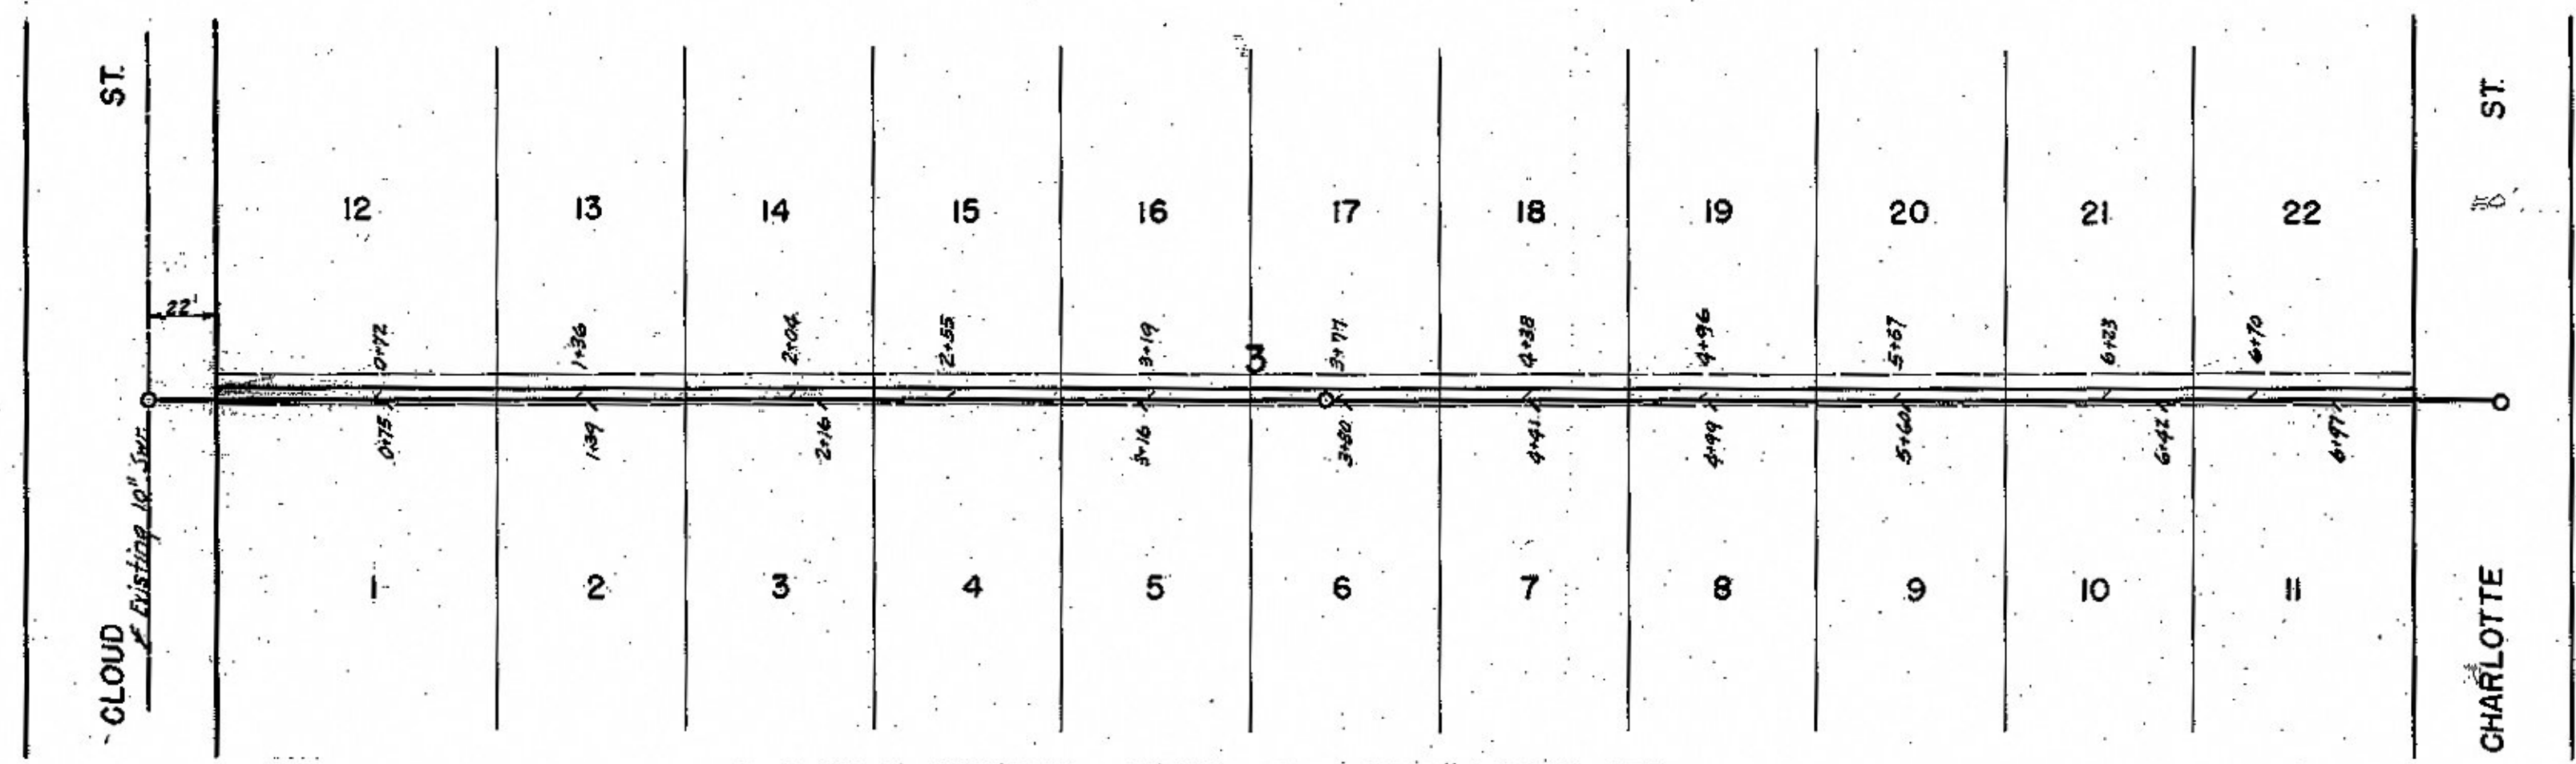


R/W E. SIMMONS FROM CLOUD TO CHARLOTTE

AS BUILT PLAN
CONSTRUCTED MAY 1951
BY
H. J. TAYLOR, CONSULTING
SALINA, KANS.

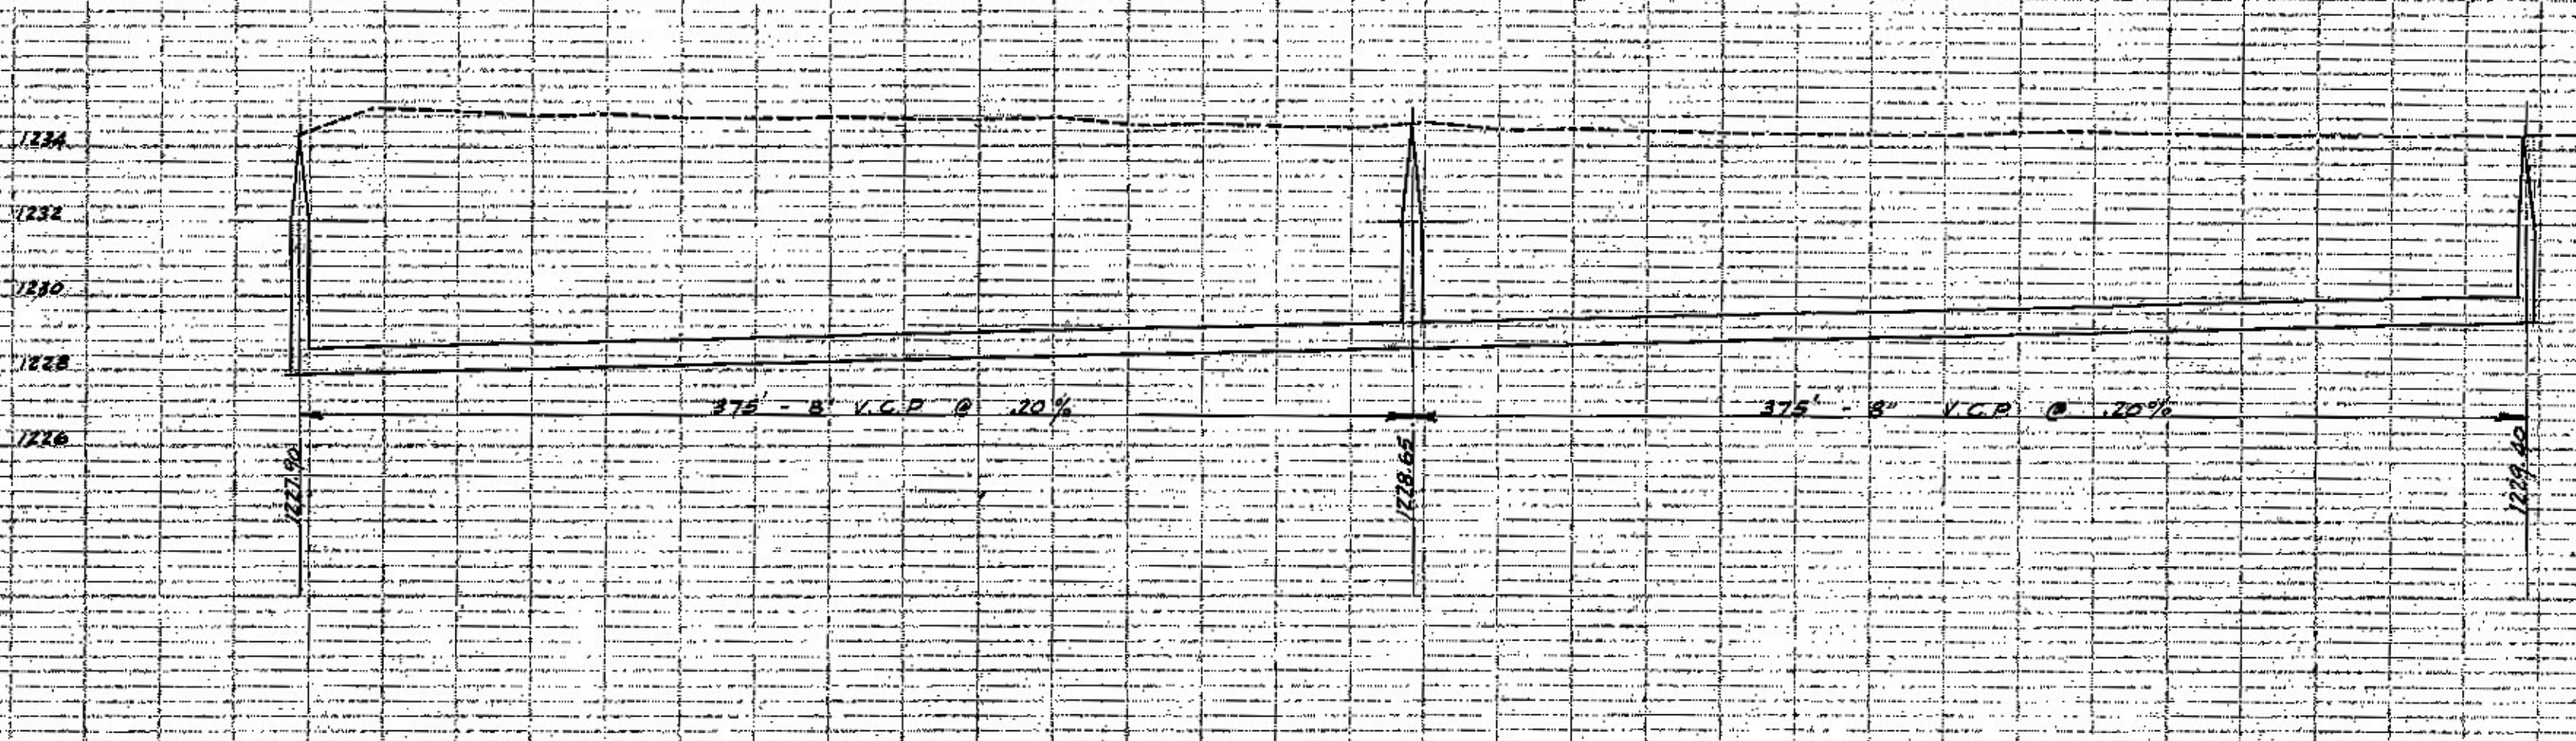


LATERAL 264

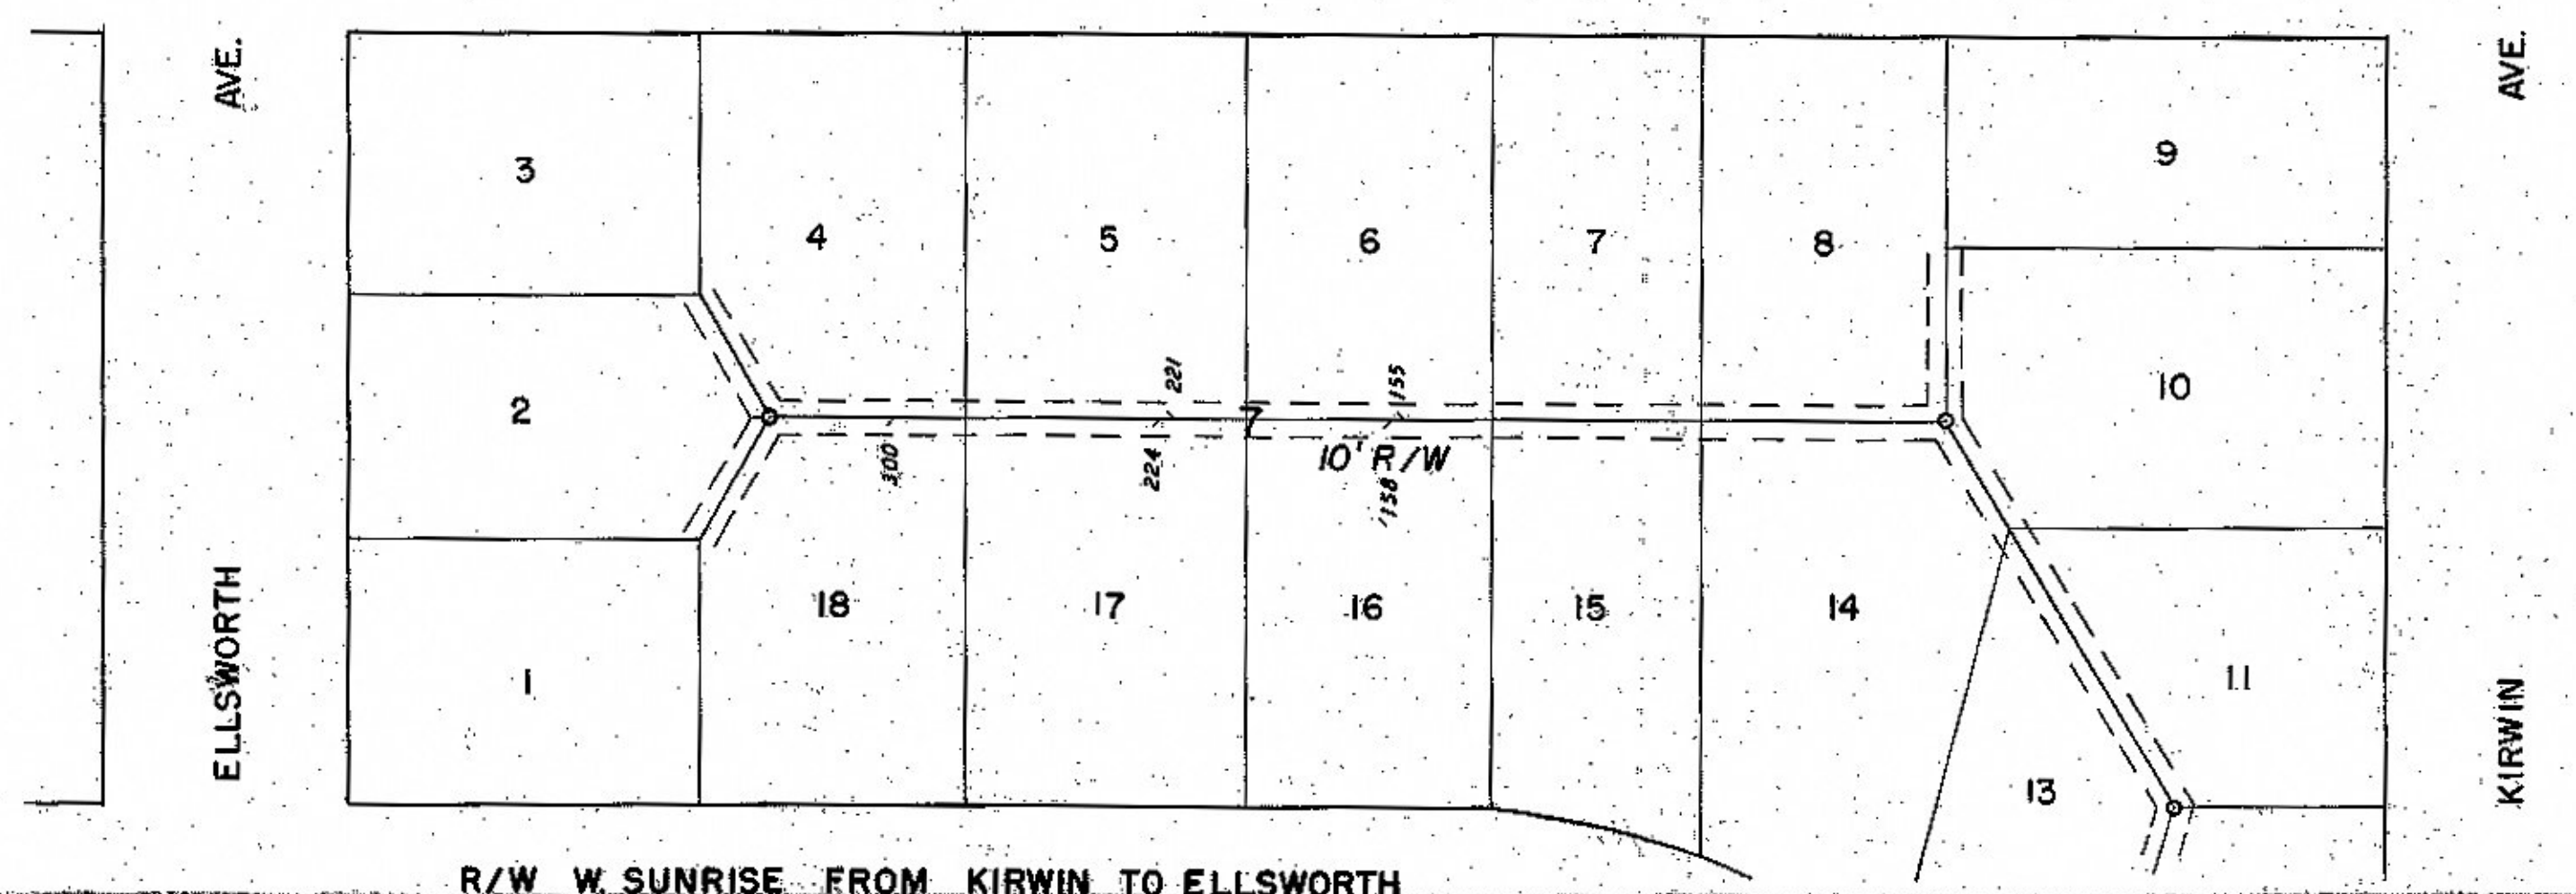

R/W W. SUNRISE FROM KIRWIN TO ELLSWORTH

AS BUILT PLAN
CONSTRUCTED NOV 1951
BY
O. D. WILMOTH

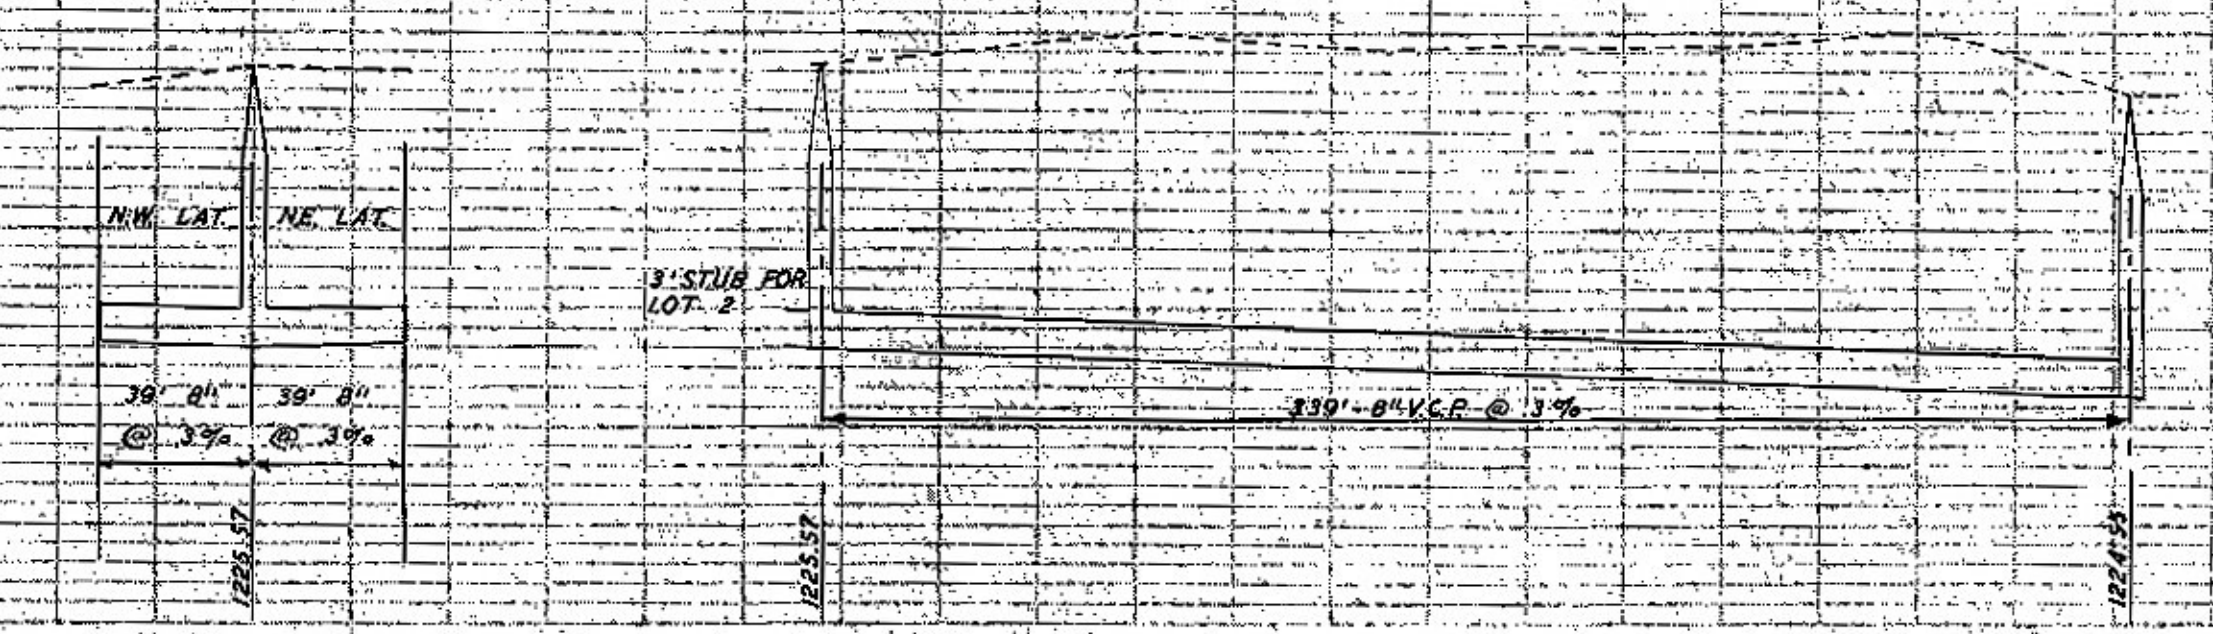

LATERAL 265