
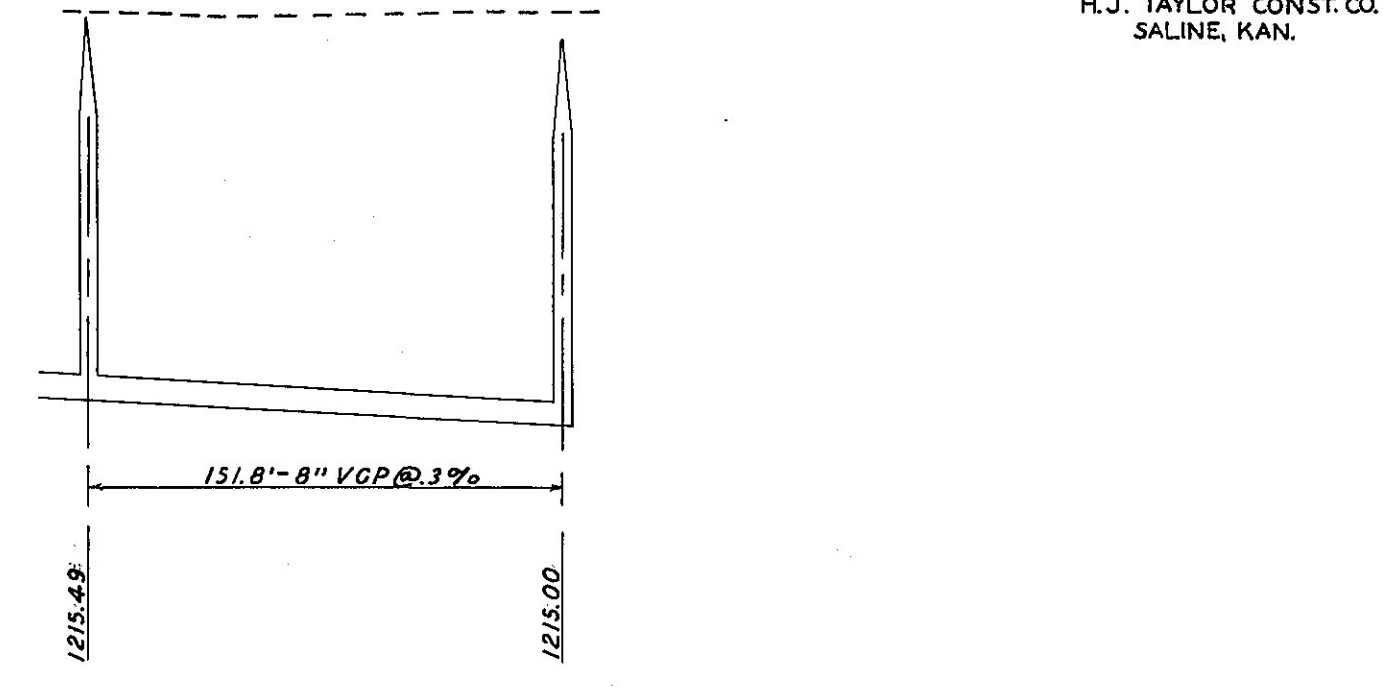
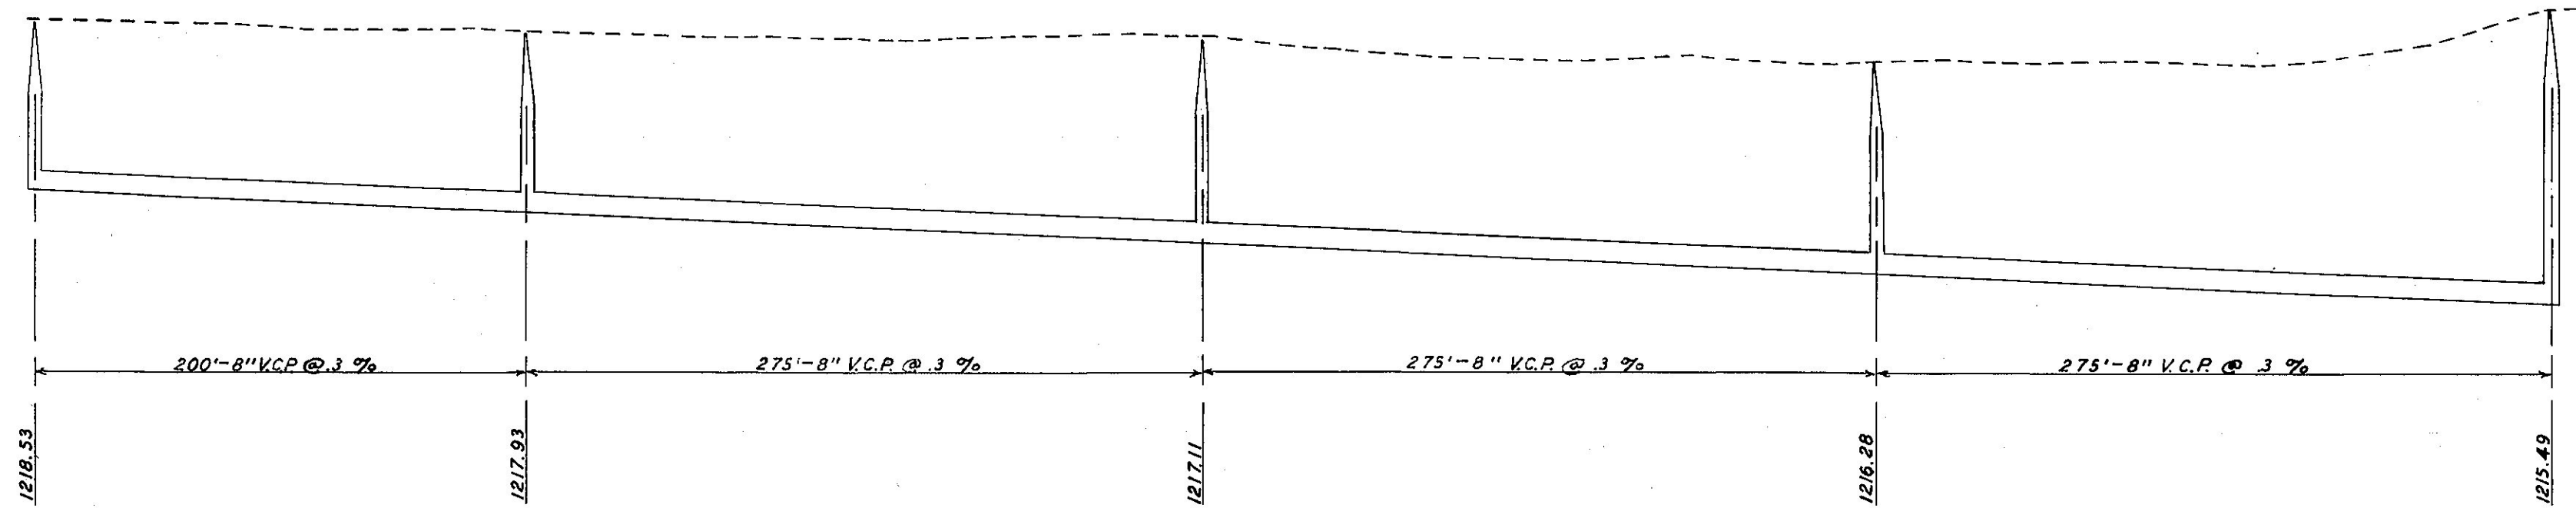
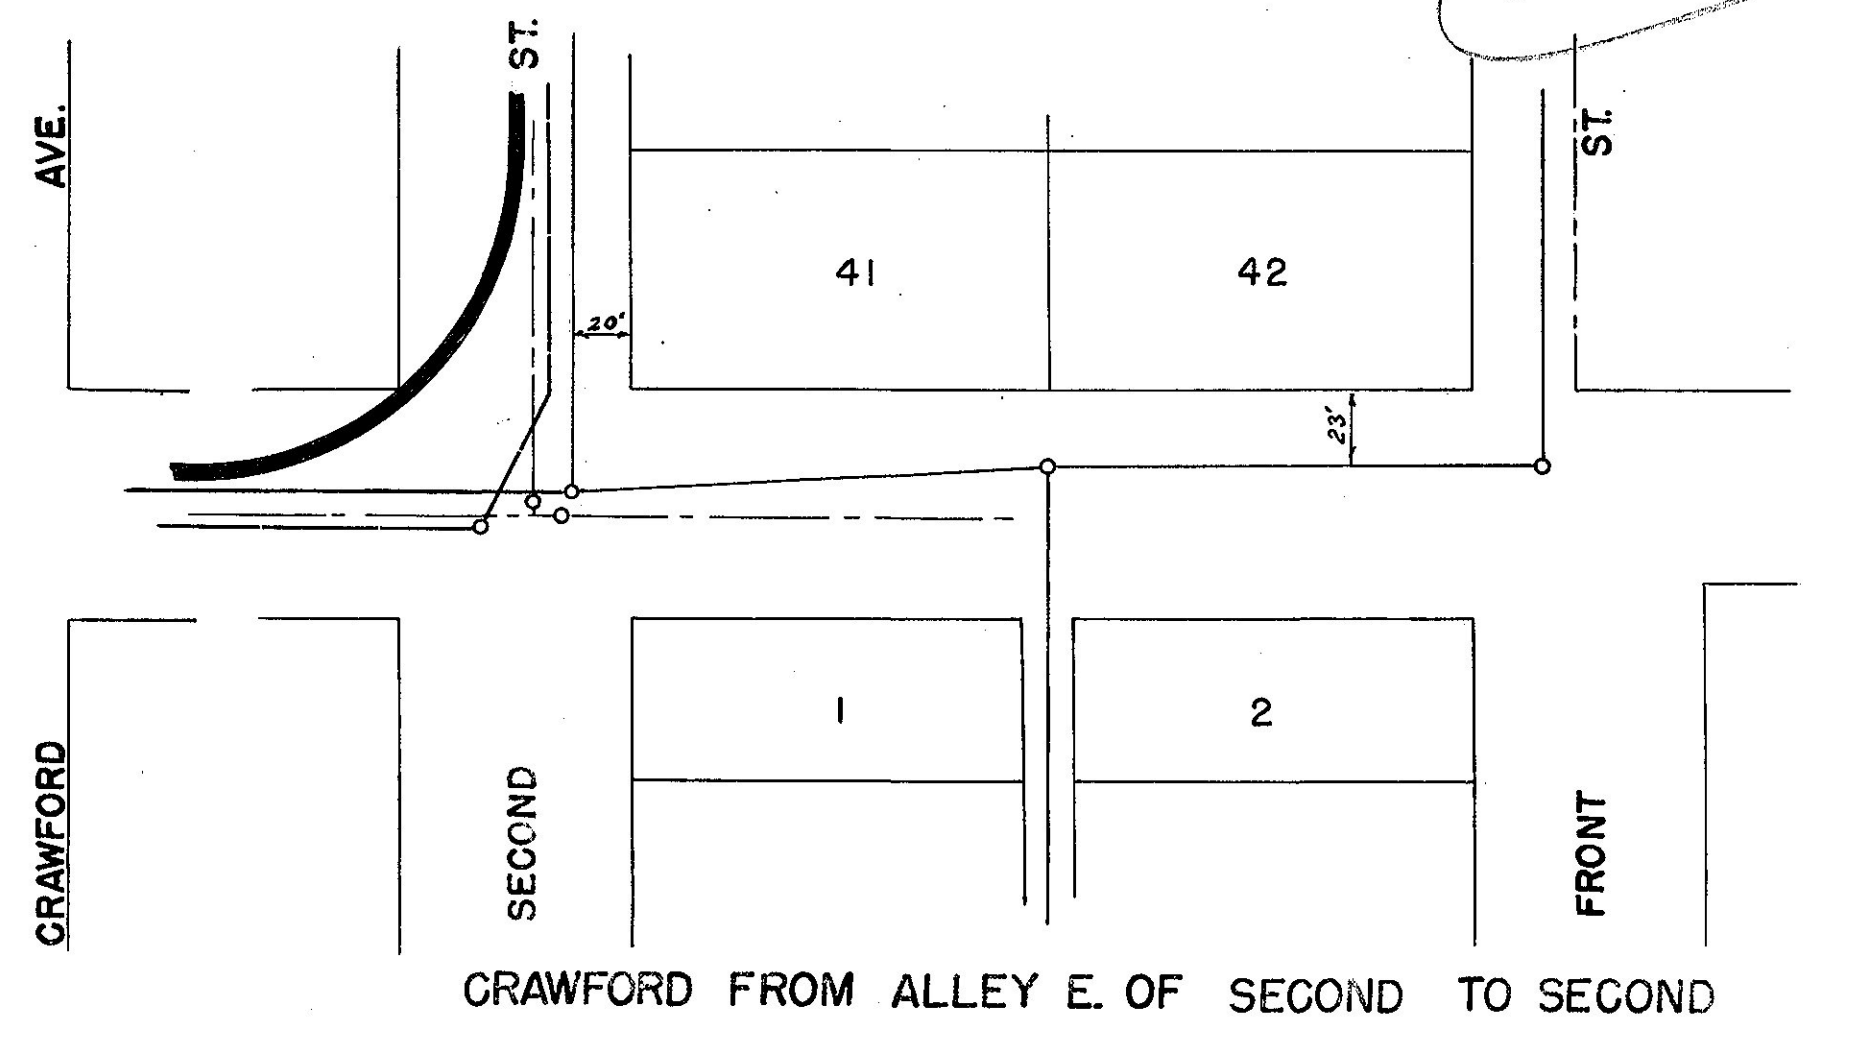






Horiz Scale 1"=60'
Vert Scale 1"=4'

212

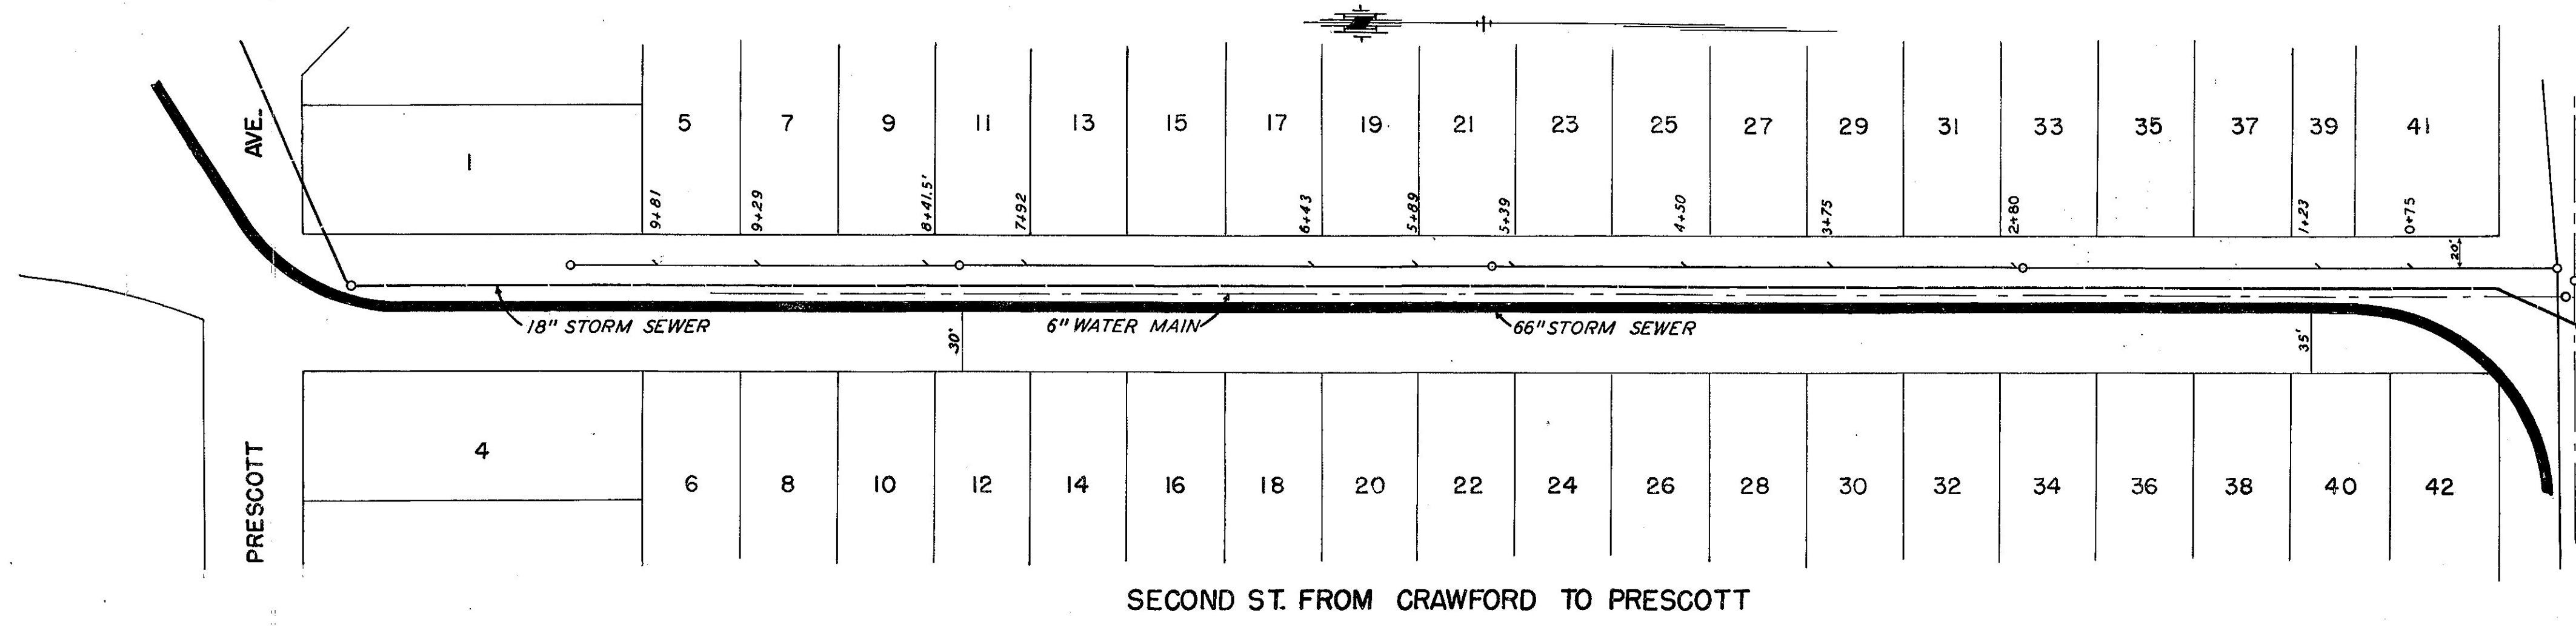

AS BUILT PLAN
CONSTRUCTED NOV. 1951
BY
H. J. TAYLOR CONST. CO.
SALINE, KAN.

12.24
22
20
18
16
14
12.12

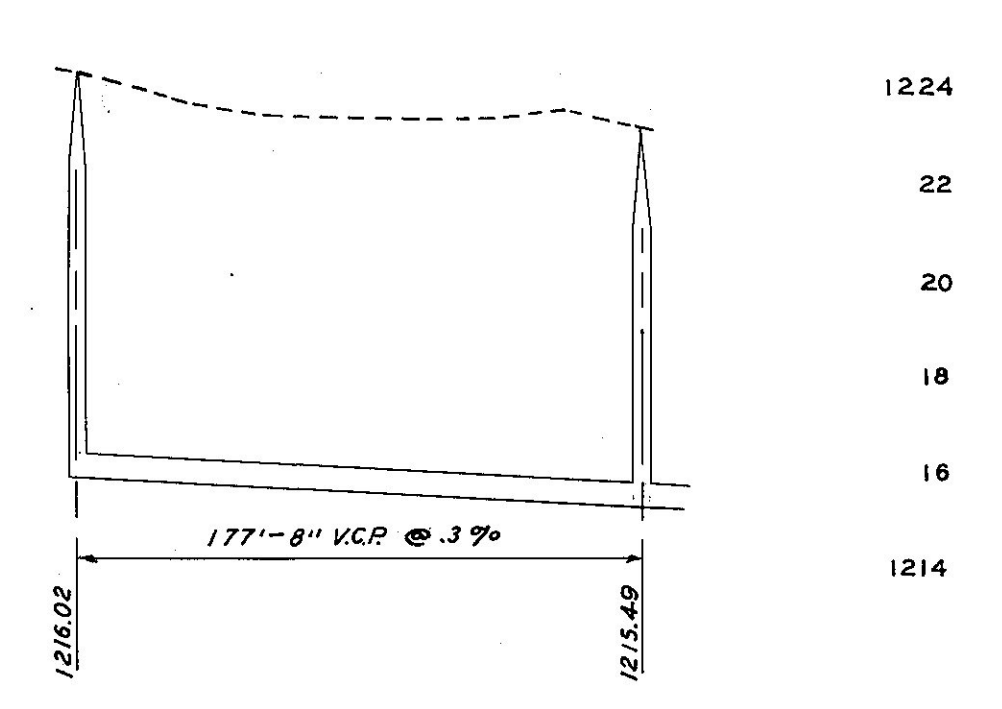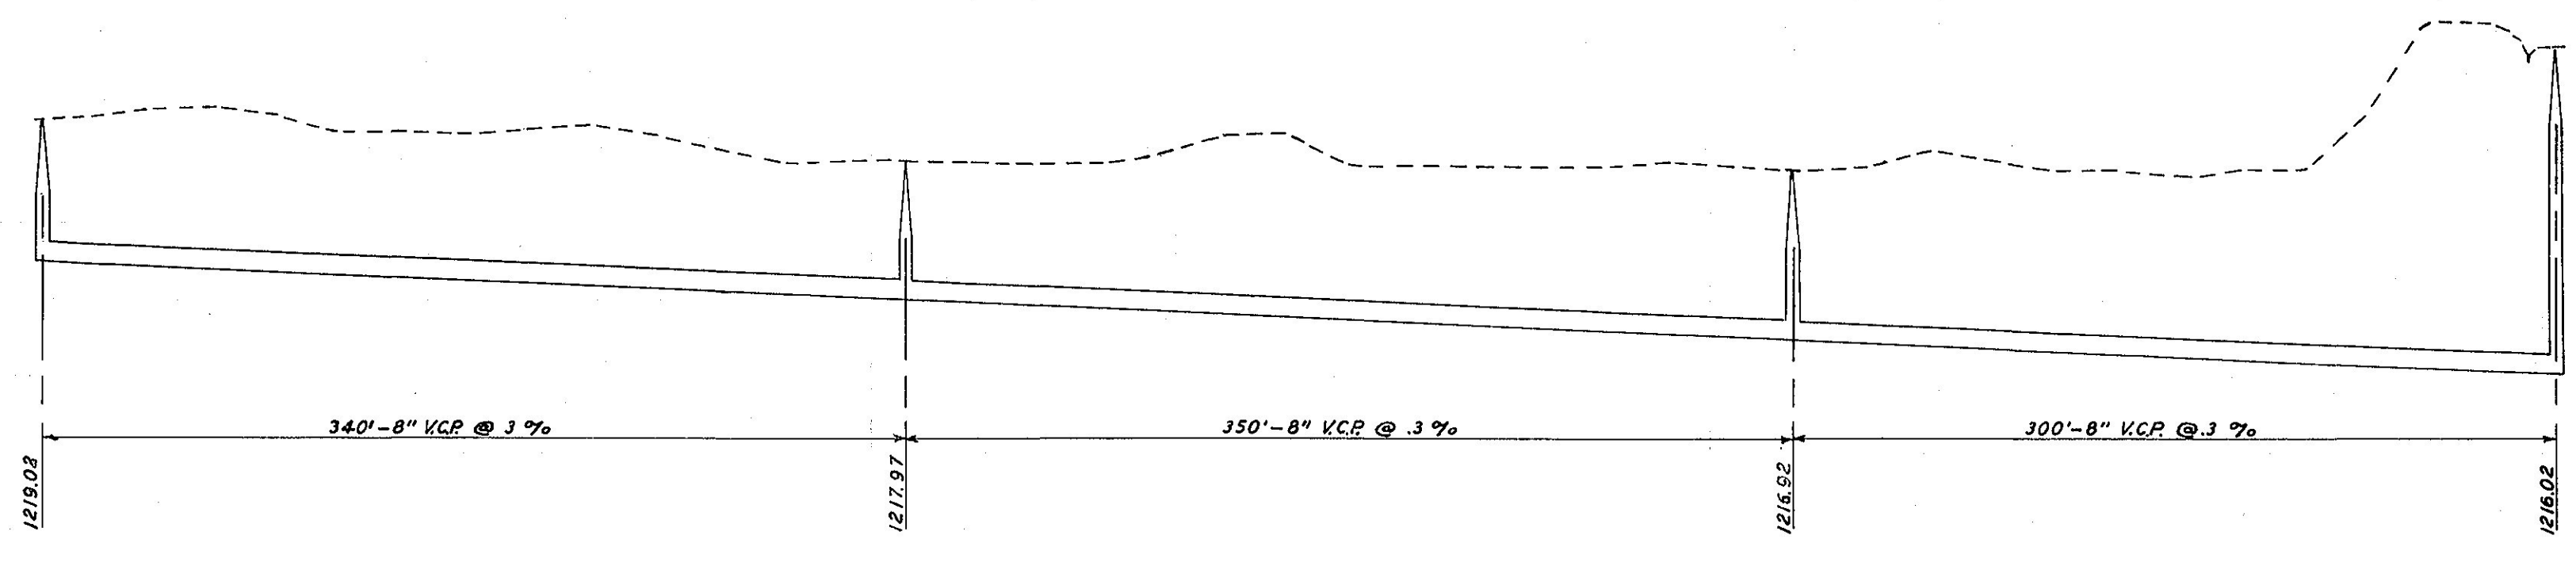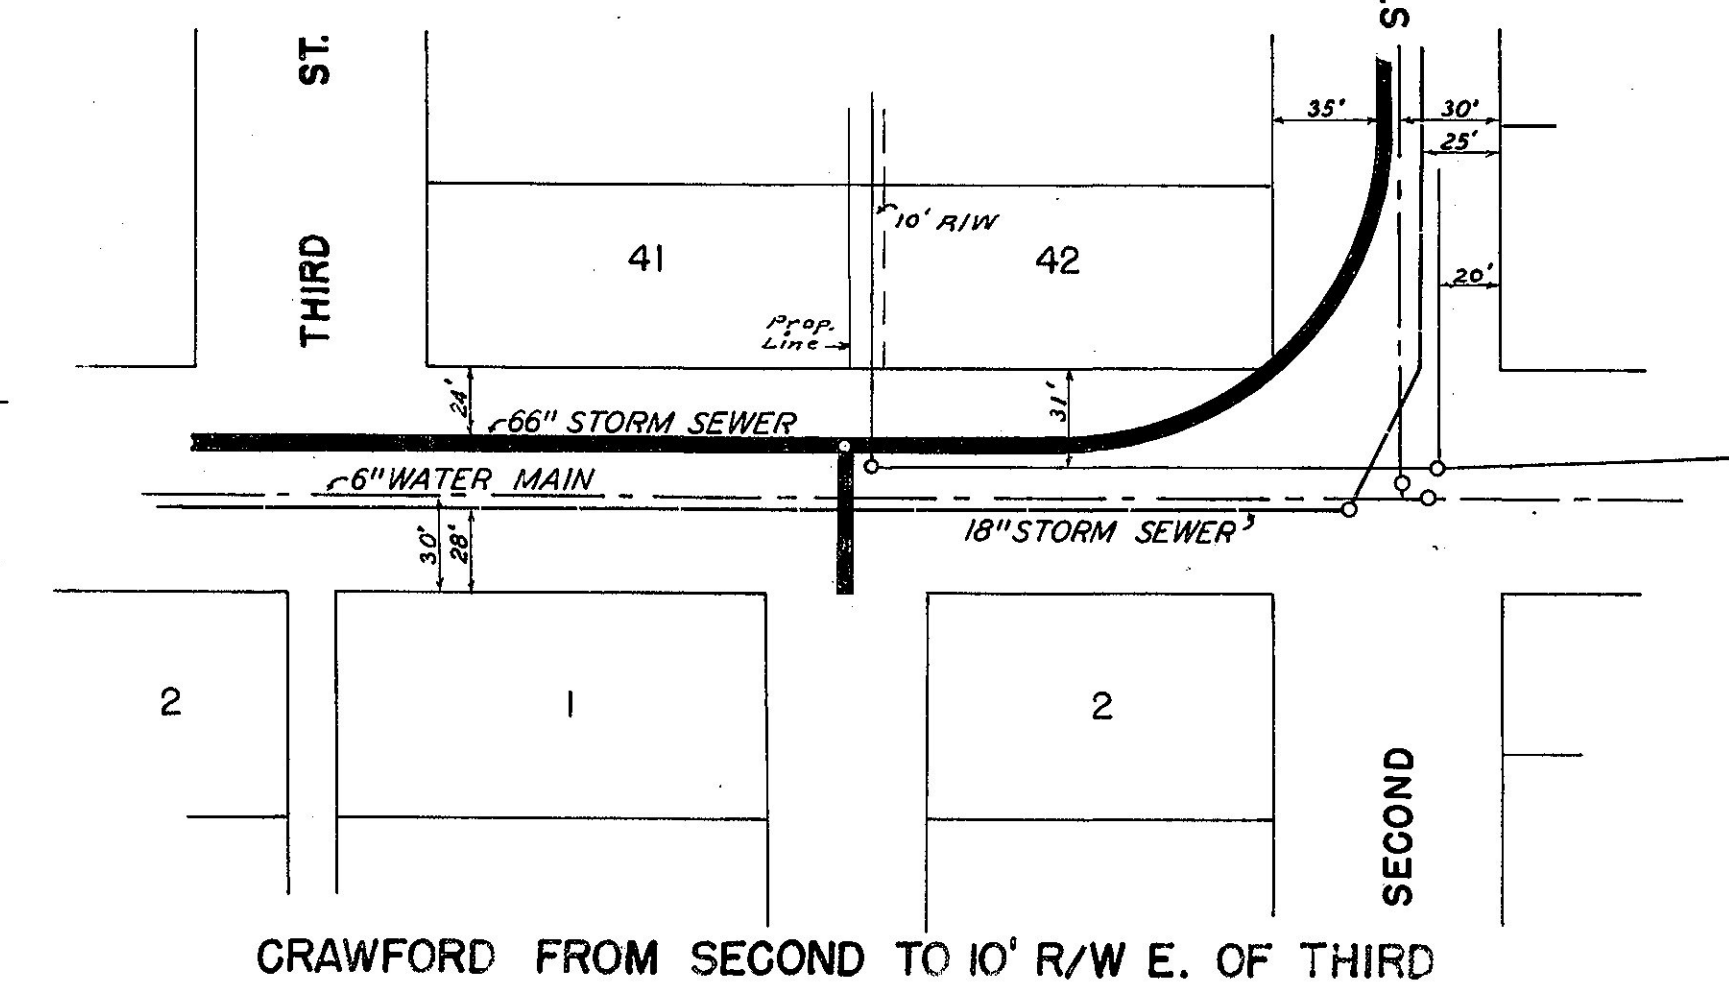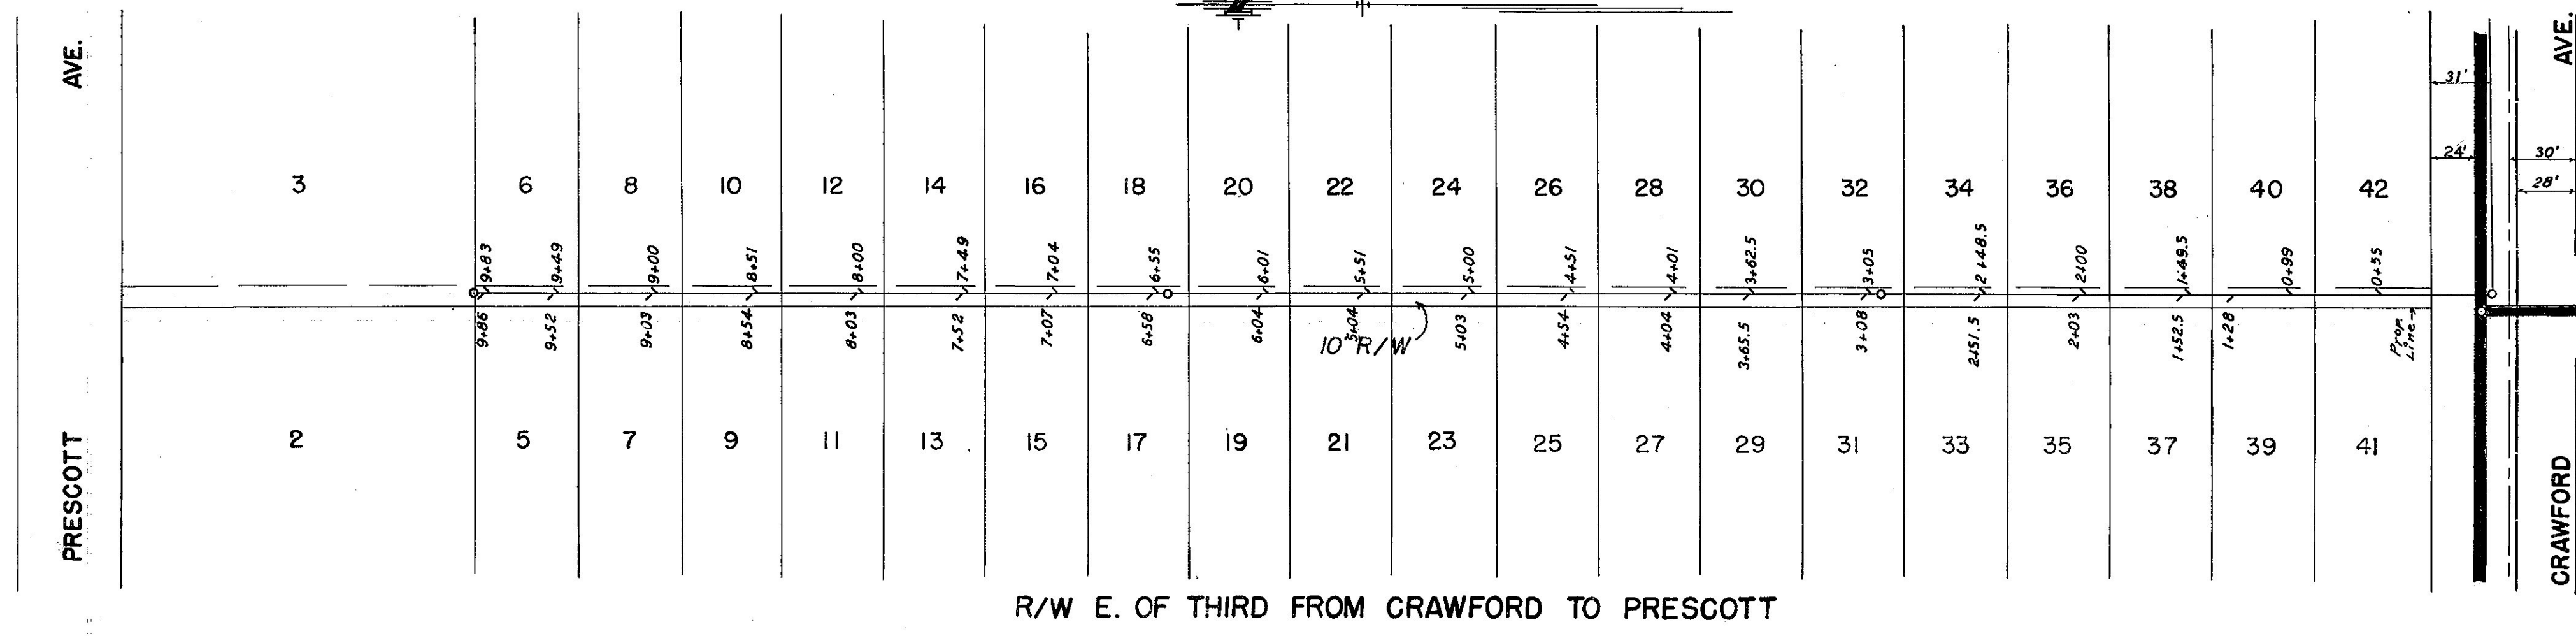

12.24
22
20
18
16
12.14

Let. 255