



PLAN	DATE	BY
AS BUILT		
NOTED		
ALIGNED		
CHECKED		
NO.		

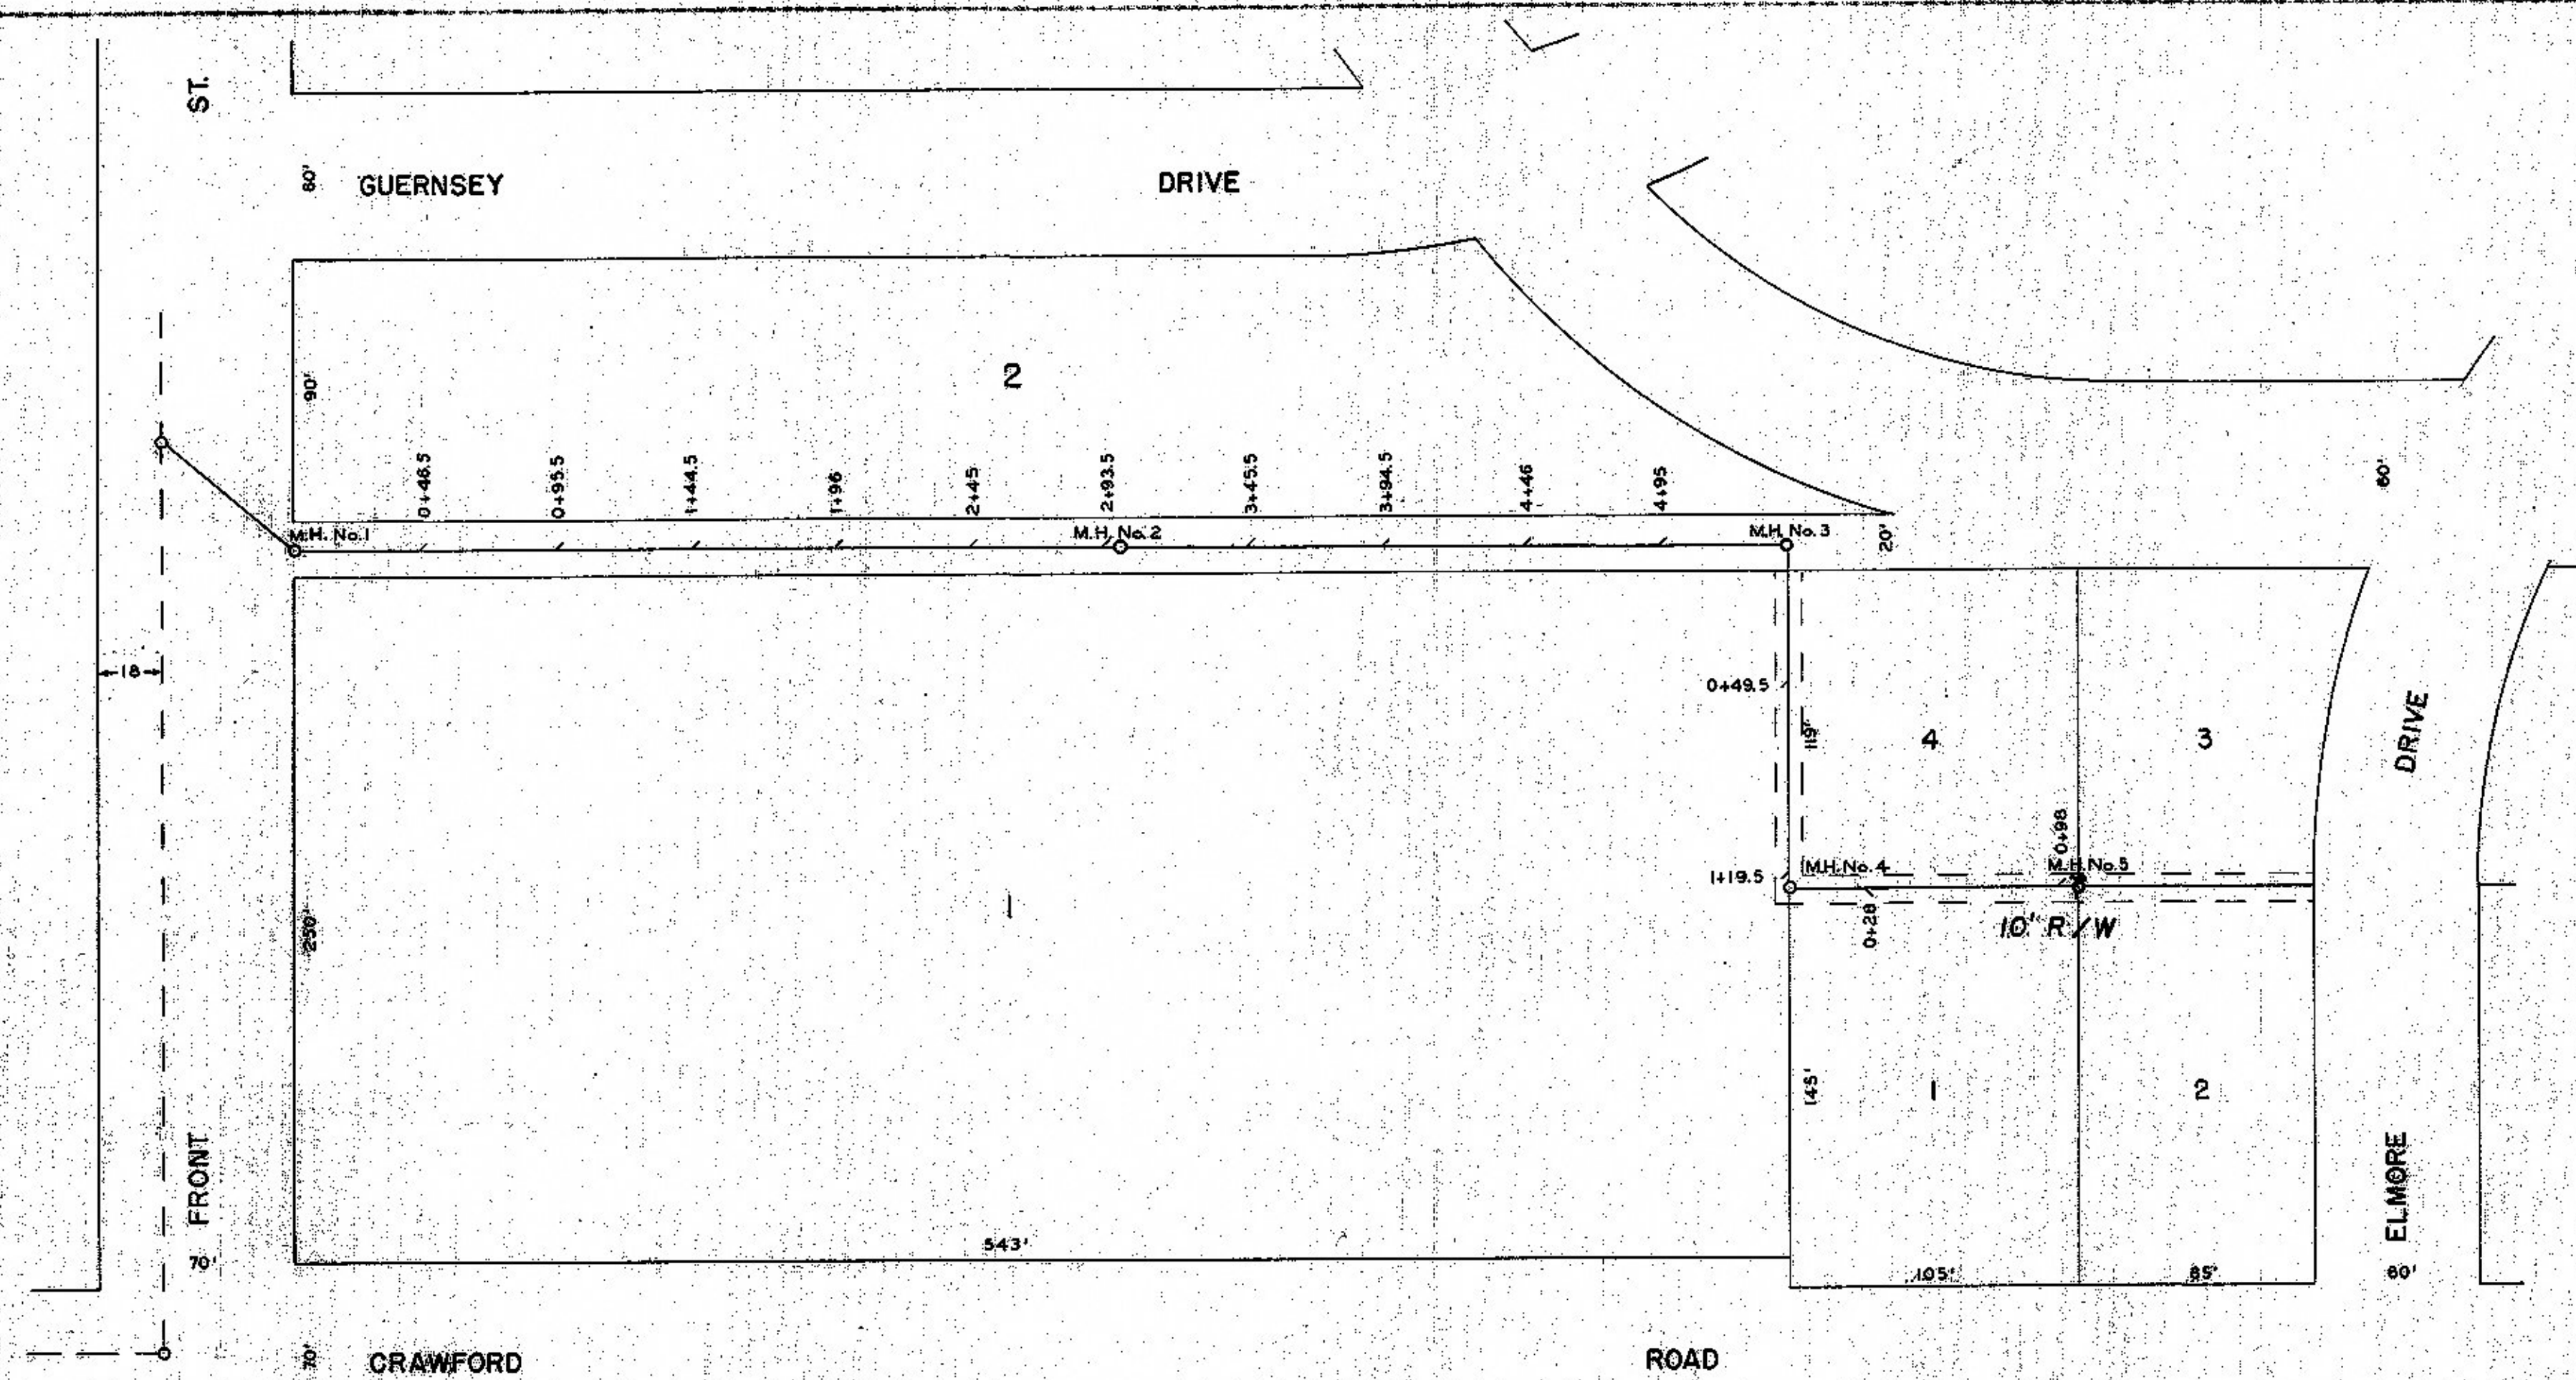

PROFILE	DATE	BY
AS BUILT		
NOTED		
ALIGNED		
CHECKED		
NO.		

ALLEY & R/W NORTH CRAWFORD — FRONT TO ELMORE DRIVE
LATERAL NO. 266

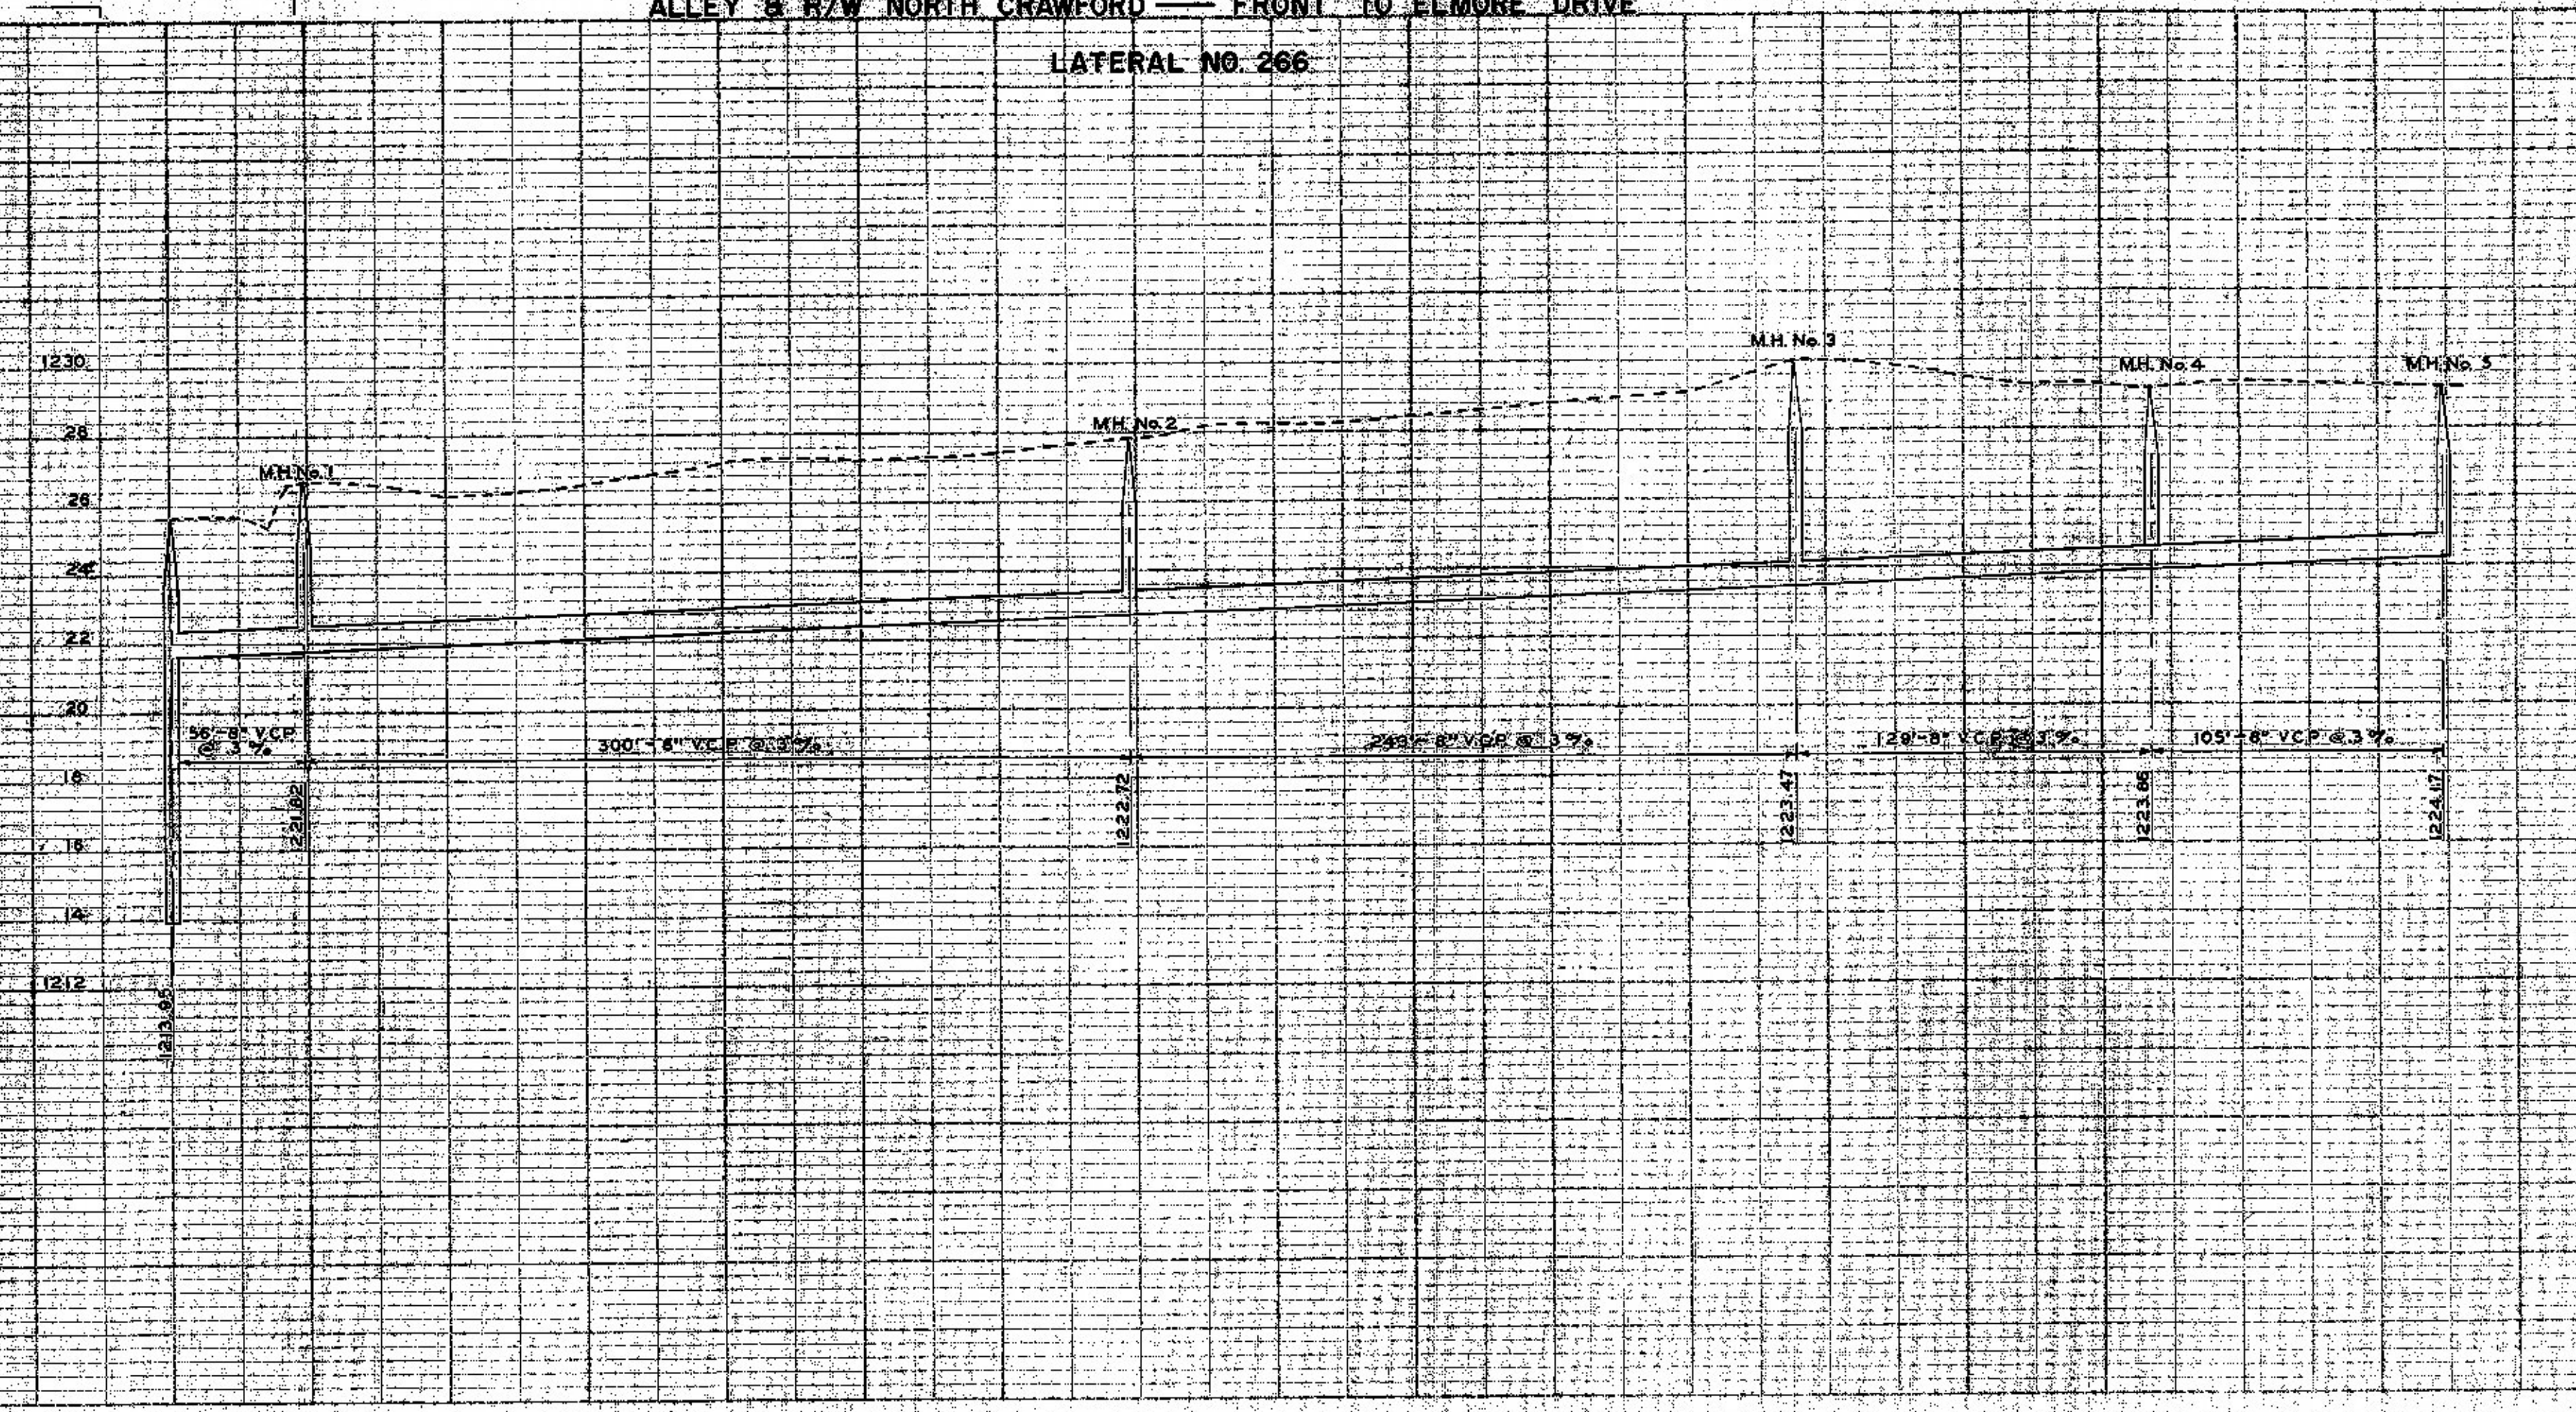

AS BUILT PLAN
CONSTRUCTED DEC. 1991
H. J. TAYLOR CONST. CO.