




PLAN
 DATE: 12/14/01
 DRAWN BY: C. P. ...
 CHECKED BY: ...
 PROJECT: ...

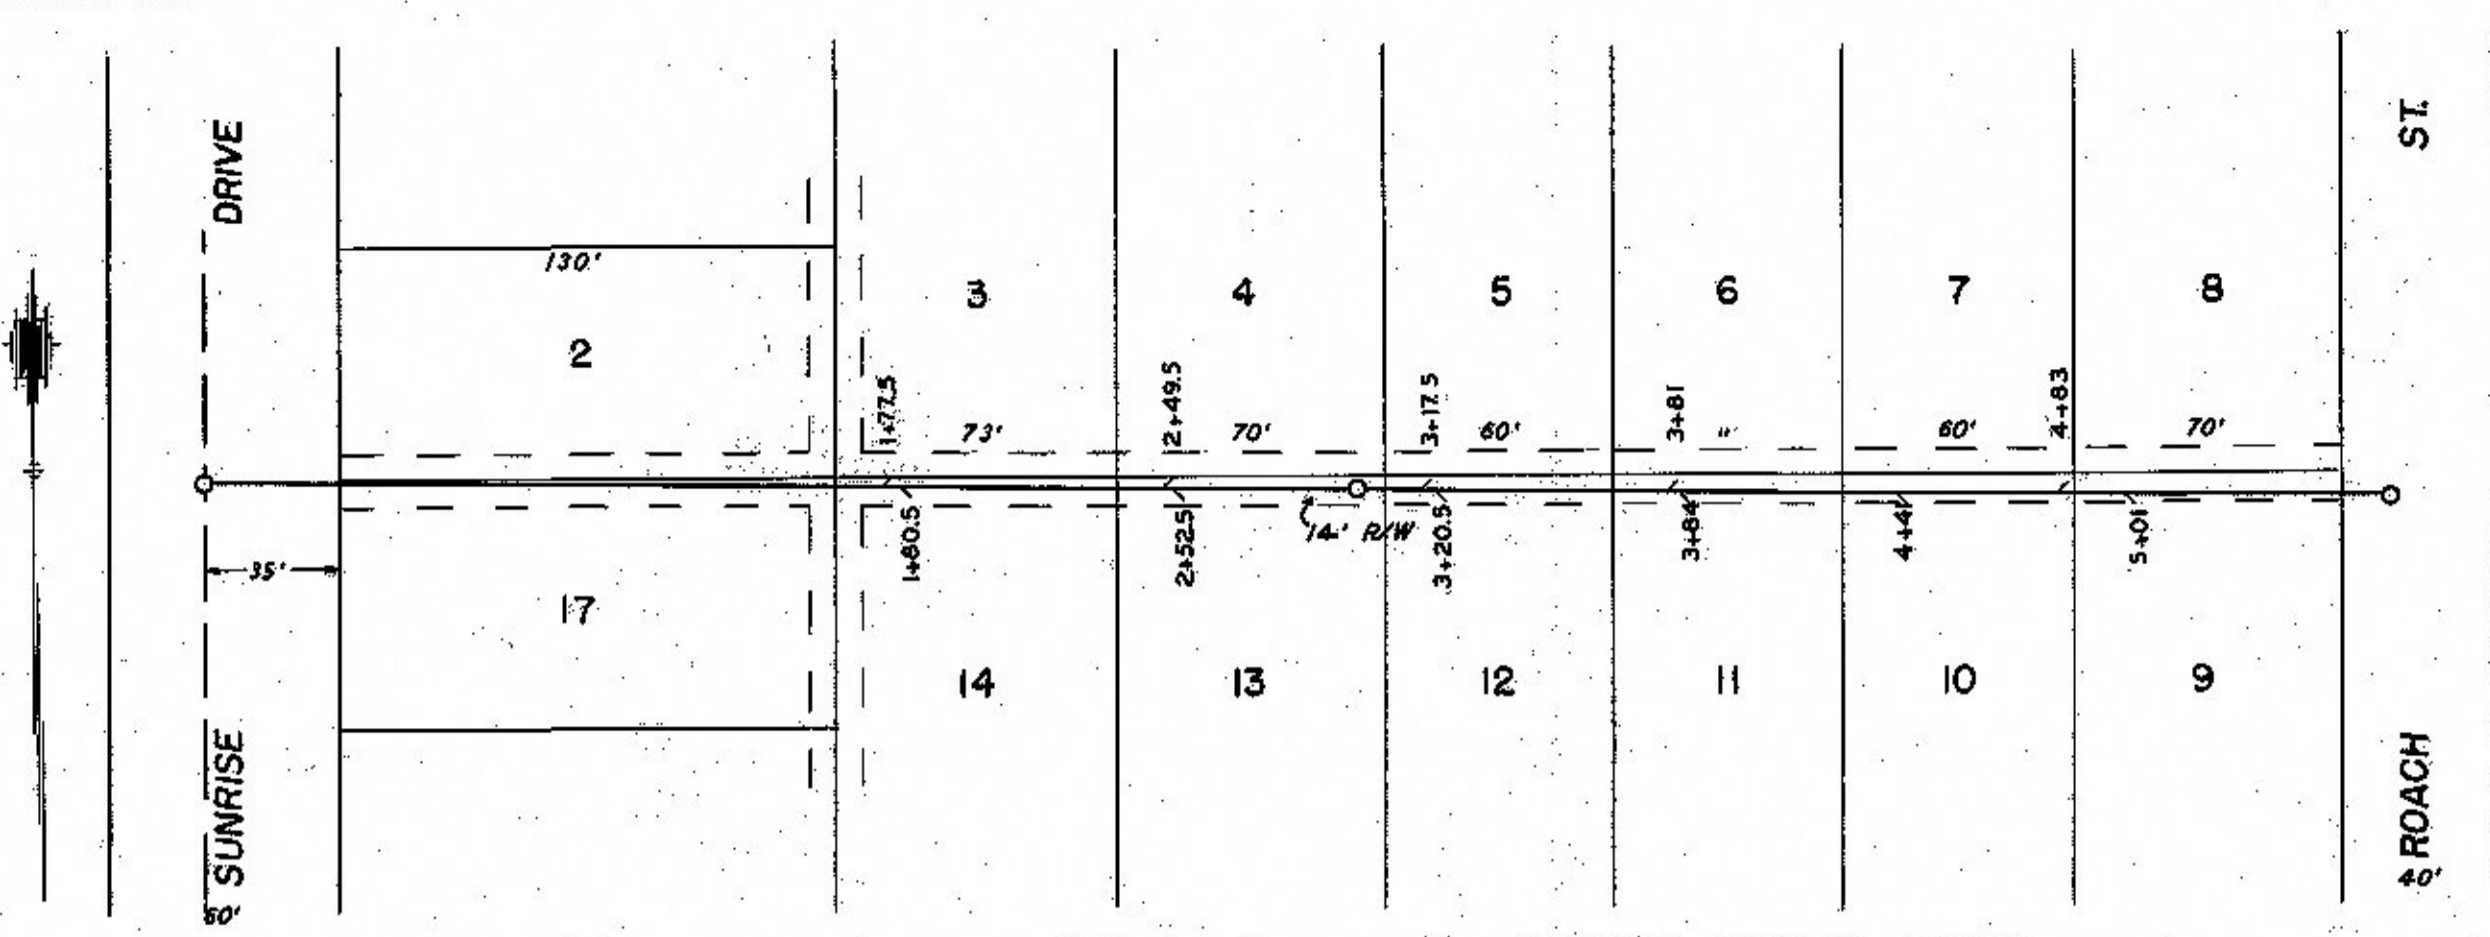

"AS BUILT" PLAN
 CONSTRUCTED DEC. 4, 1957
 H.J. TAYLOR CONST. CO.

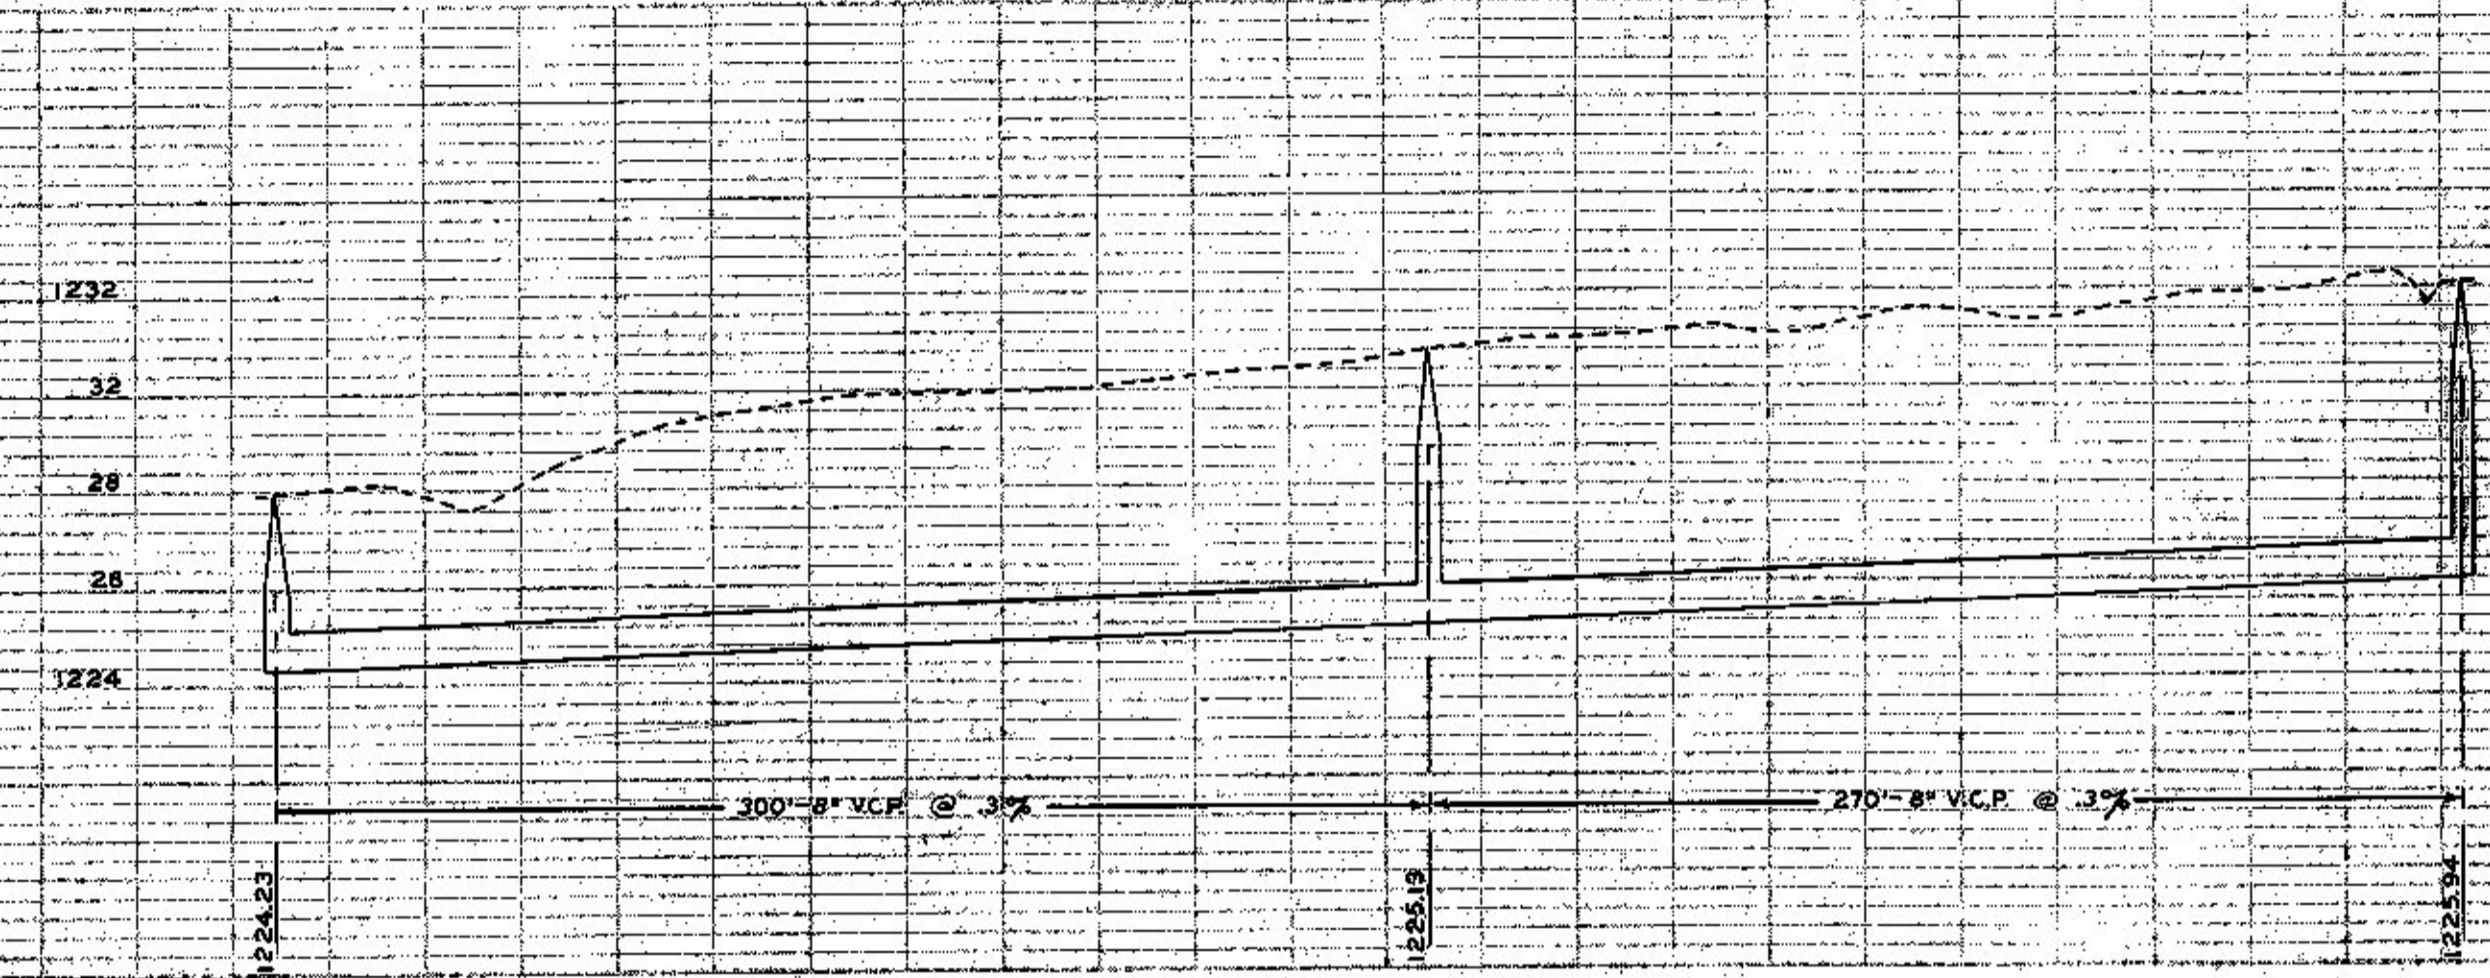

PROFILE
 DATE: 1/15/02
 DRAWN BY: ...
 CHECKED BY: ...
 PROJECT: ...

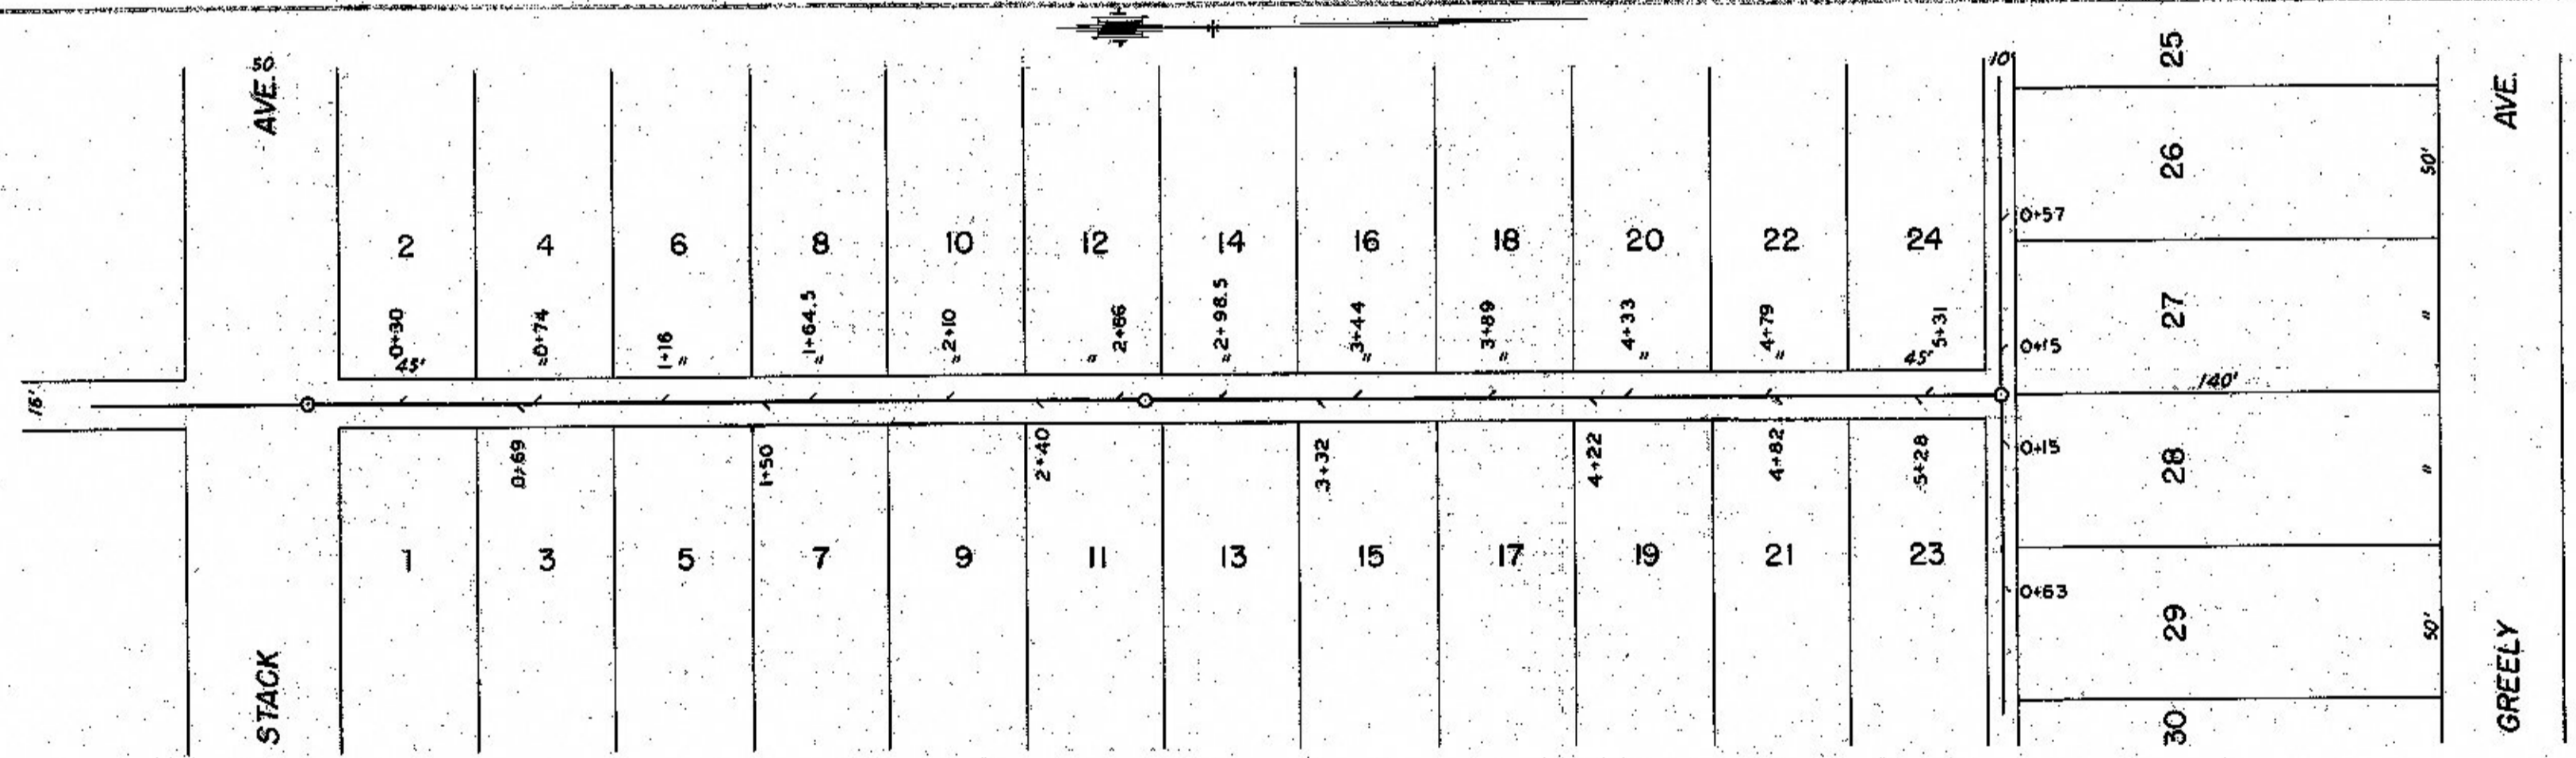

"AS BUILT" PLAN
 CONSTRUCTED MAR. 29, 1952
 O.D. WILMOTH

