




PLAN
 SURVEYED BY _____ DATE _____
 ALIGNED BY _____
 CHECKED BY _____
 NO. _____

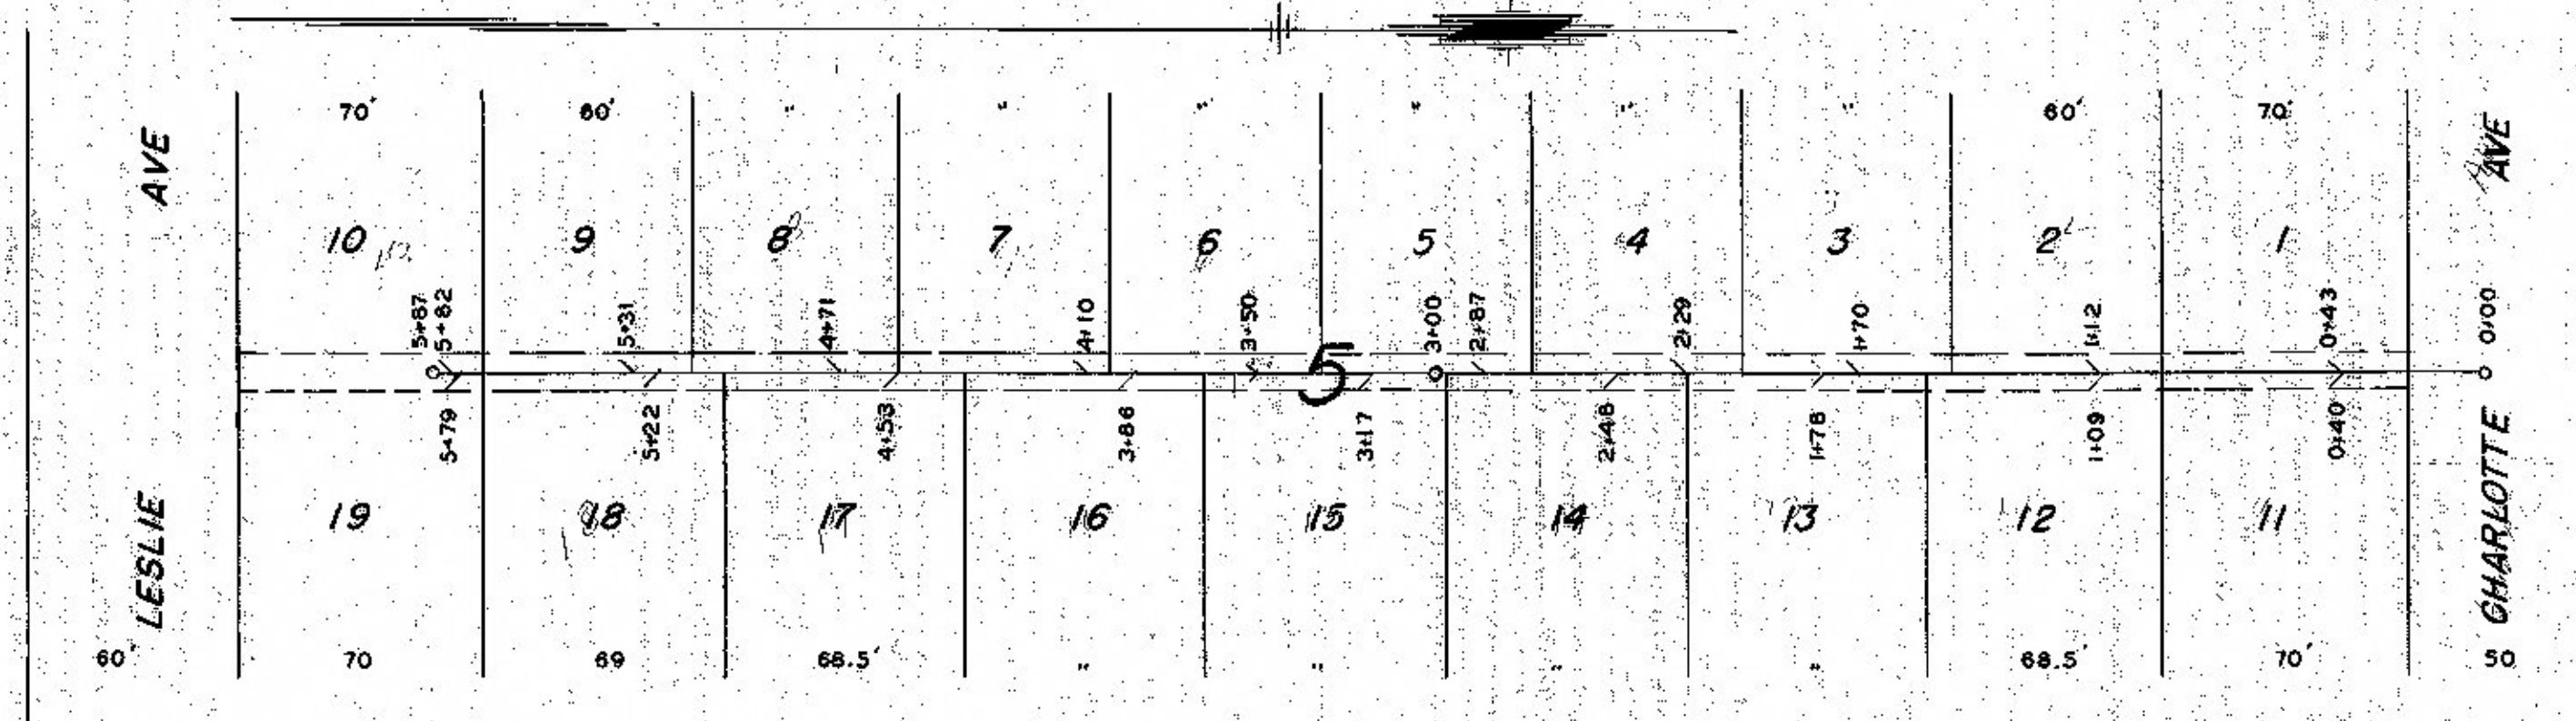


R/W EAST OF GEBHART CHARLOTTE TO LESLIE

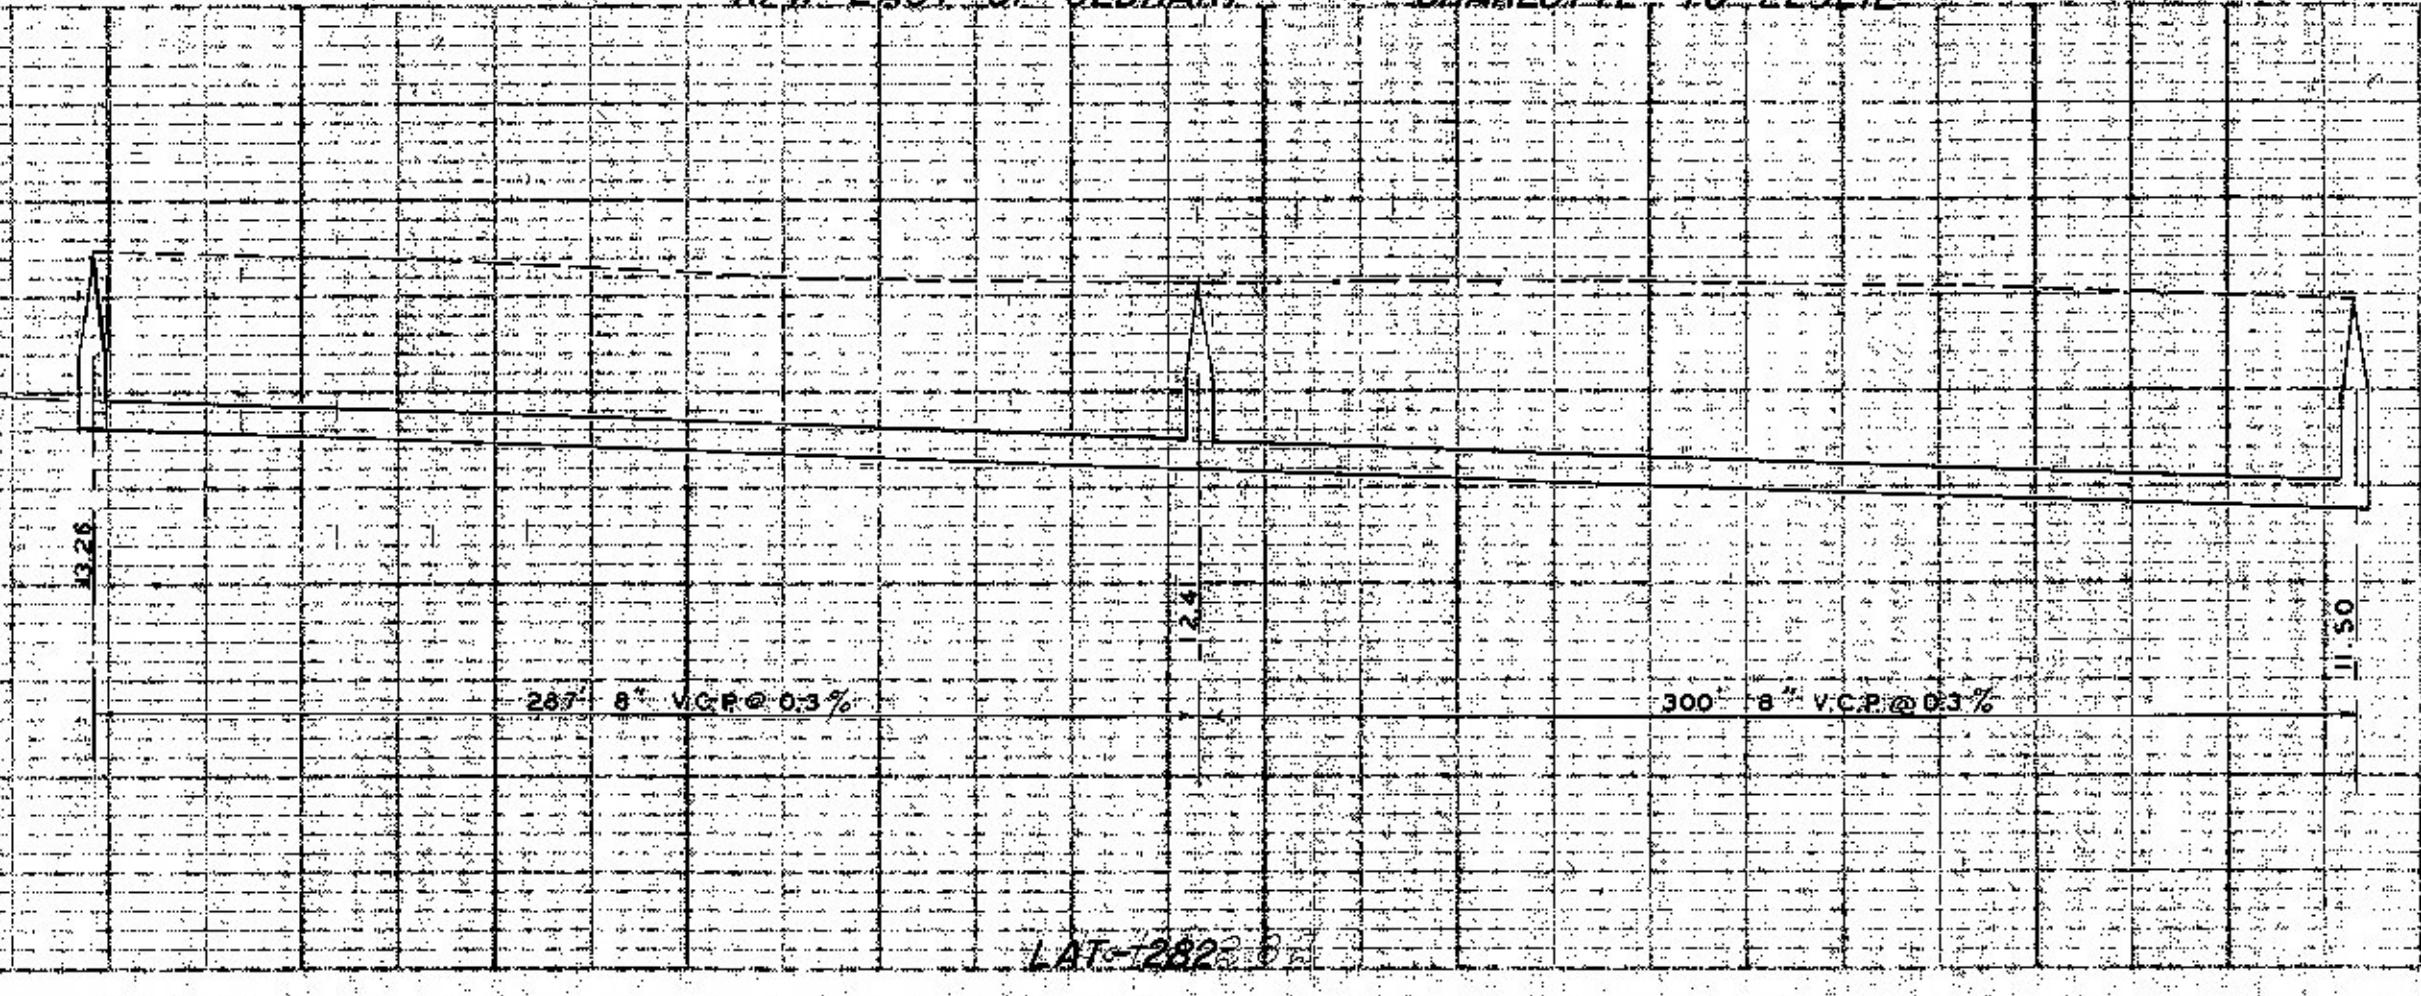

PROFILE
 SURVEYED BY _____ DATE _____
 CHECKED BY _____
 NO. _____

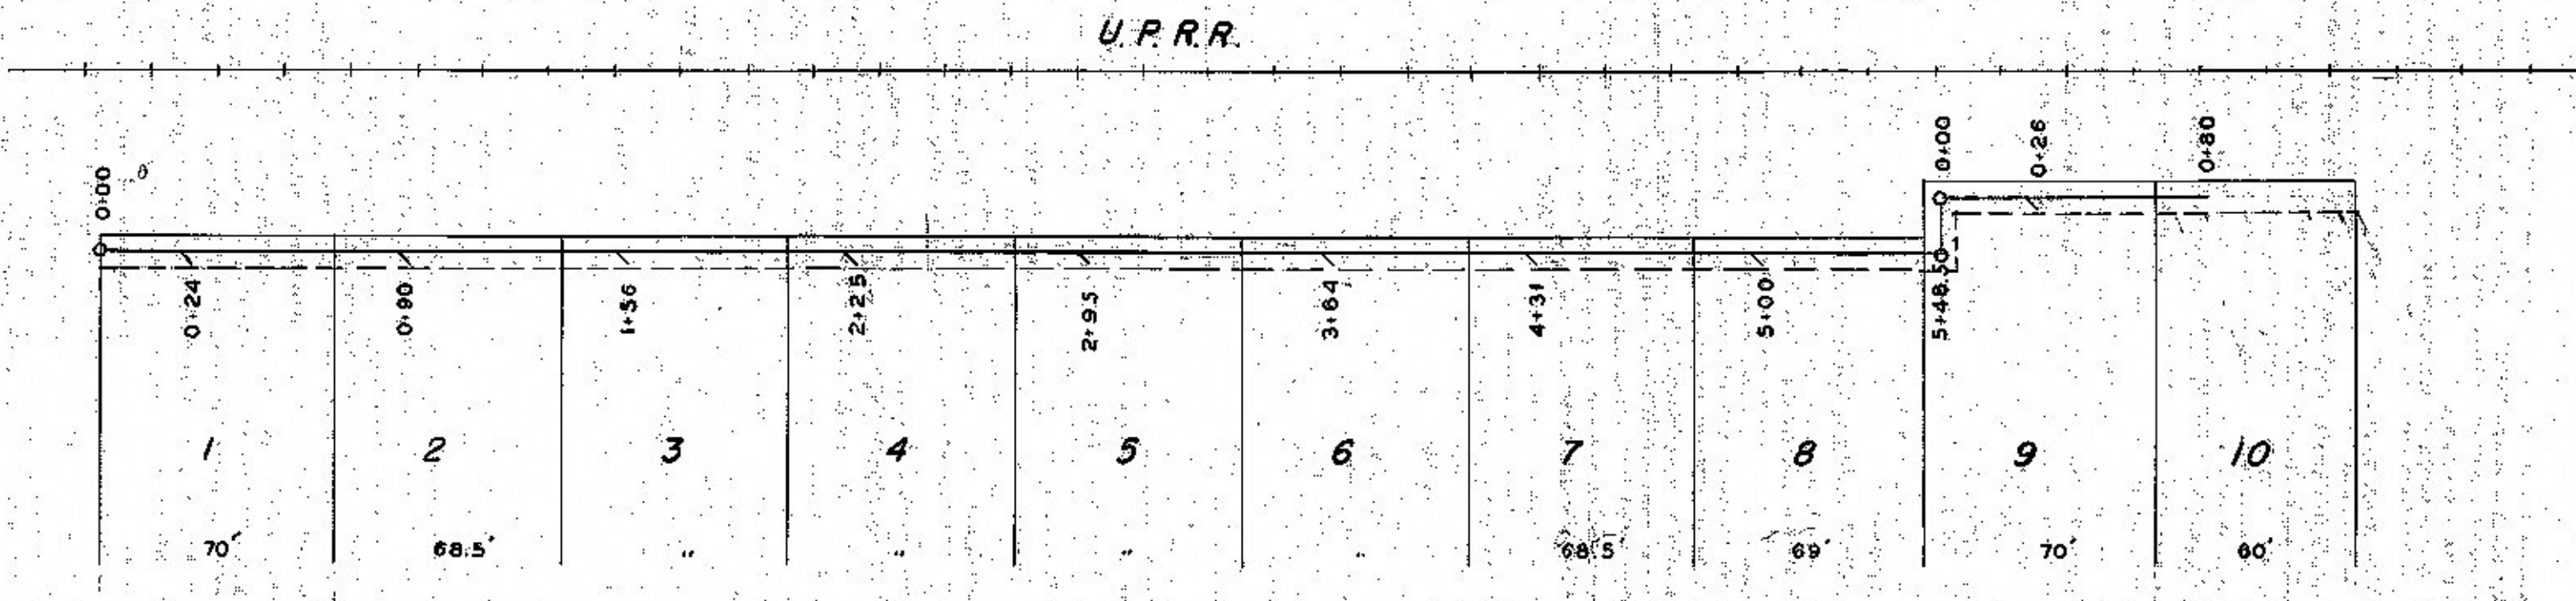

R/W EAST OF FOURTH CHARLOTTE TO LESLIE

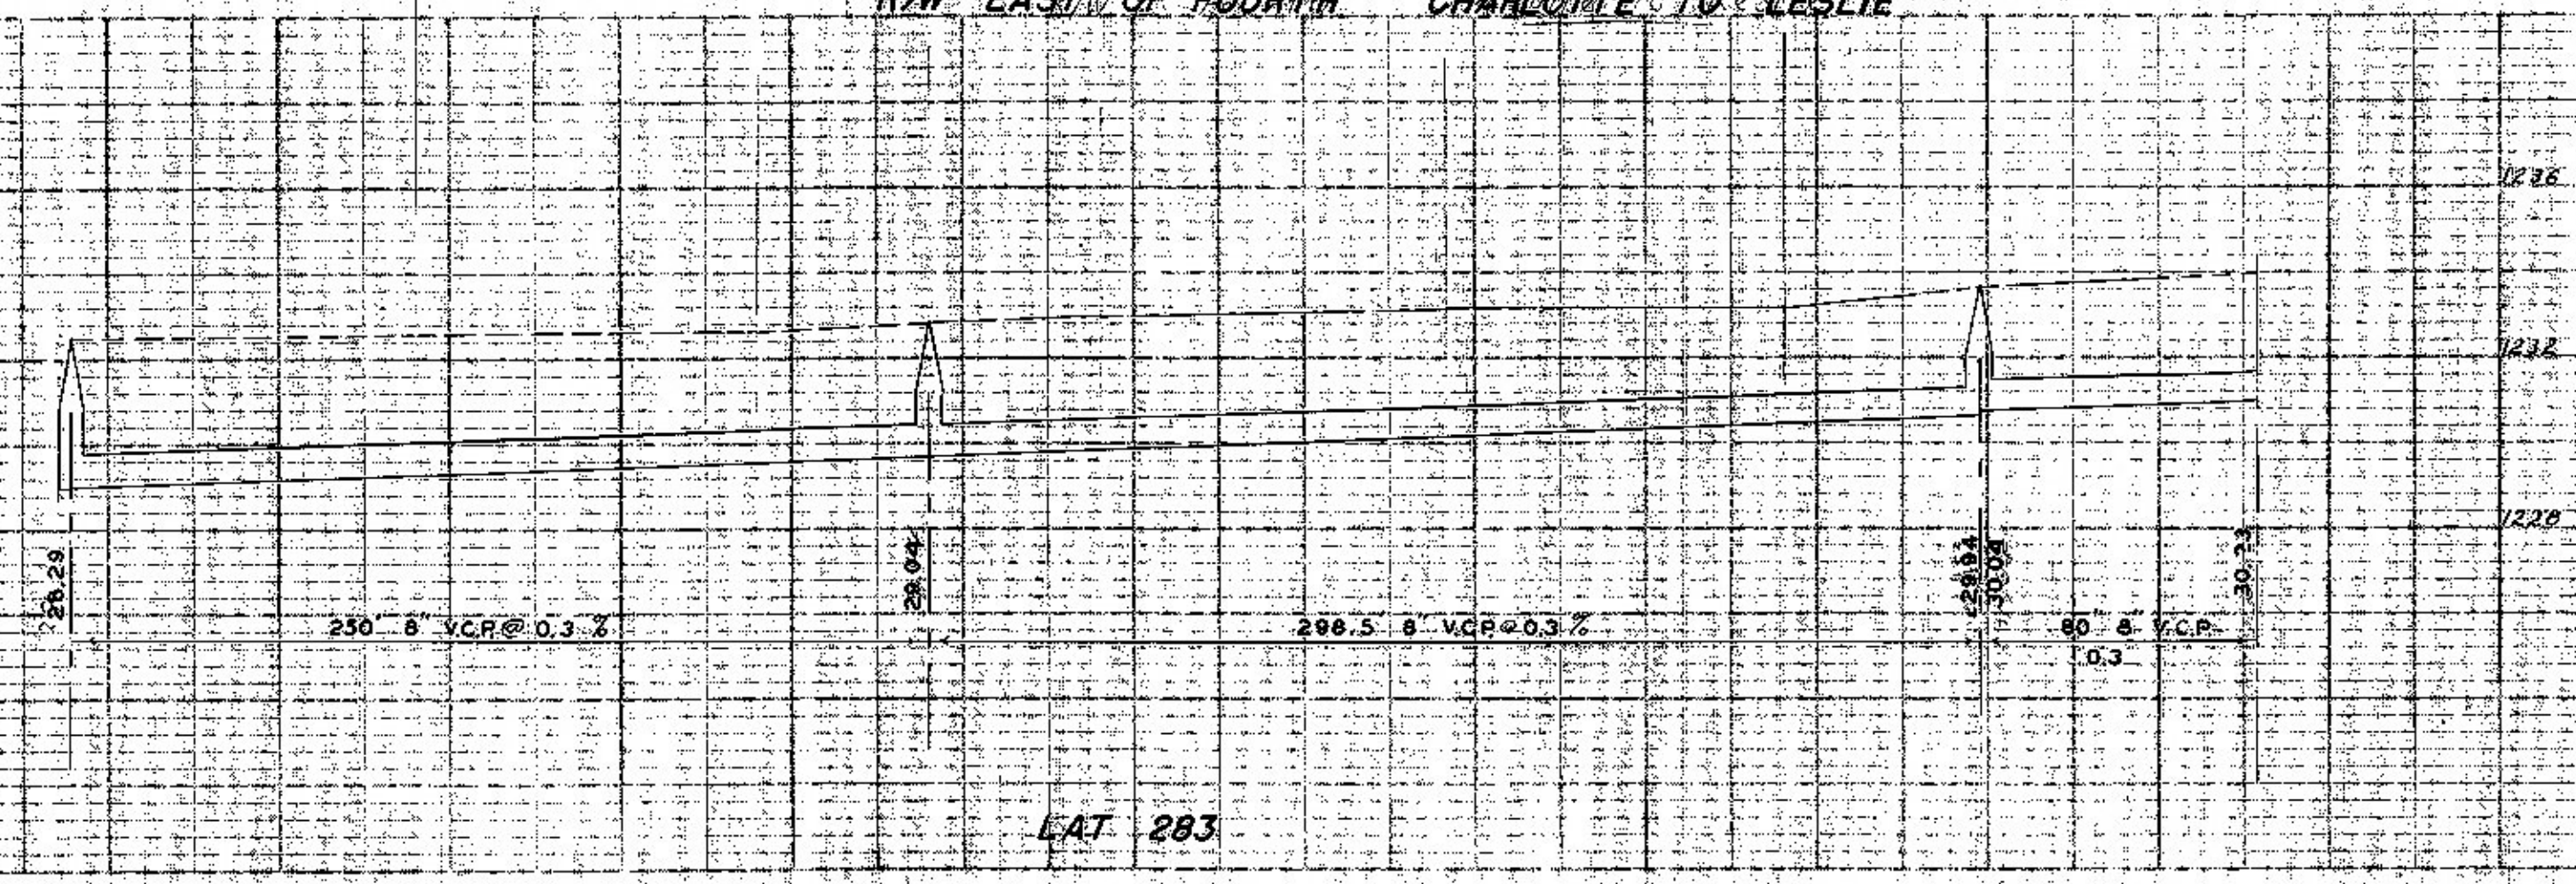

AS BUILT PLANS
 CONSTRUCTED - SEPT. 1932
 BY
 H.J. TAYLOR CONST. CO.
 SALINA, KANSAS