



212

PLAN
 SURVEYED
 PLOTTED
 CHECKED
 DATE
 BY
 NO.
 NOTE BOOK
 ALIGNMENT CHECKED
 HT. OF W.A. CHECKED


PROFILE
 SURVEYED
 PLOTTED
 CHECKED
 DATE
 BY
 NO.
 NOTE BOOK
 ALIGNMENT CHECKED
 HT. OF W.A. CHECKED

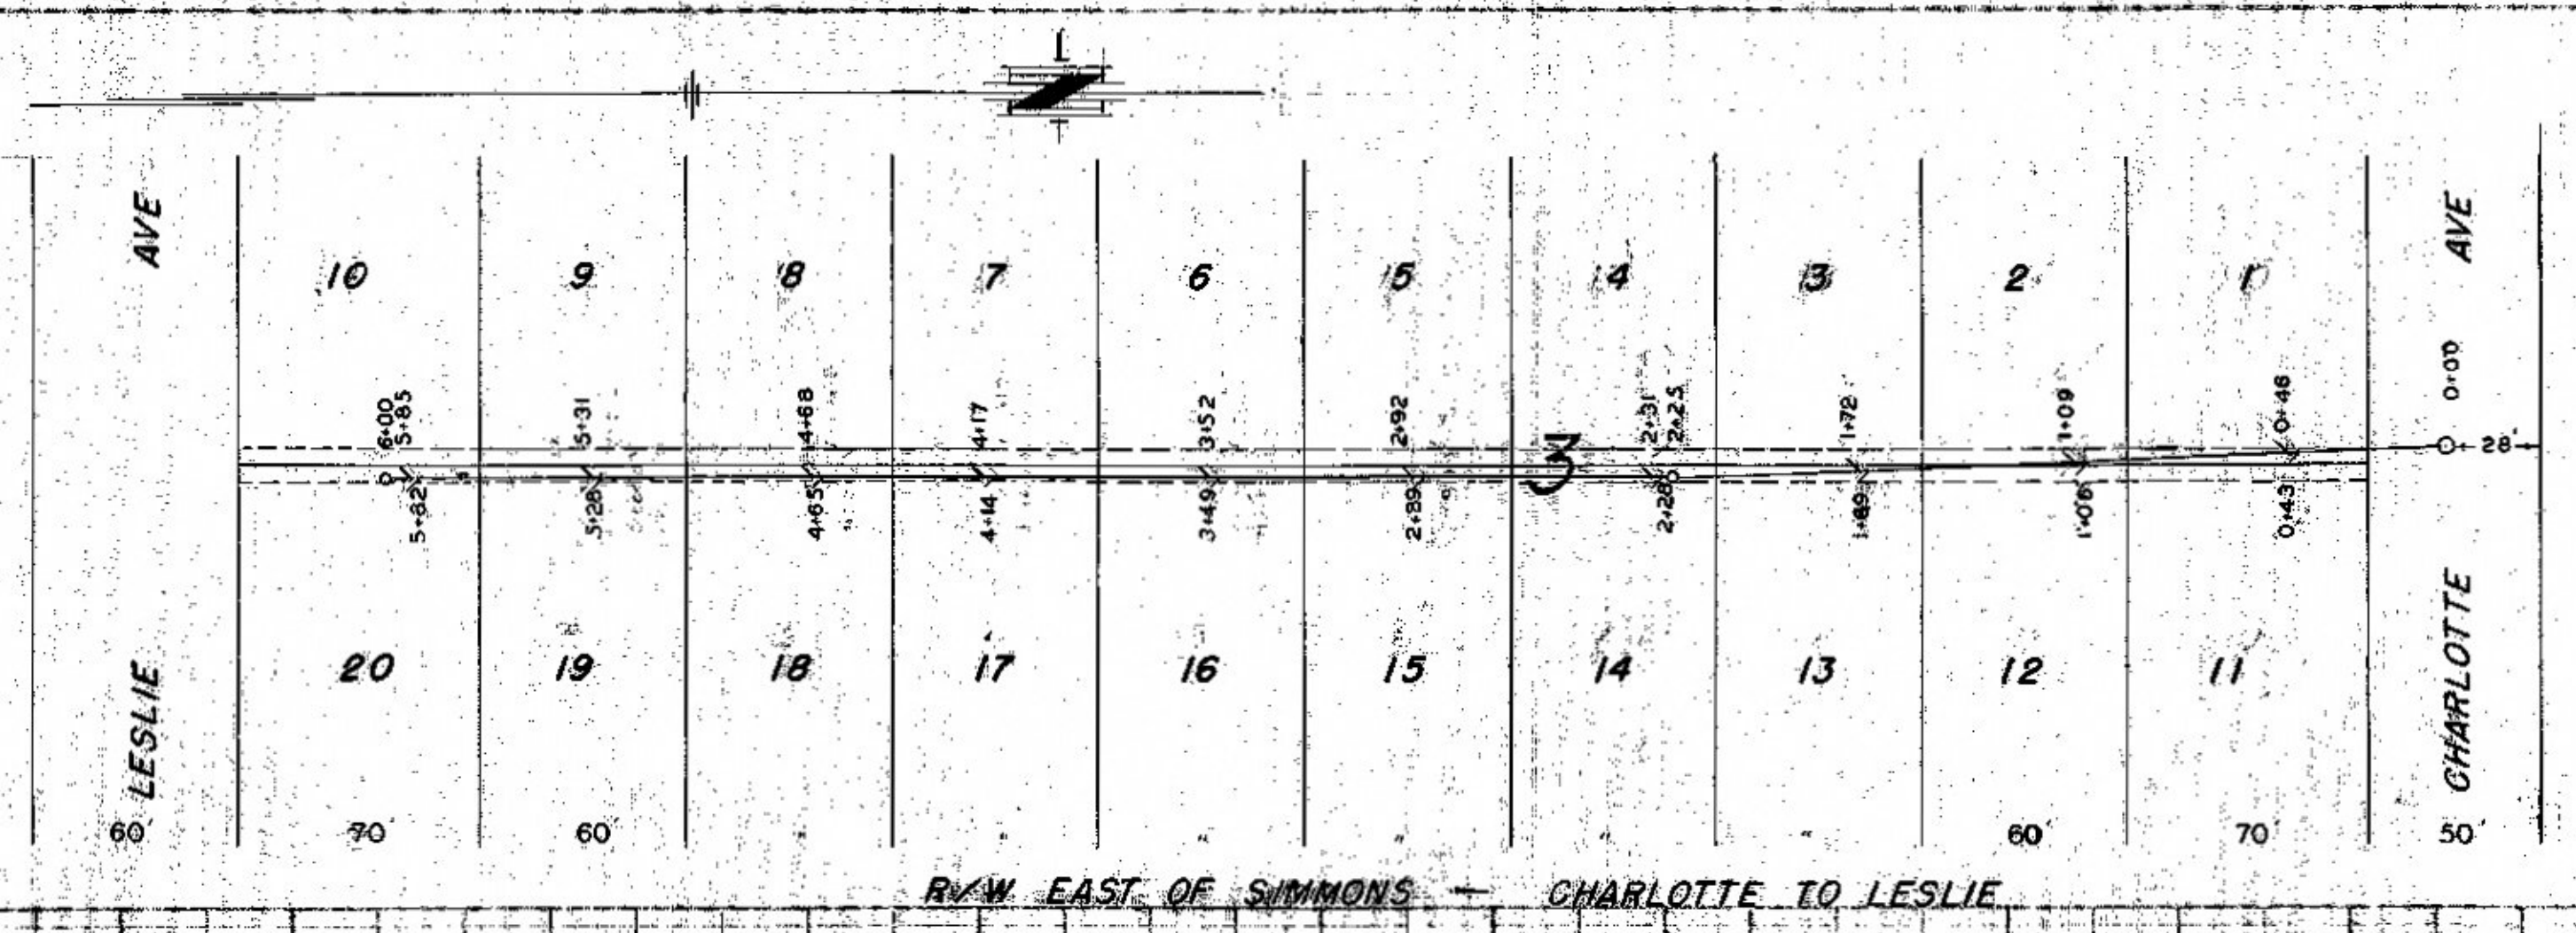


R/W EAST OF SIMMONS - CHARLOTTE TO LESLIE

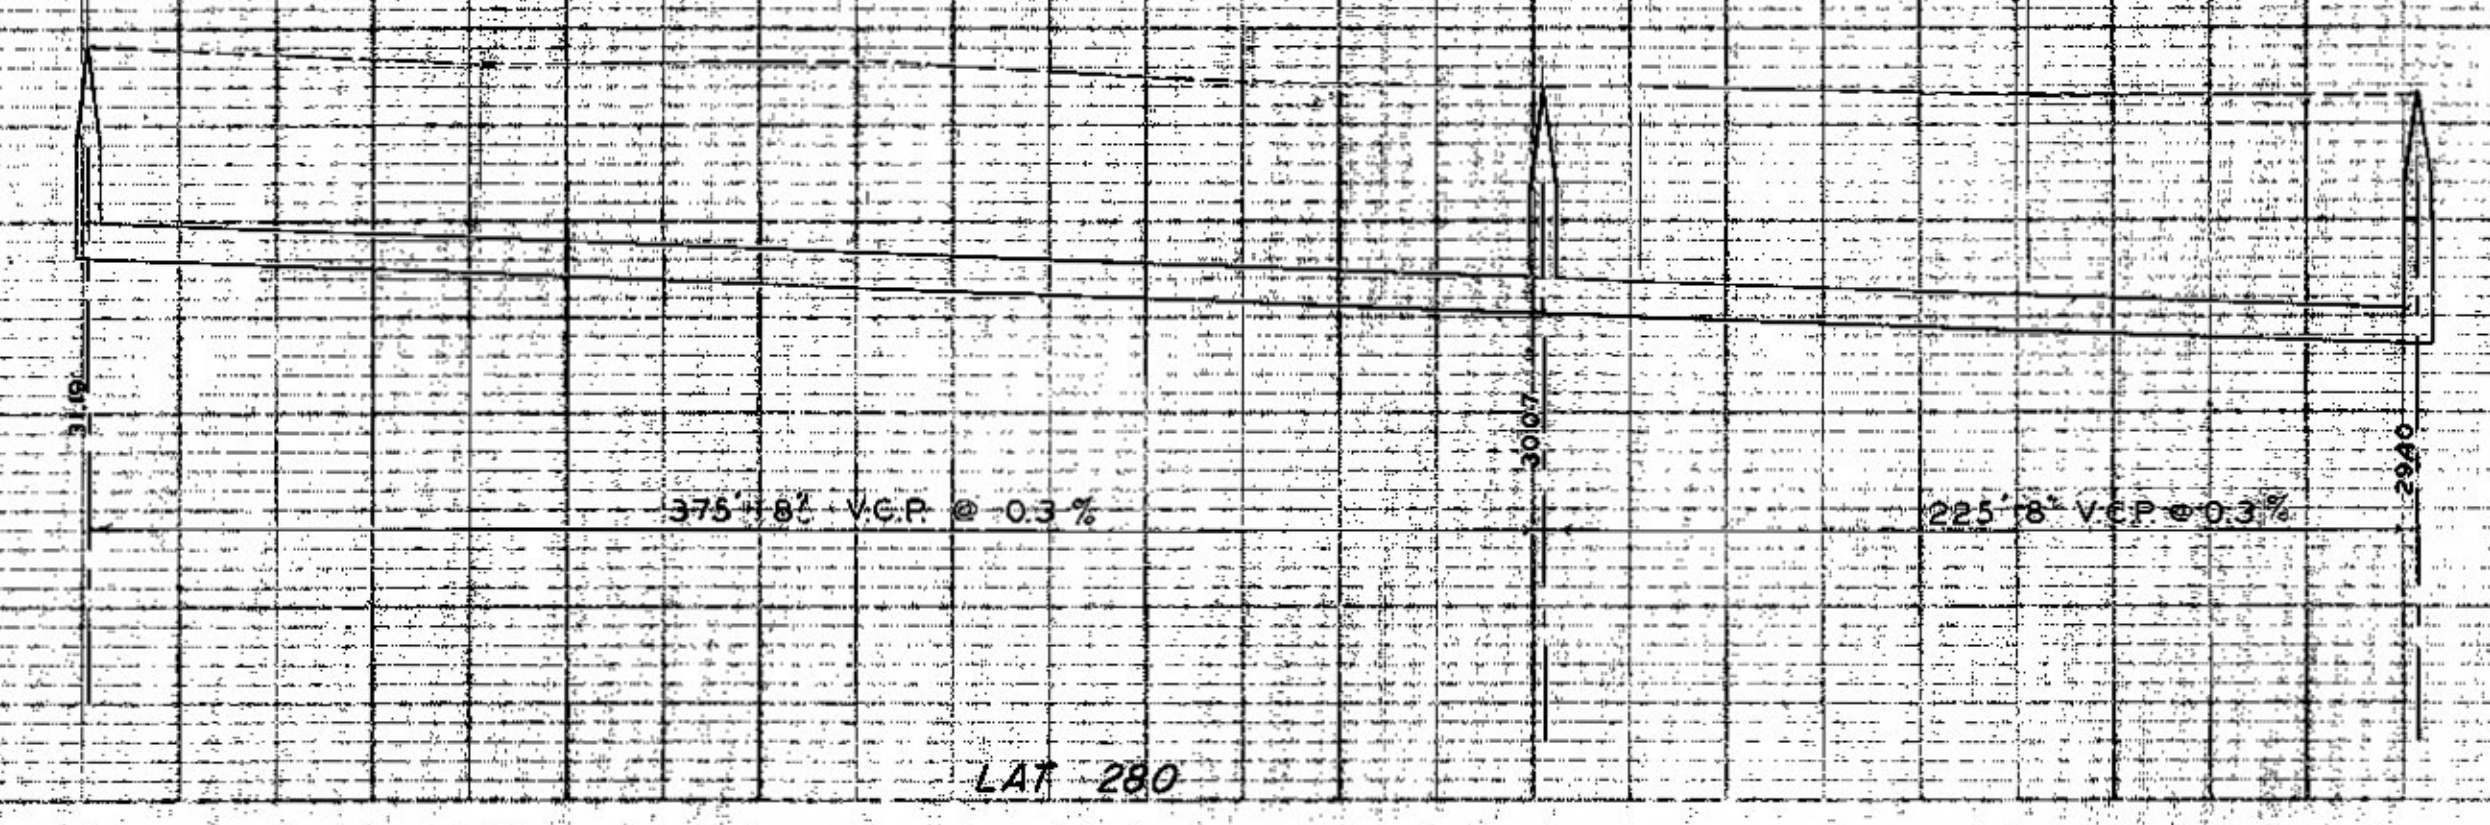

"AS BUILT PLAN"
 CONSTRUCTED - SEPT, 1952
 BY
 H.J. TAYLOR CONST. CO.
 SALINA, KANSAS

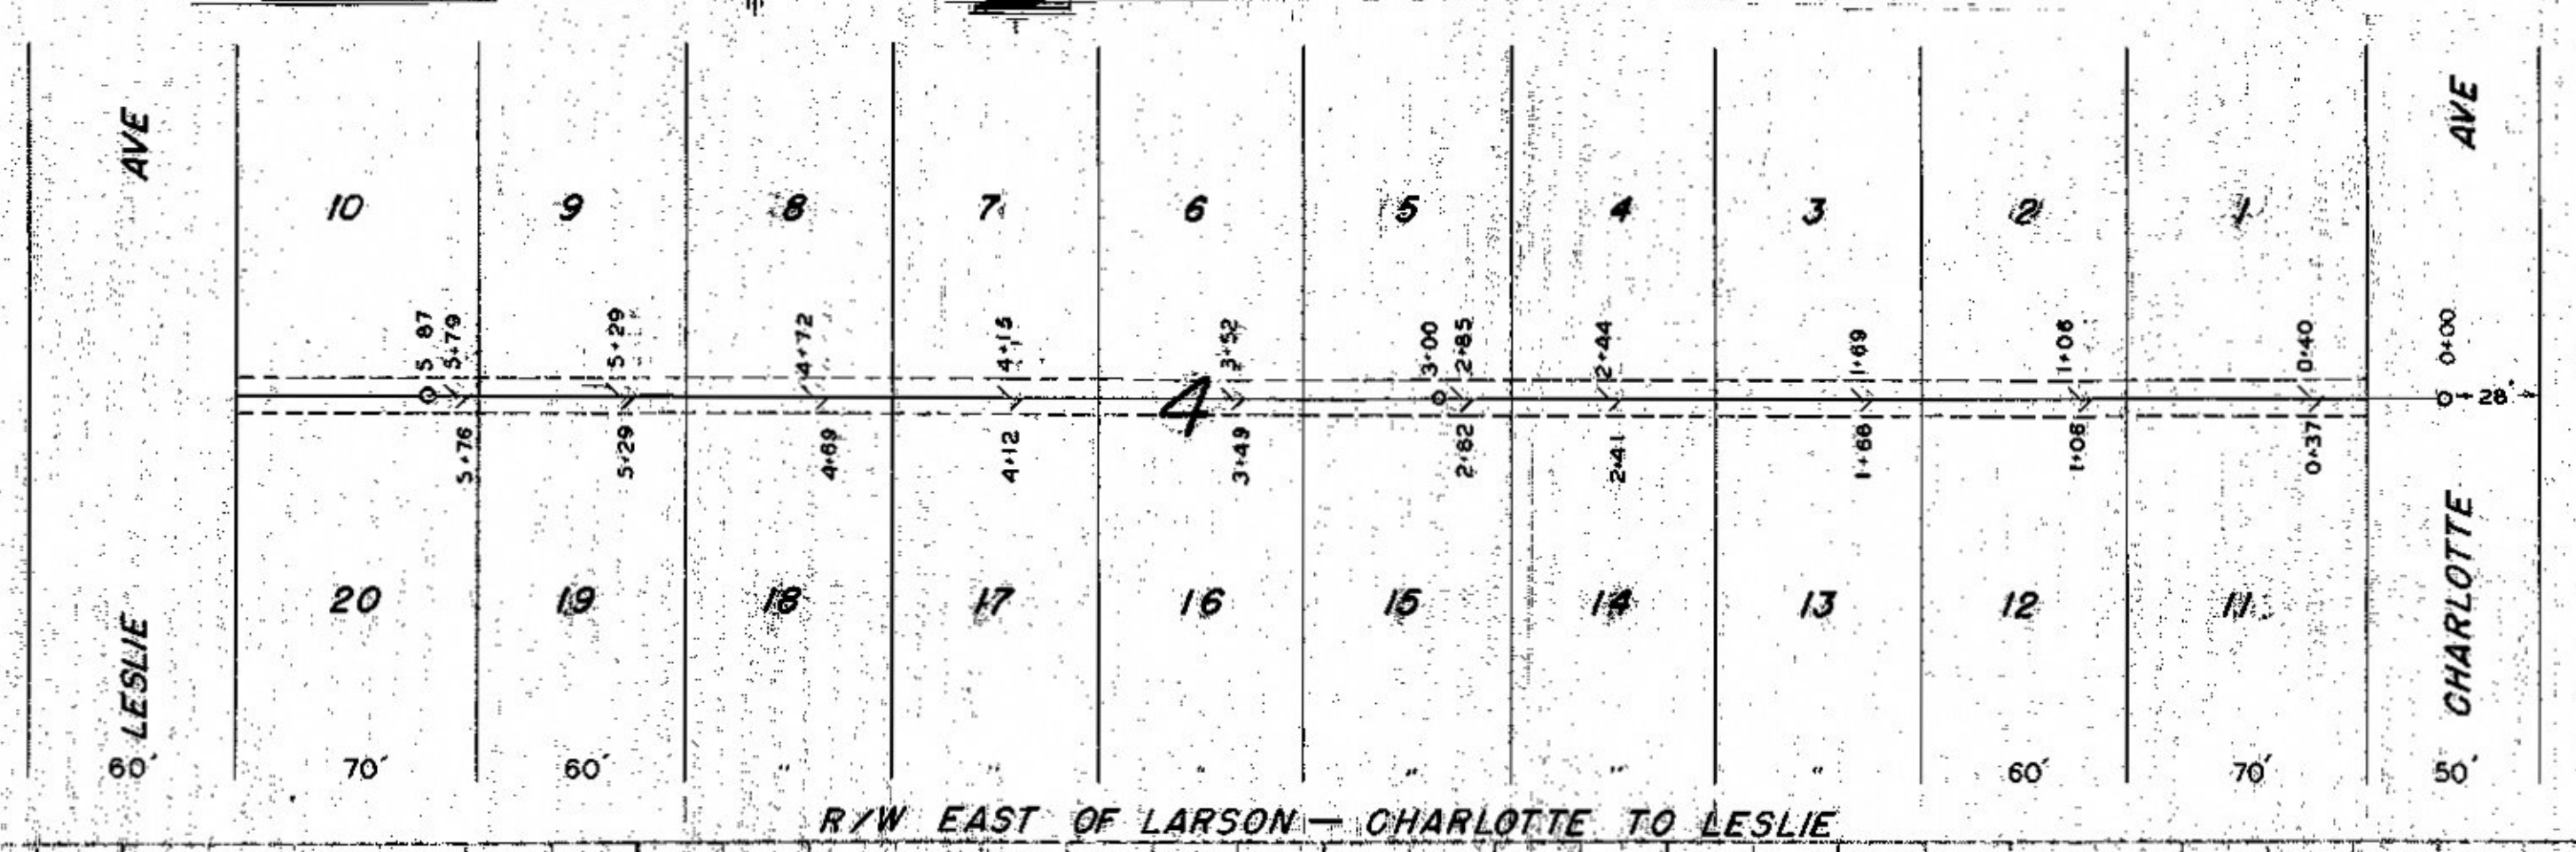

R/W EAST OF LARSON - CHARLOTTE TO LESLIE

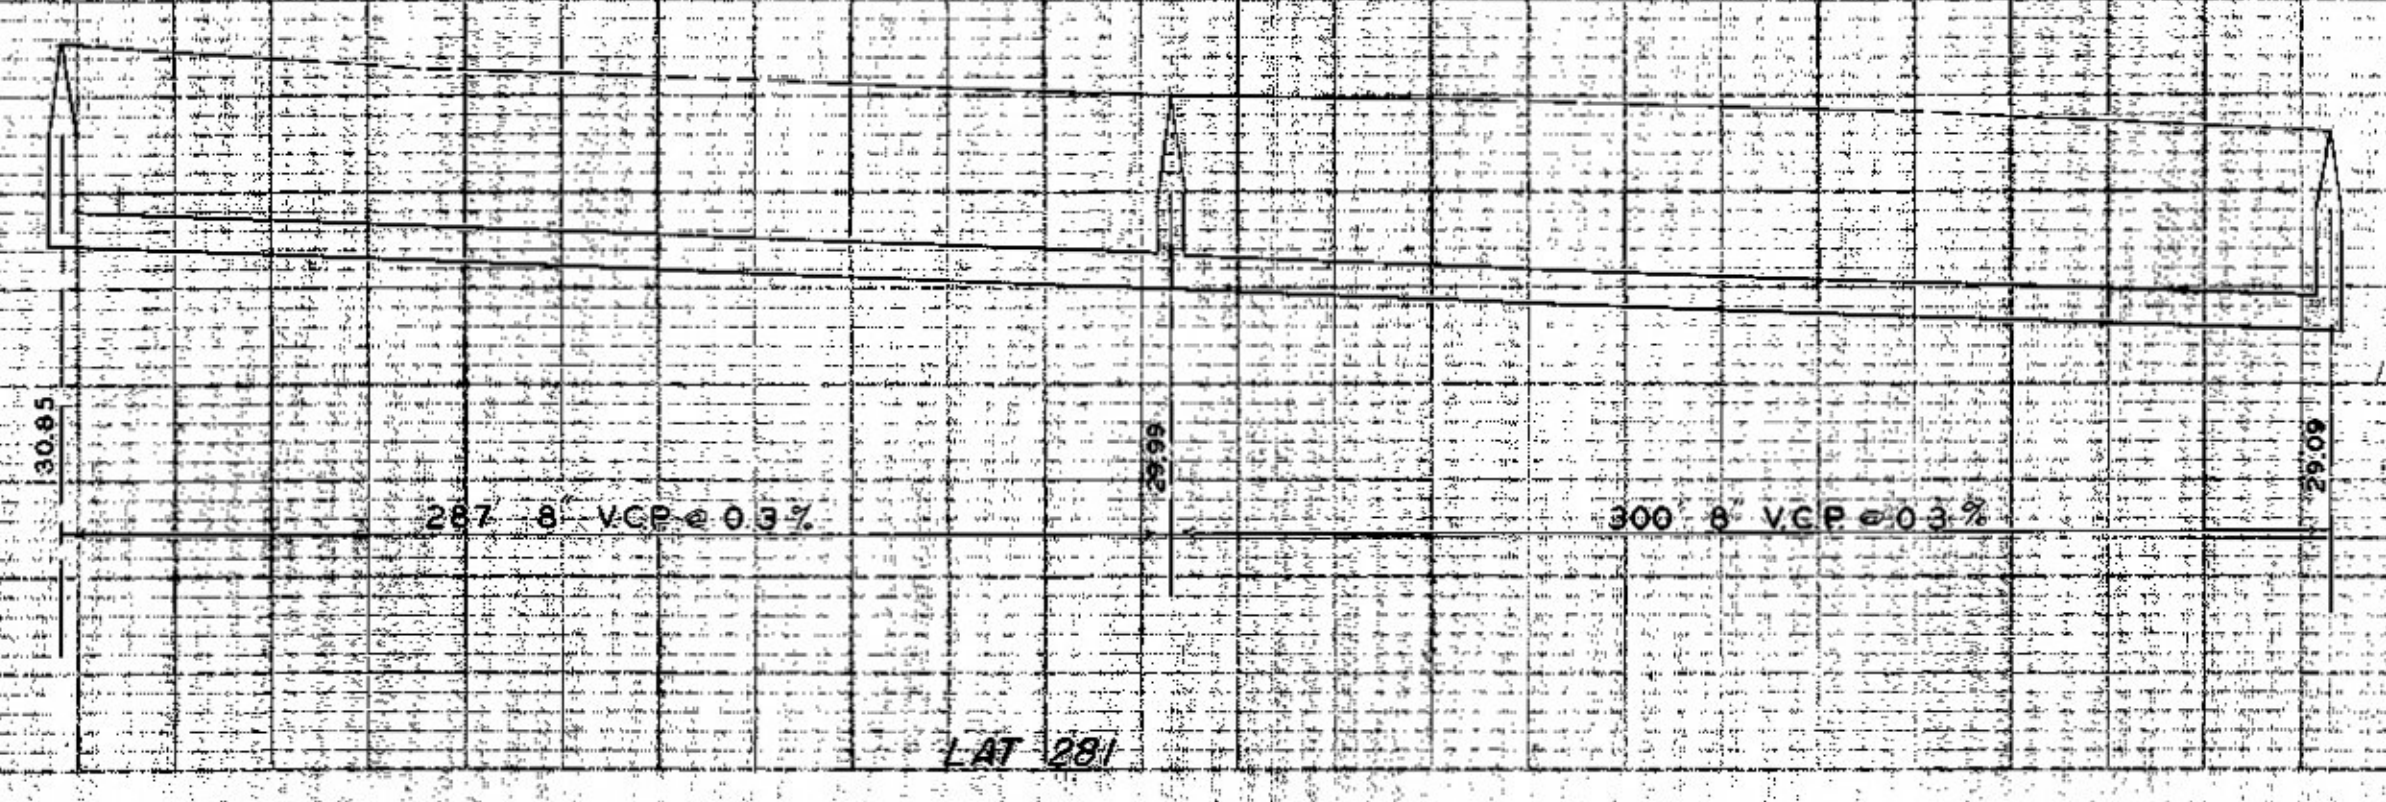

"AS BUILT PLAN"
 CONSTRUCTED - SEPT, 1952
 BY
 H.J. TAYLOR CONST. CO.
 SALINA, KANSAS