



SURVEYED BY DATE
 PLAN
 NOTE BOOK NO.
 ALIGNMENT CHECKED BY OF WAY CHECKED NO.

SURVEYED BY DATE
 PROFILE
 NOTE BOOK NO.
 GRADES CHECKED BY M.F. NOTED BY
 STRUCTURE WITHIN CHECKED NO.

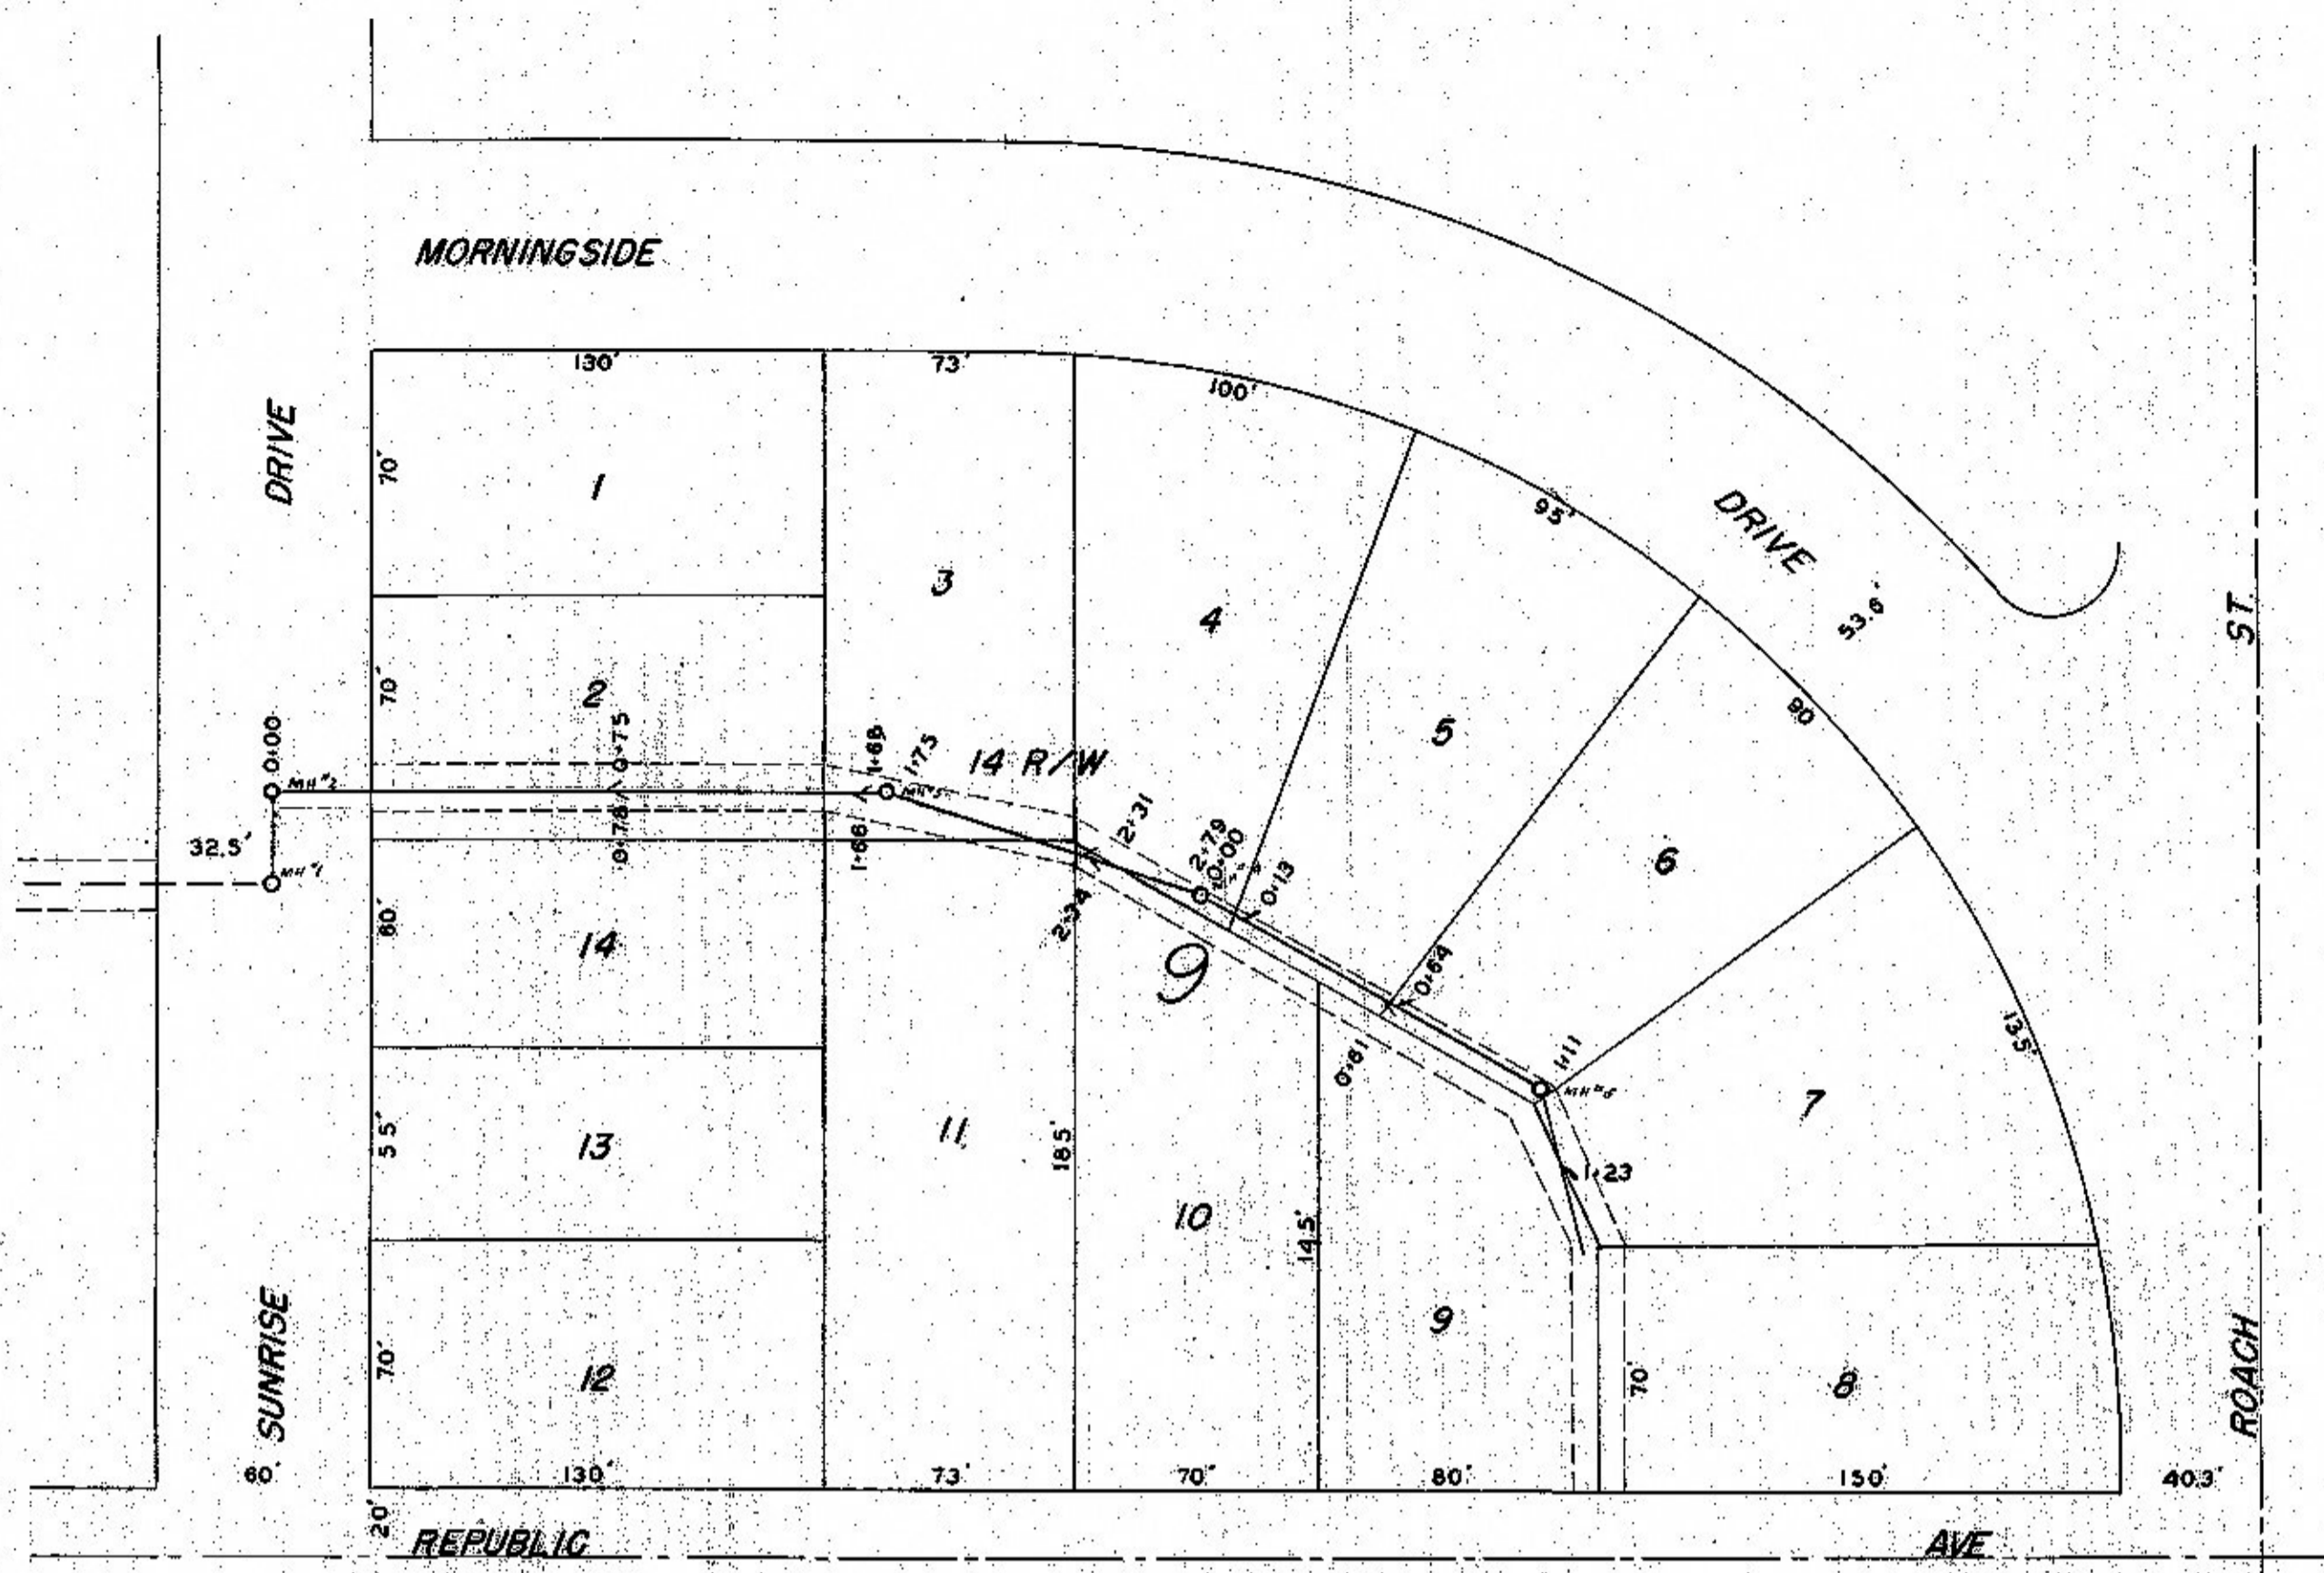

R/W N. REPUBLIC — SUNRISE TO ROACH

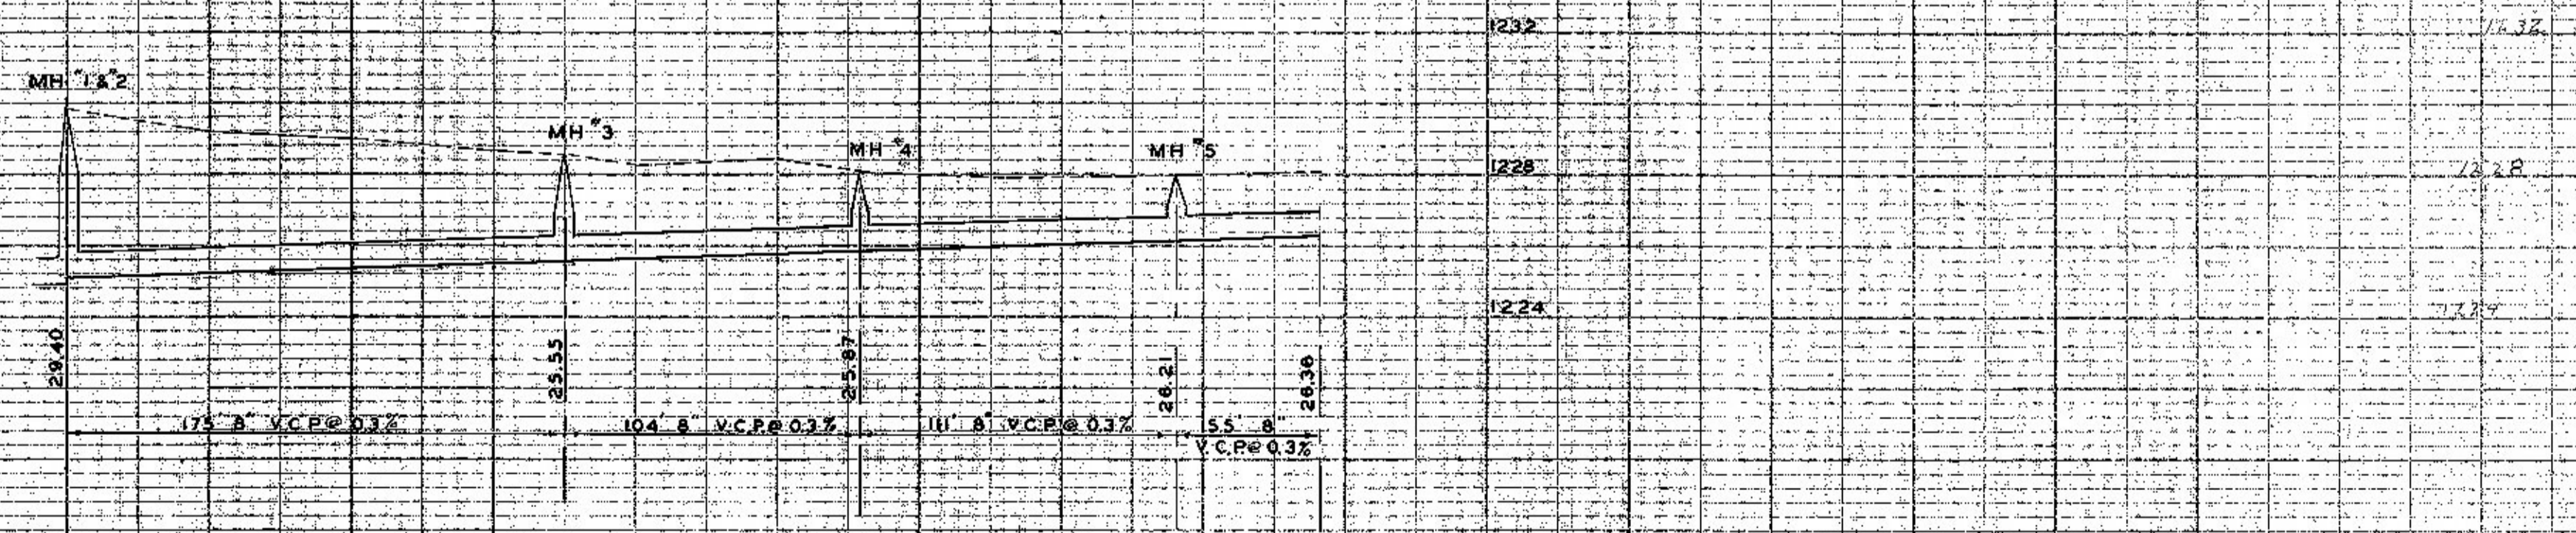

LAT 284