
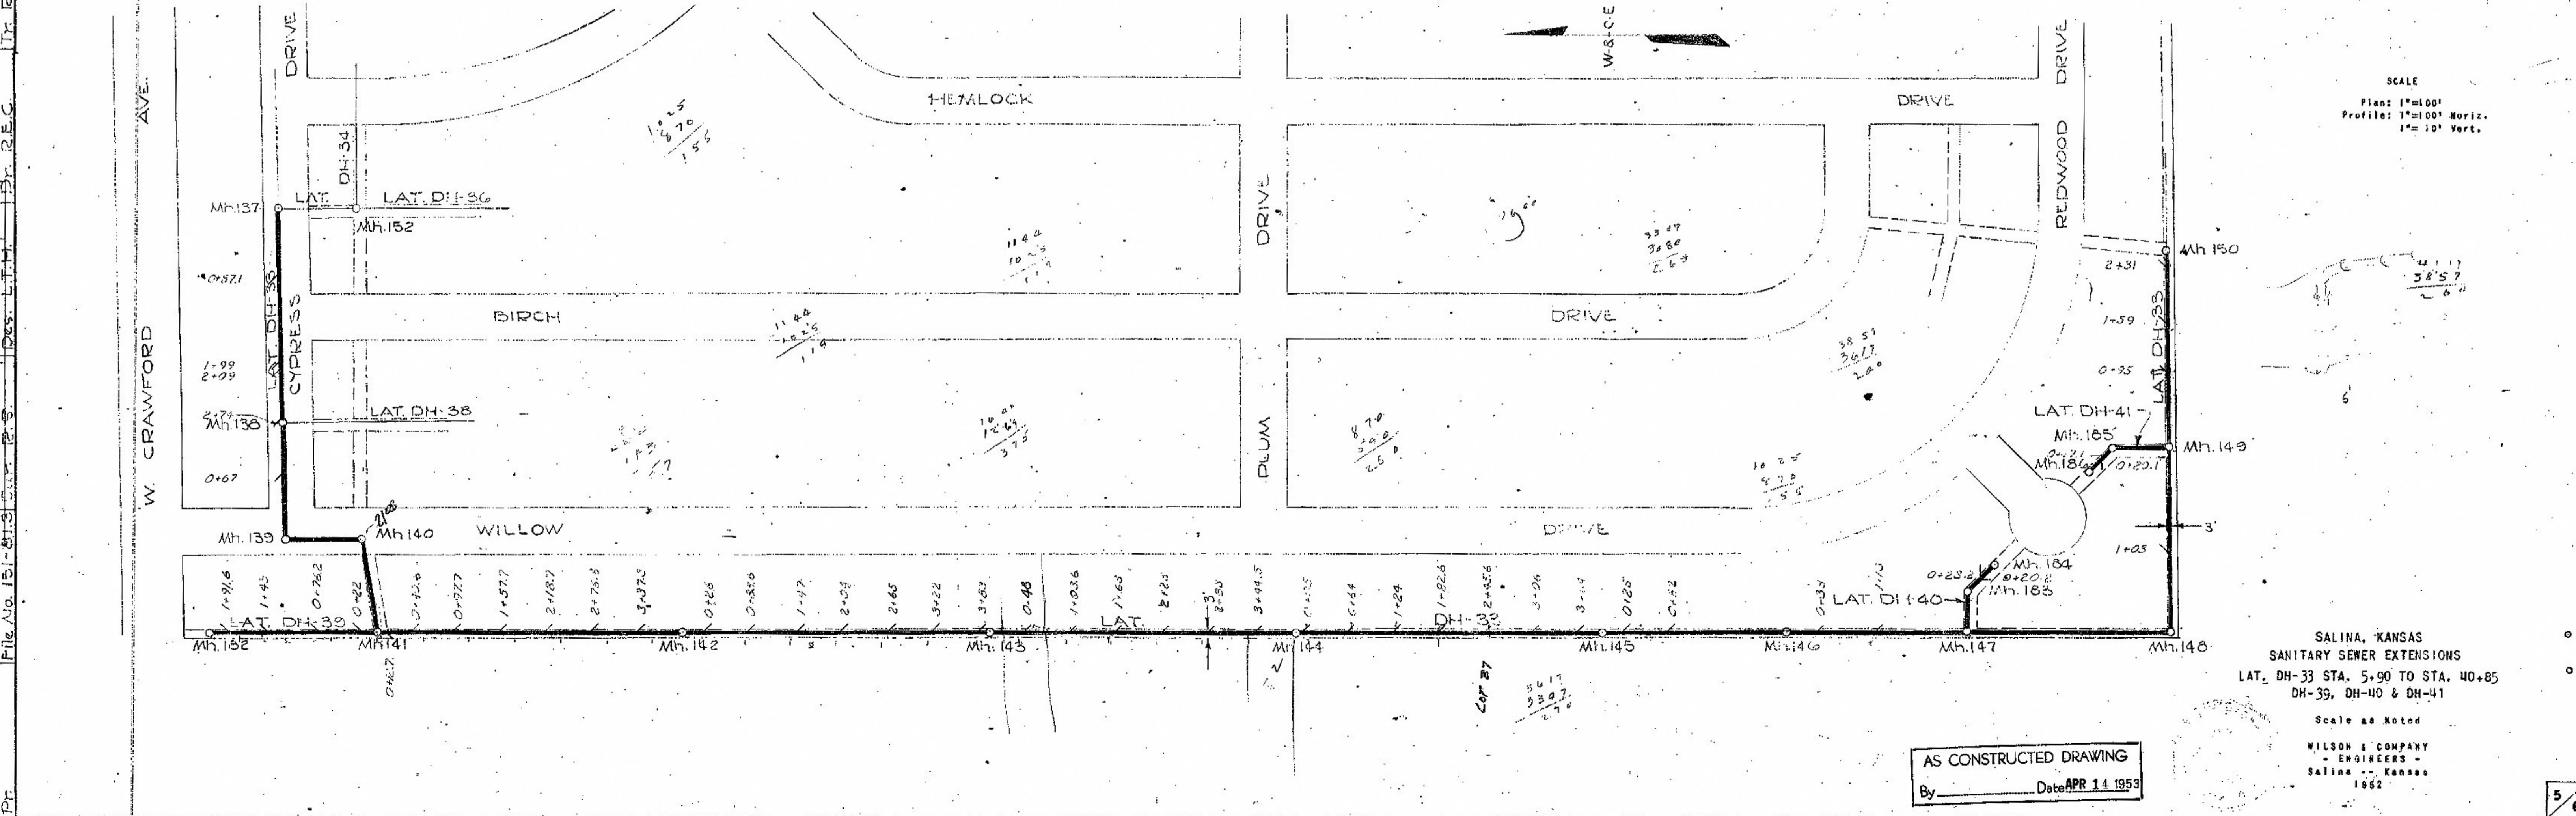


DATE	
BY	
CHECKED	
DESIGNED	
APPROVED	
PROJECT	Tr. REC. 126, Ch. 1
DESCRIPTION	Sanitary Sewer Extensions
LOCATION	W. Crawford Ave. to Redwood Drive
SCALE	1" = 100'

DATE	
BY	
CHECKED	
DESIGNED	
APPROVED	
PROJECT	Tr. REC. 126, Ch. 1
DESCRIPTION	Sanitary Sewer Extensions
LOCATION	W. Crawford Ave. to Redwood Drive
SCALE	1" = 100'

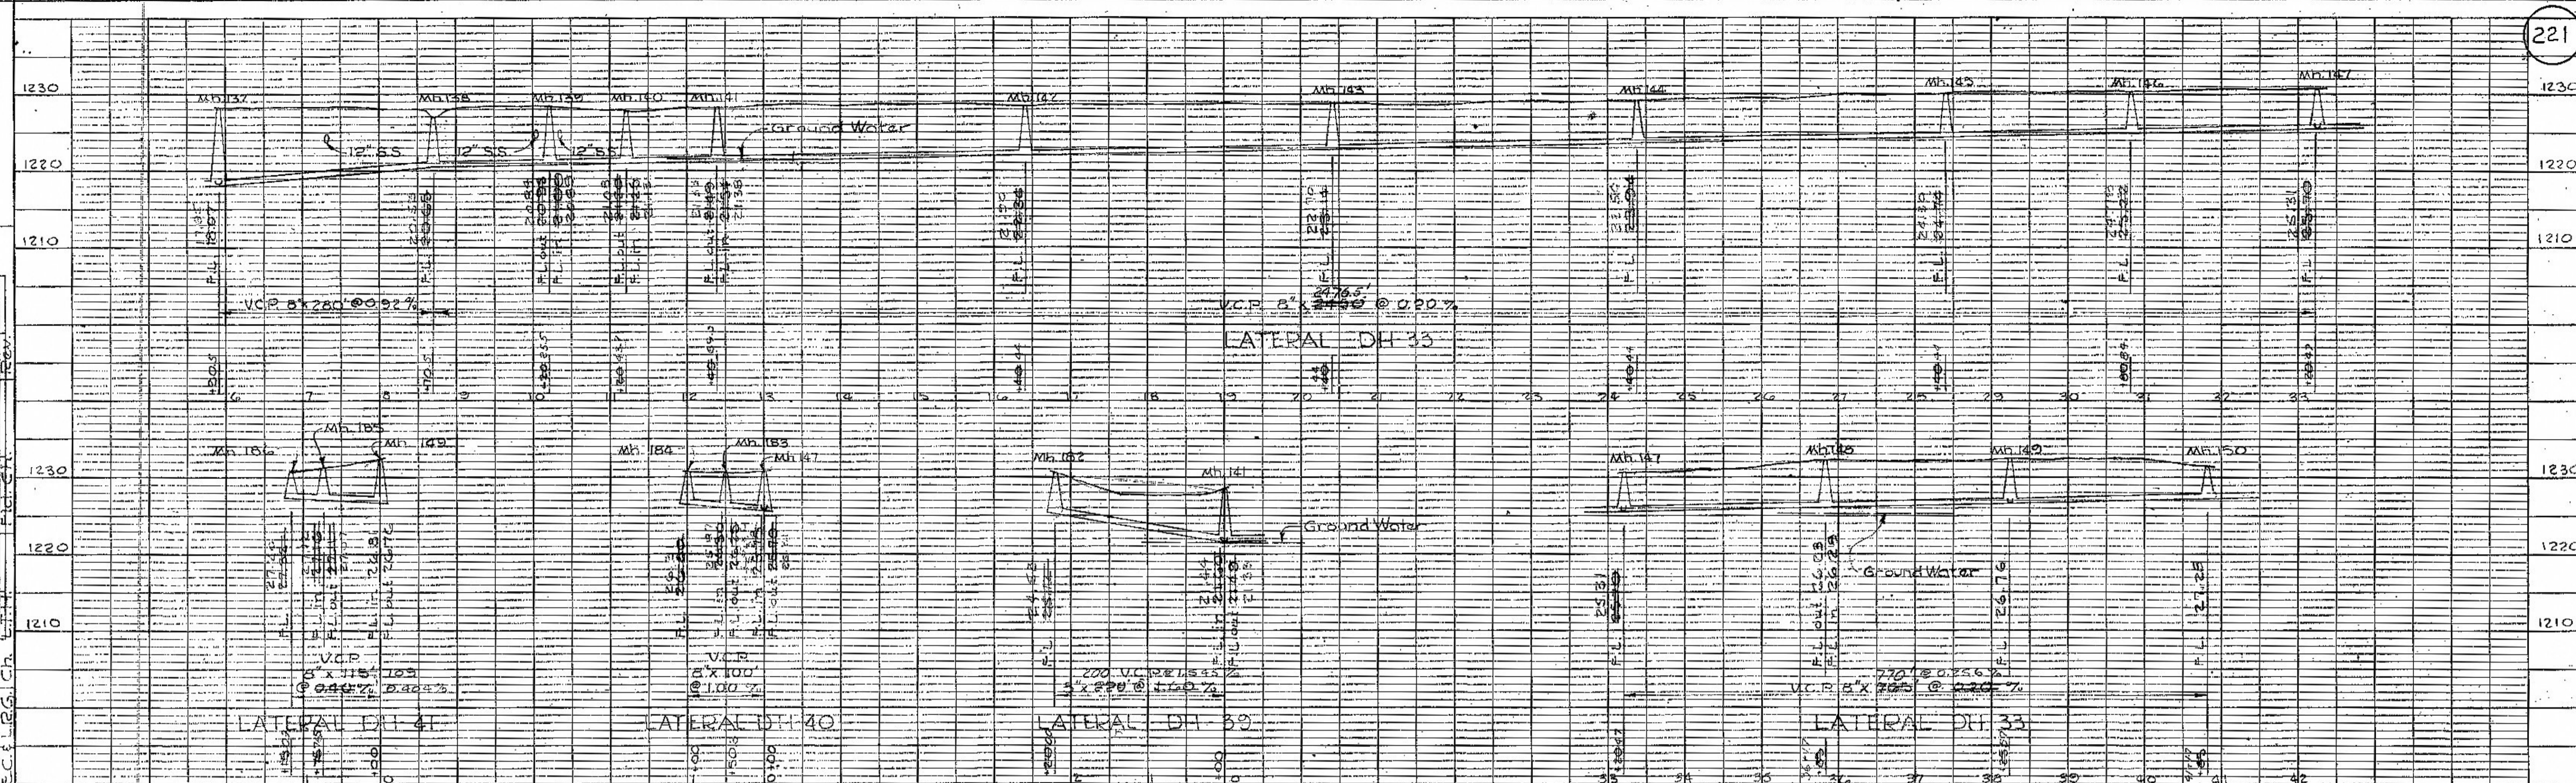

SALINA, KANSAS
SANITARY SEWER EXTENSIONS
LAT. DH-33 STA. 5+90 TO STA. 40+85
DH-39, DH-40 & DH-41

AS CONSTRUCTED DRAWING
By _____ Date APR 14 1953

Scale as Noted
WILSON & COMPANY
ENGINEERS
Salina, Kansas
1952