
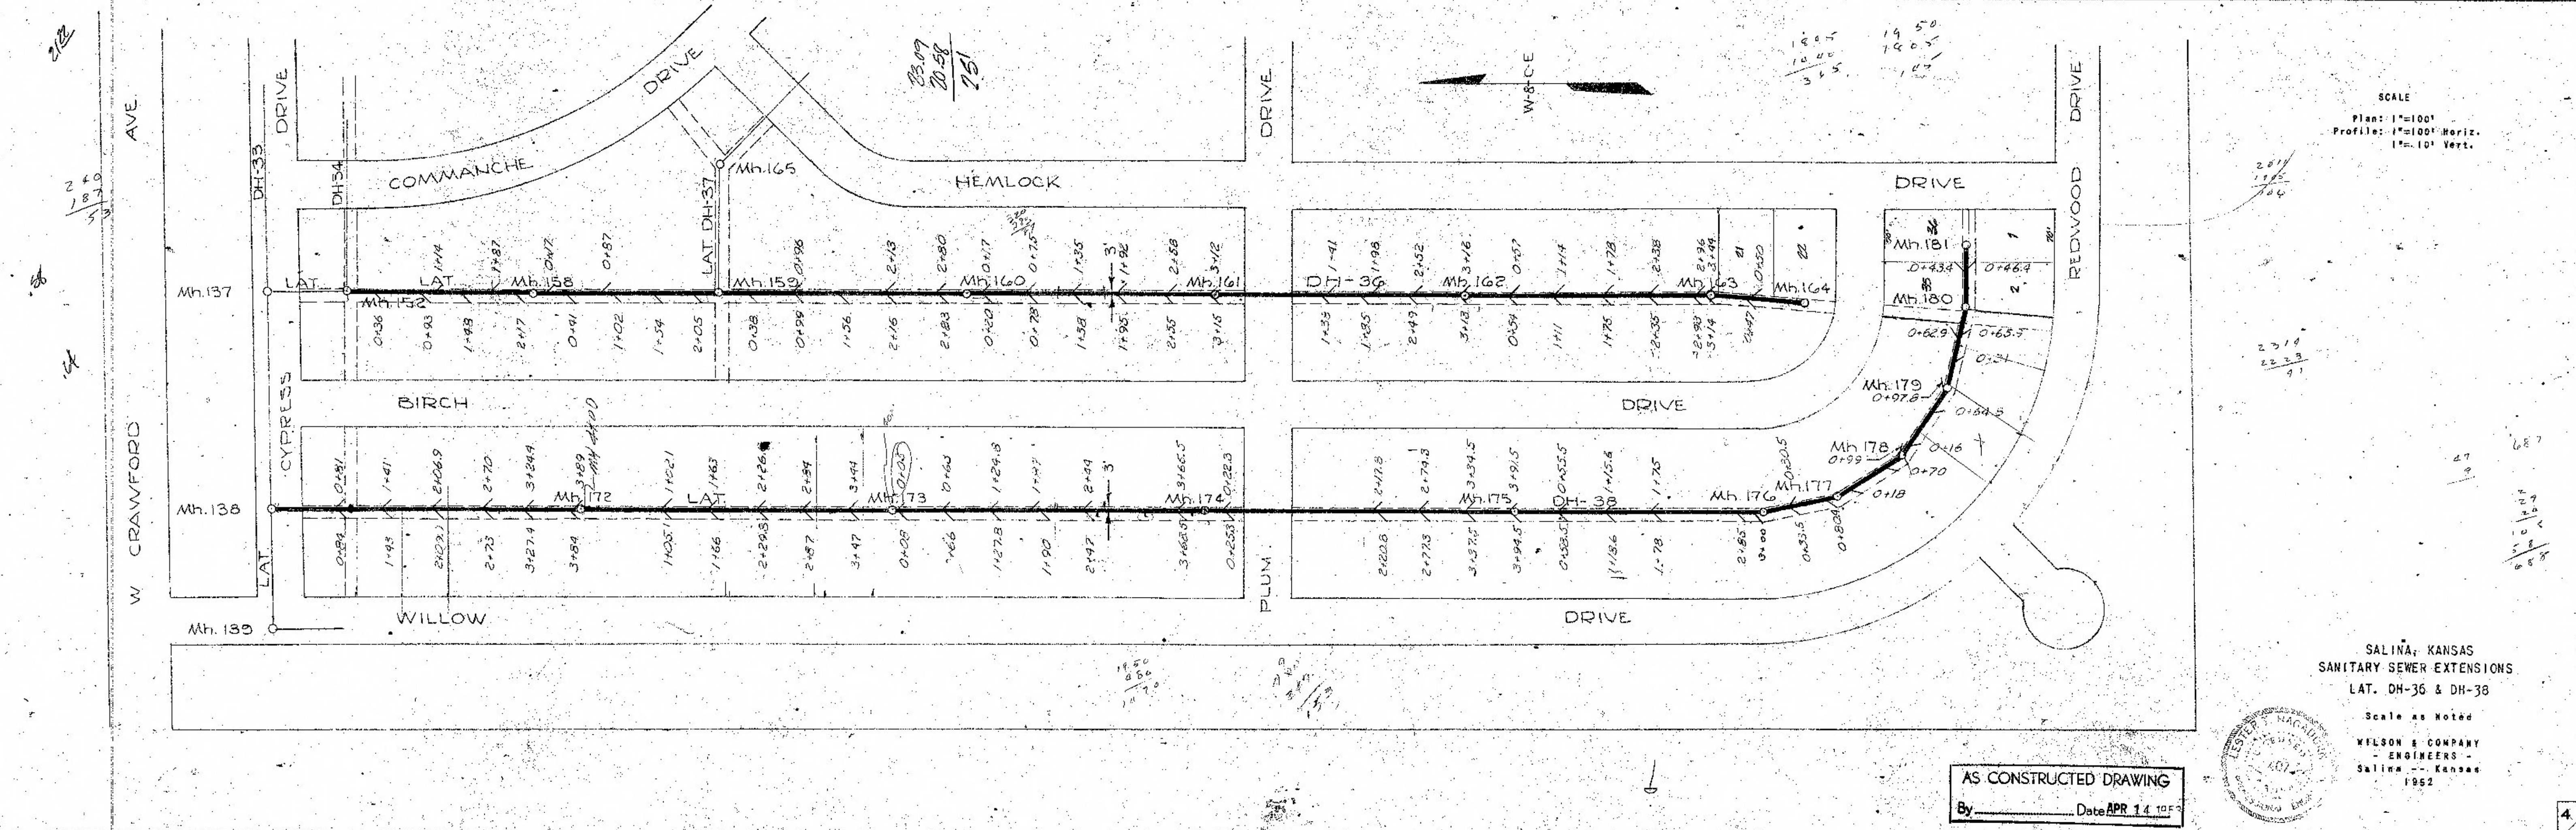


NO.	DATE	BY	REVISION
1			
2			
NO.	DATE	BY	REVISION
1			
2			
3			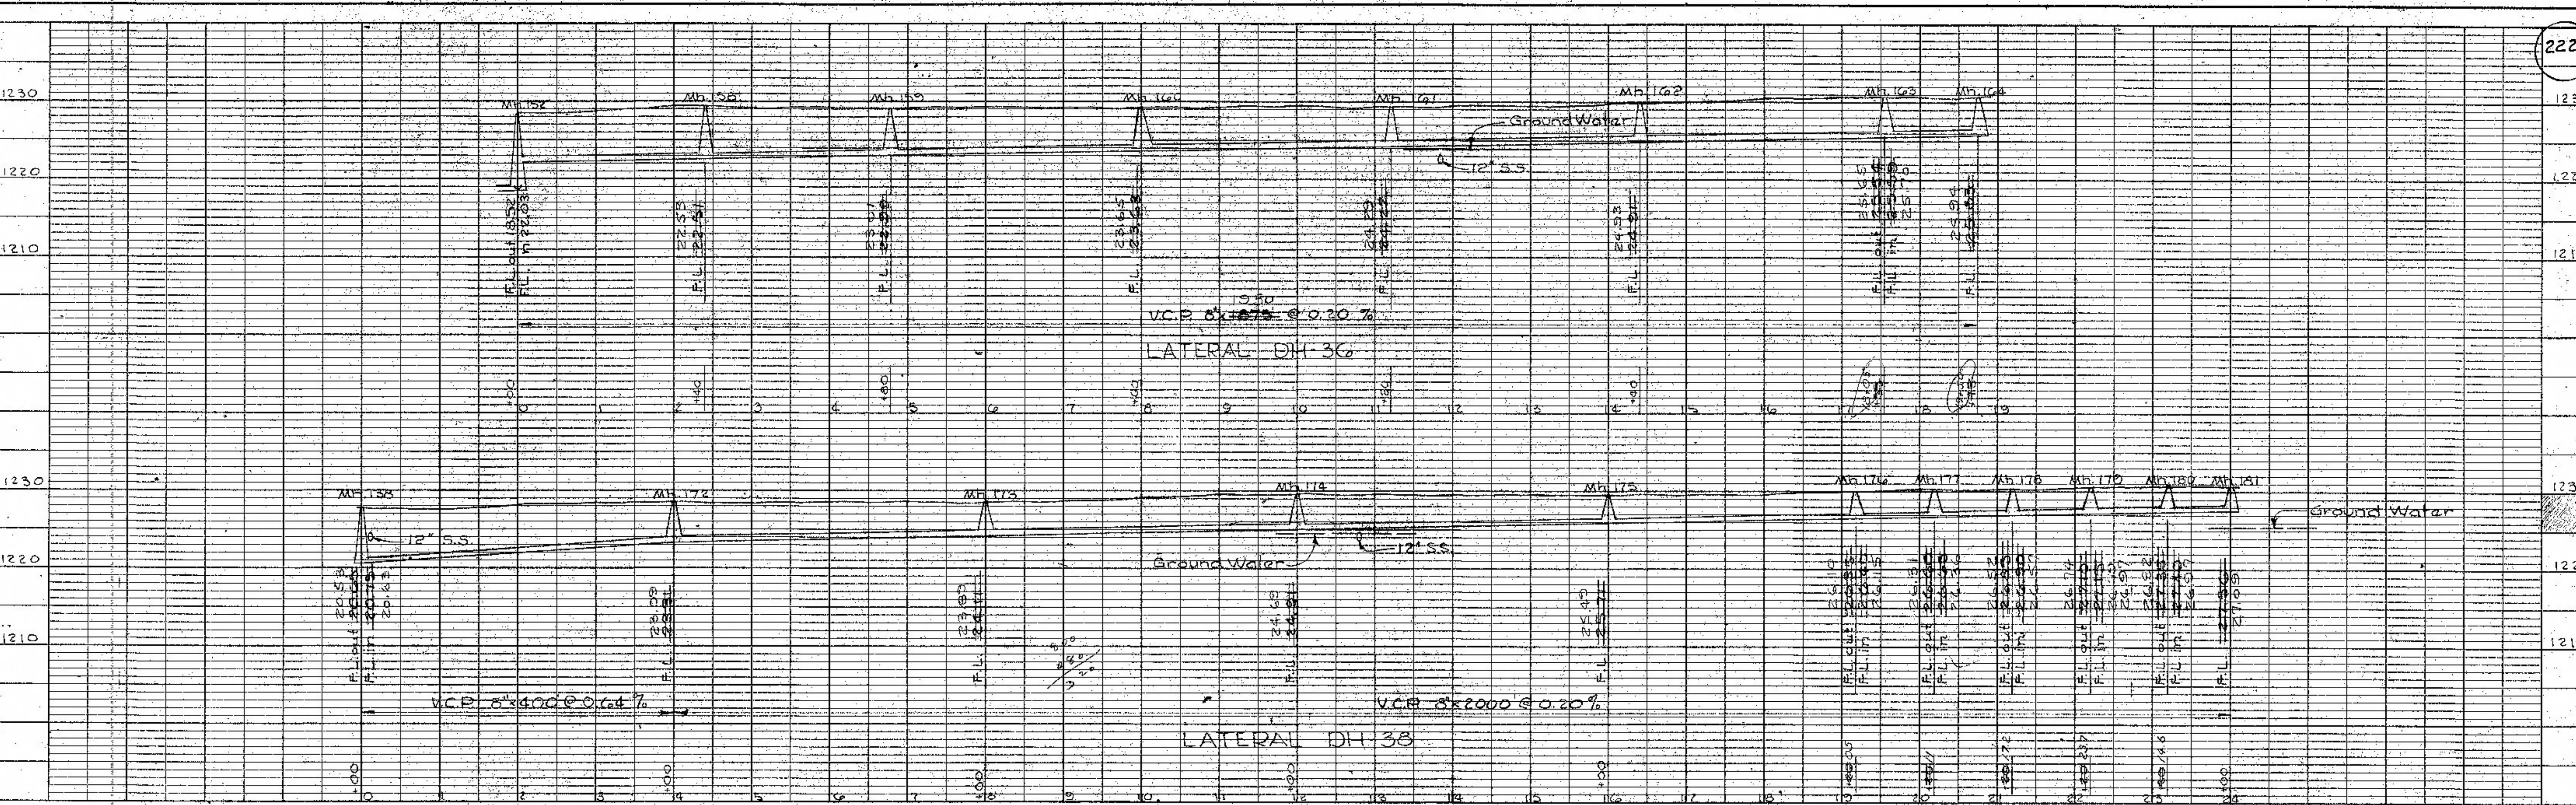
SALINA, KANSAS
 SANITARY SEWER EXTENSIONS
 LAT. DH-36 & DH-38
 Scale as Noted
 WILSON & COMPANY
 ENGINEERS -
 Salina, Kansas
 1952

AS CONSTRUCTED DRAWING
 By _____ Date APR 14 1952