


PROJECT	FILE NO. 151-B17	SUB. K-5
DATE	DES. DATE	CONSTR. DATE
BY	CHECKED	APPROVED
SCALE	PLAN 1"=100'	PROFILE 1"=10' Vert. 1"=100' Horiz.

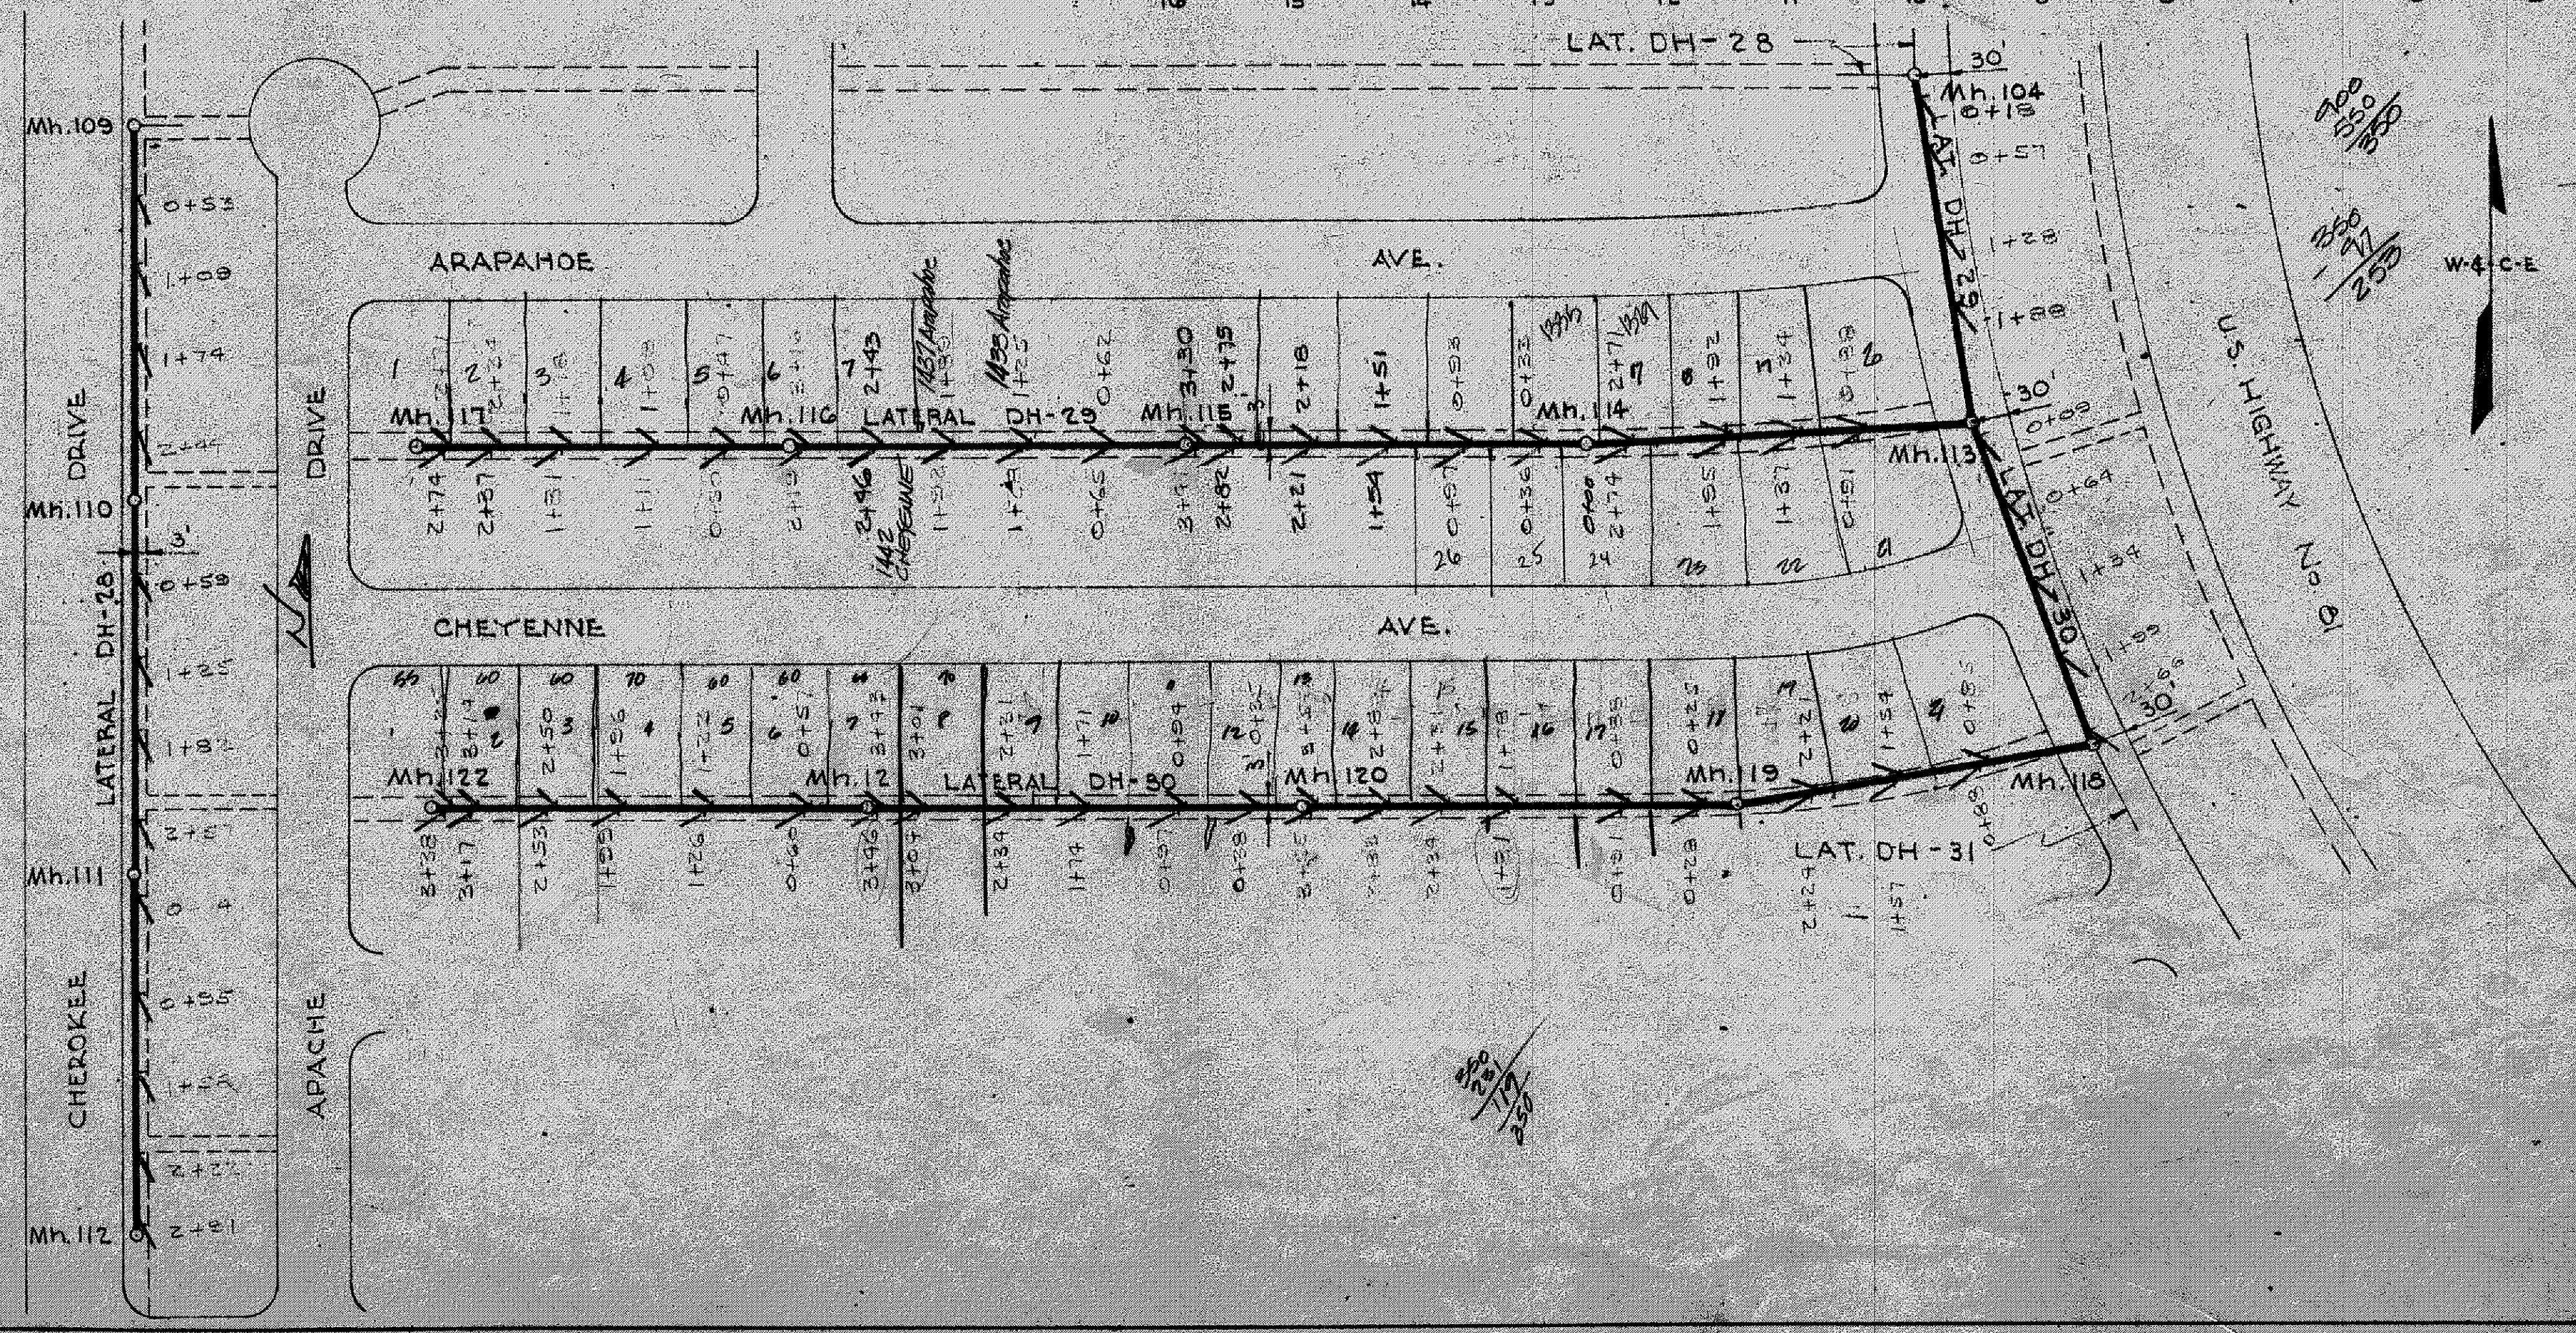

NOTE:
Tops of all manholes to be constructed to finished grade elevation.

SCALE
Plan: 1"=100'
Profile: 1"=10' Vert.
1"=100' Horiz.

SALINA, KANSAS
SANITARY SEWER EXTENSIONS
LAT DH-28 STA 15+70 TO STA 24+60,
DH-29 & DH-30

AS CONSTRUCTED DRAWING
By _____ Date APR 14 1953