

NO.	REVISION
1	AS CONSTRUCTED



NO.	REVISION
1	AS CONSTRUCTED

NO.	REVISION
1	AS CONSTRUCTED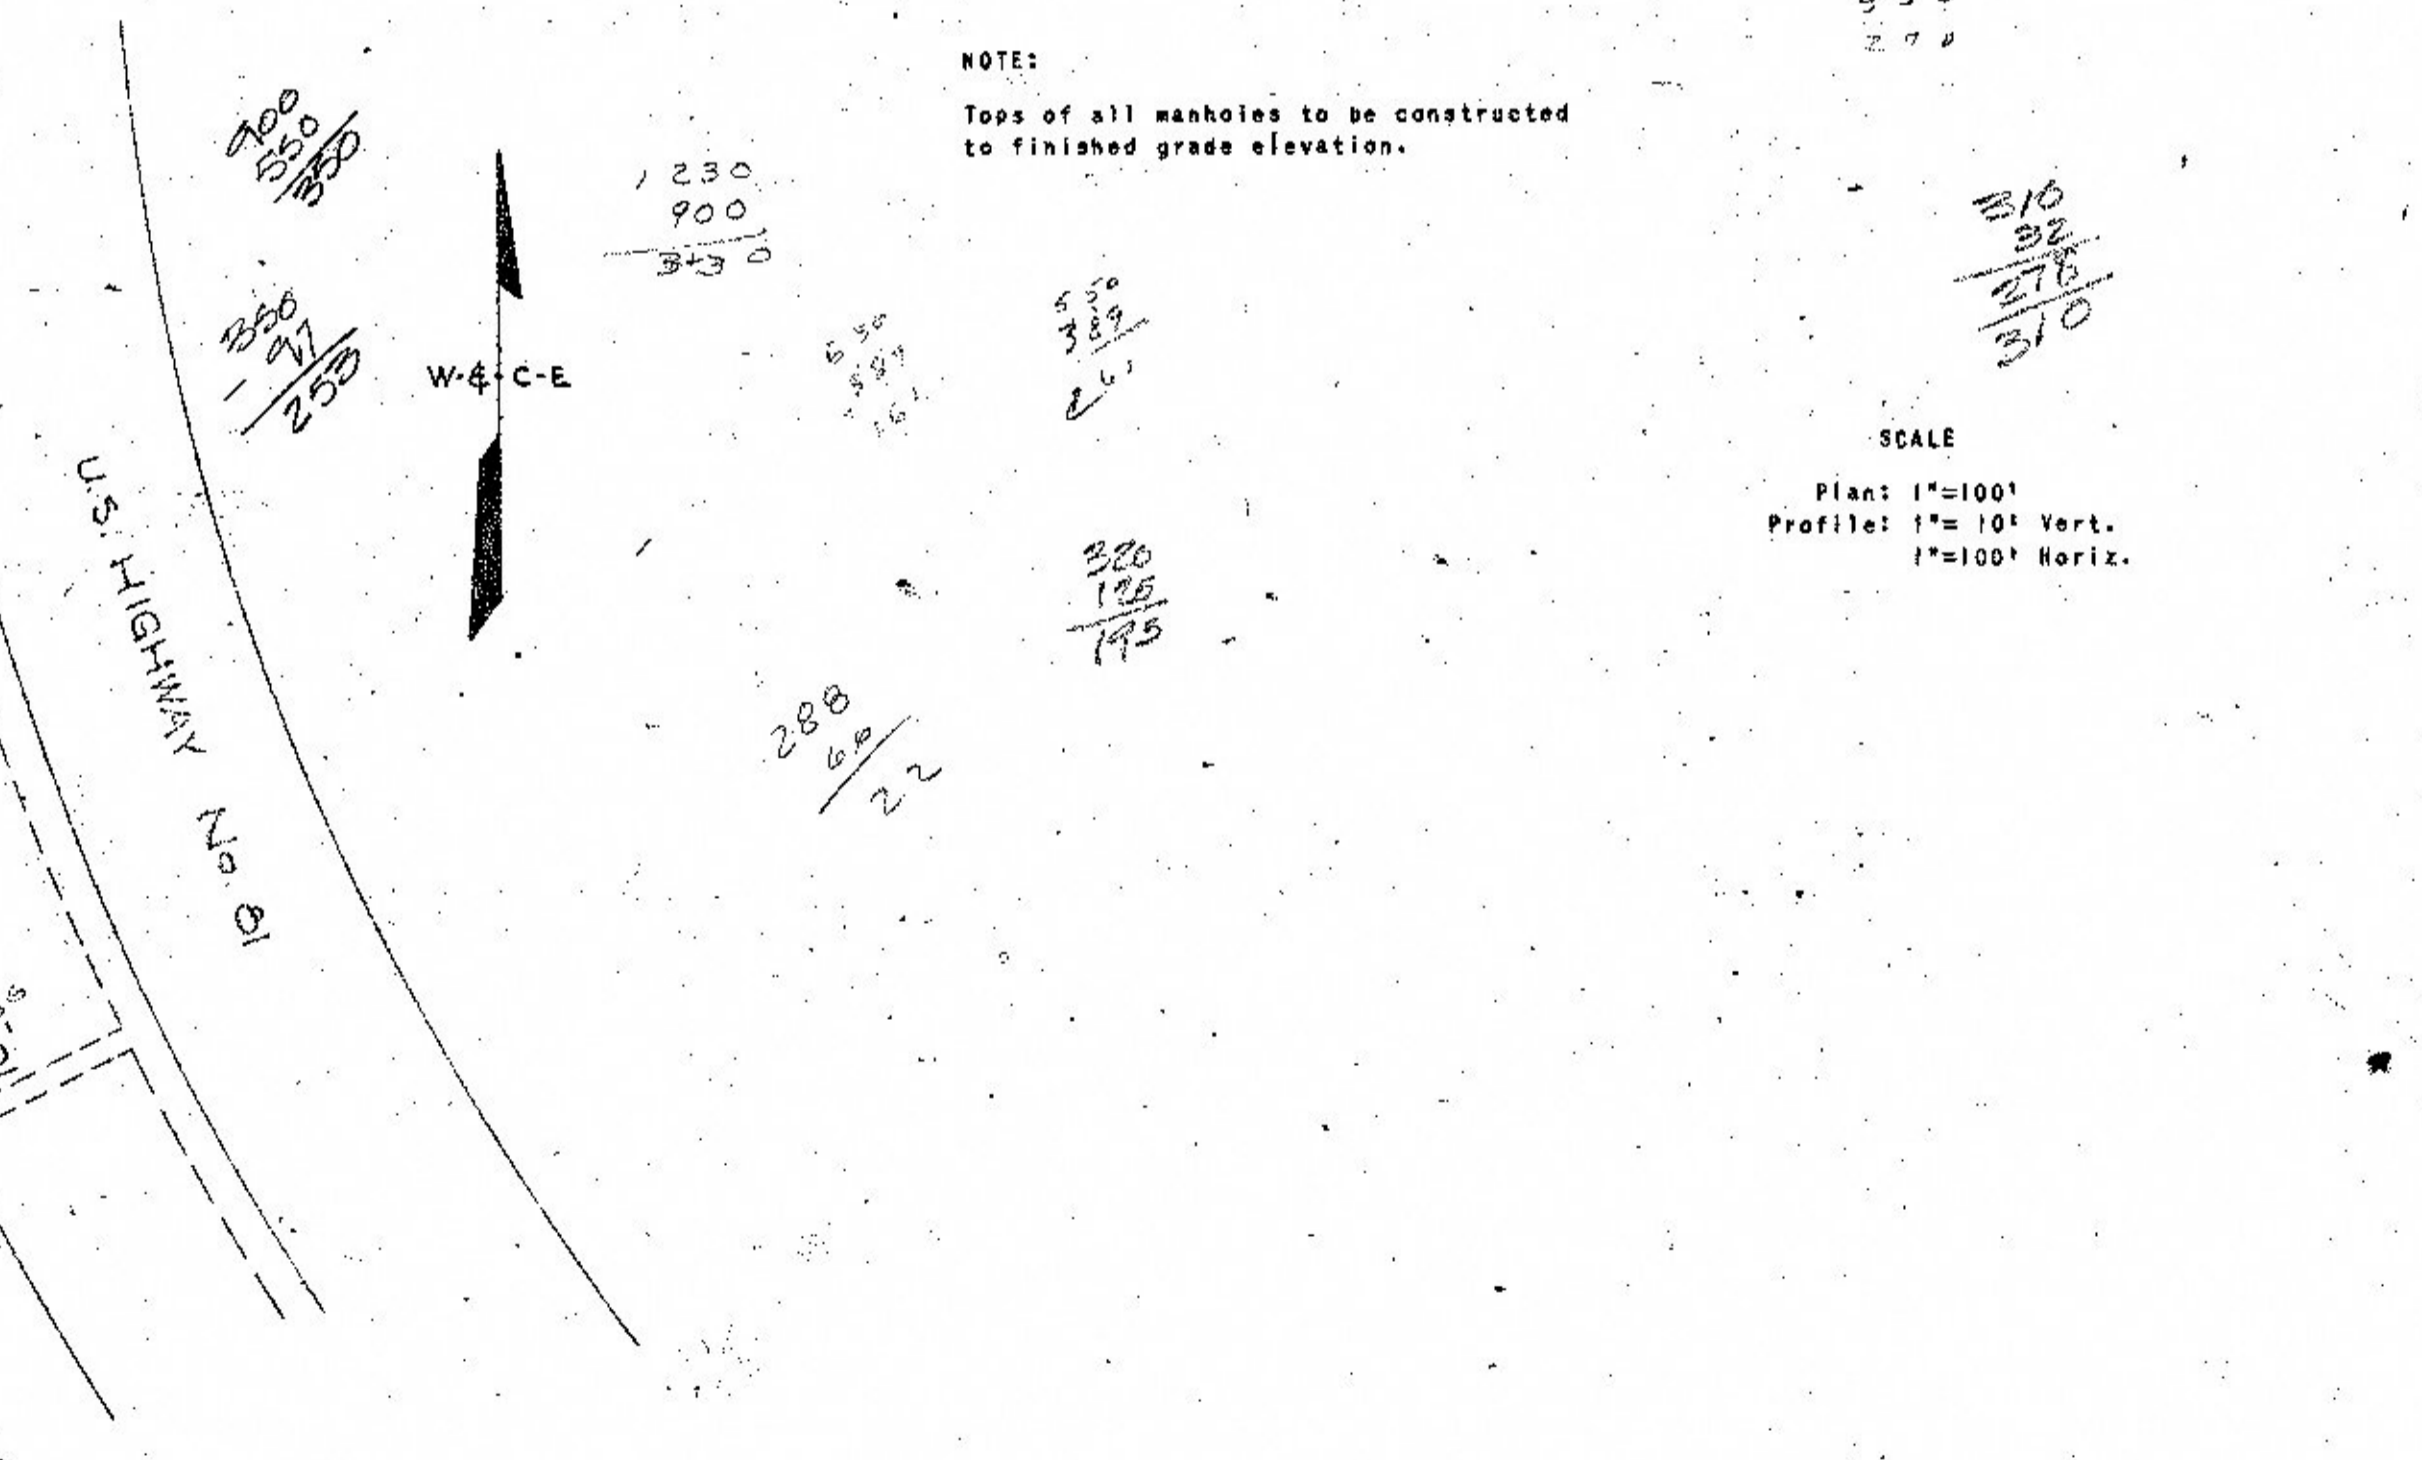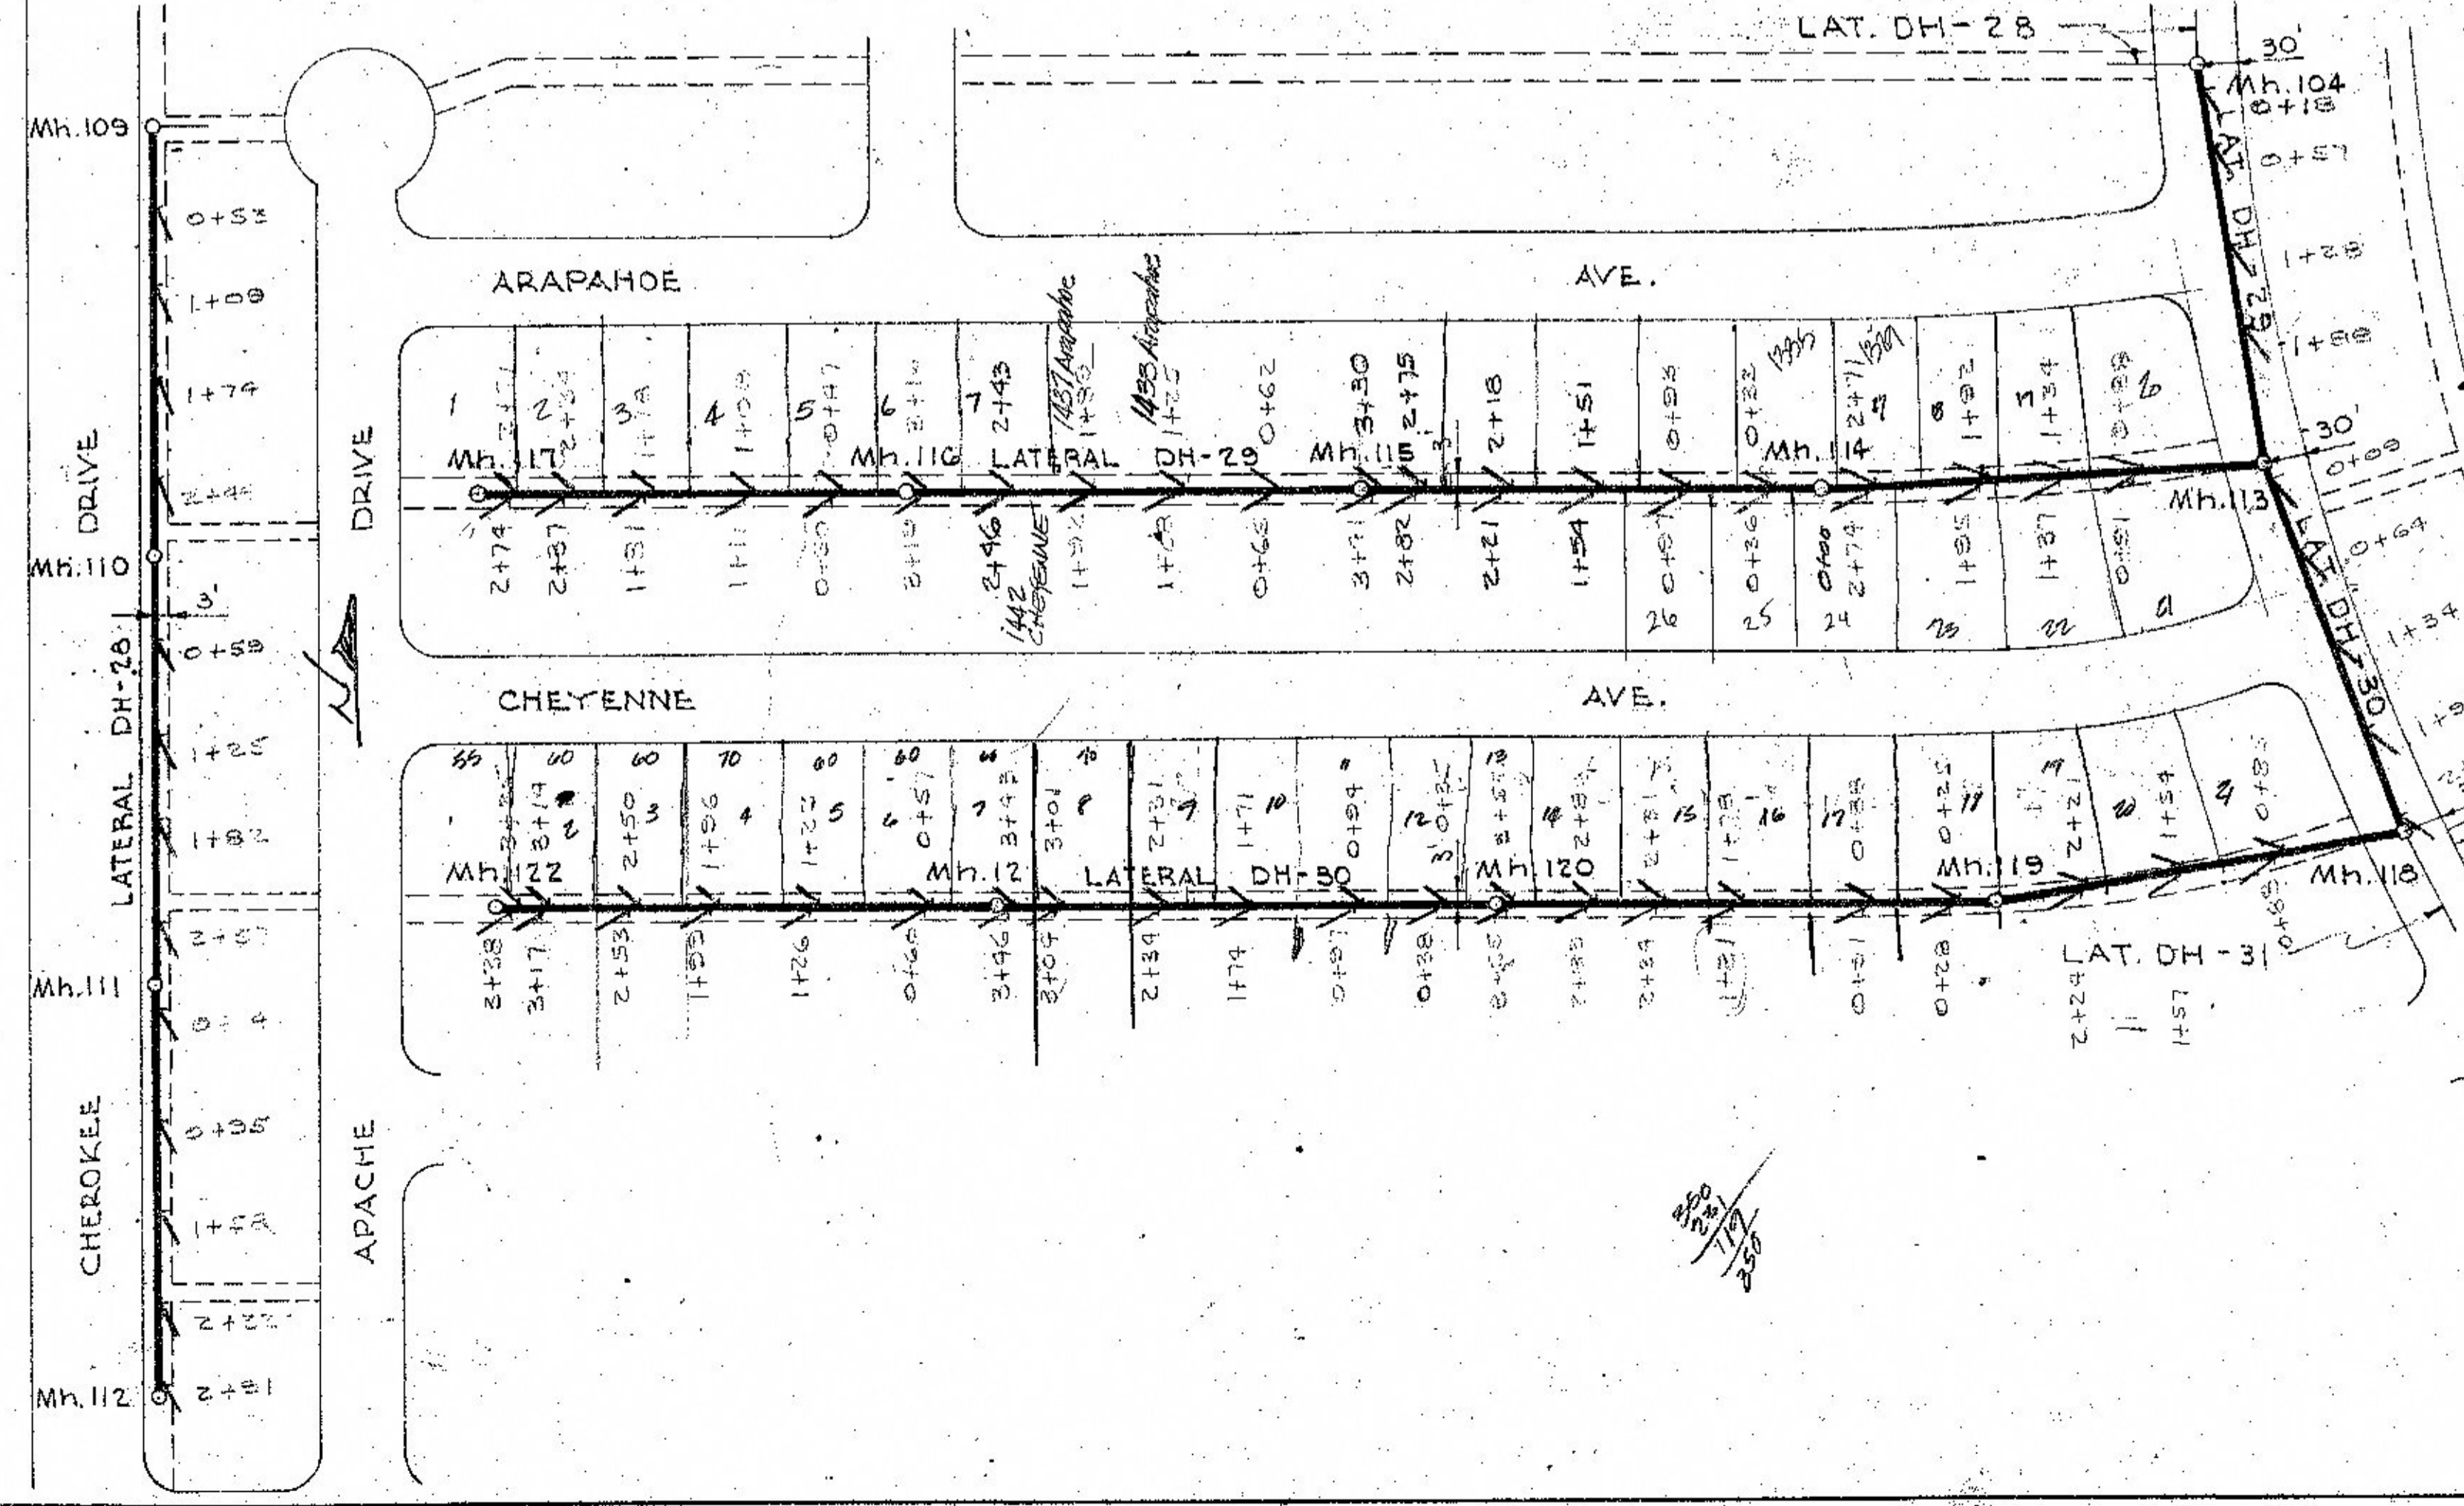

AS CONSTRUCTED DRAWING
 By _____ Date APR 14 1952



SALINA, KANSAS
 SANITARY SEWER EXTENSIONS
 LAT DH-28 STA 15+70 TO STA 24+60,
 DH-29 & DH-30
 Scale as Noted
 WILSON & COMPANY
 ENGINEERS -
 Salina -- Kansas
 1952