


REVISIONS

NO.	DATE	BY	REVISION
1			
2			
3			
4			
5			
6			
7			
8			
9			
10			

PROFILES

NO.	DATE	BY	REVISION
1			
2			
3			
4			
5			
6			
7			
8			
9			
10			

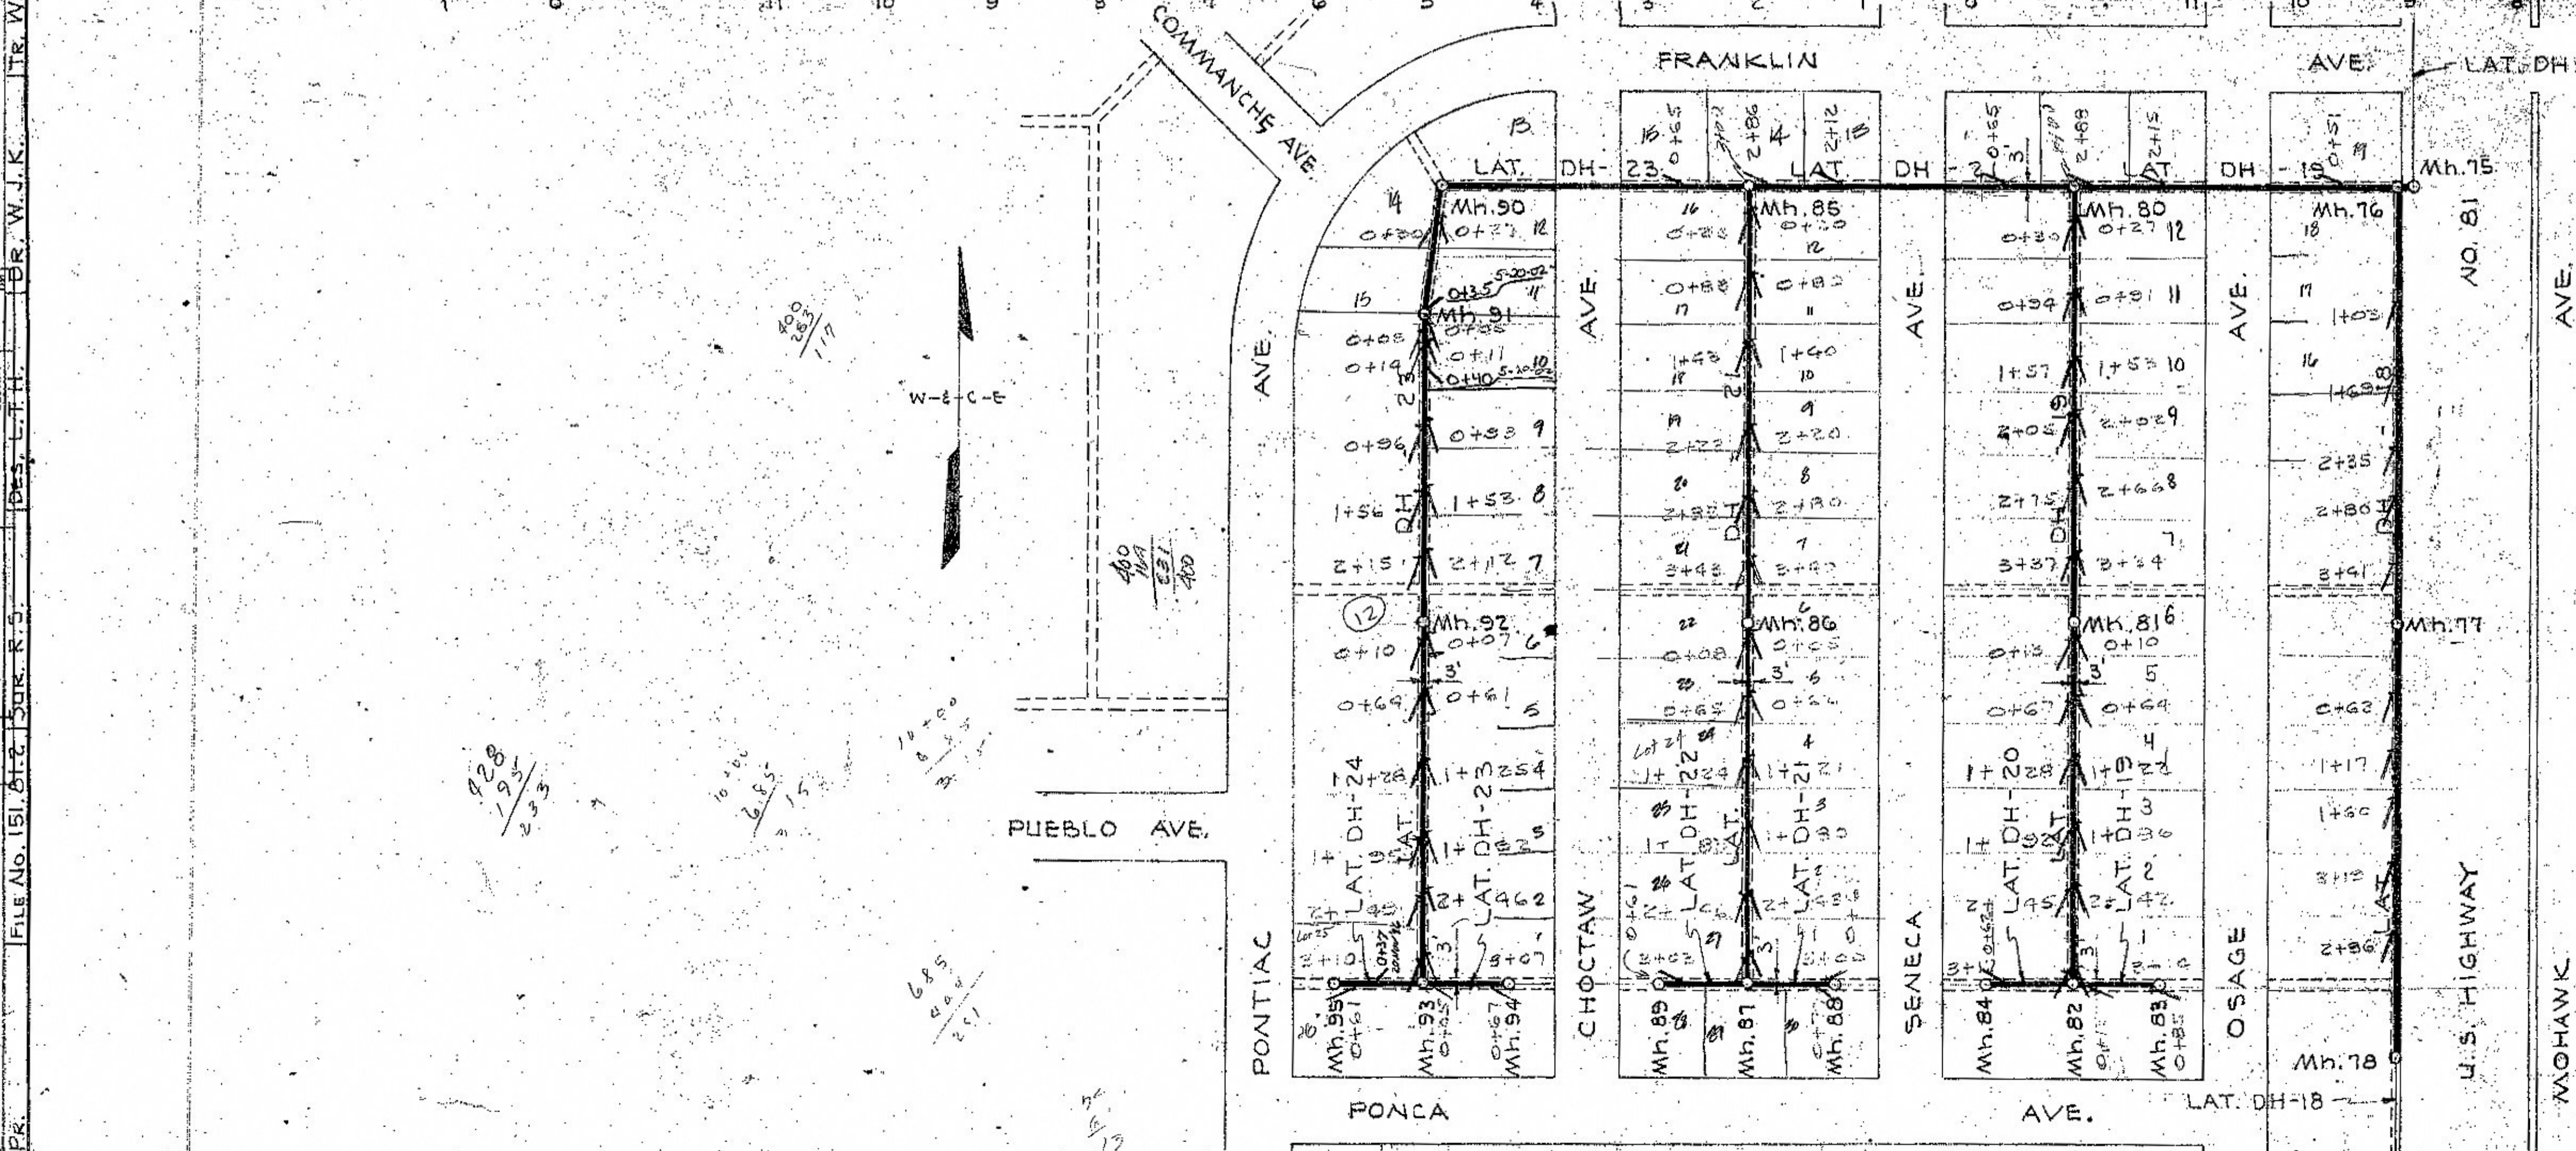

NOTE: Tops of all manholes to be constructed to finished grade elevation.

SCALE: Plan: 1"=100', Profile: 1"=10' Vert., 1"=100' Horiz.

AS CONSTRUCTED DRAWING
By _____ Date APR 14 1953

SALINA, KANSAS
SANITARY SEWER EXTENSIONS
LAT DH-18 STA 0+00 TO STA 13+15,
DH-19, DH-20, DH-21, DH-22, DH-23, DH-24
Scale as Noted
WILSON & COMPANY
ENGINEERS
Salina, Kansas
1952

Handwritten notes and calculations are present in the lower right quadrant, including a scale diagram and various numerical values.