
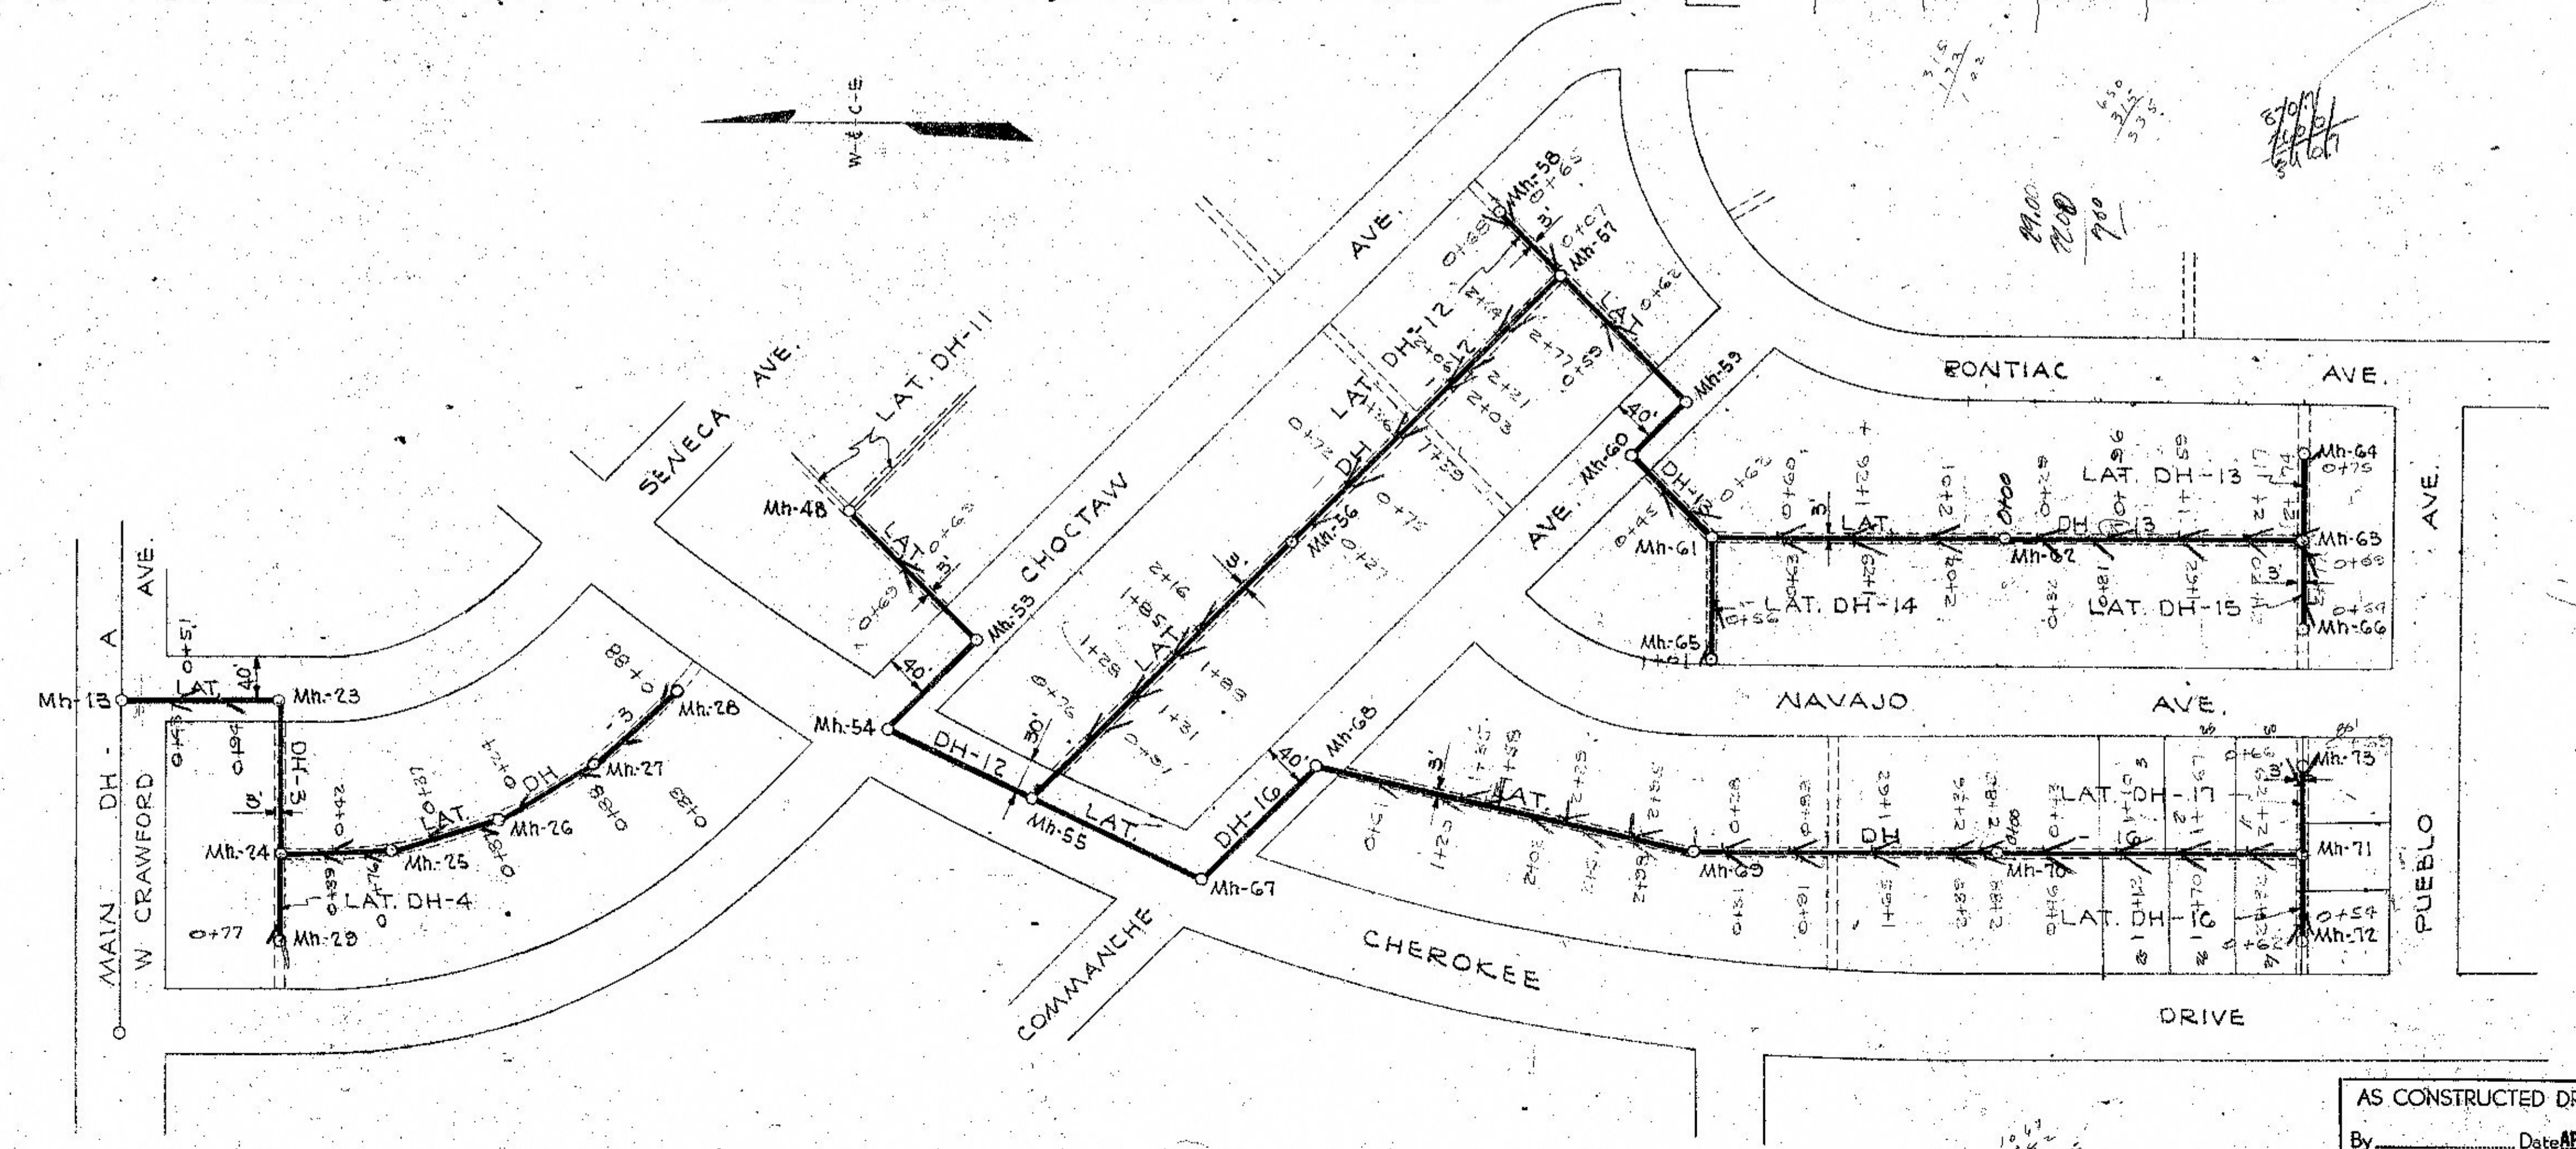


PROJECT	STATE
NO.	
DATE	

DESIGNER	DATE
CHECKER	
APPROVER	

NO.	DATE

NO.	DATE

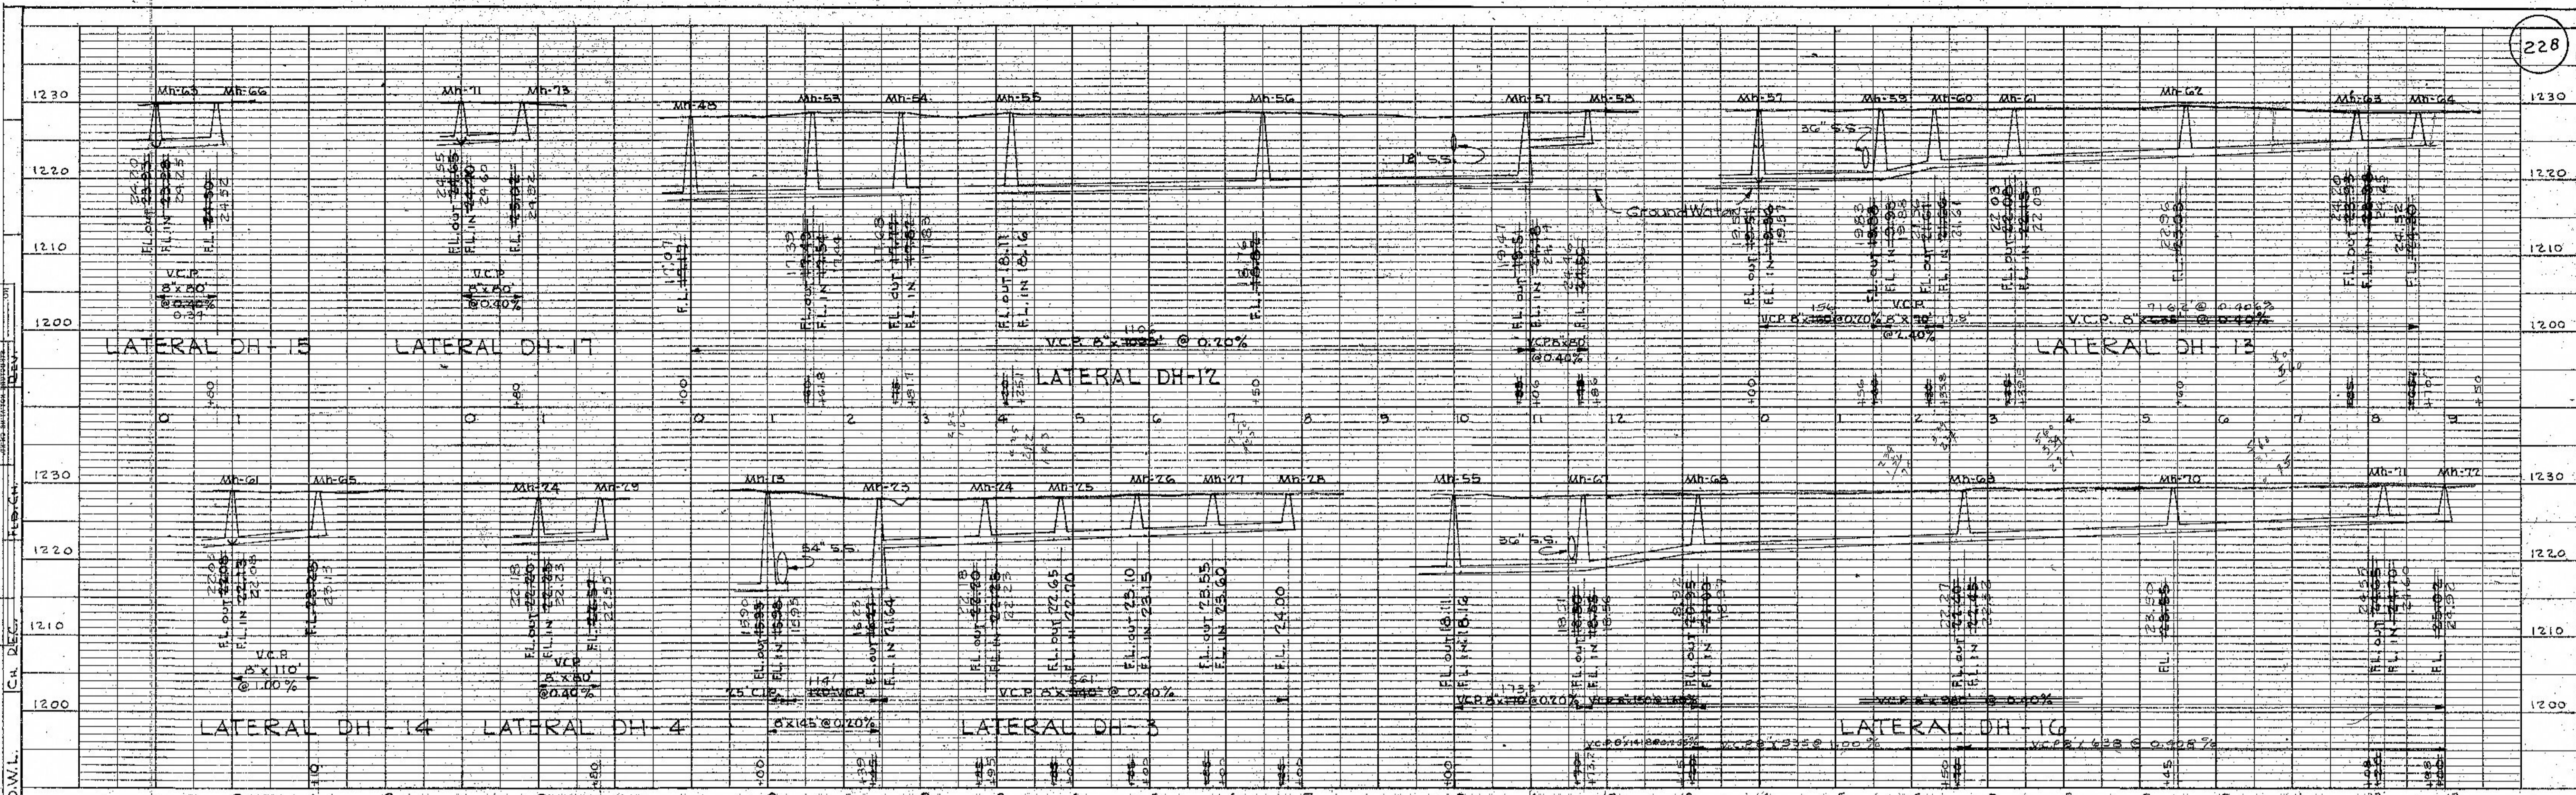

NOTE:  
Tops of all manholes to be constructed to finished grade elevation.

SCALE  
Plan: 1"=100'  
Profile: 1"=10' Vert.  
1"=100' Horiz.

SALINA, KANSAS  
SANITARY SEWER EXTENSIONS  
LAT DH-3, DH-4, DH-12, DH-13,  
DH-14, DH-15, DH-16 & DH-17

Scale as Noted  
WILSON & COMPANY  
ENGINEERS -  
Salina - Kansas  
1952

AS CONSTRUCTED DRAWING  
By \_\_\_\_\_ Date APR 14, 1953

